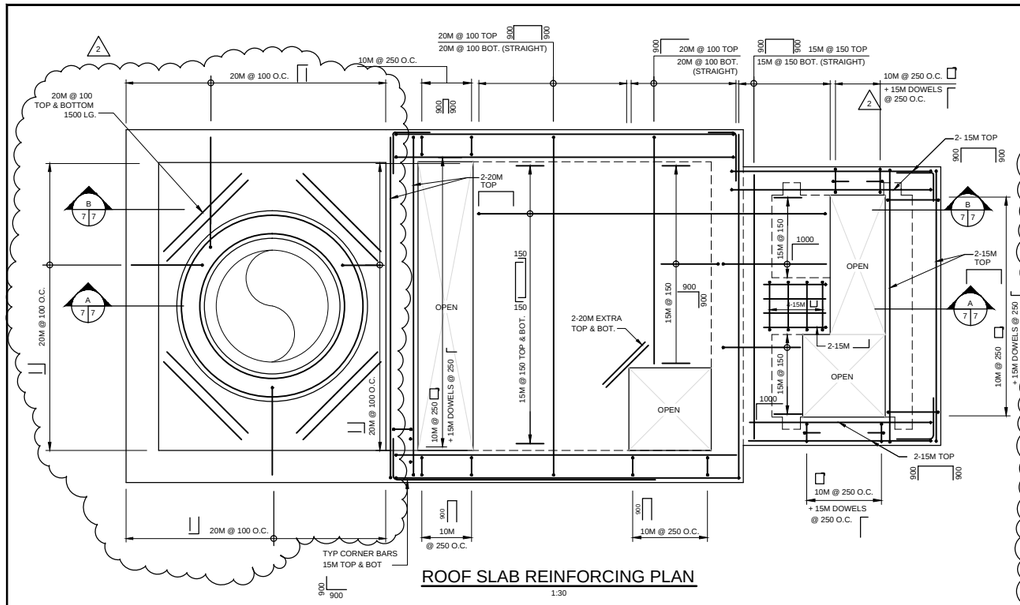

ROOF SLAB REINFORCING PLAN
1:30

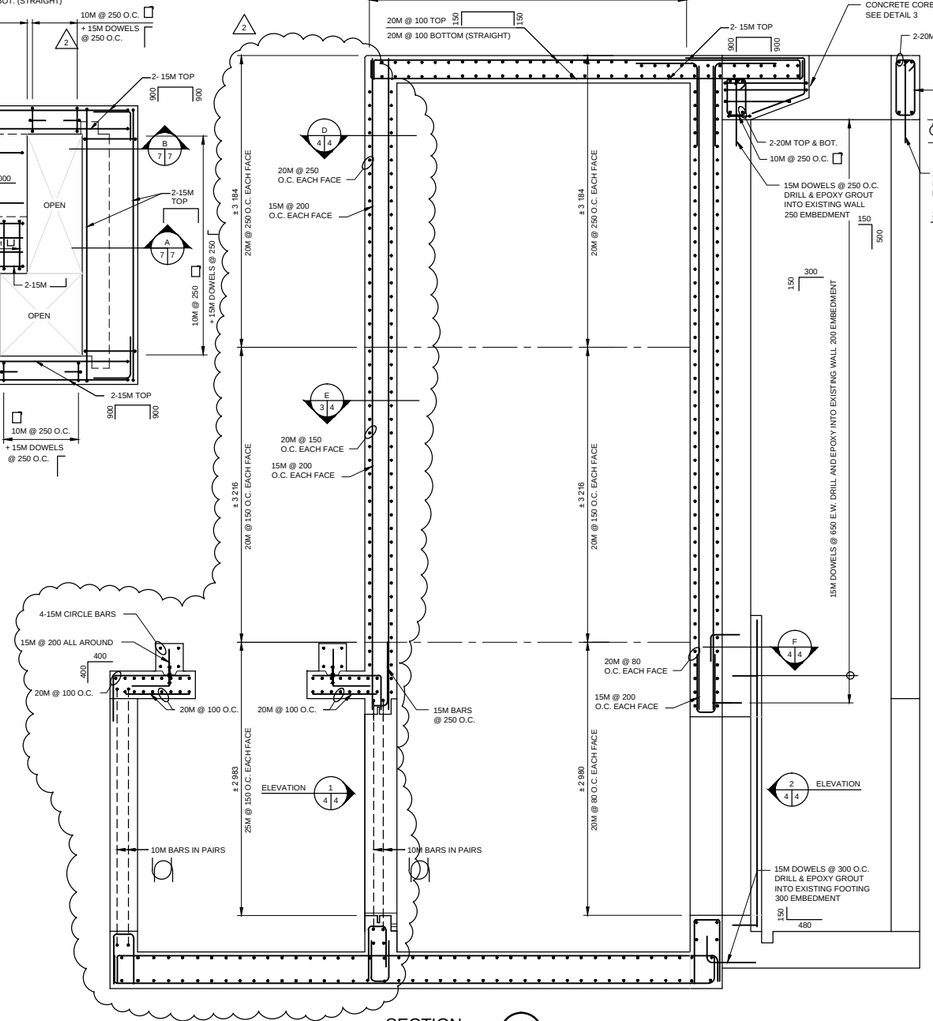

SECTION (THROUGH ℄ OF PIPE)
1:30

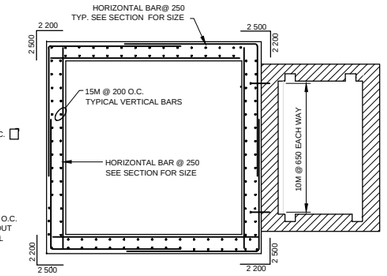

SECTION D
1:50

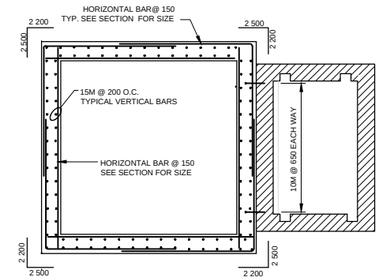

SECTION E
1:50

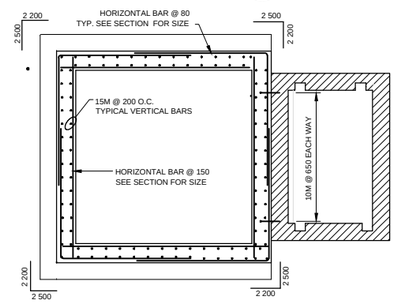

SECTION F
1:50

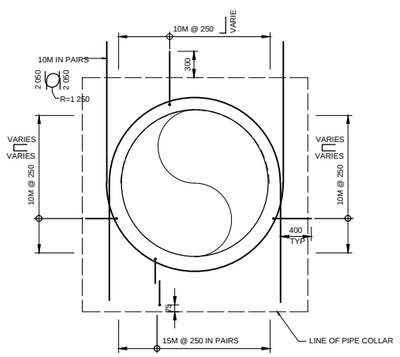

ELEVATION
1:40

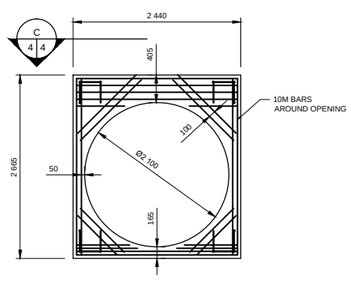

ELEVATION
1:40

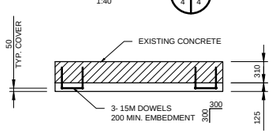

PLAN
1:40

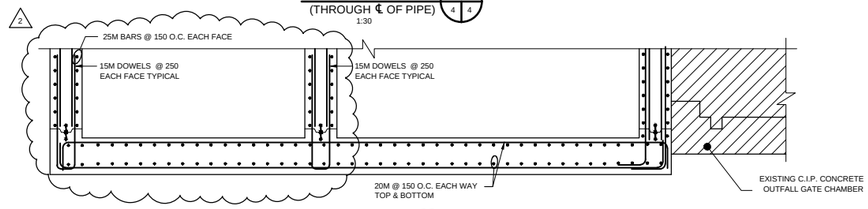

SECTION
1:30

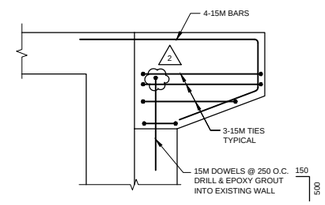

NOTE: WALL & ROOF SLAB REINFORCING NOT SHOWN FOR CLARITY

DETAIL
1:20

APEGM
Certificate of Authorization
MMM Group Limited
No. 4531 Date: 11.11.29

SCALE LEGEND:

1:20 — 0 500 1000 1500

1:30 — 0.0 0.5 1.0 1.5 2.0m

NOTE:
These design documents are prepared solely for the use by the party with whom the design professional has entered into a contract and there are no representations of any kind made by the design professional to any party with whom the design professional has not entered into a contract.

A = DETAIL/SECTION No.
B = DRAWING WHERE SHOWN
C = DRAWING WHERE TAKEN

METRIC
WHOLE NUMBERS INDICATE MILLIMETRES
DECIMALIZED NUMBERS INDICATE METRES

No.	REVISIONS	DATE	BY
2	ISSUED FOR ADDENDUM 1	11.11.29	DM
1	ISSUED FOR TENDER	11.11.18	DM

MMM GROUP

MMM Group Limited
Suite 111 - 93 Lombard Ave.
Winnipeg, MB R3B 3B1
t. 204.943.3178 | f. 204.943.4948
www.mmm.ca

DESIGNED BY	MM	CHECKED BY	DM/CDP
DRAWN BY	KDB	APPROVED BY	DM
HOR. SCALE	AS NOTED	RELEASED FOR CONSTRUCTION	
VERT. SCALE	AS NOTED		
DATE		DATE	2011.11.29

ENGINEER'S SEAL
PROVINCE OF MANITOBA
Nov. 29, 2011
MUHURDAREVIC
Member
31027
REGISTERED PROFESSIONAL ENGINEER

BID OPPORTUNITY: 938-2011
PLOT DATE: 2011.11.29

Winnipeg
THE CITY OF WINNIPEG
WASTE AND WATER DEPARTMENT

OUTFALL GATE CHAMBERS CONSTRUCTION & UPGRADES
MINNETONKA STREET & RIVER ROAD
LDS OUTFALL GATE CHAMBER ADDITION

REINFORCING DETAILS

CONSULTANT DRAWING No.: 5511125-4
SHEET 4 OF 10
CITY DRAWING No.: LD-5710

Last saved November 29, 2011 - 1:11 PM by BERNARDINK
P:\551110\1-551119\5511125 - Minnetonka Gate Chambers Construction\MMM Drawings\5511125 minnetonka gate chambers_111128_kdb.dwg