

NOTES

1. ALL WORK TO BE COMPLETED BETWEEN STA. 12+50 AND STA. 26+00.

2. ALL WORK TO BE TYPE "A-1" EXCEPT AS NOTED.

3. ALL SERVICE TO BE INSTALLED BELOW GRADE AS NOTED.

4. ALL DIMENSIONS TO BE A MINIMUM OF 6" UNLESS OTHERWISE NOTED.

5. ALL MATERIALS TO BE EXCEPT AS NOTED.



6. ALL STRENGTH CONCRETE PIPE 12" DIA.

7. ALL 24" RADIUS, LANE FILL: 118'


8. ALL UNDERGROUND WORK TO BE COMPLETED BEFORE BEGINNING OF CONSTRUCTION.

9. ALL WATER ONLY, CONTRACTION SHALL BE BEFORE BEGINNING OF CONSTRUCTION.

10. ALL AT S.W. CORNER OF ST. WALTERS RD. E.T. 131.42'

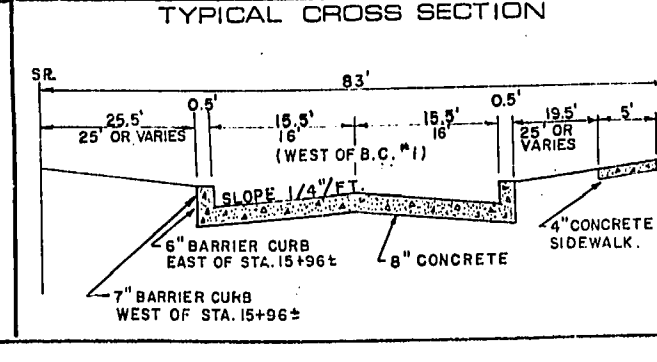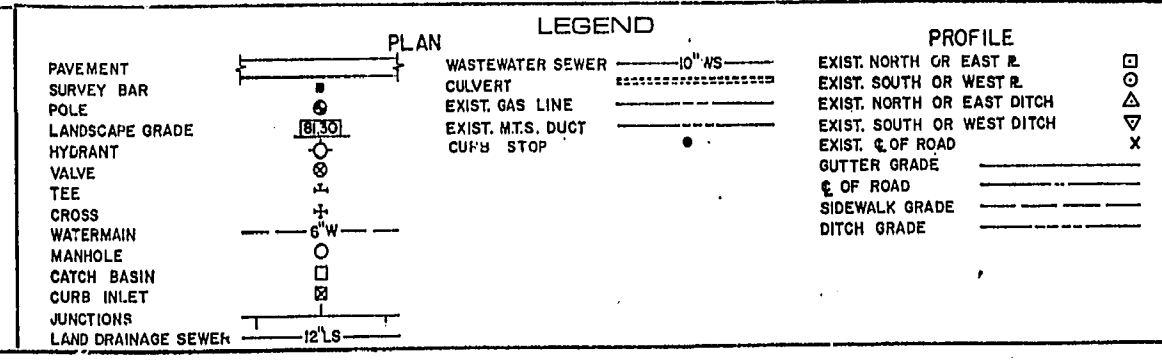

NO.	REVISIONS	DATE	BY
12	REVISED P.W.Y. APPROACH TO MINNETONKA SCHOOL	MAY 11/72	R.P.
11	REVISED P.W.Y. CONCRETE PAVEMENT CONTRACT	NOV. 5/72	R.P.
10	CHANGED 30' L.S. OFFSET FROM 15' TO 10'	OCT. 19/72	R.P.
9	REVISED TYPICAL CROSS SECTION	OCT. 24/72	R.P.
8	REVISED TO A CONCRETE TO 10' A. SERVICE GRASS	OCT. 21/72	R.P.
7	REVISED TO 10' A. SERVICE GRASS	OCT. 21/72	R.P.

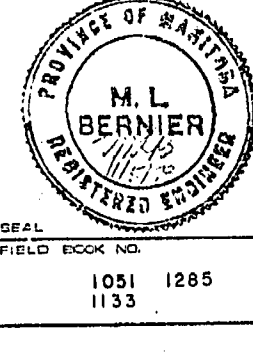

THE CITY OF WINNIPEG
OPERATIONS DIVISION - DISTRICT 5
LOCATION AND GRADE OF SERVICES ON
VISTA AVENUE River Road
STA. 12+50 W. TO STA. 26+00 W.

TEMPLETON ENGINEERING COMPANY
PROFESSIONAL ENGINEERS

WINNIPEG MANITOBA

DRAWN BY: R.B. CHECKED BY: M.L.B. APPROVED BY: G.A.P.

DATE: MAY 7, 1973 SCALE: HORIZ. 1" = 40' VERT. AS SHOWN PLAN NO.: SV-6-195

FIELD BOOK NO.: 1051 1285 1133