


**LEGEND**  
 WATER INTERCEPTOR EXTENSION

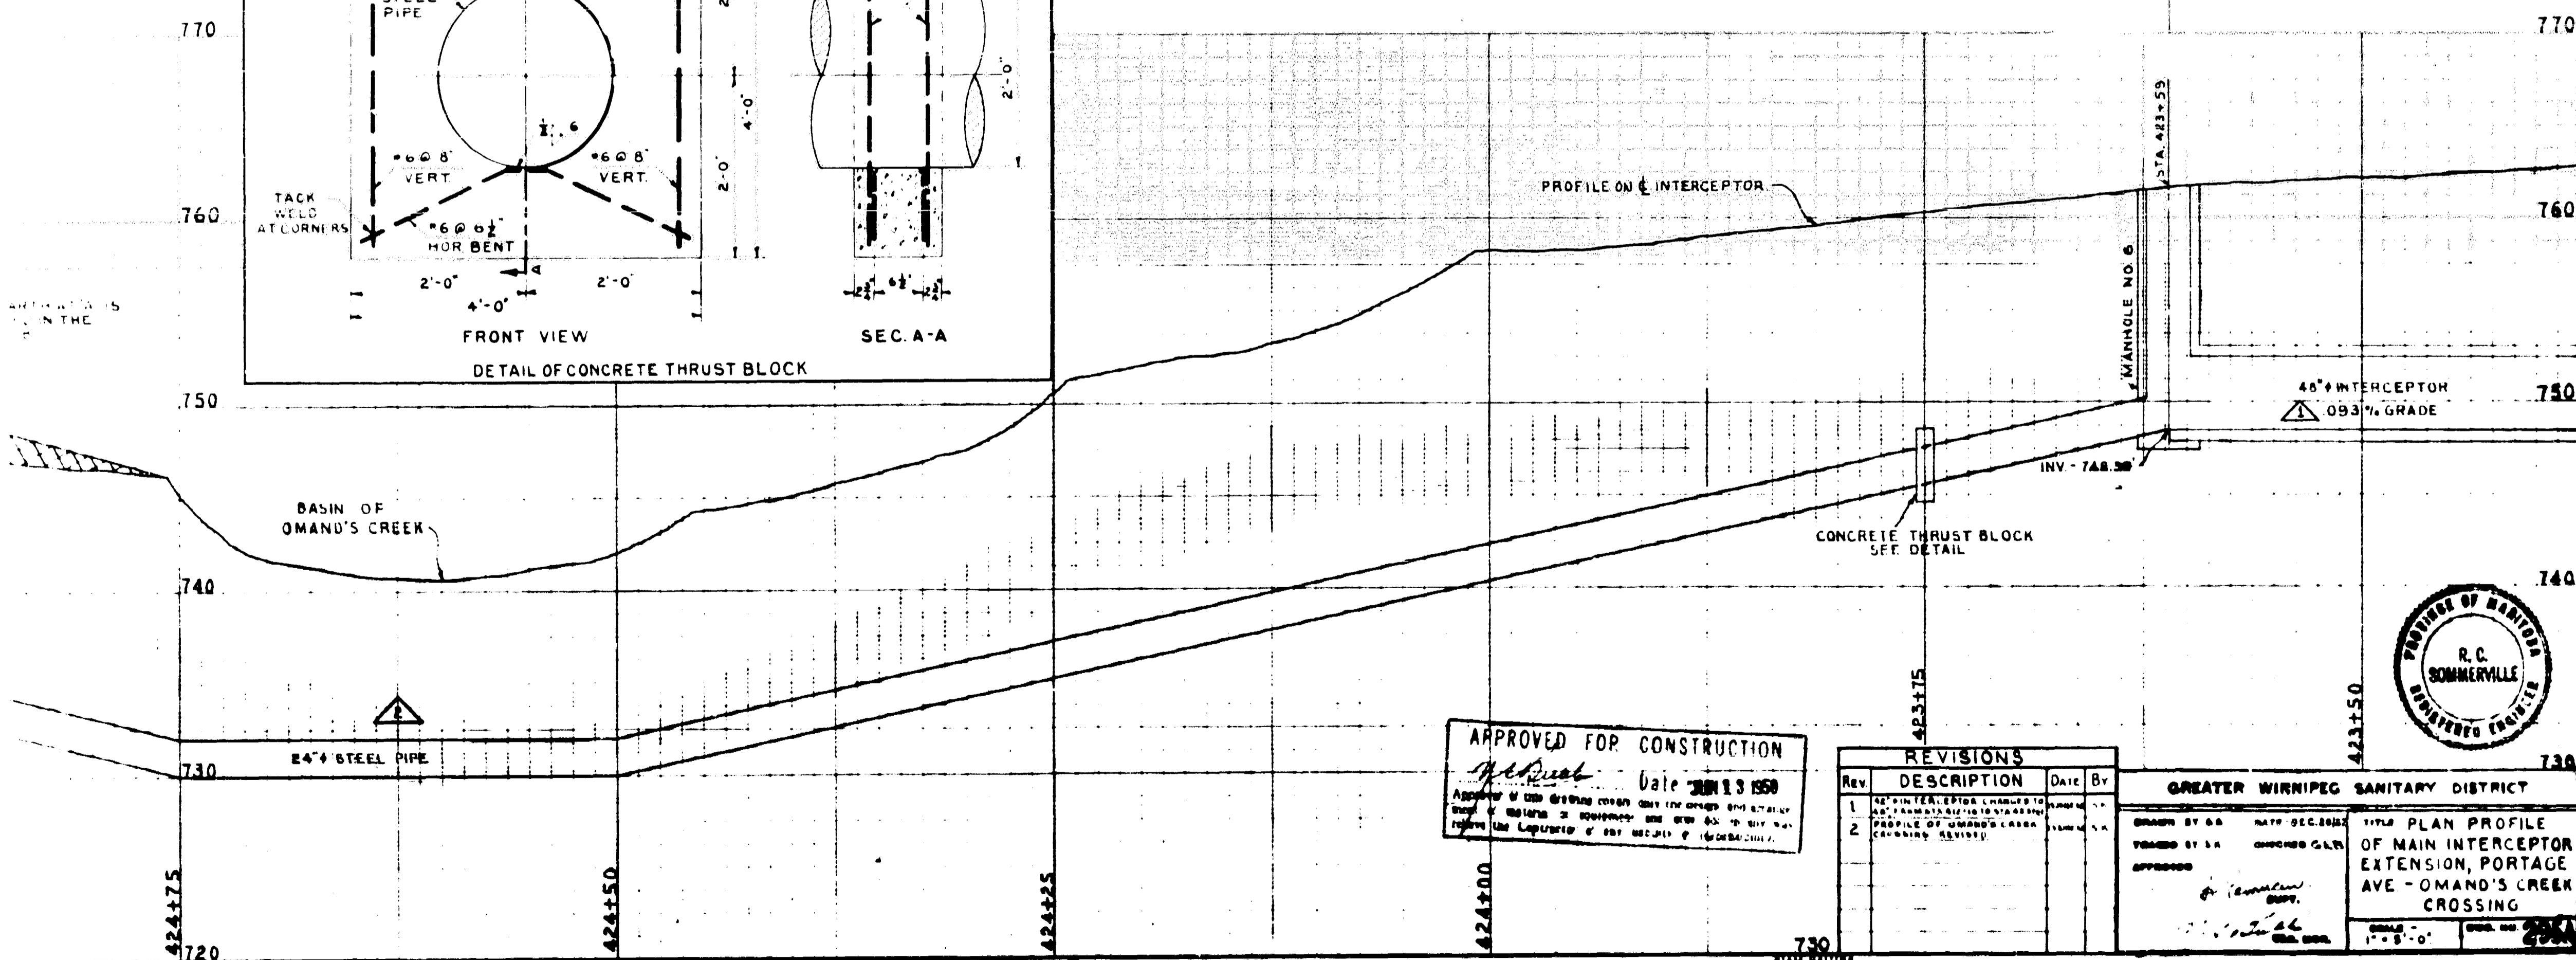

APPROVED FOR CONSTRUCTION  
*[Signature]* Date JUN 13 1950  

REV.	DESCRIPTION	DATE	BY

GREATER WINNIPEG SANITARY DISTRICT

DESIGNED BY G.S. CHECKED G.L.L.  
 DRAWN BY S.A. APPROVED *[Signature]*

TITLE PLAN PROFILE OF MAIN INTERCEPTOR EXTENSION, PORTAGE AVE - OMAND'S CREEK CROSSING

SCALE 1" = 5'-0"

