AZON CANADA
3130110300

REF. or DRAWING No. _____
DETAILS 295A-3

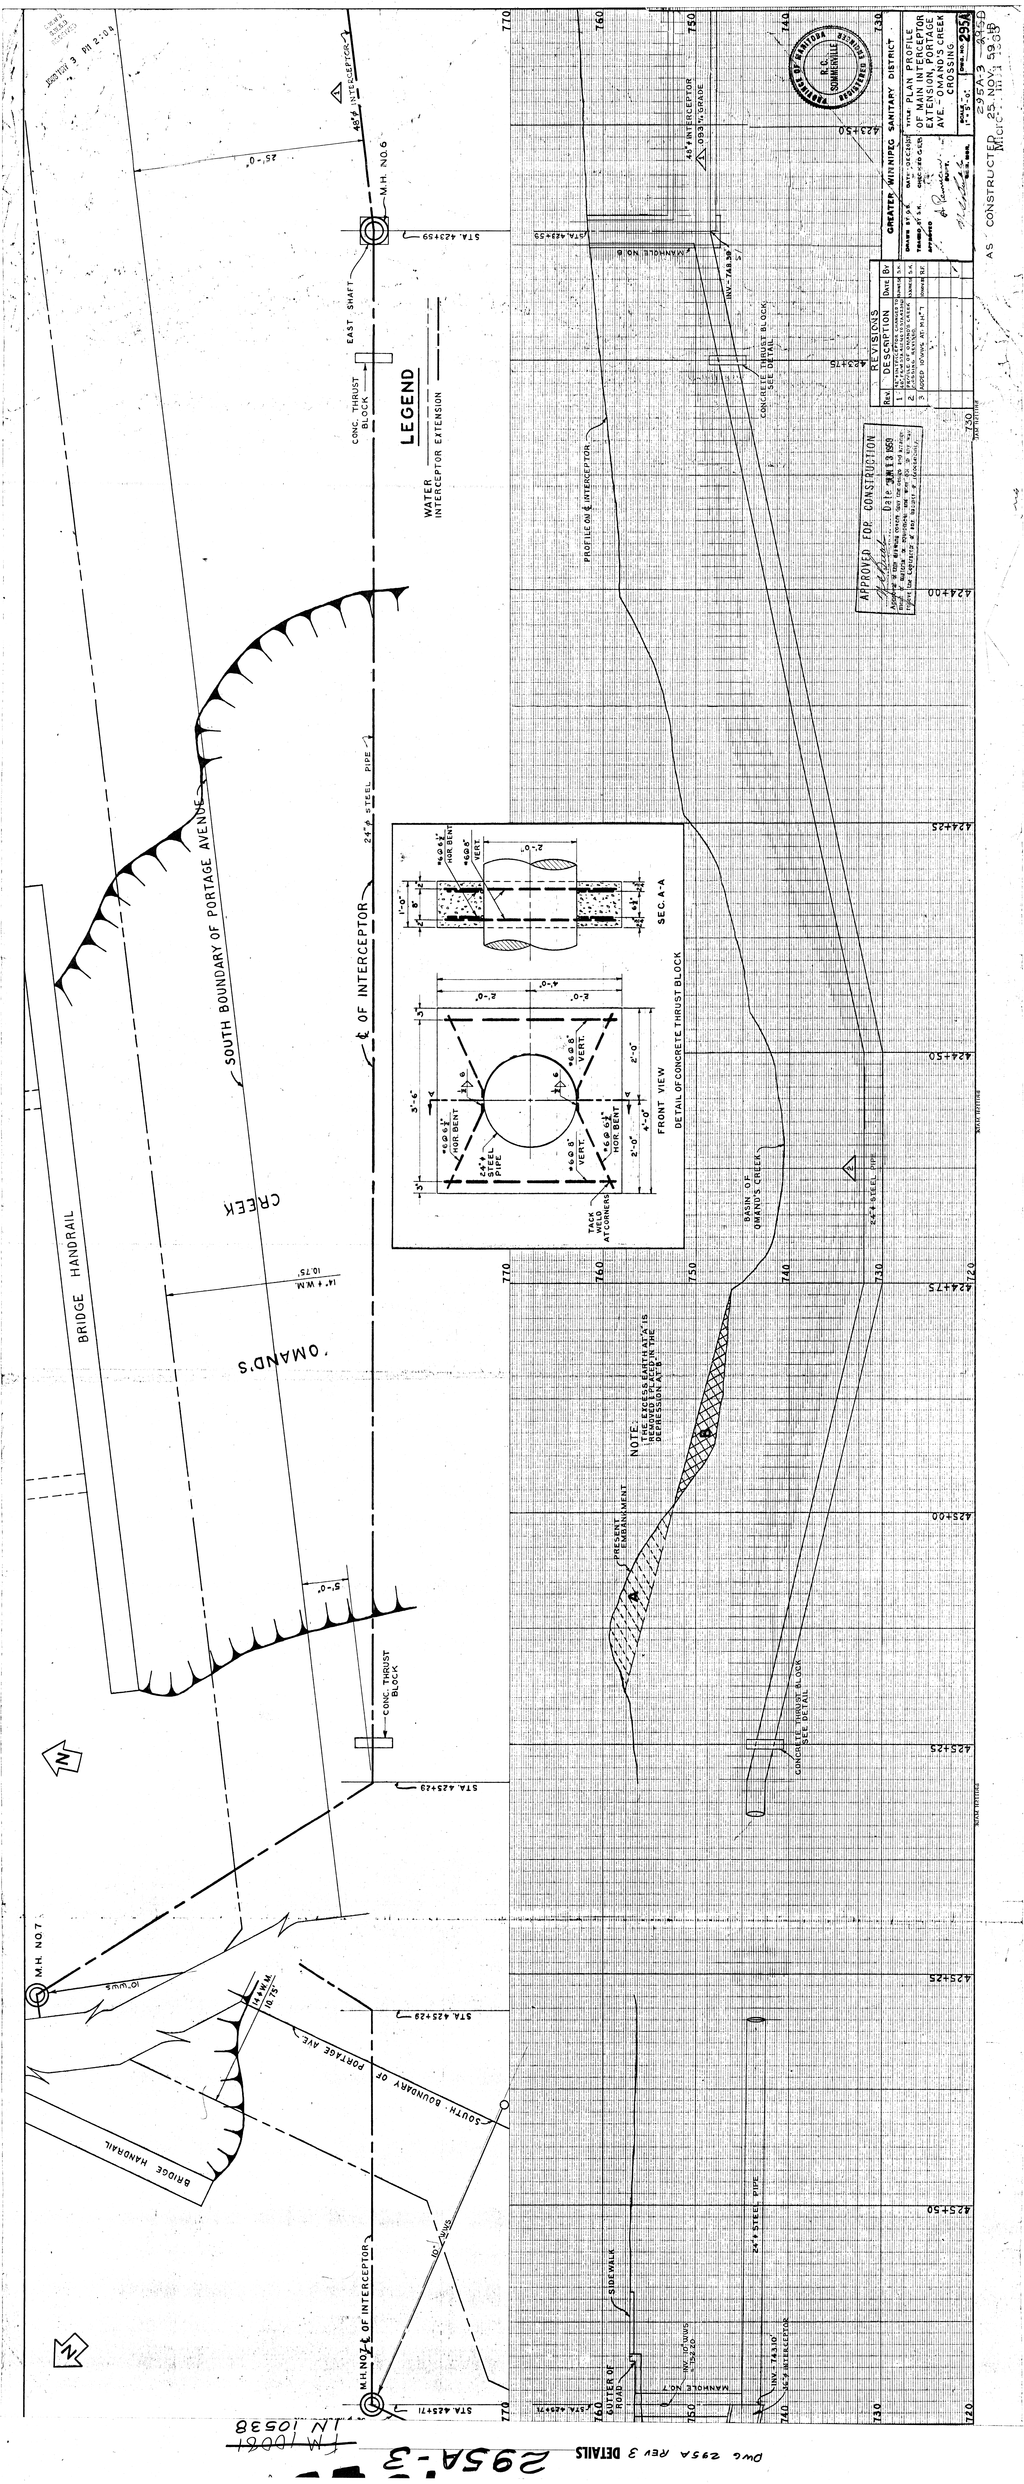

FM 10538
295A-3
DWG 295A REV 3 DETAILS