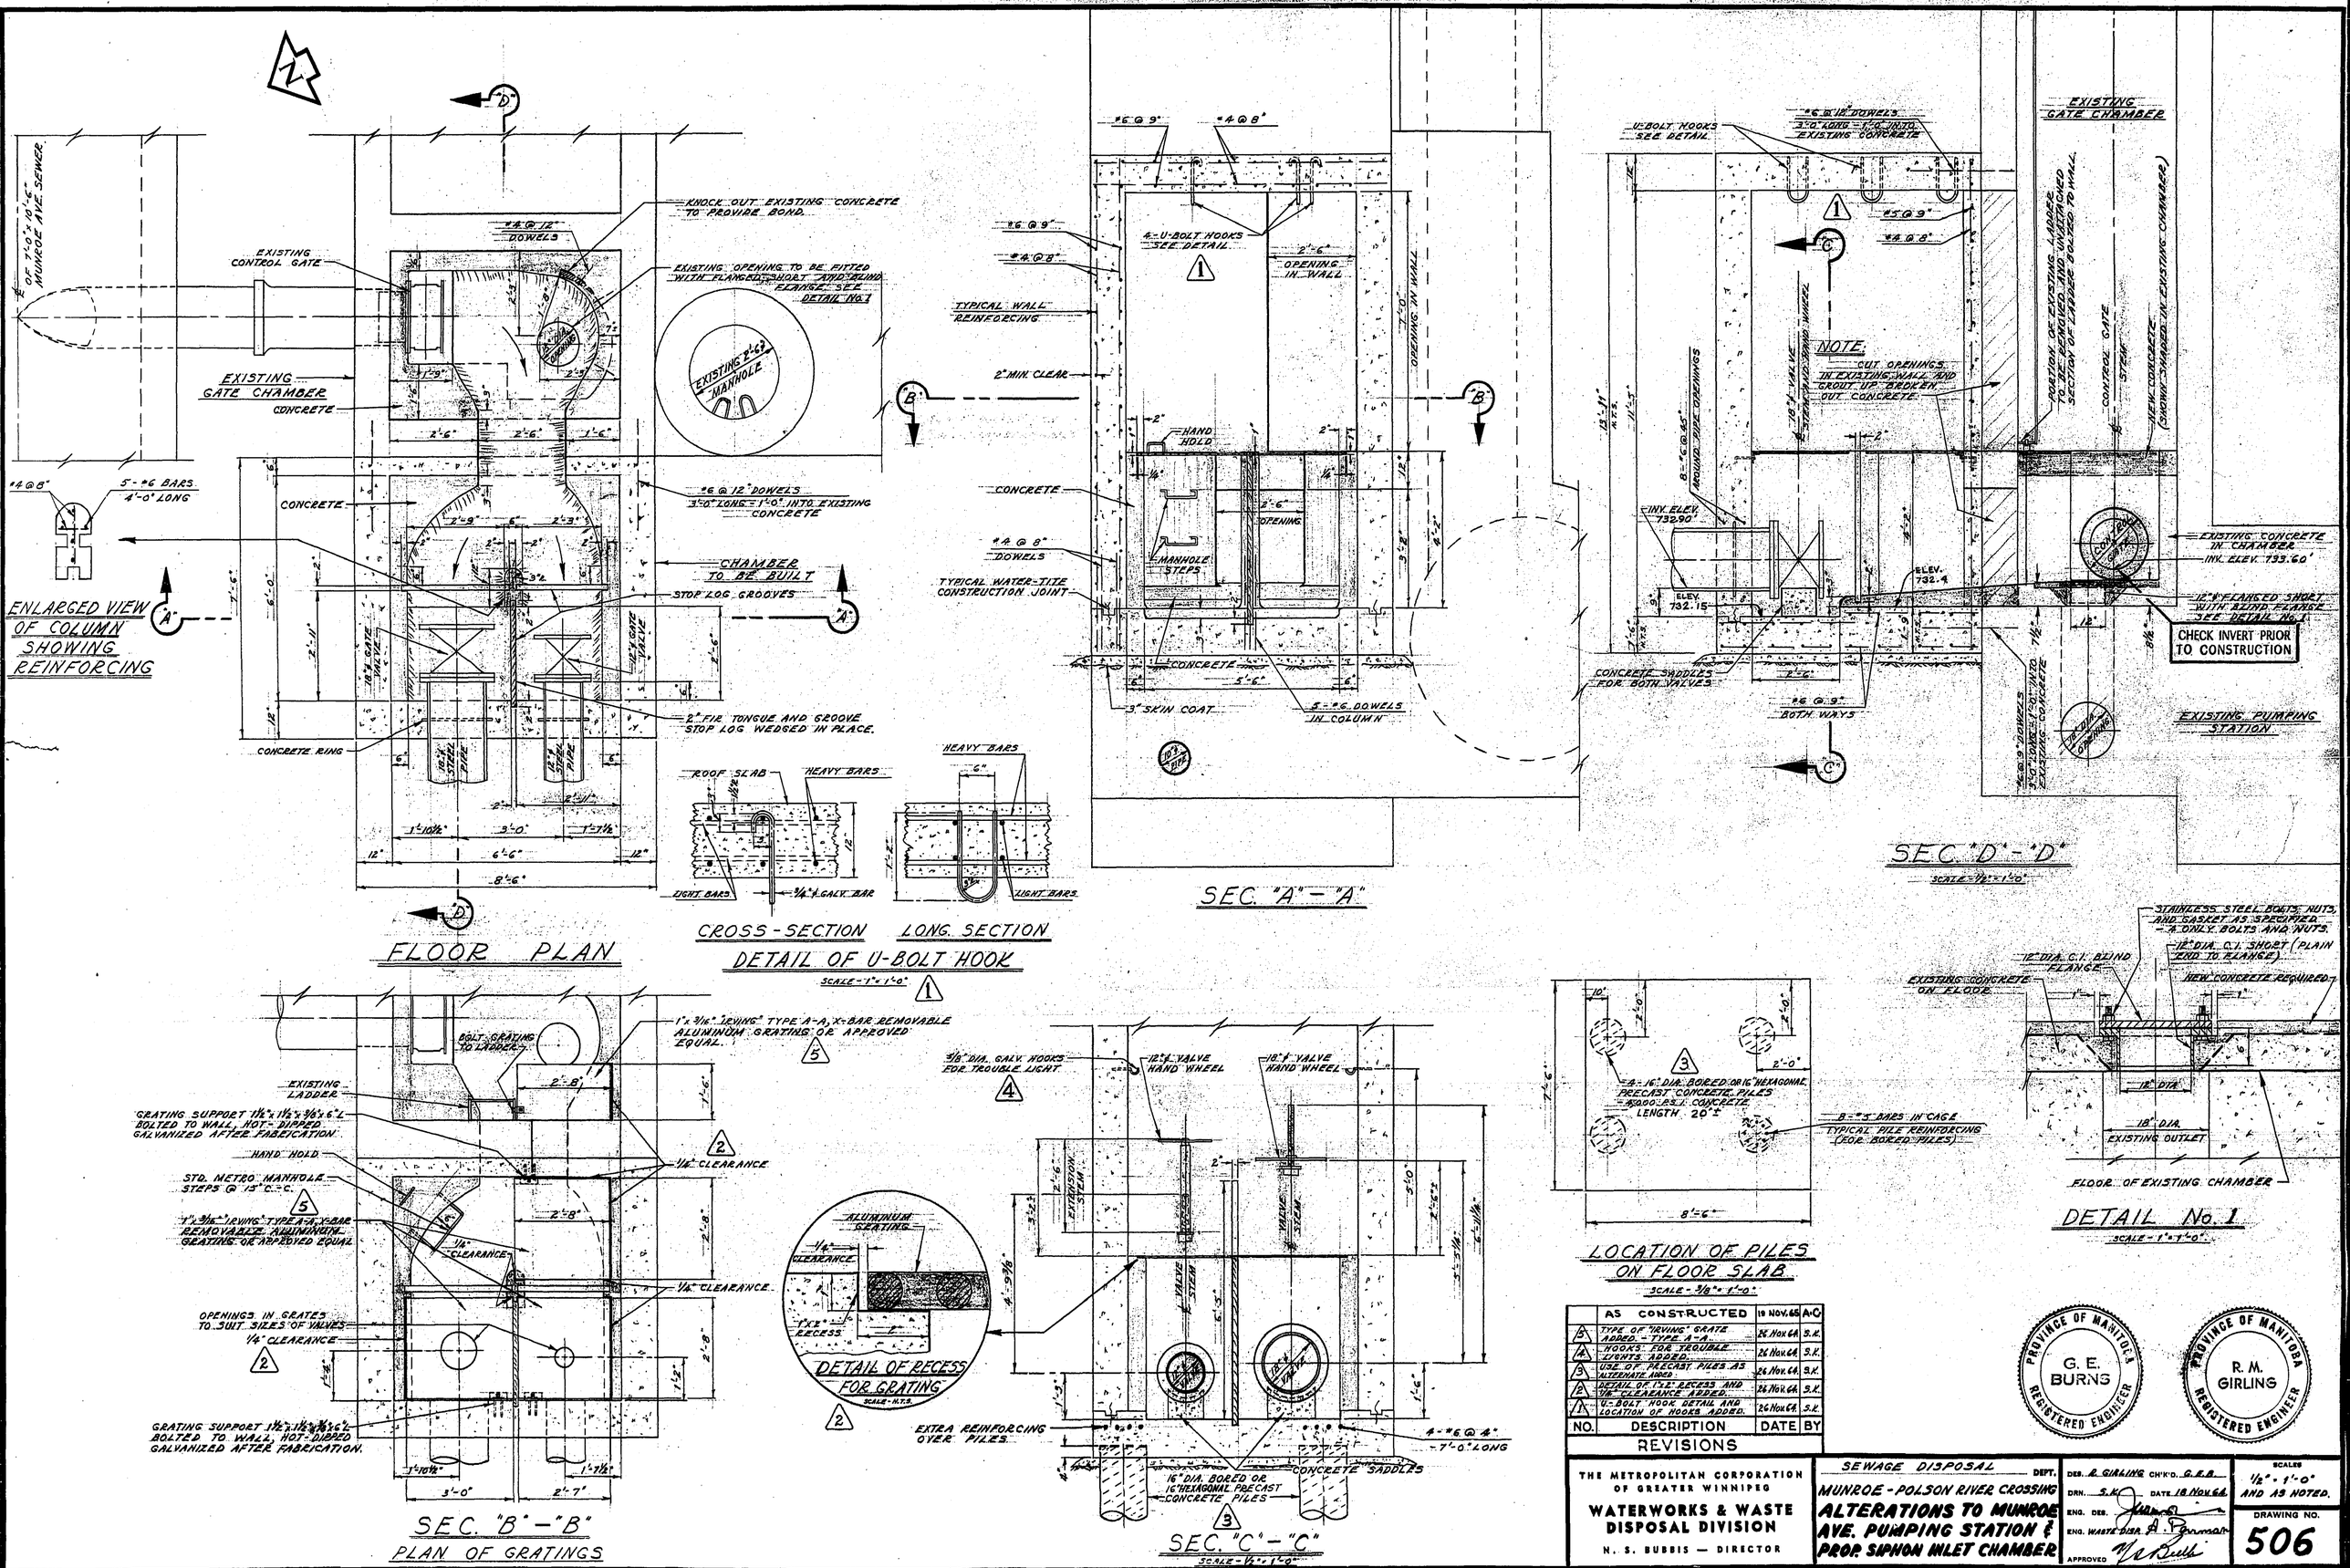

NO.	DESCRIPTION	DATE	BY
	AS CONSTRUCTED	19 Nov. 65	A.C.
5	TYPE OF "IRVING" GRATE ADDED - TYPE "A-A"	26 Nov 64	S.K.
4	HOOKS FOR TROUBLE LIGHTS ADDED	26 Nov 64	S.K.
3	USE OF PRECAST PILES AS ALTERNATE ADDED	26 Nov 64	S.K.
2	DETAIL OF 1½" RECESS AND ¼" CLEARANCE ADDED	26 Nov 64	S.K.
1	U-BOLT HOOK DETAIL AND LOCATION OF HOOKS ADDED	26 Nov 64	S.K.

REVISIONS

PROVINCE OF MANITOBA — G. E. BURNS — REGISTERED ENGINEER

PROVINCE OF MANITOBA — R. M. GIRLING — REGISTERED ENGINEER

THE METROPOLITAN CORPORATION OF GREATER WINNIPEG

WATERWORKS & WASTE DISPOSAL DIVISION

N. S. BUBBIS — DIRECTOR

SEWAGE DISPOSAL — DEPT.

MUNROE - POLSON RIVER CROSSING

ALTERATIONS TO MUNROE AVE. PUMPING STATION & PROP. SIPHON INLET CHAMBER

DES. R. GIRLING CH'K'D. G.E.B.

DRN. S.K. DATE 18 Nov. 64

ENG. DES.

ENG. WASTE DISP. A. B. Furman

APPROVED N. S. Bubbis

SCALES ½" = 1'-0" AND AS NOTED.

DRAWING NO. 506