


SWS Field workstation

Note: refer to overall plan A1-R1 for complete layout.

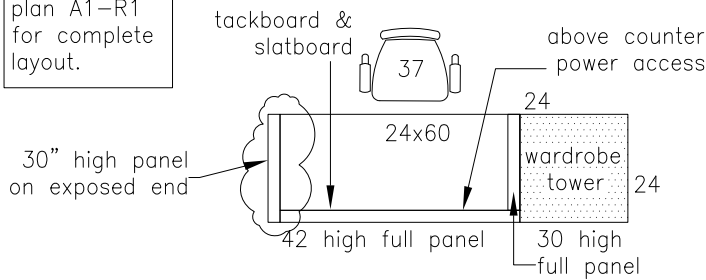

SWS Field "hotelling" Desks

 THE CITY OF WINNIPEG PLANNING, PROPERTY AND DEVELOPMENT DEPARTMENT MUNICIPAL ACCOMMODATIONS DIVISION 3-65 GARRY STREET, R3C 4K4		PROJECT SOLID WASTE/ IST RELOCATION 1120 WAVERLY STREET			SHEET TITLE SWS FIELD TYPICAL WORKSTATIONS SWS FIELD STAFF "HOTELING" DESKS	
DRAWN BY:	CHECKED BY:	DESIGNED BY:	APPROVED BY:	DATE:	SCALE:	SHEET No:
KN		KN		2012-04-25	1/4"=1'-0"	A9-R1
				eFILE:	PROJECT No:	
					2012-035	