


power pole required for electrical access; power req'd below desk too.

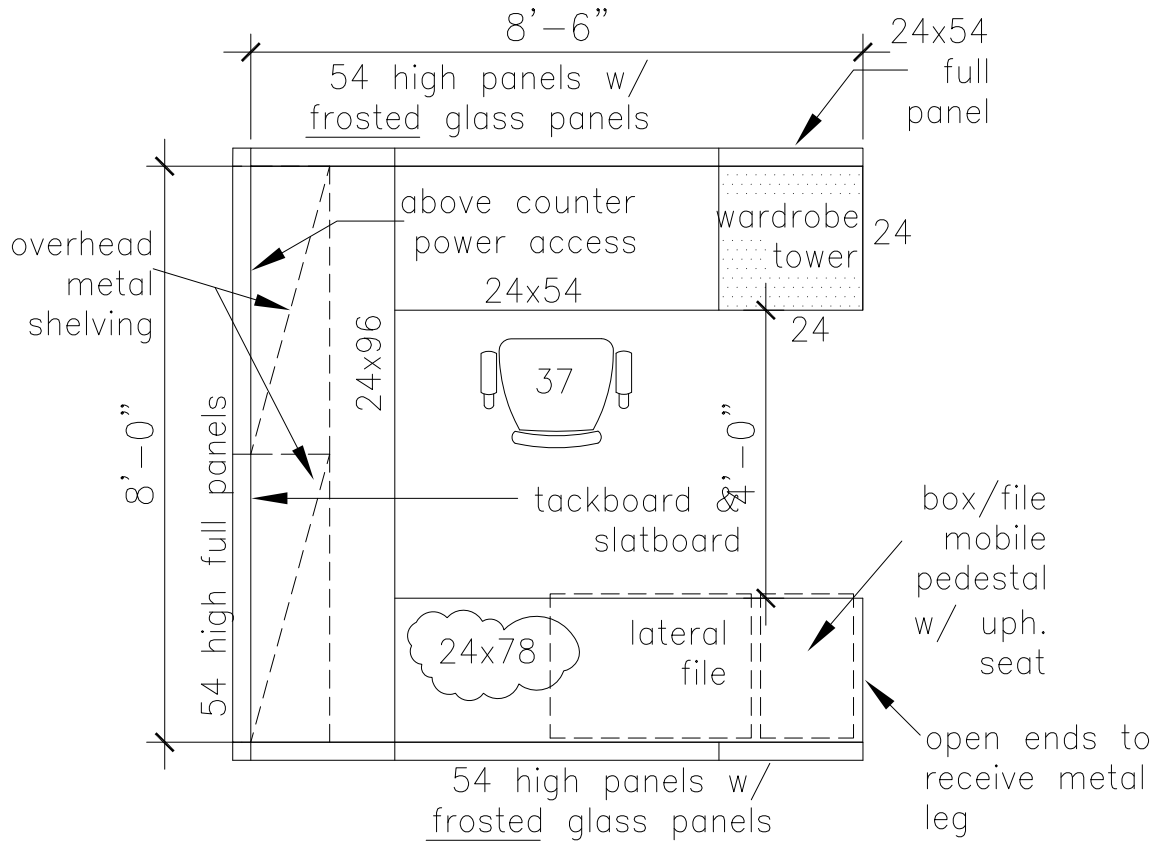

SWS Clerks workstation

 THE CITY OF WINNIPEG PLANNING, PROPERTY AND DEVELOPMENT DEPARTMENT MUNICIPAL ACCOMMODATIONS DIVISION 3-65 GARRY STREET, R3C 4K4		PROJECT SOLID WASTE/ IST RELOCATION 1120 WAVERLY STREET			SHEET TITLE SWS CLERKS WORKSTATIONS ENLARGED PLAN	
DRAWN BY:	CHECKED BY:	DESIGNED BY:	APPROVED BY:	DATE:	SCALE:	SHEET No:
KN		KN		2012-05-01	3/8"=1'-0"	A7-R1
				eFILE:	PROJECT No:	
					2012-035	