


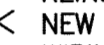
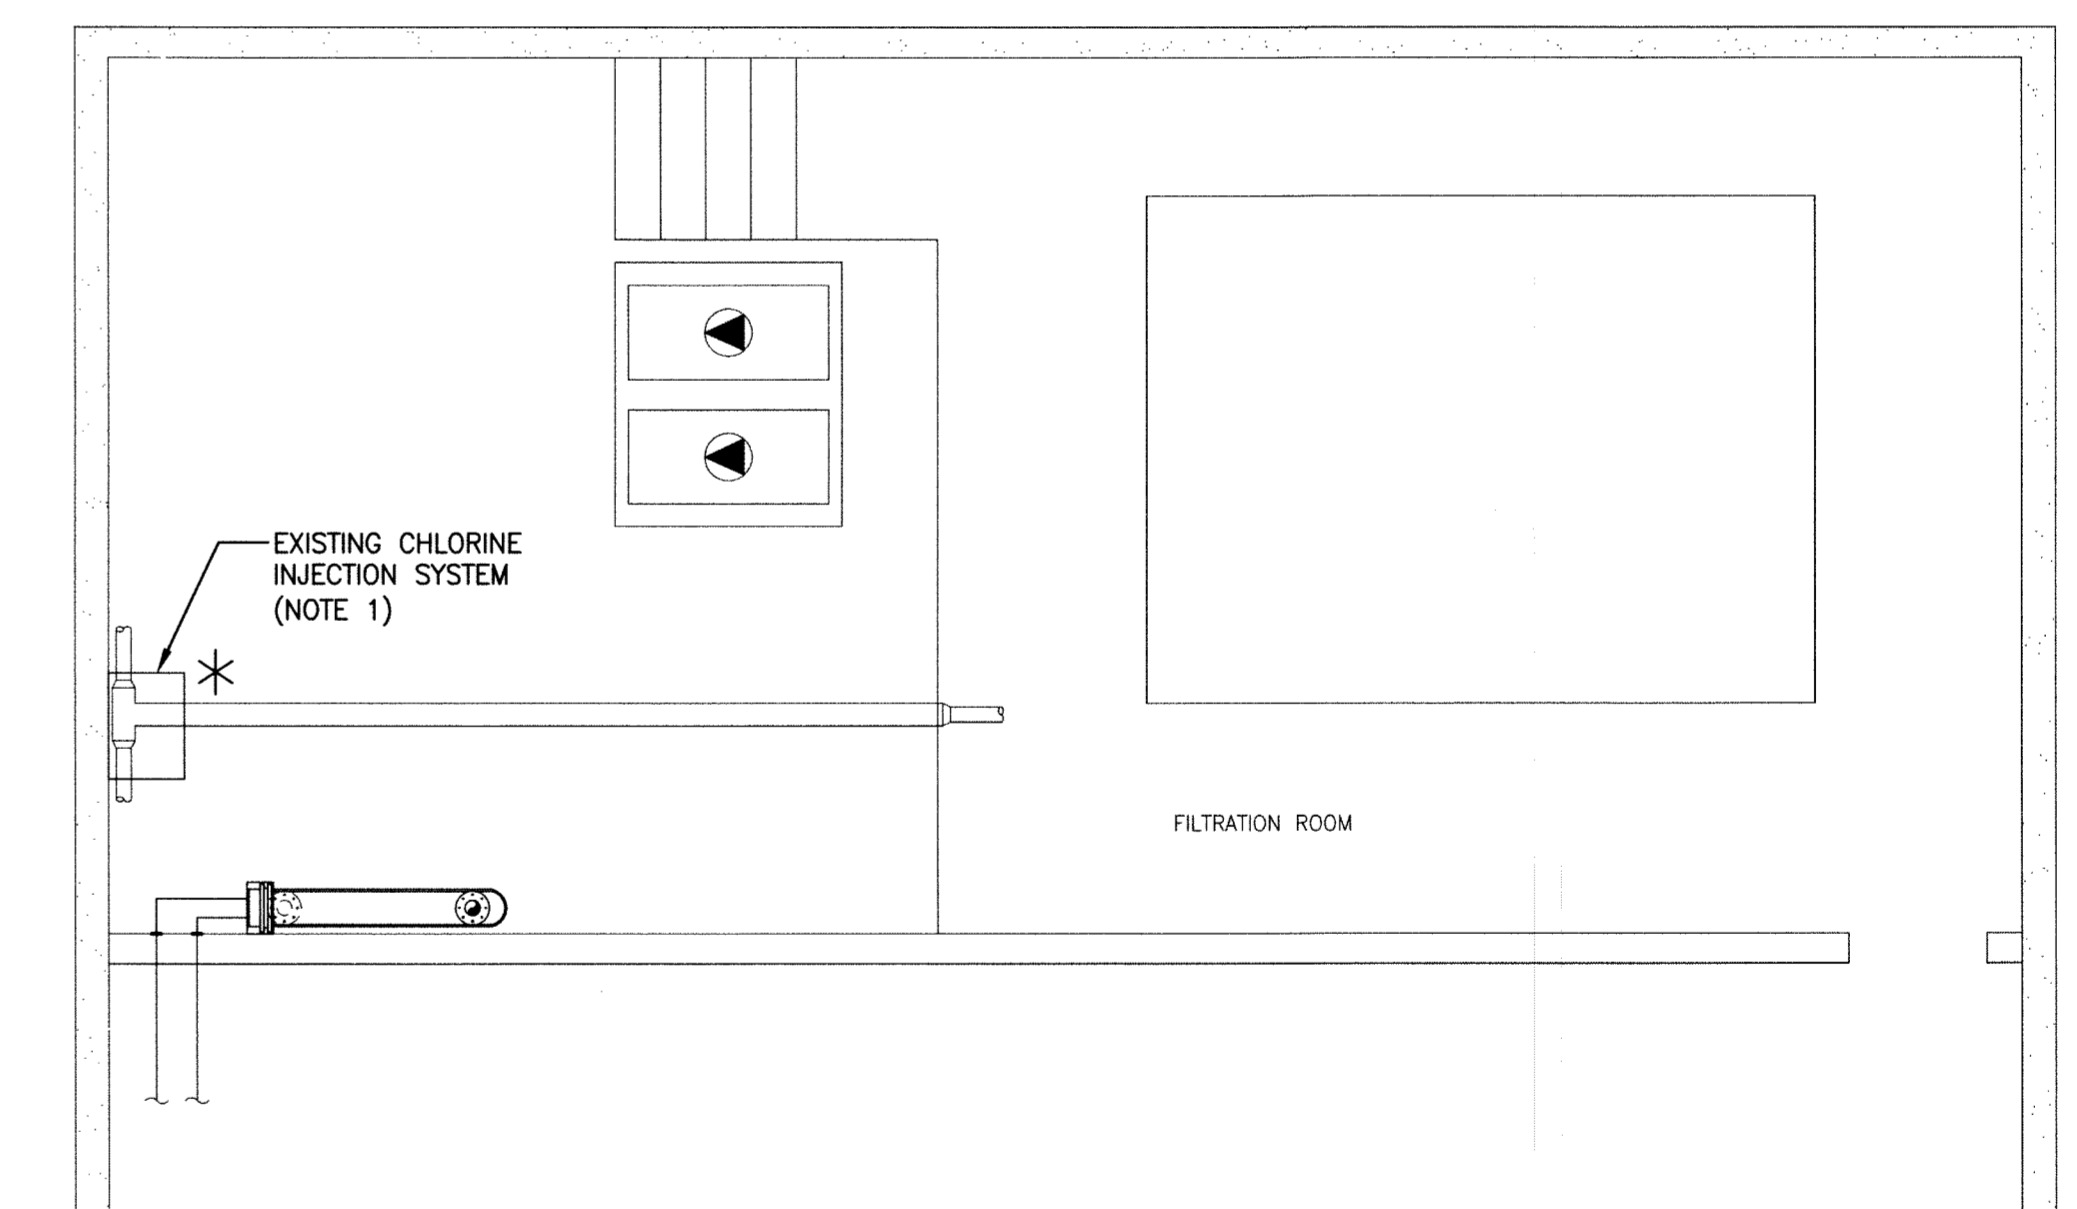
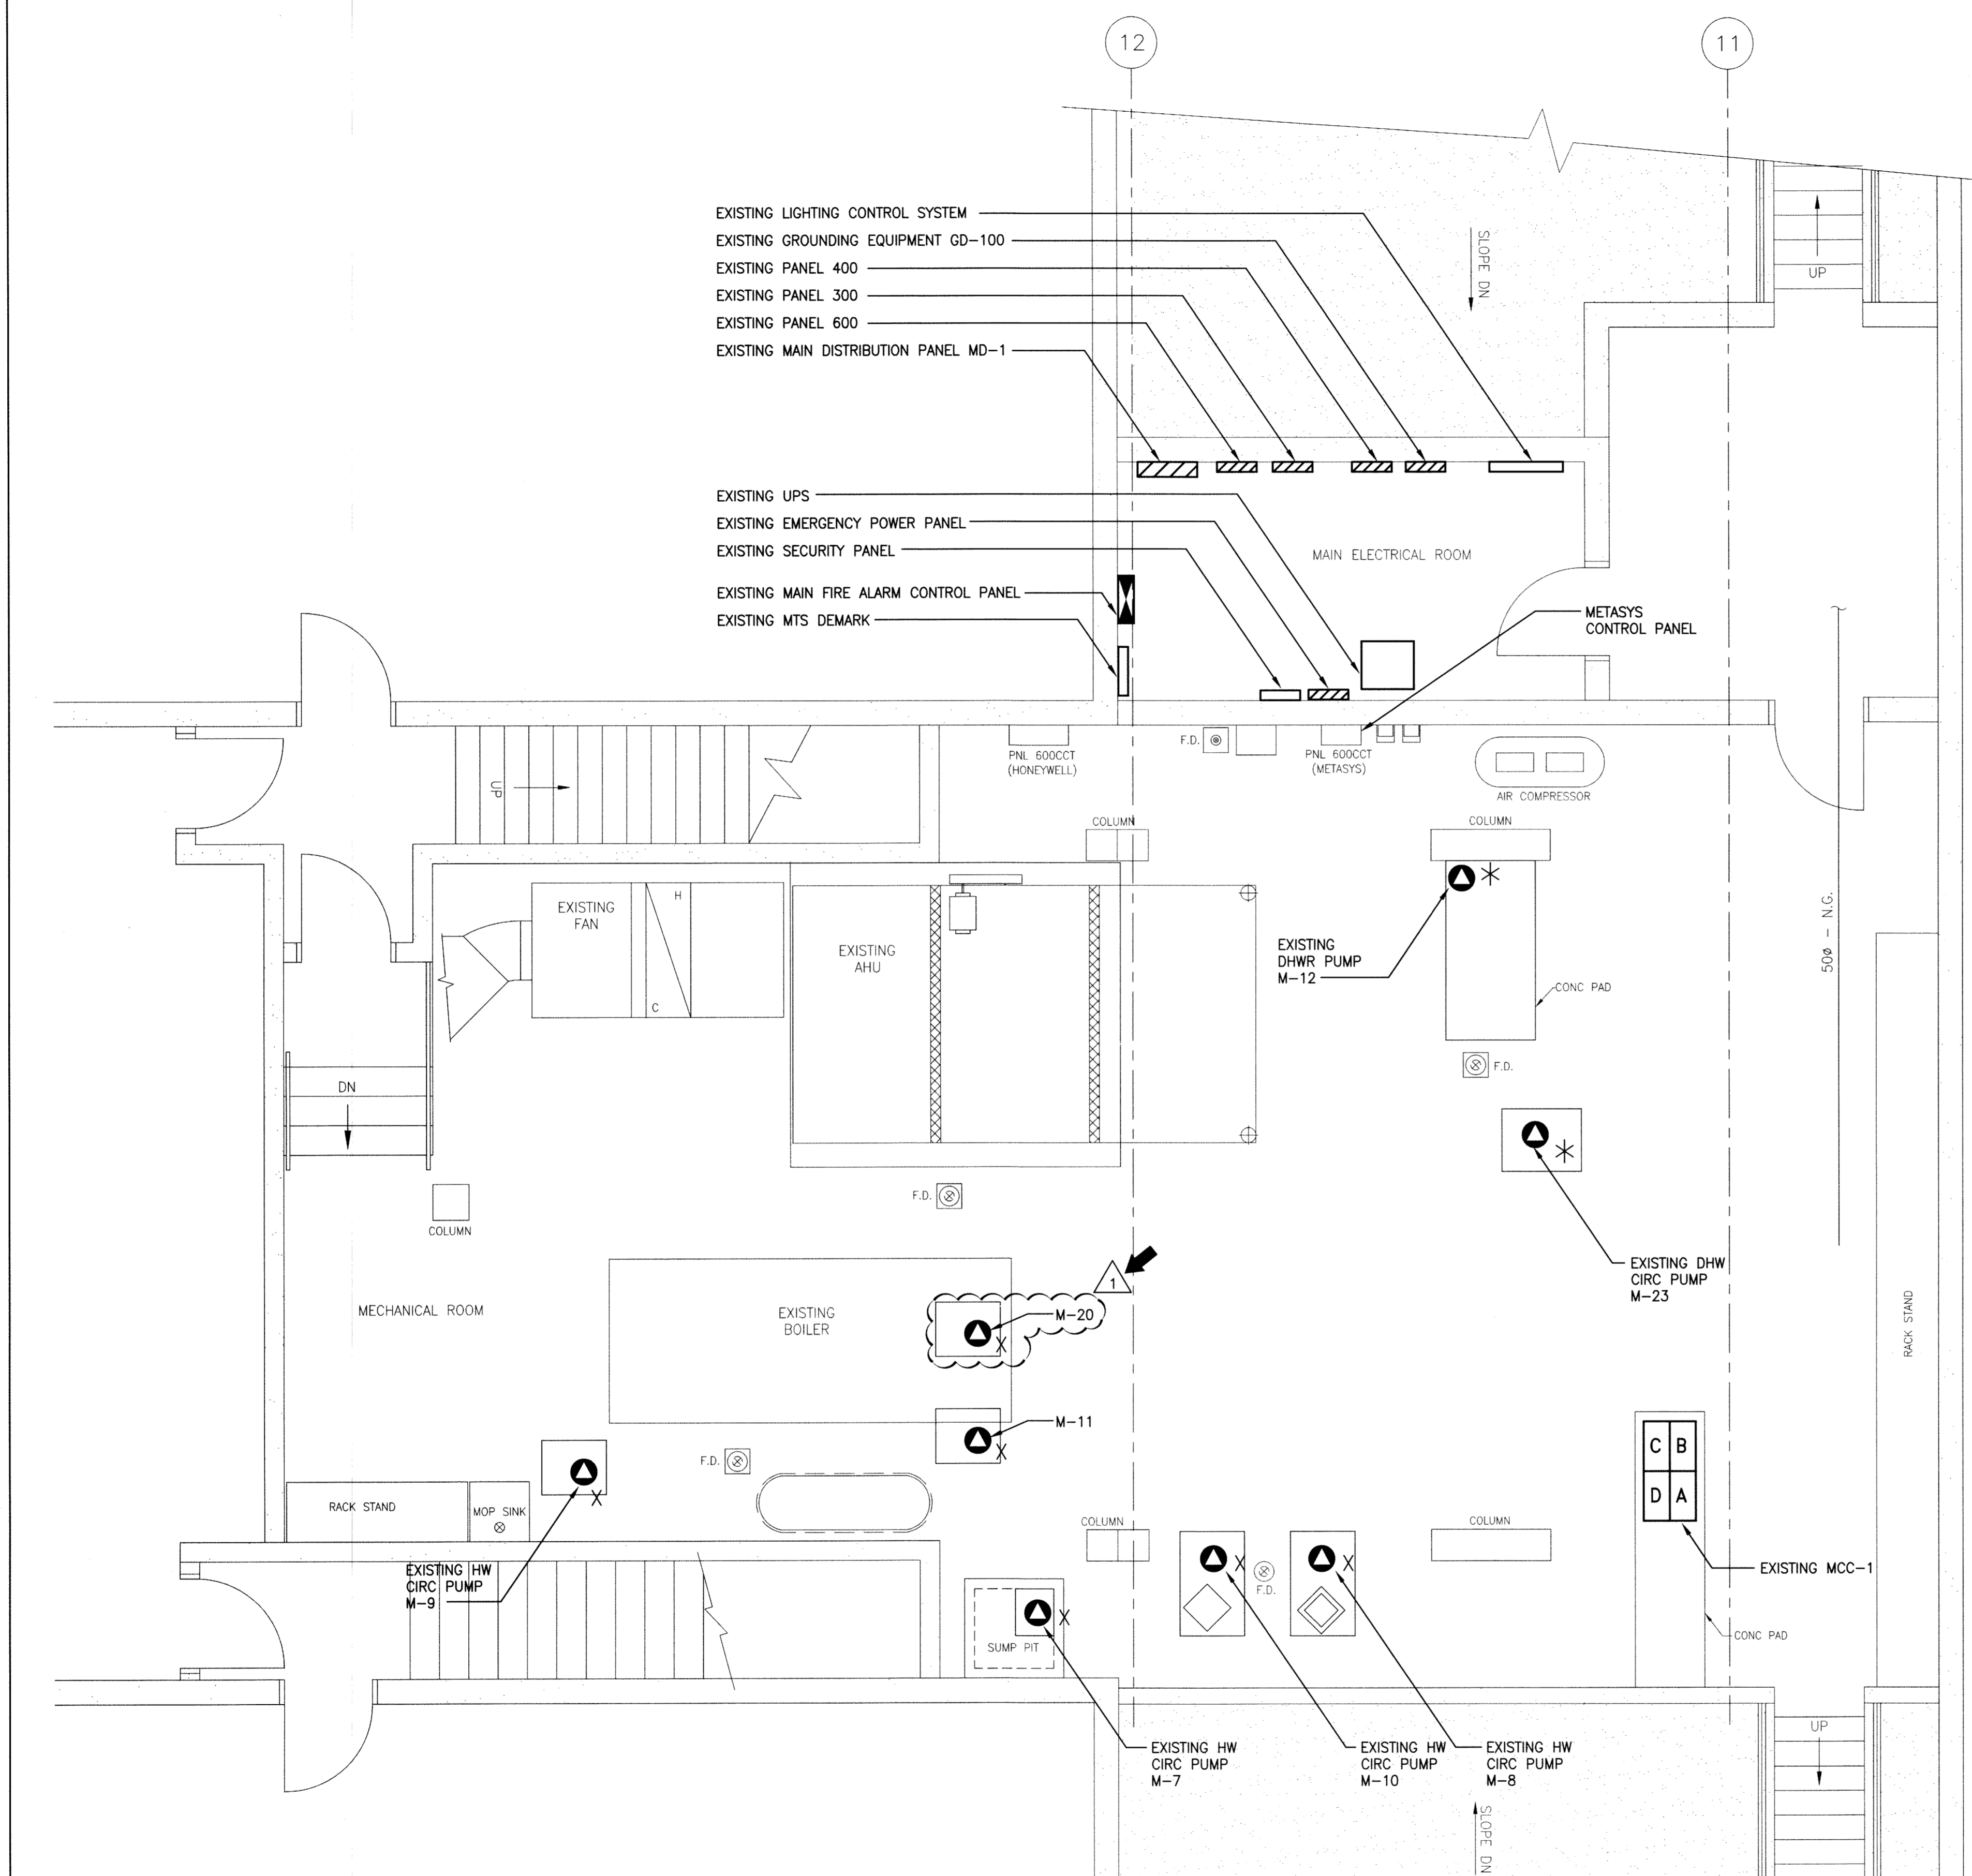


- NOTES:**
- EXISTING DISCONNECT AND DUPLEX RECEPTACLES ASSOCIATED WITH EXISTING CHLORINE INJECTION SYSTEM TO BE RELOCATED TO SUIT NEW LOCATION OF CHLORINE INJECTION SYSTEM. REFER TO MECHANICAL DRAWINGS FOR EXACT DETAILS.

- LEGEND:**
-  ELECTRICAL PANELBOARD
 -  MOTOR LOAD
- RENOVATION LEGEND:**
-  EXISTING ELECTRICAL EQUIPMENT TO BE REMOVED AND TURNED OVER TO THE CONTRACT ADMINISTRATOR. REMOVE, BLANK OFF, EXTEND OR RELOCATE ALL ASSOCIATED WIRING AND MAKE SAFE.
 -  EXISTING ELECTRICAL EQUIPMENT TO BE REMOVED AND REINSTALLED OR RELOCATED AS SHOWN UPON COMPLETION OF NEW CEILING OR WALL CONSTRUCTION. RE-WIRE OR EXTEND WIRING AS REQUIRED.



2 BASEMENT FILTRATION ROOM PLAN - DEMOLITION
 SCALE: 1:50mm

1 BASEMENT MECHANICAL ROOM PLAN - DEMOLITION
 SCALE: 1:40mm

APEGM
 Certificate of Authorization
 KGS Group
 No. 245

B.M. ELEV.	
DESIGNED BY	CLS
DRAWN BY	GCN
1 ISSUED FOR ADDENDUM #1	12/03/13
0 ISSUED FOR TENDER	12/02/24
NO. REVISIONS	DATE

KGS GROUP
 CONSULTING ENGINEERS & PROJECT MANAGERS
 WINNIPEG (204) 896-1209
 THUNDER BAY (807) 345-2233

DESIGNED BY	CLS	CHECKED BY	
DRAWN BY	GCN	APPROVED BY	
HOR. SCALE:	AS SHOWN	RELEASED FOR CONSTRUCTION:	
VERTICAL:		DATE	

ENGINEER'S SEAL
 THE ORIGINAL ISSUE REV. 0 WAS STAMPED, DATED AND SIGNED BY:
 C.P. SURGEONER, P.ENG
 ON 2012/02/24
 CONSULTANT DRAWING NO.
E01

THE CITY OF WINNIPEG
 PLANNING, PROPERTY & DEVELOPMENT

PROJECT TITLE
ST. JAMES CENTENNIAL POOL
 644 PARKDALE STREET
 BID OPPORTUNITY: 45-2012
 UPGRADE HYDRONIC HEATING SYSTEM

SHEET OF
001 OF **004**
 COMPUTER FILE NAME
11-0107-32-E01
 CITY DRAWING NUMBER

BASEMENT MECHANICAL ROOM
 PLAN - DEMOLITION