Rec. of Drawing No. ME-36

DETAILS ELECTRICAL - POWER - PLANS ABOVE ELEVATIONS 740.00 & 750.00

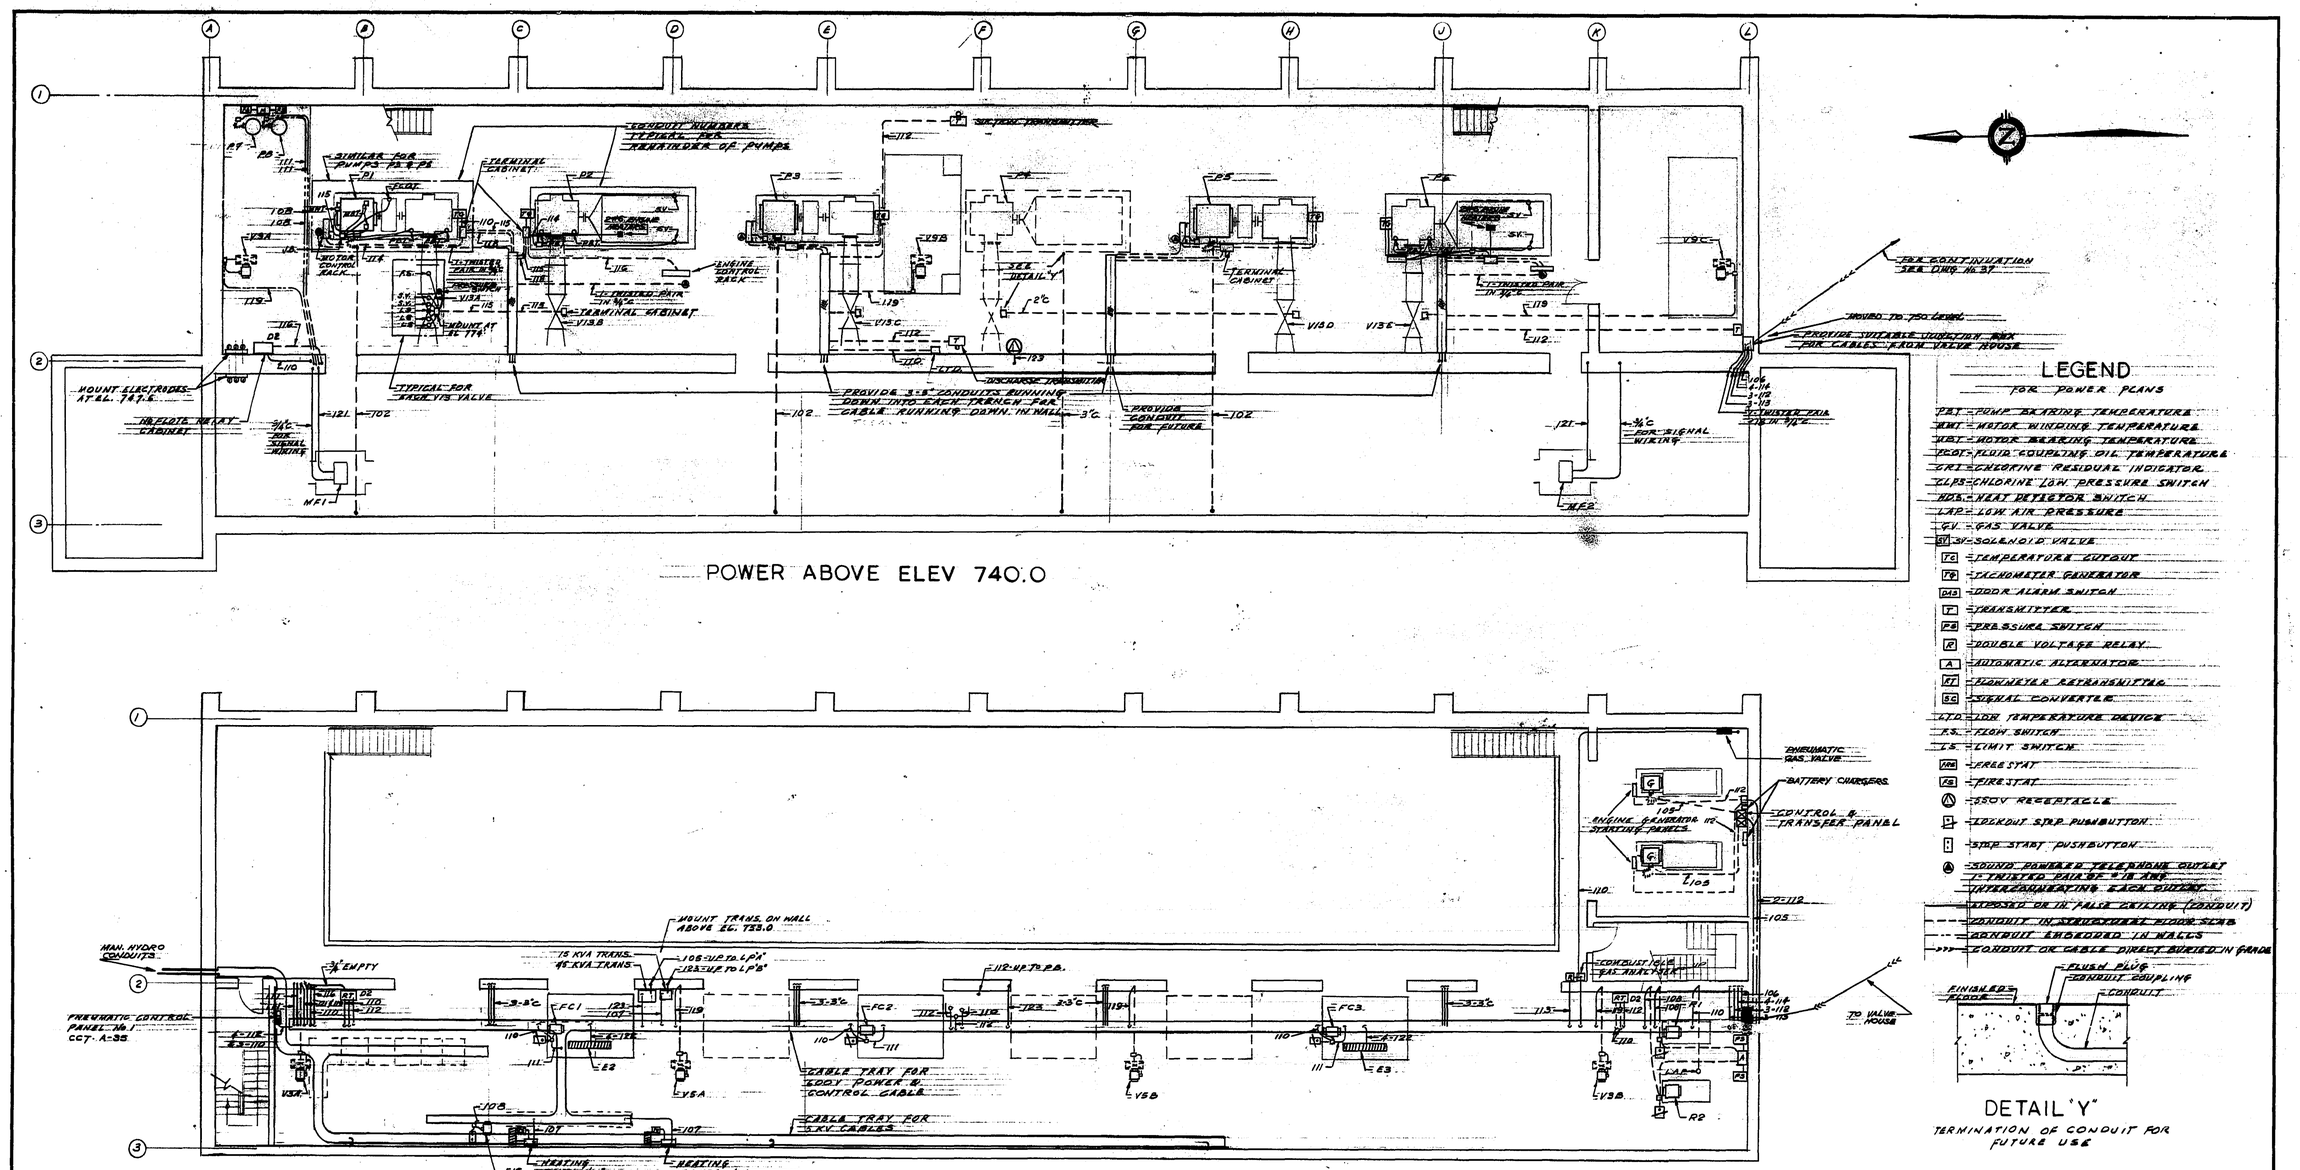

REVISED AS BUILT, JUNE - 1965

THE METROPOLITAN CORPORATION OF GREATER WINNIPEG
WATERWORKS AND WASTE DISPOSAL DIVISION

METRO EAST PUMPING STATION AND RESERVOIR

CONTRACT A — PUMPING STATION ELECTRICAL — POWER, PLANS ABOVE ELEVATIONS 740.00 AND 750.00

JAMES P. MacLAREN ASSOCIATES ENGINEERS TORONTO
THURSTON ENGINEERING COMPANY PROFESSIONAL ENGINEERS WINNIPEG

APPROVED
DESIGN ENGINEER
ENGINEER OF WATERWORKS
DIRECTOR & CHIEF ENGINEER

PROVINCE OF MANITOBA — J. W. MacLAREN — REGISTERED ENGINEER

DATE JUNE 22, 1962 | SCALE AS SHOWN | DWG. No. 29 OF 41 | ME-36

FILE 525-D-4363