



G682, G686,
G687 TERMINALS
①

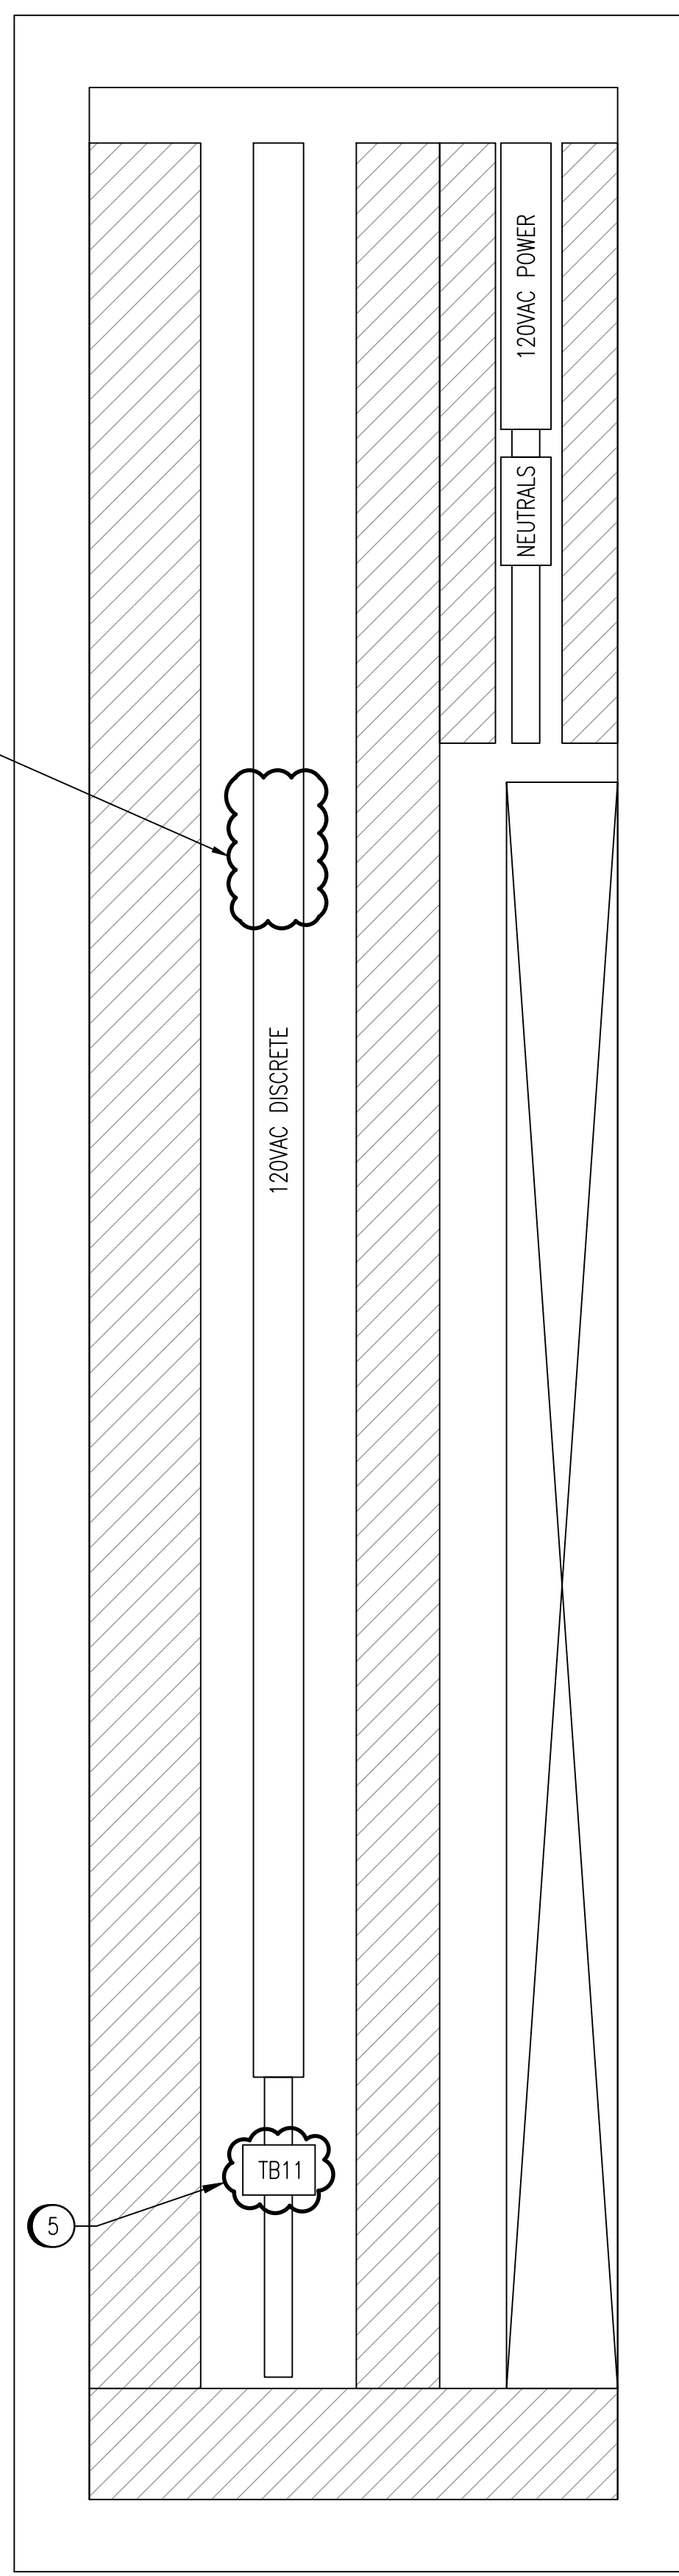


LEFT SIDE
(FUTURE TERMINALS TB11 TO TB19)

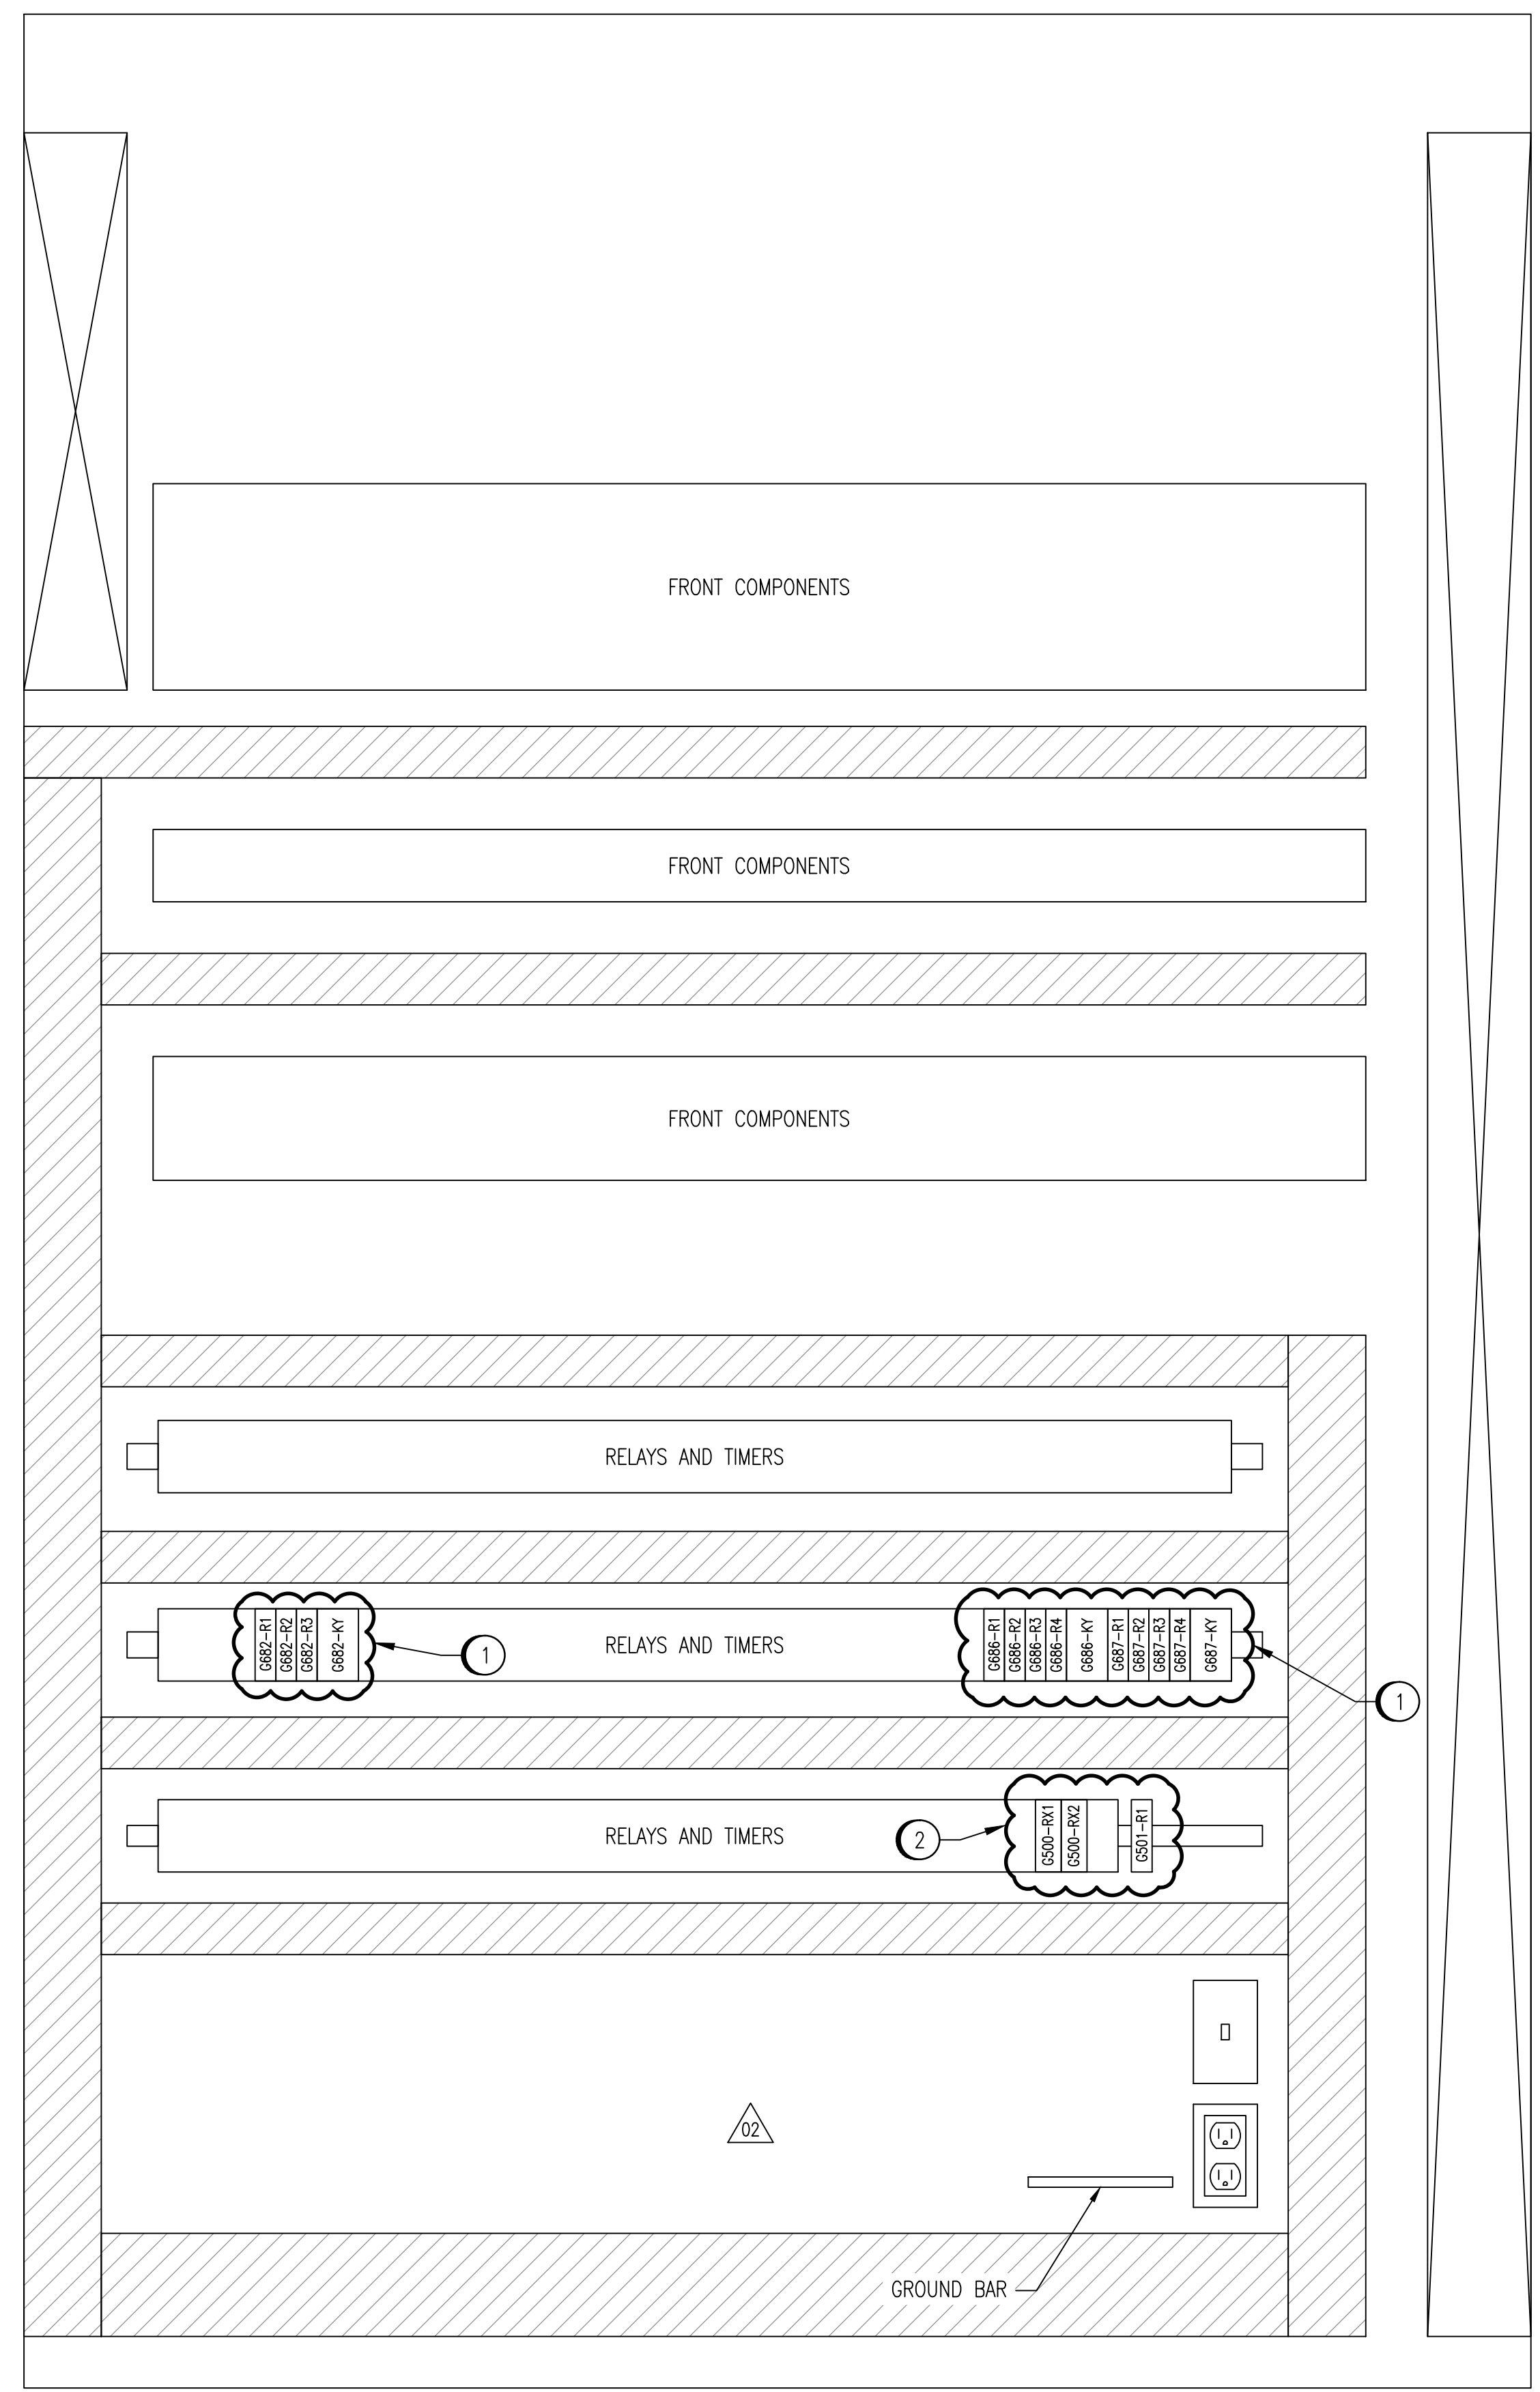

CENTRE
(FUTURE TERMINALS TB21 TO TB29)

NORTH CABINET

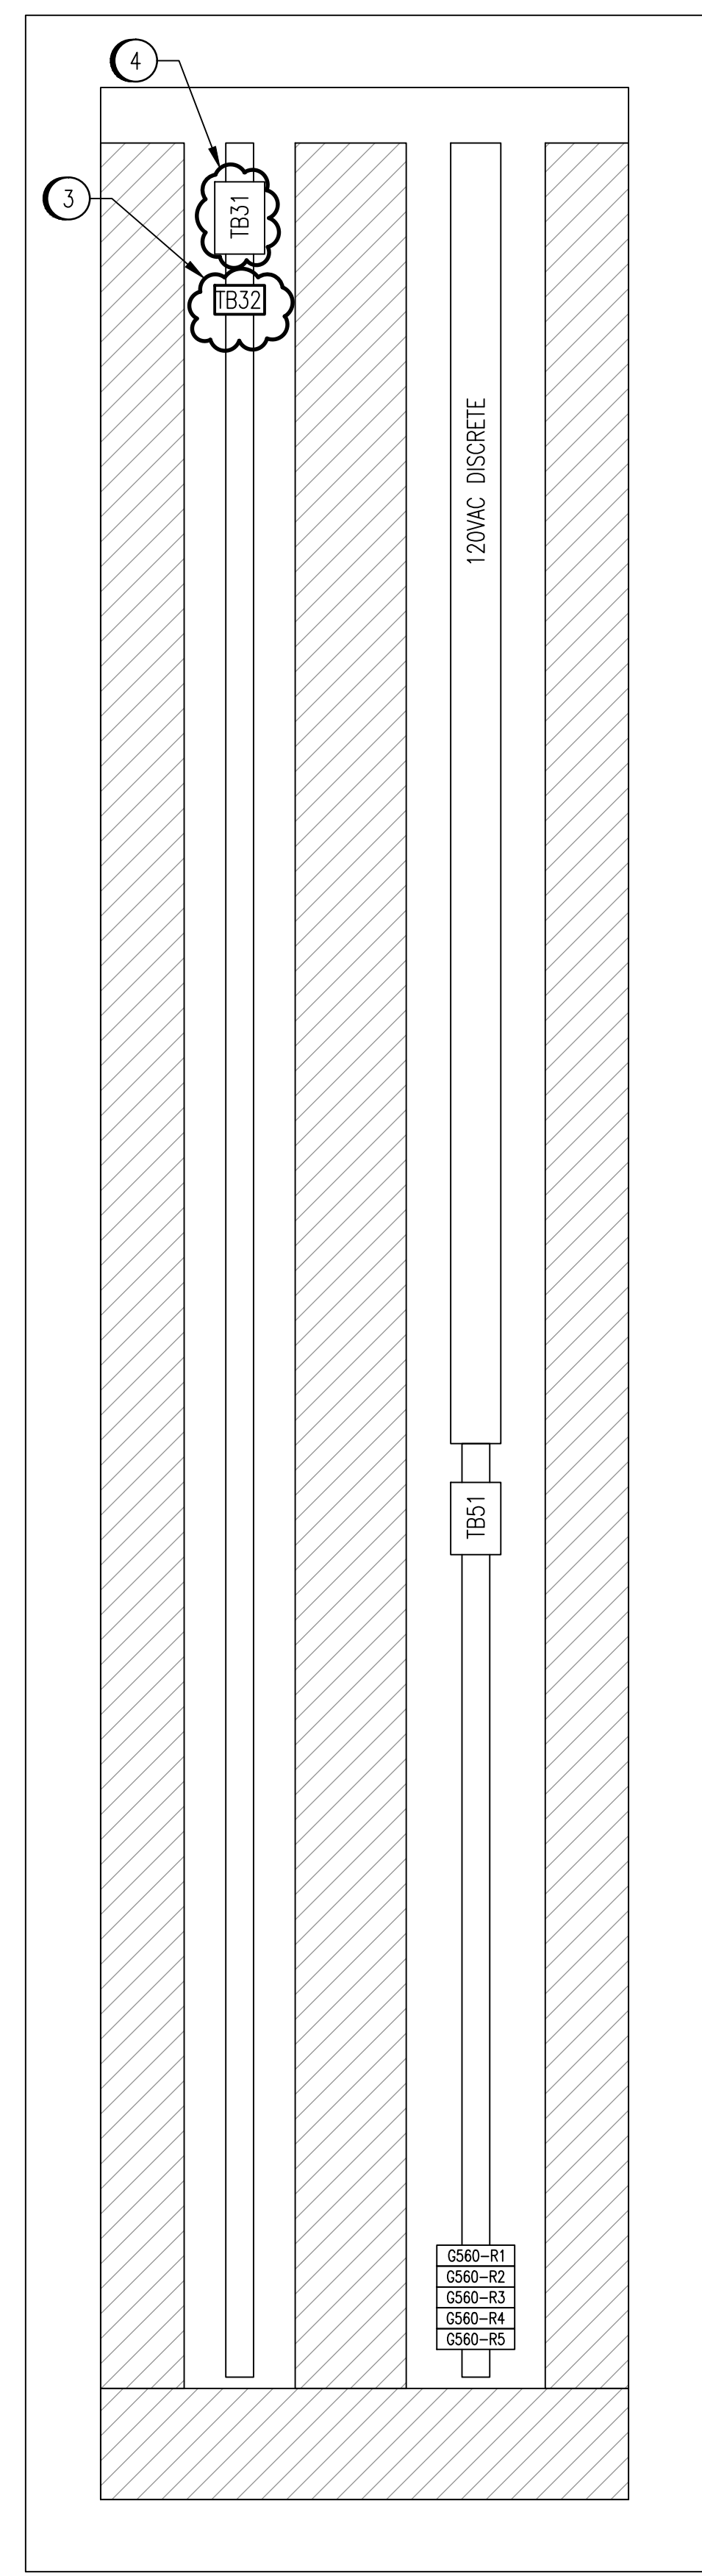

RIGHT SIDE
(FUTURE TERMINALS TB31 TO TB59)

- CONSTRUCTION NOTES:**
- ① REMOVE WIRING AND DEVICES FROM FDP-G. ENSURE NO OTHER WIRING IS AFFECTED DURING THE REMOVAL PROCESS.
 - ② RENAME AND MODIFY WIRING TO G500-RX1 AND G500-RX2. ADD RELAY G501-R1.
 - ③ ADD TB32 FOR BOILER ROOM SUMP LEVEL TRANSMITTER.
 - ④ ADD TERMINALS TO TB31
 - ⑤ ADD TB11 FOR VENTILATION INTERLOCKS.

NOTES:
 1. THIS DRAWING SUPERCEDES PART OF SEP-840.

NO.	REVISIONS	DATE	DESIGN	CHECK
02	REMOVED G686-EF, G687-EF, & G682-AHU, BID OPP. 545-2012	2012/08/31	TMC	CJR
01	UPS AND GAS DETECTION MODIFICATIONS	2011/03/11	TMC	CJR
00	ISSUED FOR TENDER	2010/10/01	TMC	CJR

SNC-LAVALIN INC.
 148 Nature Park Way
 Winnipeg, MB, Canada R3P 0X7
 204-786-8080

DESIGNED BY: I. CHURCH
 CHECKED BY: C. REIMER
 DRAWN BY: S. COATES
 APPROVED BY: C. REIMER

SCALE: 1:5
 RELEASED FOR CONSTRUCTION BY: J. VEILLEUX
 DATE: 2010/08/12
 DATE: 2010/10/01

CONSULTANT NO.: 112577-0112-480D-0304

THE CITY OF WINNIPEG
 WATER AND WASTE DEPARTMENT

SOUTH END WATER POLLUTION CONTROL CENTRE
 HEADWORKS UPGRADES
 PANEL LAYOUT
 FDP-G REAR VIEW

CITY DRAWING NUMBER: 1-0102G-A0086
 SHEET: 002
 REV: 02
 SIZE: A1