


LAST SAVE: 2012/10/09 - 9:19am
 PATH: M:\112577\0112\4ENG\488&C\DD - General DWG\1-0102G-A0087-001-02.dwg
 A1 SIZE - 594mm x 841mm

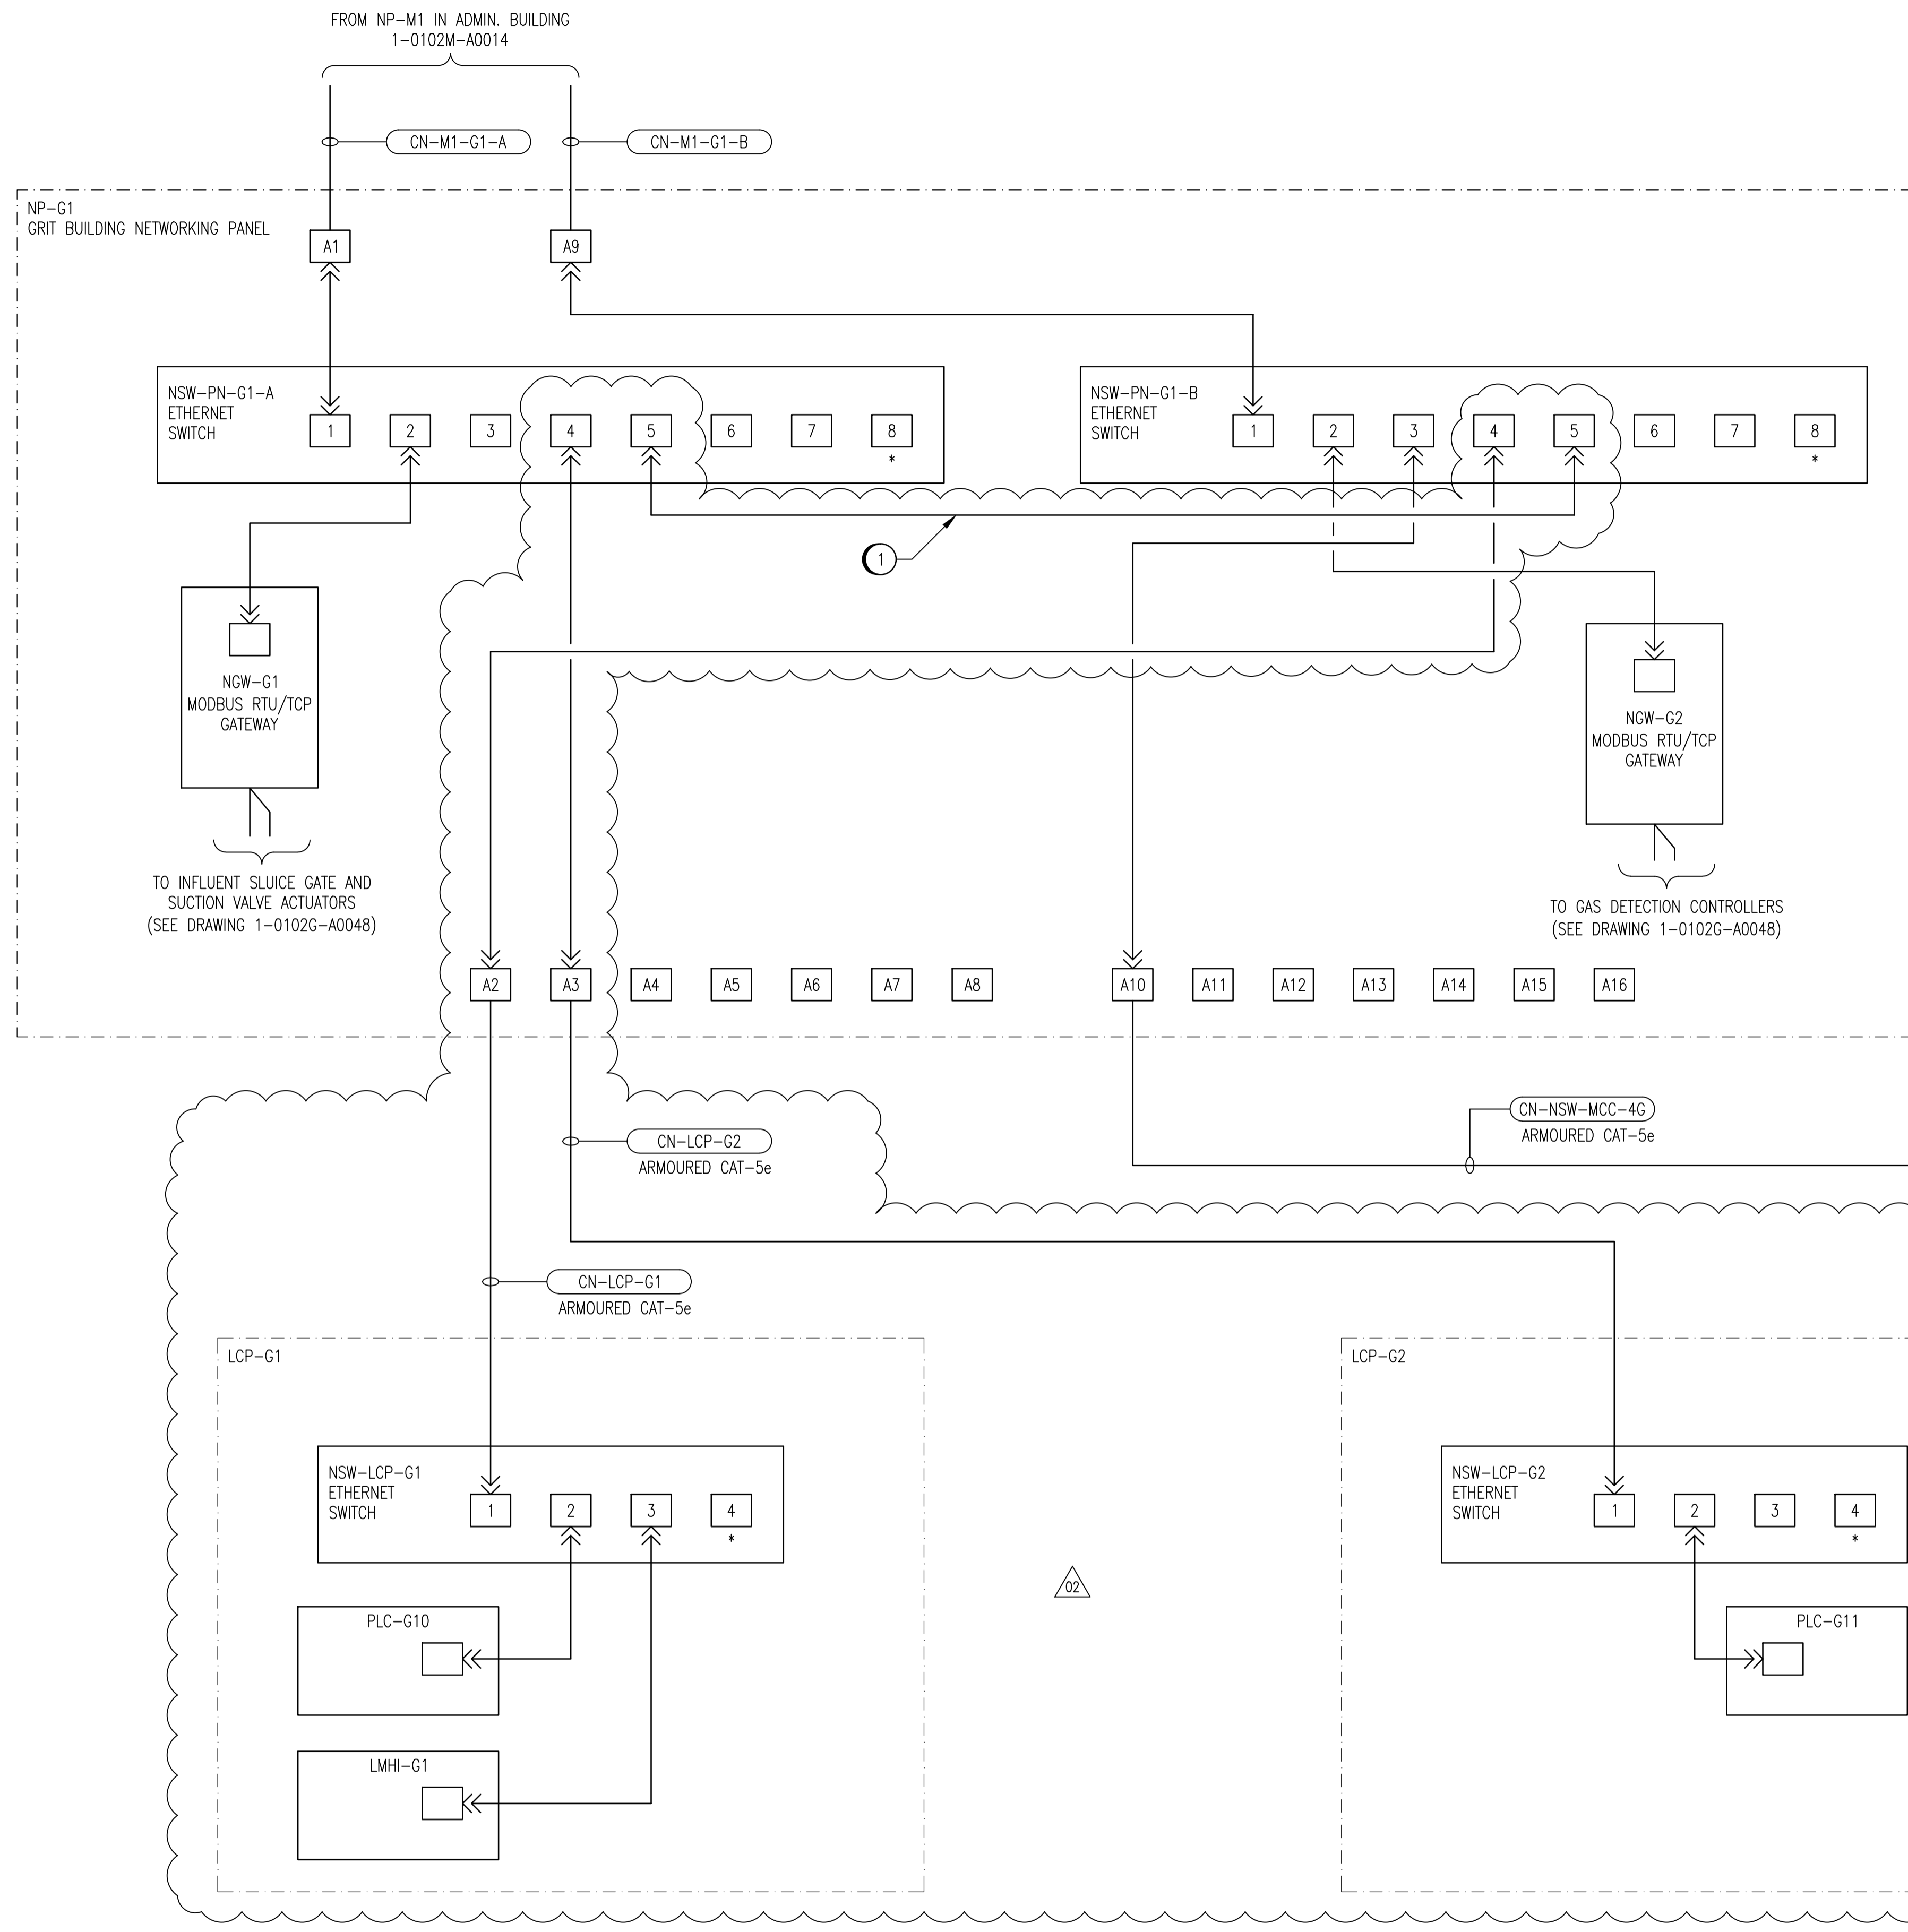

LEGEND:

- RJ45 PORT OR PATCH PANEL
- * RESERVED FOR MAINTENANCE PURPOSES
- ⤴ RJ45 CONNECTOR

CONSTRUCTION NOTES:

1 PROVIDE QUALIFIED NETWORKING SERVICES TECHNICIAN TO SET UP ETHERNET SWITCHES WITH CORRECT LAYER-2 SWITCH PROTOCOLS TO ALLOW FOR RING TOPOLOGY. SWITCHES IN PANEL NP-M1 IN ADMIN BUILDING ARE TO BE INCLUDED IN THIS SET UP.



NO.	REVISIONS	DATE	DESIGN	CHECK
02	ADDED LCP-G1 & LCP-G2, BID OPP. 545-2012	2012/08/31	TMC	CJR
01	ADDED POWER METERING AND GAS DETECTION	2011/03/11	TMC	CJR
00	ISSUED FOR TENDER, BID OPP. 759-2010	2010/10/01	TMC	CJR

 SNC-LAVALIN INC. 148 Nature Park Way Winnipeg, MB, Canada R3P 0X7 204-786-8080	
DESIGNED BY: I. CHURCH	CHECKED BY: C. REIMER
DRAWN BY: S. COATES	APPROVED BY: C. REIMER
SCALE: NTS	RELEASED FOR CONSTRUCTION BY: J. VEILLEUX
DATE: 2010/07/15	DATE: 2010/10/01
CONSULTANT NO.: 112577-0112-48DD-0302	

ENGINEER'S SEAL

THE CITY OF WINNIPEG
 WATER AND WASTE DEPARTMENT

SOUTH END WATER POLLUTION CONTROL CENTER
 HEADWORKS UPGRADES
 NETWORK BLOCK DIAGRAM
 GRIT BUILDING PROCESS NETWORK

CITY DRAWING NUMBER	SHEET	REV.	SIZE
1-0102G-A0087	001	02	A1