


B SIZE - 279mm x 432mm

LAST SAVE: 2012/10/09 - 9:22am
 PATH: M:\112577\0113\4ENG\47ELE\DD - General DWG\1-0102G-A0090-001-01.dwg

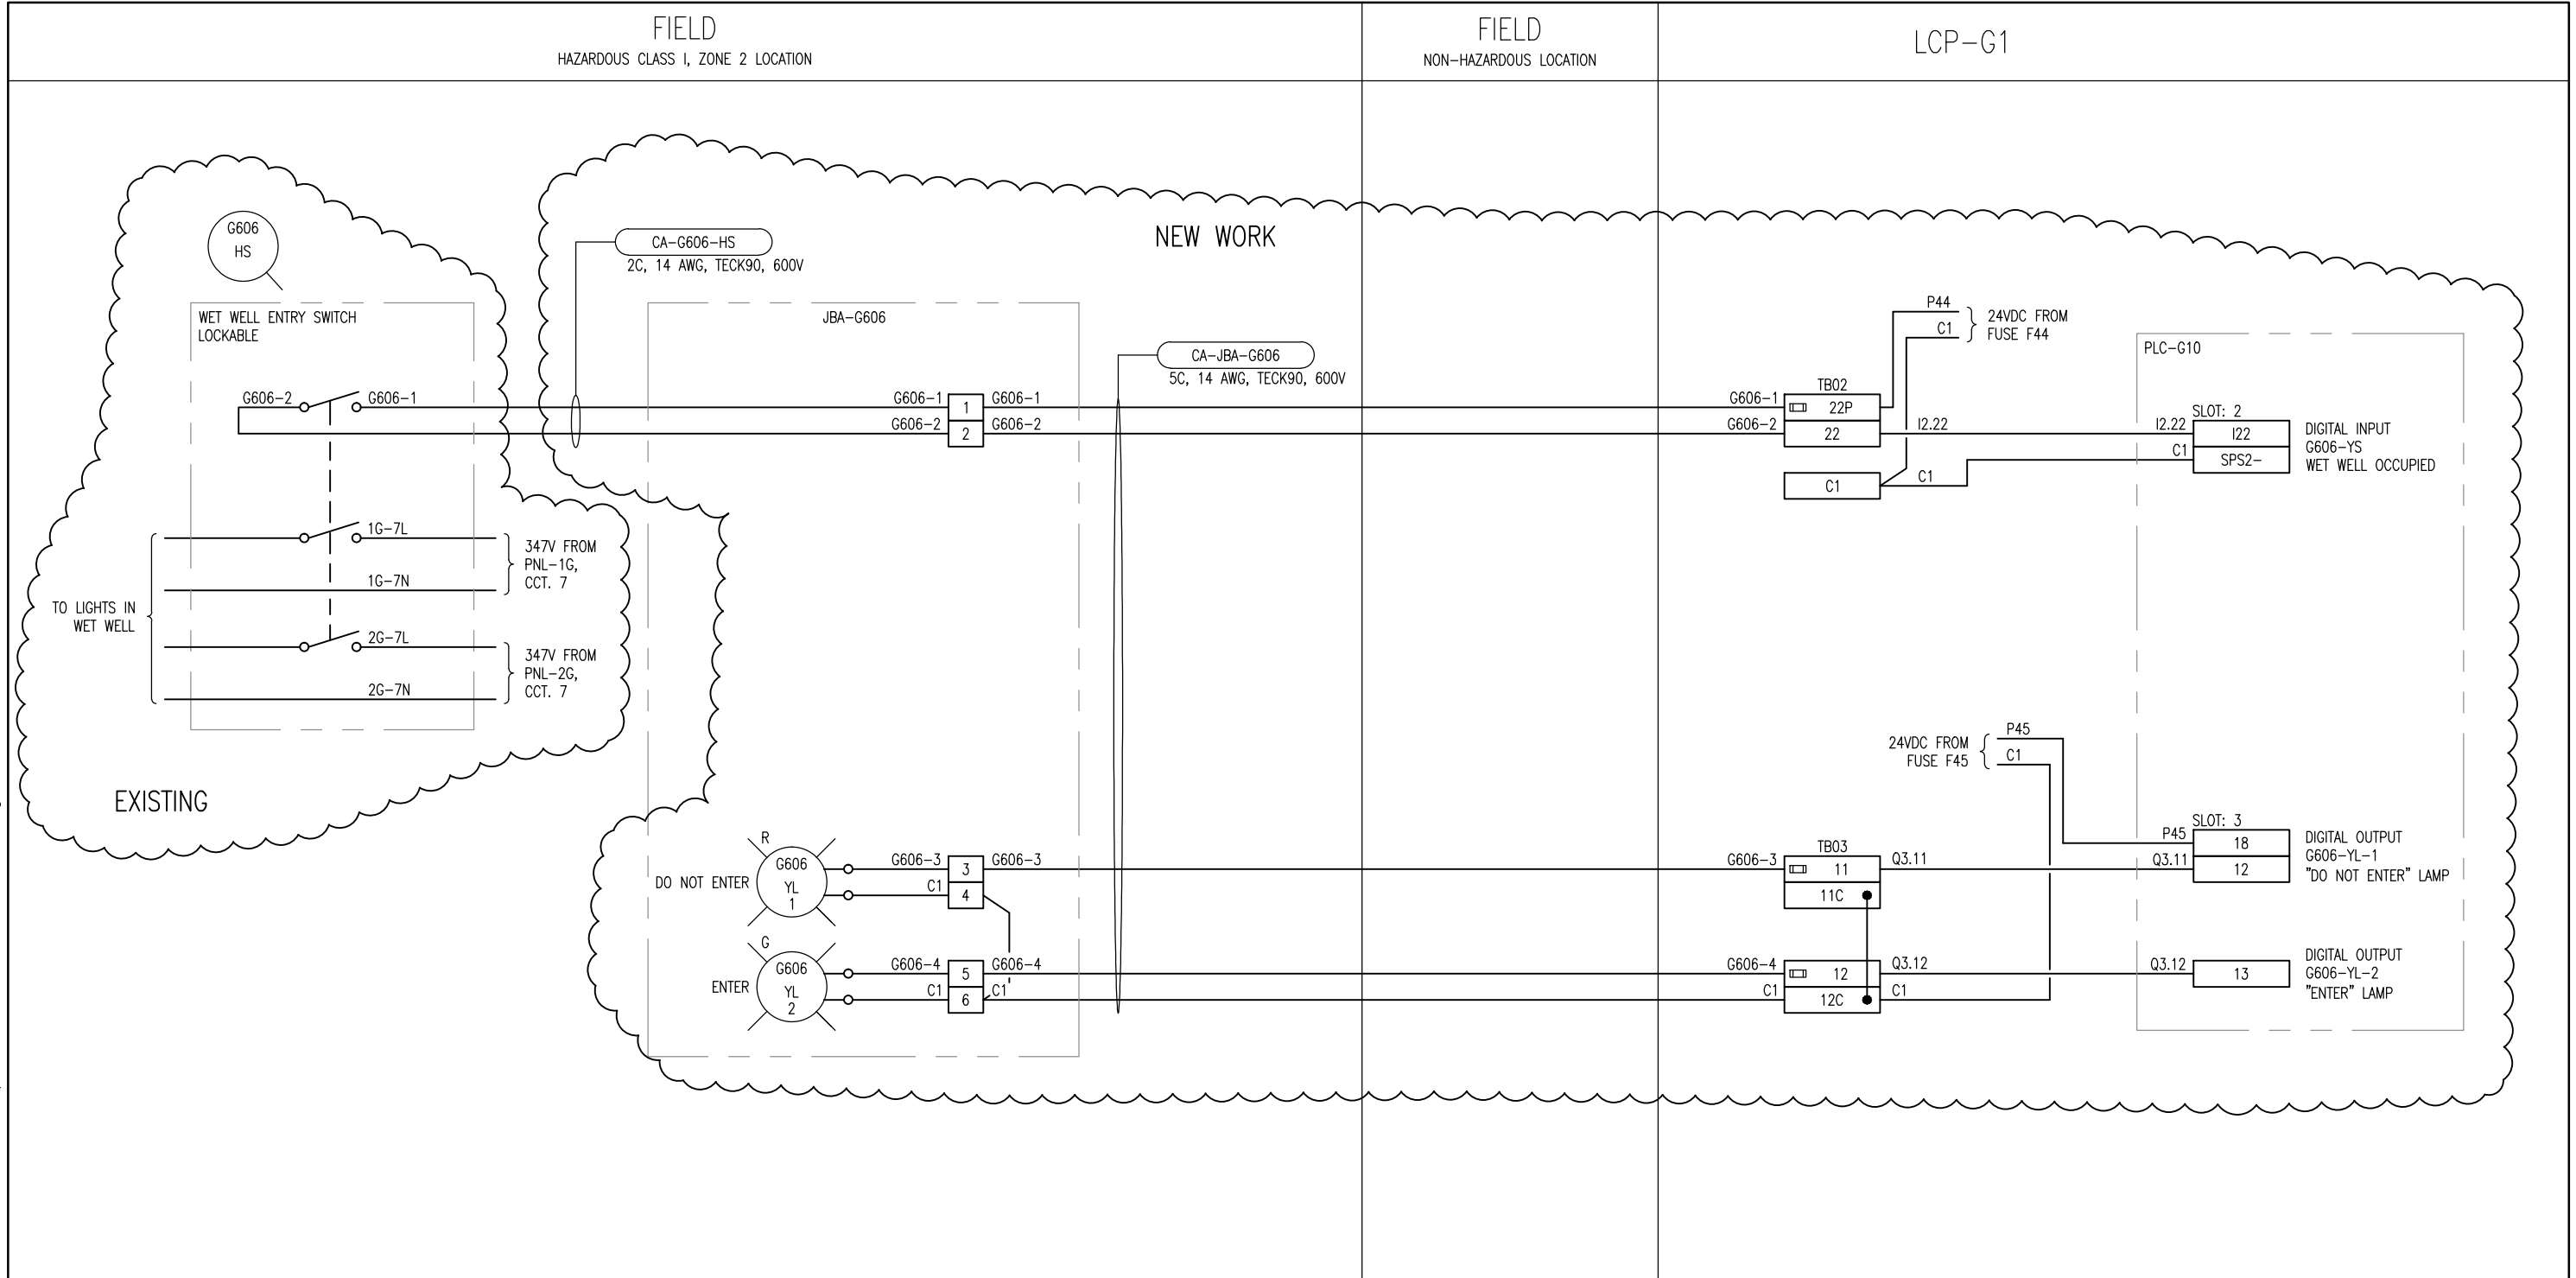

NOTES

- UTILIZE HAZARDOUS RATED TECK CABLE CONNECTORS.



SNC-LAVALIN INC.
 148 Nature Park Way
 Winnipeg, MB, Canada R3P 0X7
 204-786-8080

ENGINEER'S SEAL

NO.	REVISIONS	DATE	DESIGN	CHECK
01	ADDED CONNECTION TO LCP-G1, BID OPP. 545-2012	2012/08/31	TMC	CJR
00	ISSUED FOR TENDER, BID OPP. 7-2012	2012/02/08	TMC	CJR

DESIGNED BY: T. CHURCH	CHECKED BY: C. REIMER
DRAWN BY: MJ. PERSSON	APPROVED BY: C. REIMER
SCALE: NTS	DATE: 2011/12/15
RELEASED FOR CONSTRUCTION	
BY: N. HARRINGTON	DATE: 2012/02/15
CONSULTANT NO.: 112577-0113-47DD-0225	



THE CITY OF WINNIPEG
 WATER AND WASTE DEPARTMENT

SOUTH END WATER POLLUTION CONTROL CENTRE
 ELECTRICAL CLASSIFICATION UPGRADES
 LOOP DIAGRAM
 G606-HS, G606-YL-1, G606-YL-2

CITY DRAWING NUMBER	SHEET	REV.	SIZE
1-0102G-A0090	001	01	B