


SECTION C
LD-5842
SCALE 1:40
FLOOD CONTROL STRUCTURE



SECTION D
LD-5842
SCALE 1:40
FLOOD CONTROL STRUCTURE

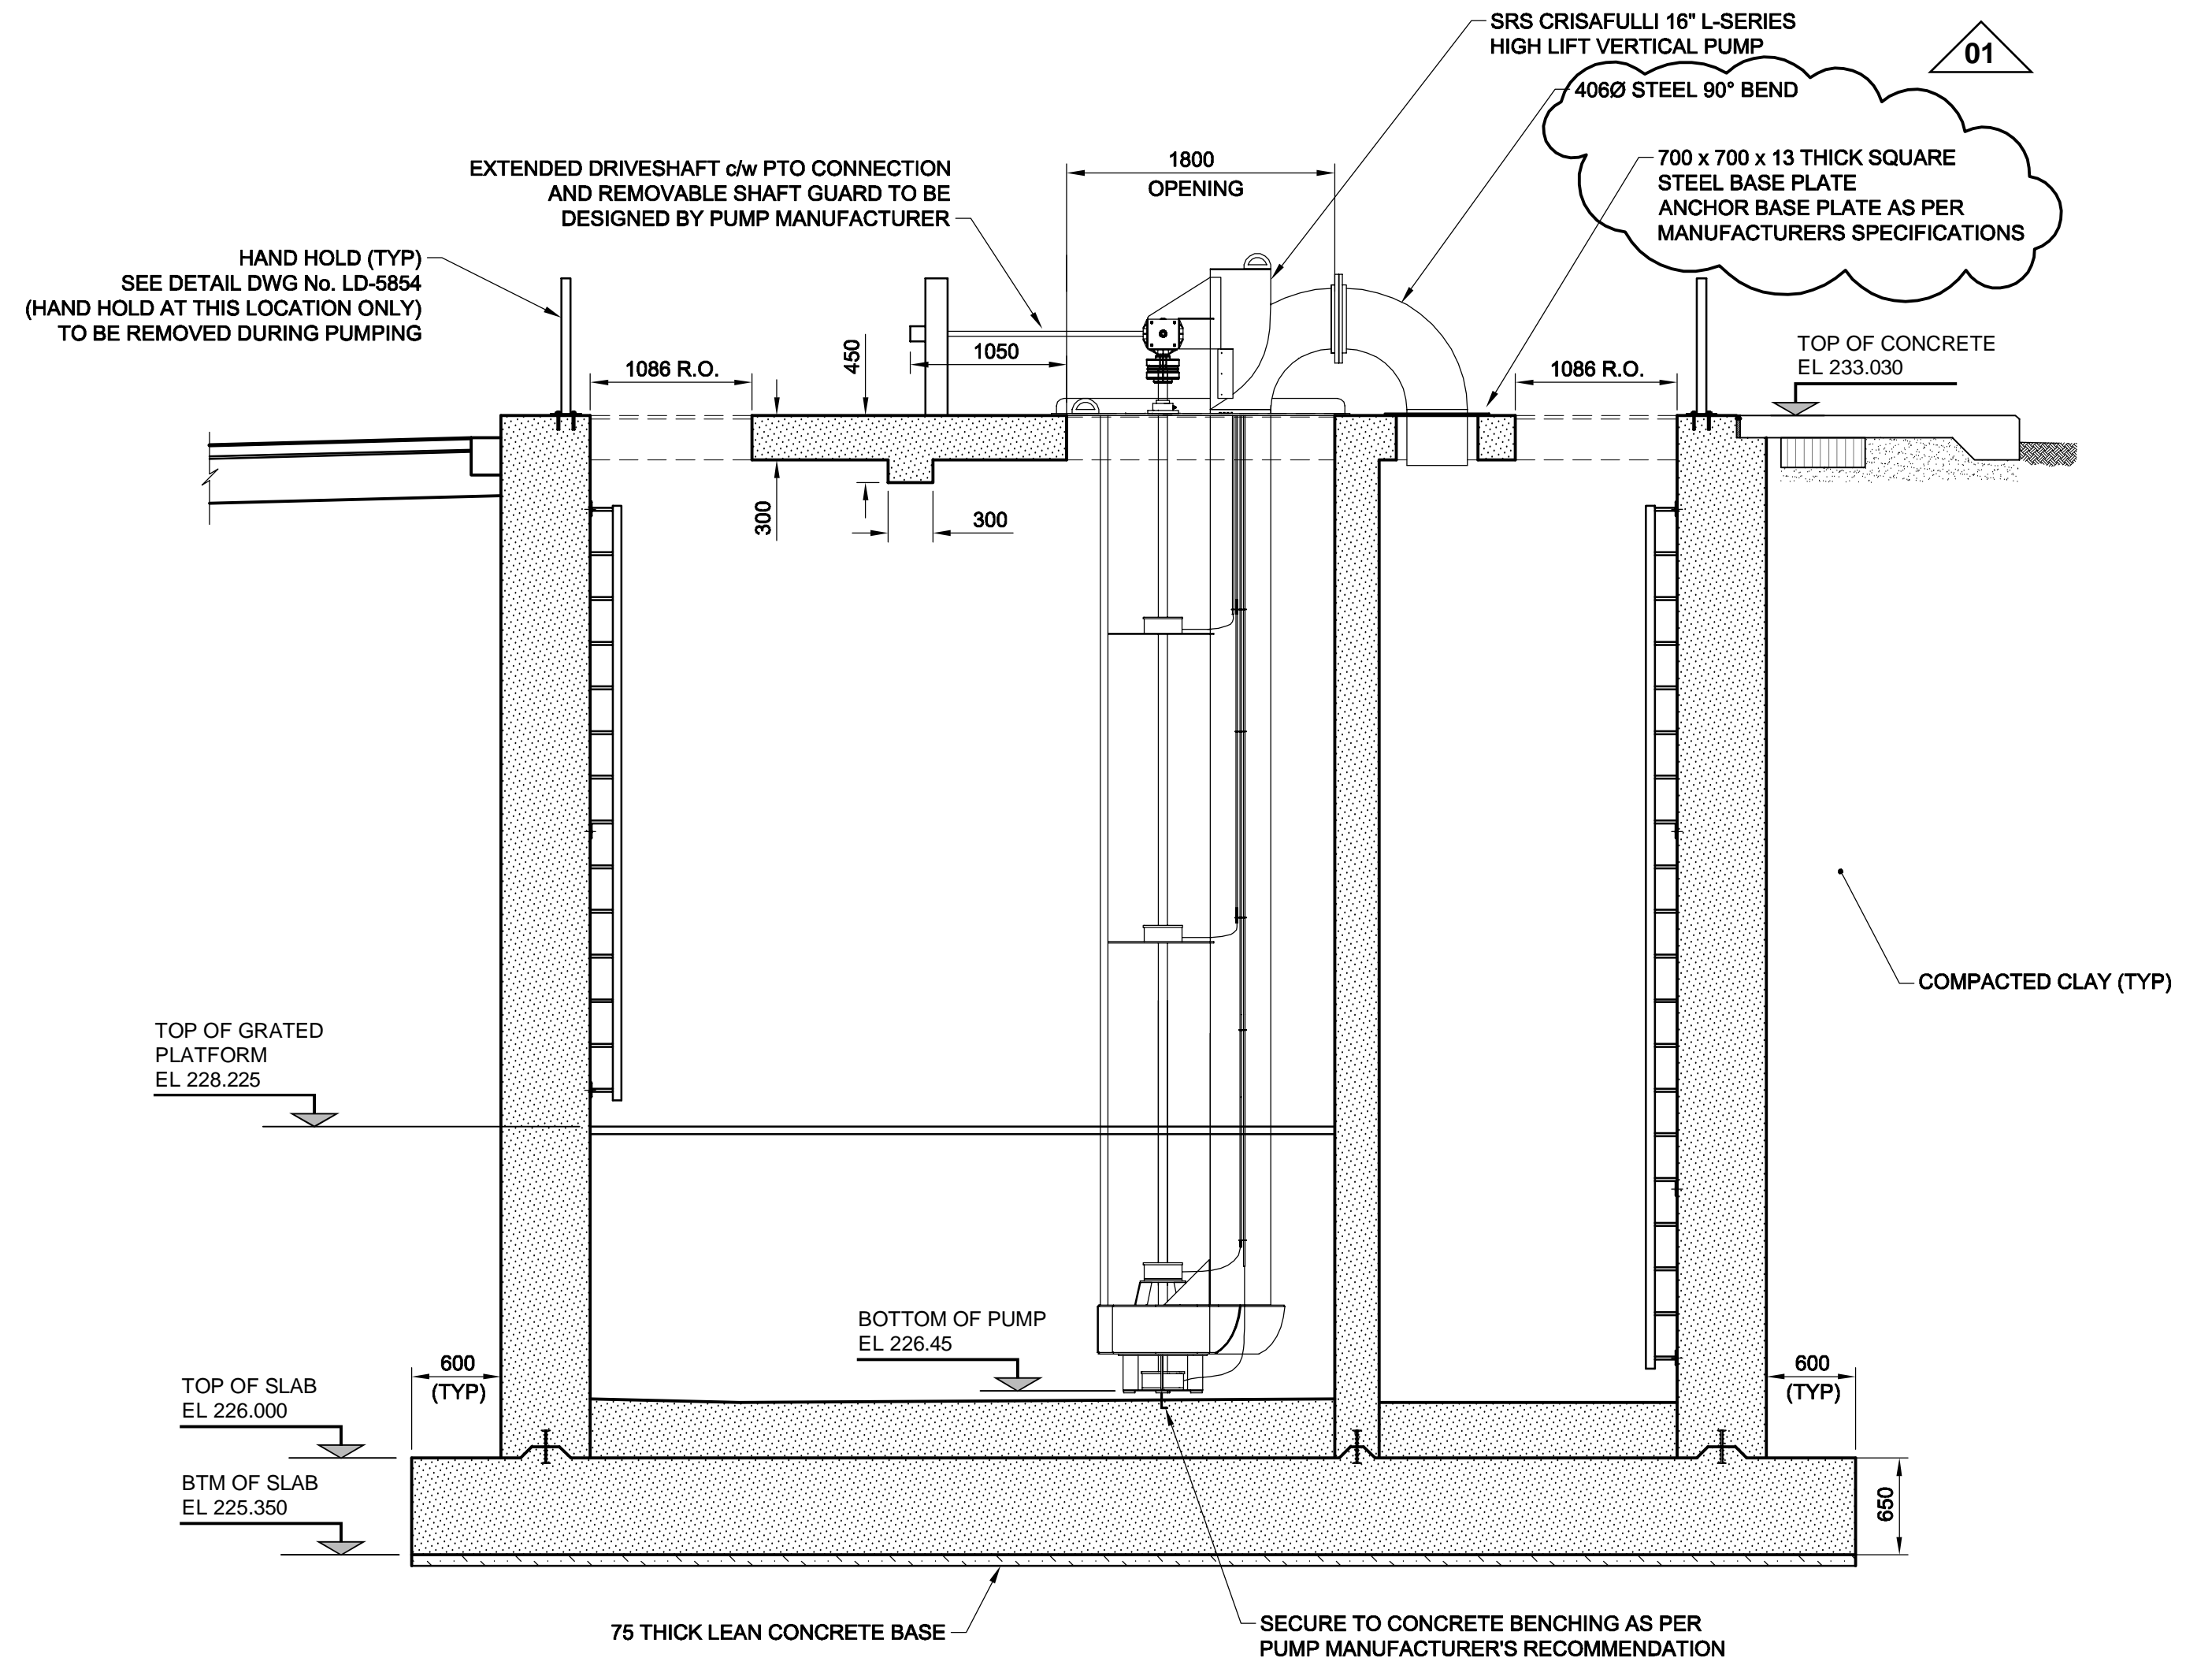

LOCATION APPROVED UNDERGROUND STRUCTURES

SUPR. U/G STRUCTURES	DATE	COMMITTEE

NOTE:
LOCATION OF UNDERGROUND STRUCTURES AS SHOWN ARE BASED ON THE BEST INFORMATION AVAILABLE. BUT NO GUARANTEE IS GIVEN THAT ALL EXISTING UTILITIES ARE SHOWN OR THAT THE GIVEN LOCATIONS ARE EXACT. CONFIRMATION OF EXISTENCE AND EXACT LOCATION OF ALL SERVICES MUST BE OBTAINED FROM THE INDIVIDUAL UTILITIES BEFORE PROCEEDING WITH CONSTRUCTION.

NO.	REVISIONS	DATE	BY
1	ADDENDUM 1	12/08/16	KLC
0	ISSUED FOR CONSTRUCTION	12/07/27	WJd/KLC

AECOM	
DESIGNED BY JAT	CHECKED BY JAT
DRAWN BY WJd	APPROVED BY BTW
HOR. SCALE 1:100	RELEASED FOR CONSTRUCTION
VERT. SCALE N/A	DATE
DATE 12/07/30	

METRIC
WHOLE NUMBERS INDICATE MILLIMETRES
DECIMALIZED NUMBERS INDICATE METRES

PROFESSIONAL'S SEAL

ORIGINAL SIGNED BY:
A. NAGY
JULY 27, 1012

CONSULTANT DRAWING NO.
60221826-02-C-104-R0X.dwg

Winnipeg

**THE CITY OF WINNIPEG
WATER & WASTE DEPARTMENT**

**CONSTRUCTION OF FLOOD CONTROL STRUCTURE
AT PEMBINA HIGHWAY & BEAUJOLAIS COULEE**

CIVIL
FLOOD CONTROL CHAMBER
SECTIONS & DETAILS 3

BID OPPORTUNITY NO. 587-2012

SHEET	5	OF	19
CITY DRAWING NUMBER	LD-5844		
REV	1		