

Figure 1. NEWPCC Raw Sewage Dry Well #1 Dimensional Plan

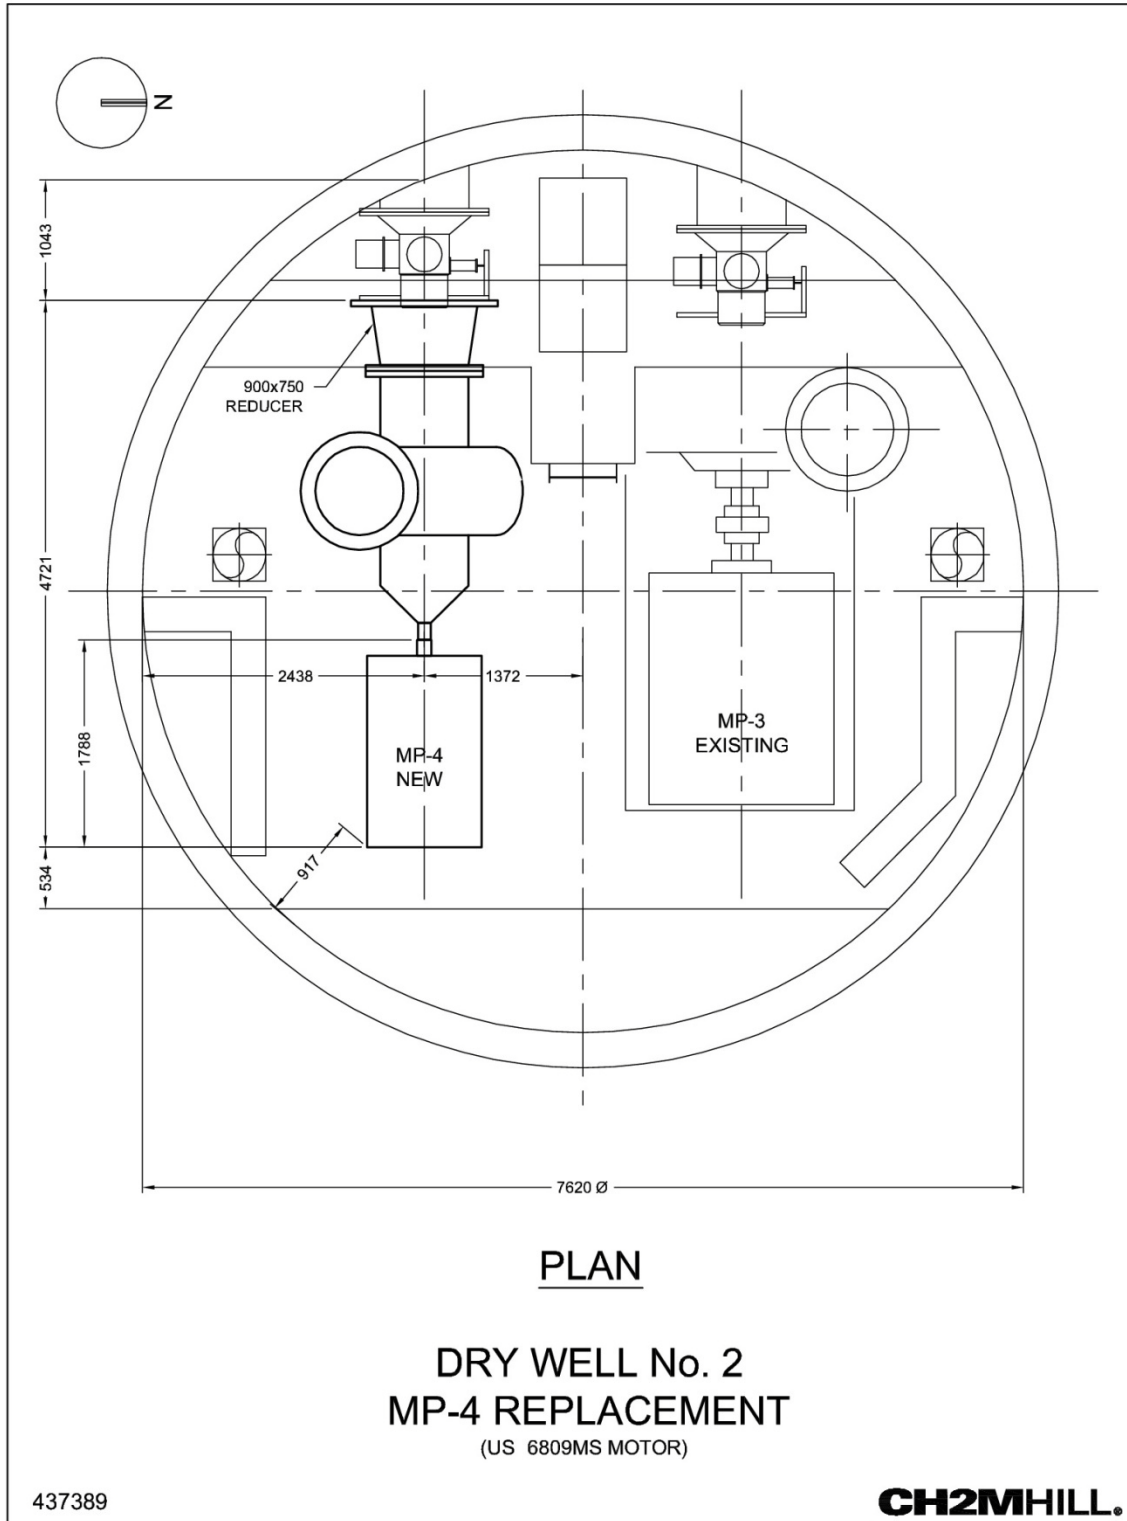


Figure 2. NEWPCC Raw Sewage Dry Well #2 Dimensional Plan

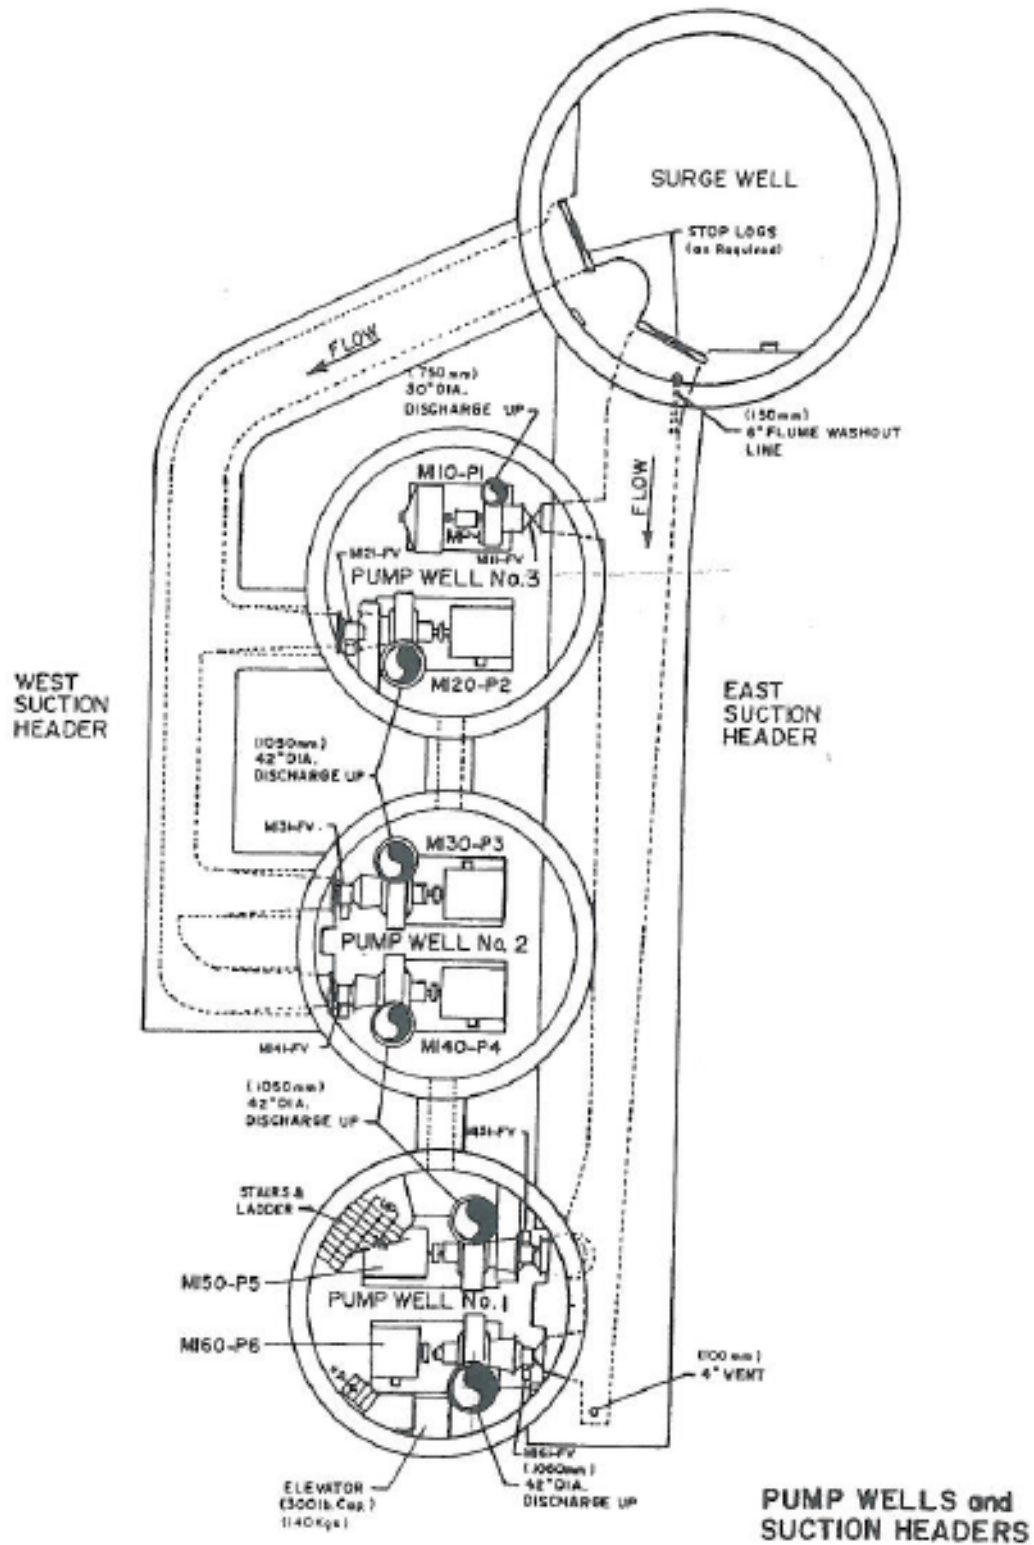


Figure 3: Plan View Dry Well 1, 2 & 3

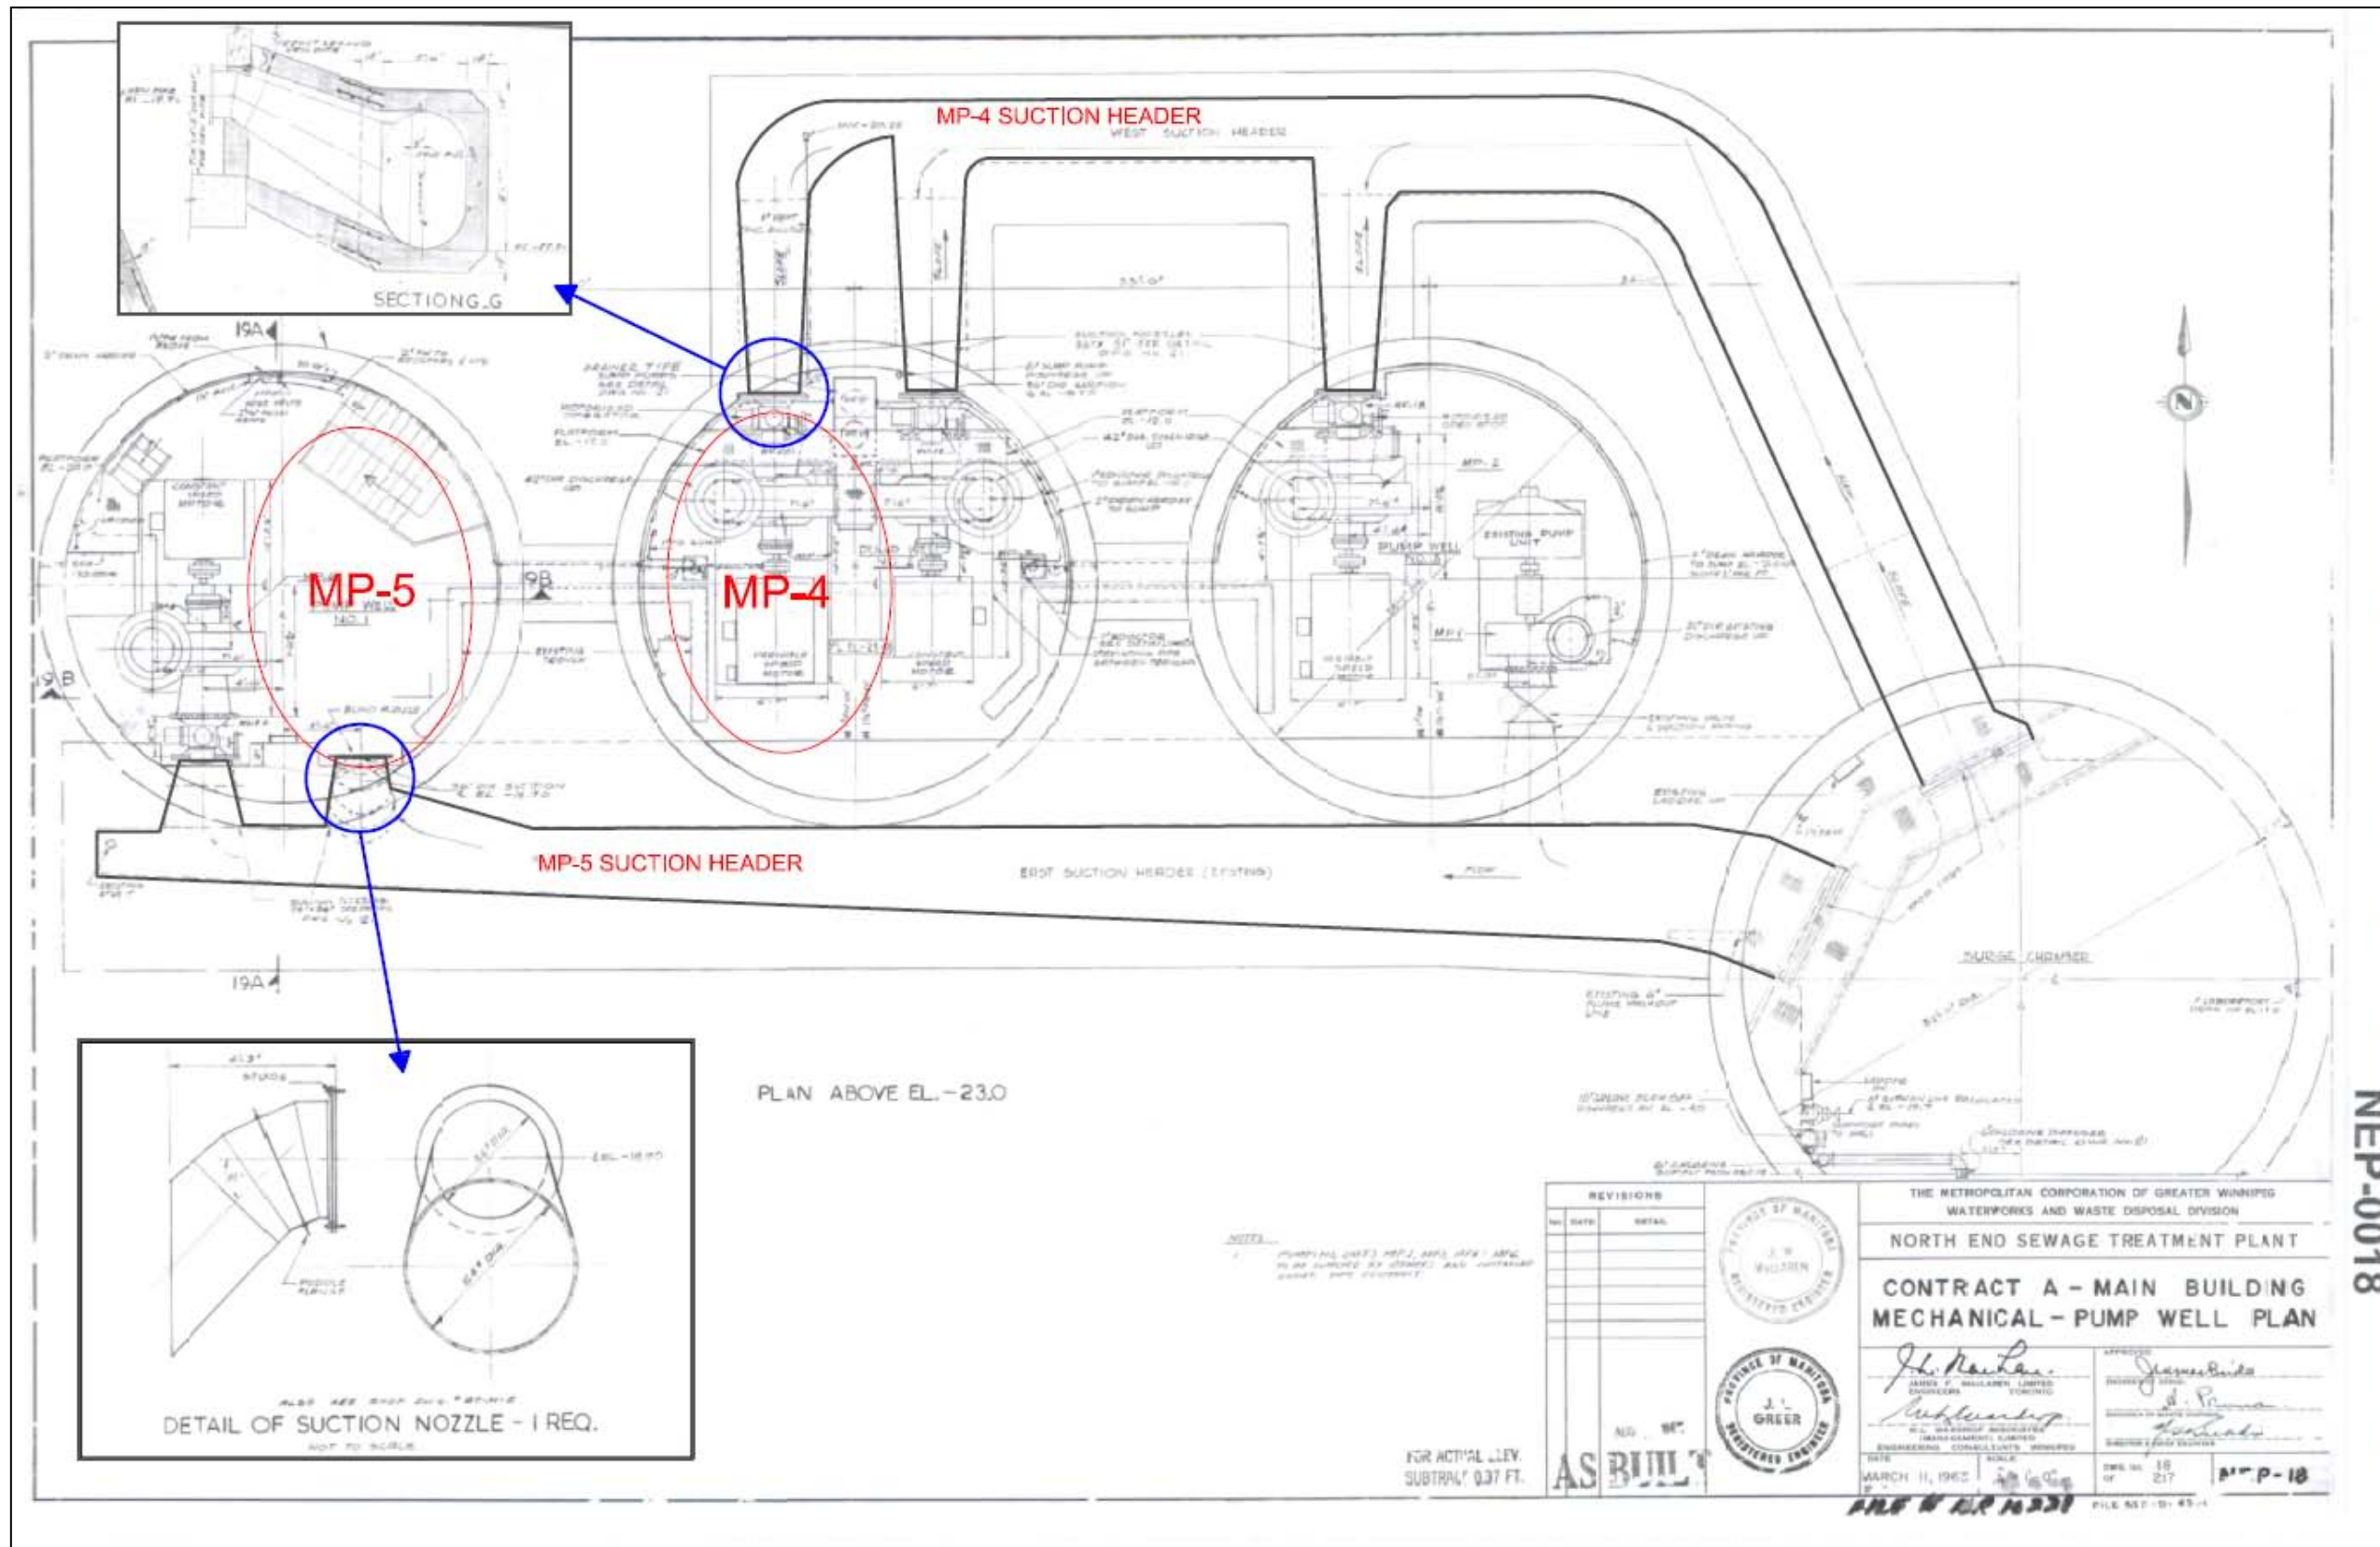


Figure 4. Dry Well Suction Header Details

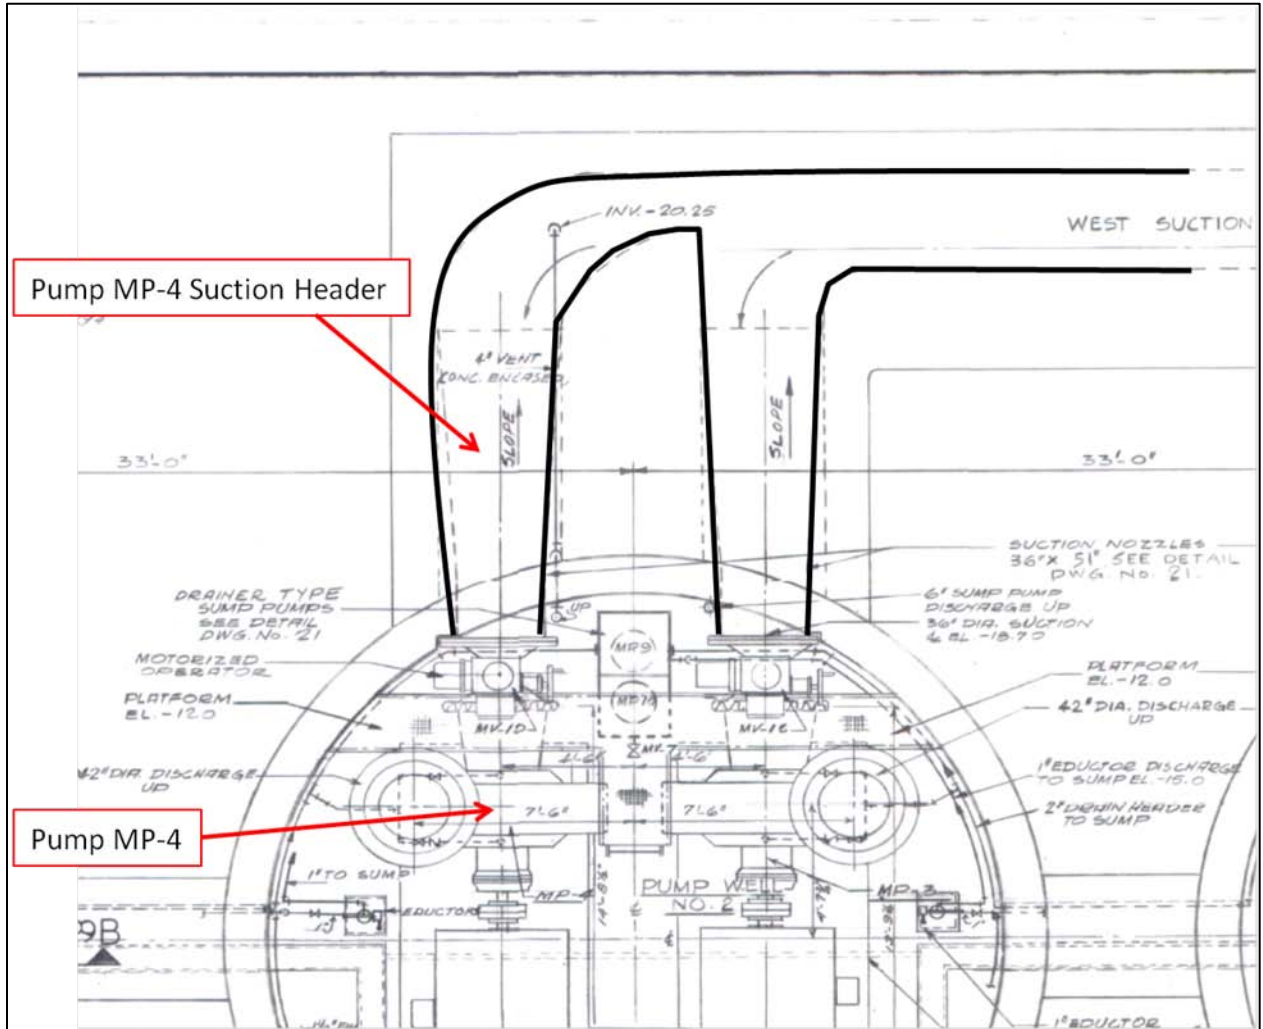


Figure 5. MP-4 Dry Well Suction



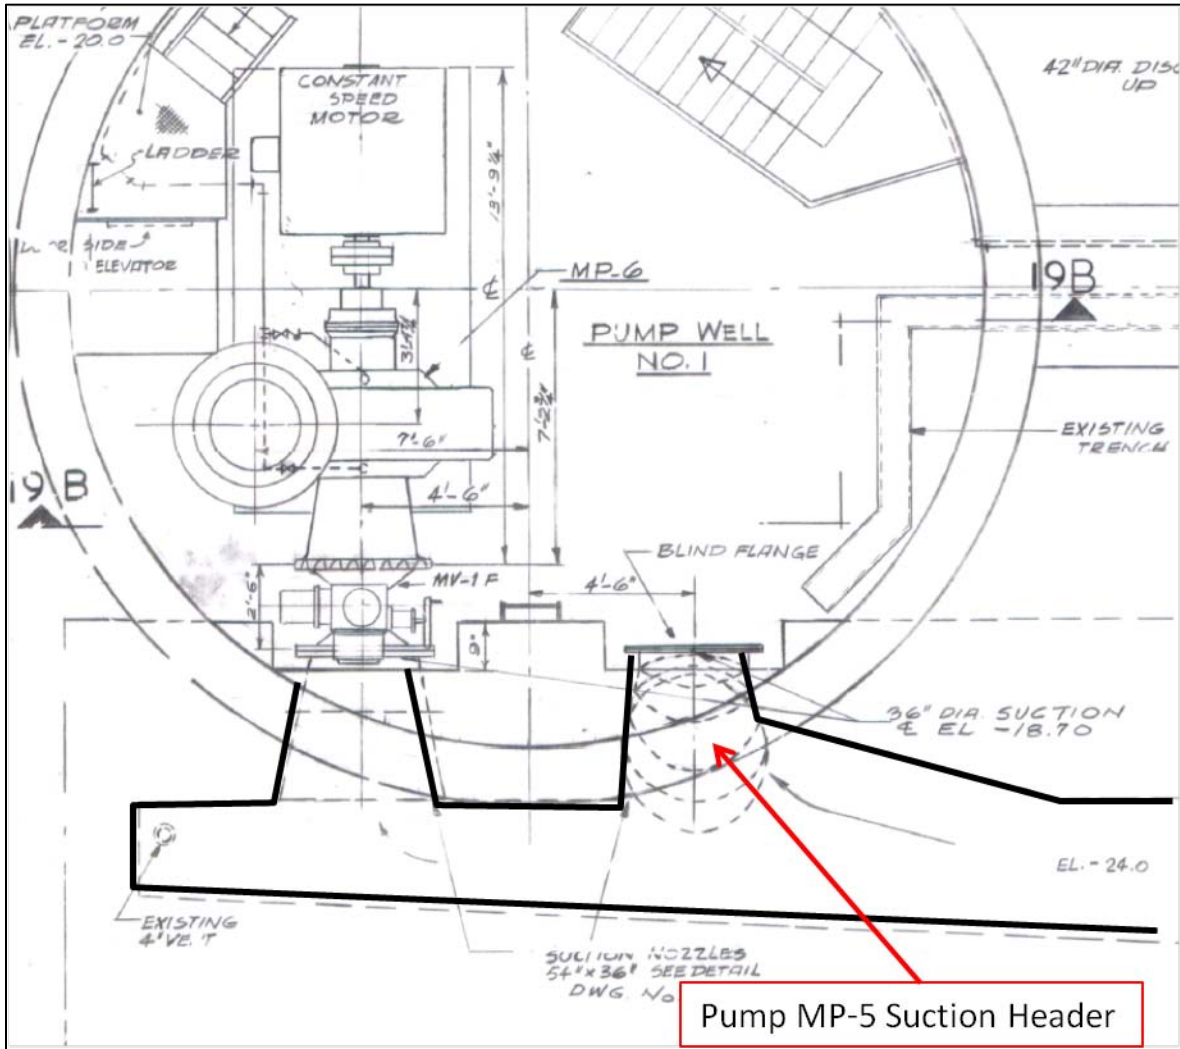


Figure 6. MP-5 Dry Well Suction

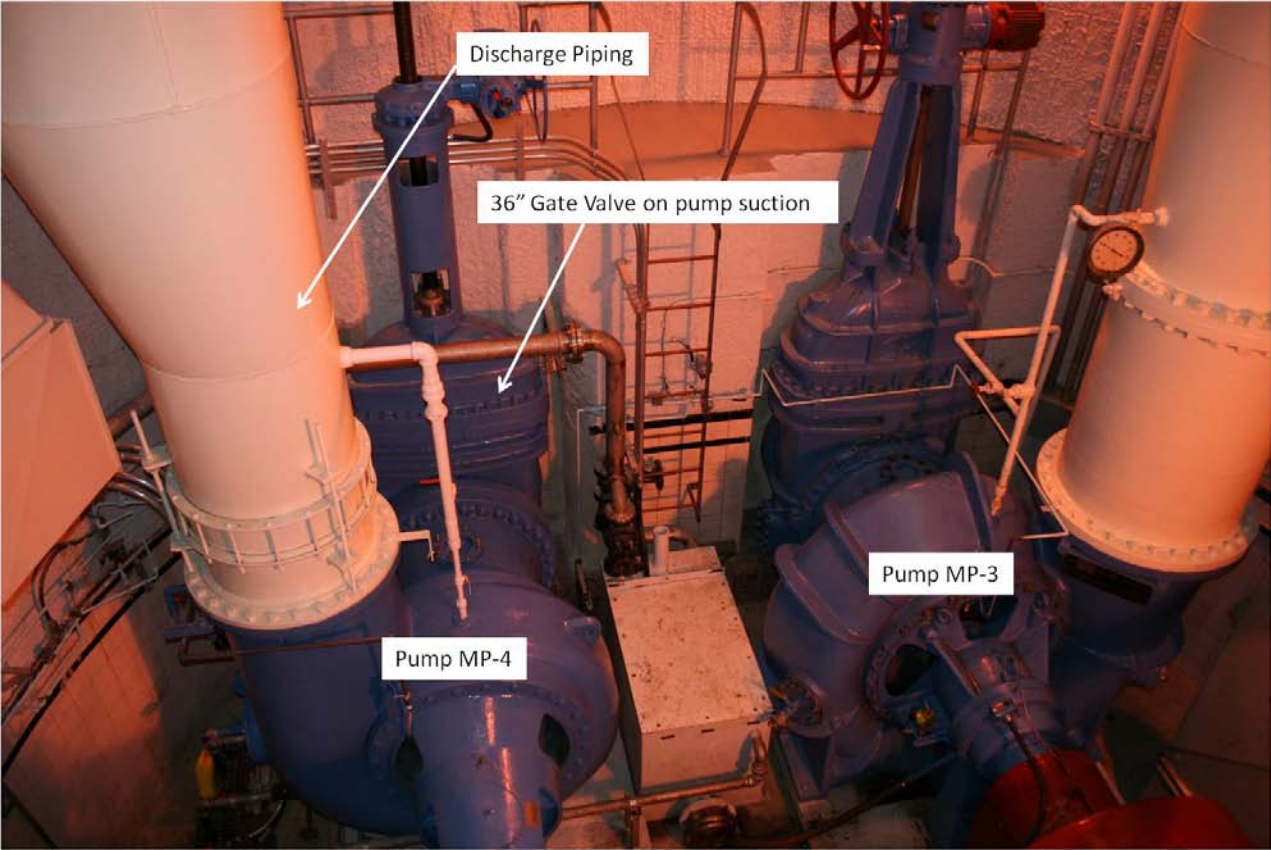


Figure 7. Existing Pumps MP-3 and MP-4 in Dry Well No. 2

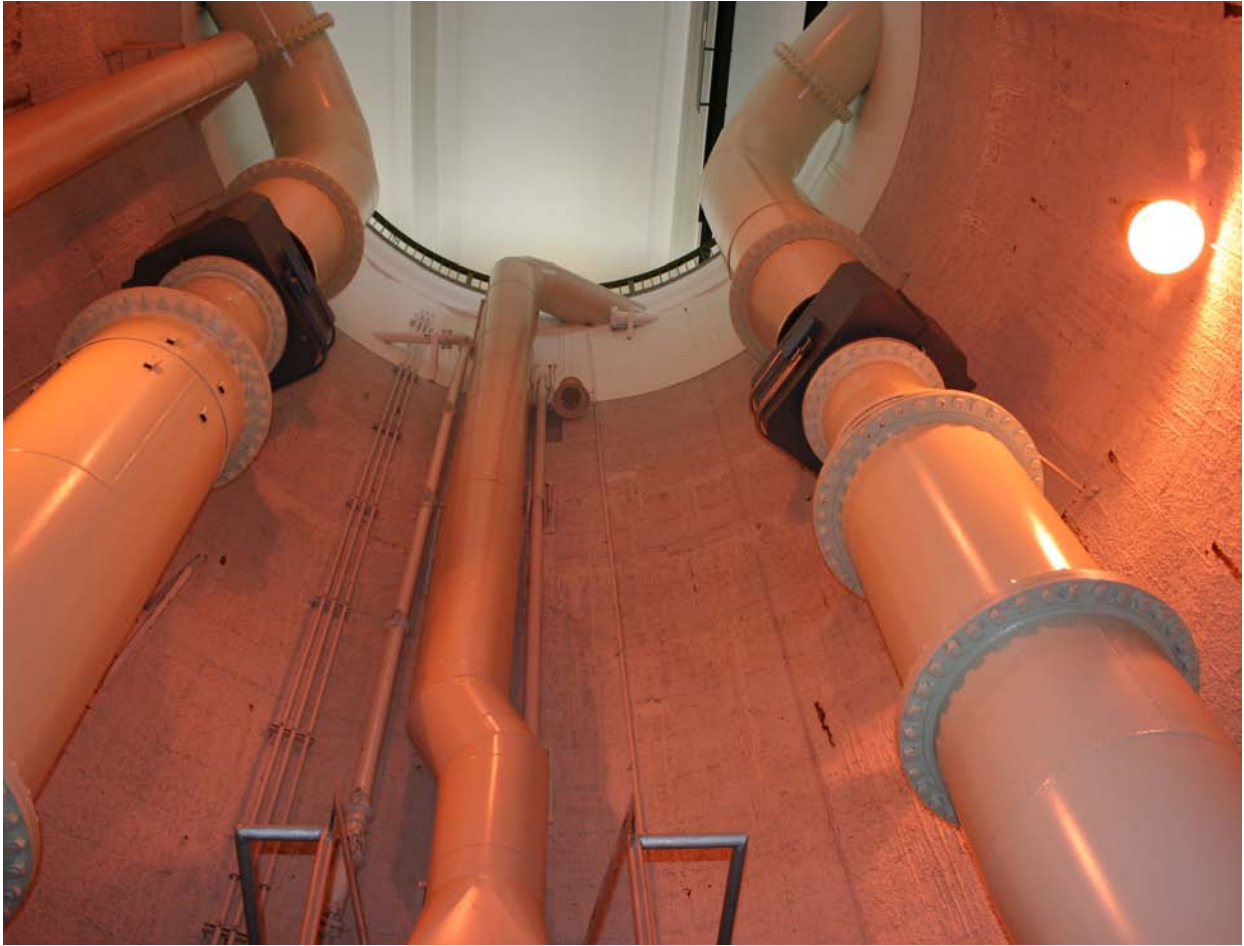


Figure 8. Existing Pump Discharge Piping in Dry Well No. 2

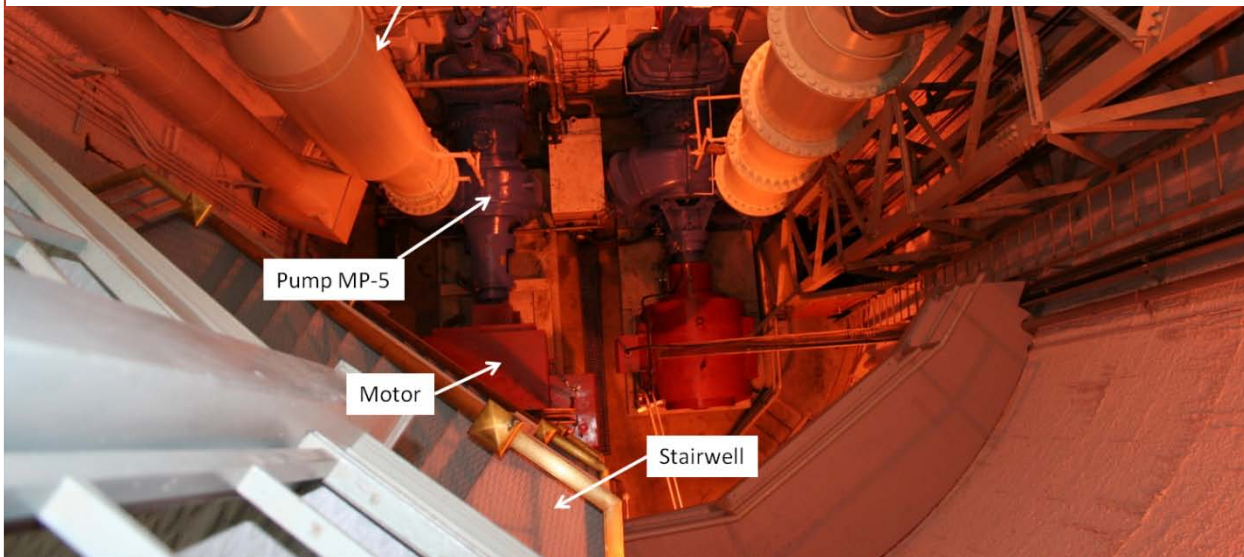


Figure 9. Existing Pump Discharge Piping in Dry Well No. 1