


B SIZE - 279mm x 432mm

LAST SAVE: 2012/02/17 - 3:05pm
 PATH: M:\112577\0106\4ENG\48&C\DD - General DWG\1-0102G-A0062-001-01.dwg

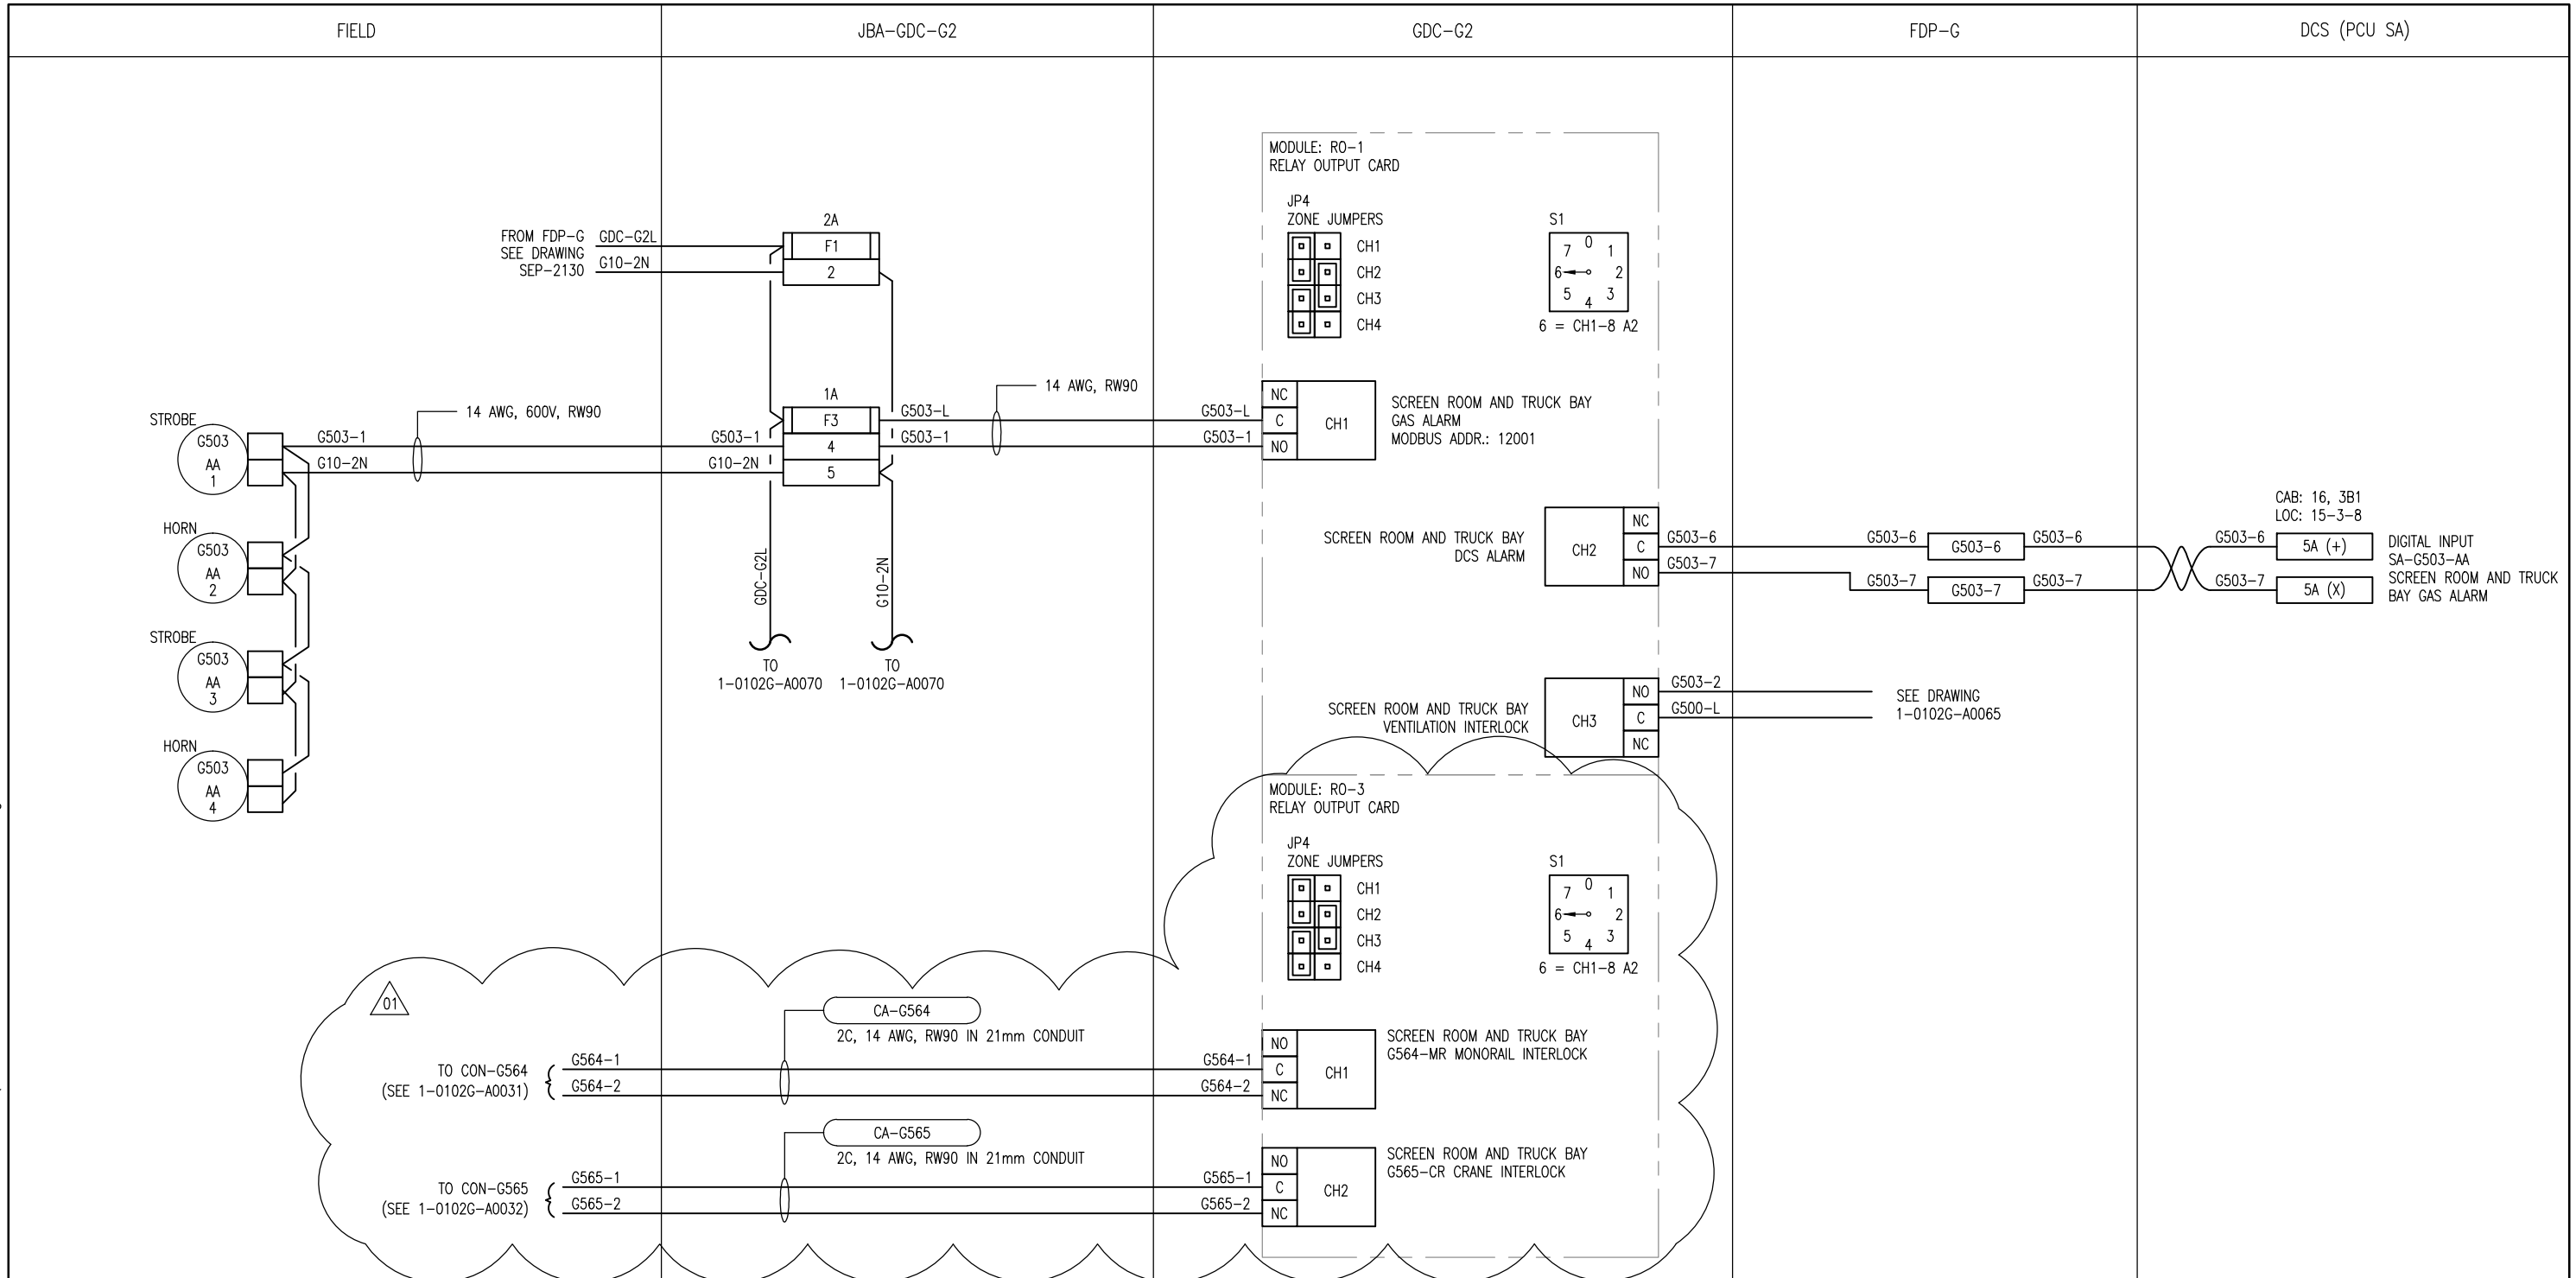

NOTES:

- INSTALL IN ACCORDANCE WITH HAZARDOUS CLASS 1, ZONE 2 REQUIREMENTS.



| NO. | REVISIONS | DATE | DESIGN | CHECK |
|-----|--------------------------------------|------------|--------|-------|
| 01 | ADDED GRANE AND MONORAIL INTERLOCKS | 2012/02/08 | TMC | CJR |
| 00 | ISSUED FOR TENDER, BID OPP. 209-2011 | 2011/03/11 | TMC | CJR |



SNC-LAVALIN INC.
 148 Nature Park Way
 Winnipeg, MB, Canada R3P 0X7
 204-786-8080

| | |
|---|---------------------------|
| DESIGNED BY: T. CHURCH | CHECKED BY: C. REIMER |
| DRAWN BY: S. COATES | APPROVED BY: C. REIMER |
| SCALE: N.T.S. | DATE: 2009/12/17 |
| RELEASED FOR CONSTRUCTION DATE: 2011/03/11 | |
| BY: N. HARRINGTON | |
| CONSULTANT NO.: 112577-0106-48DD-1219 | |

ENGINEER'S SEAL
 ORIGINAL DRAWING
 SEALED BY:
 T. M. CHURCH
 SNC-LAVALIN
 MEMBER # 32682
 2012/02/17
 REV. 01



SOUTH END WATER POLLUTION CONTROL CENTRE
 ESSENTIAL SYSTEM UPGRADES
 INSTRUMENT LOOP DIAGRAM
 G503 SCREEN ROOM AND TRUCK BAY GAS ALARM

| | | | |
|---------------------|-------|------|------|
| CITY DRAWING NUMBER | SHEET | REV. | SIZE |
| 1-0102G-A0062 | 001 | 01 | B |