



EXISTING G260 TERMINALS

4

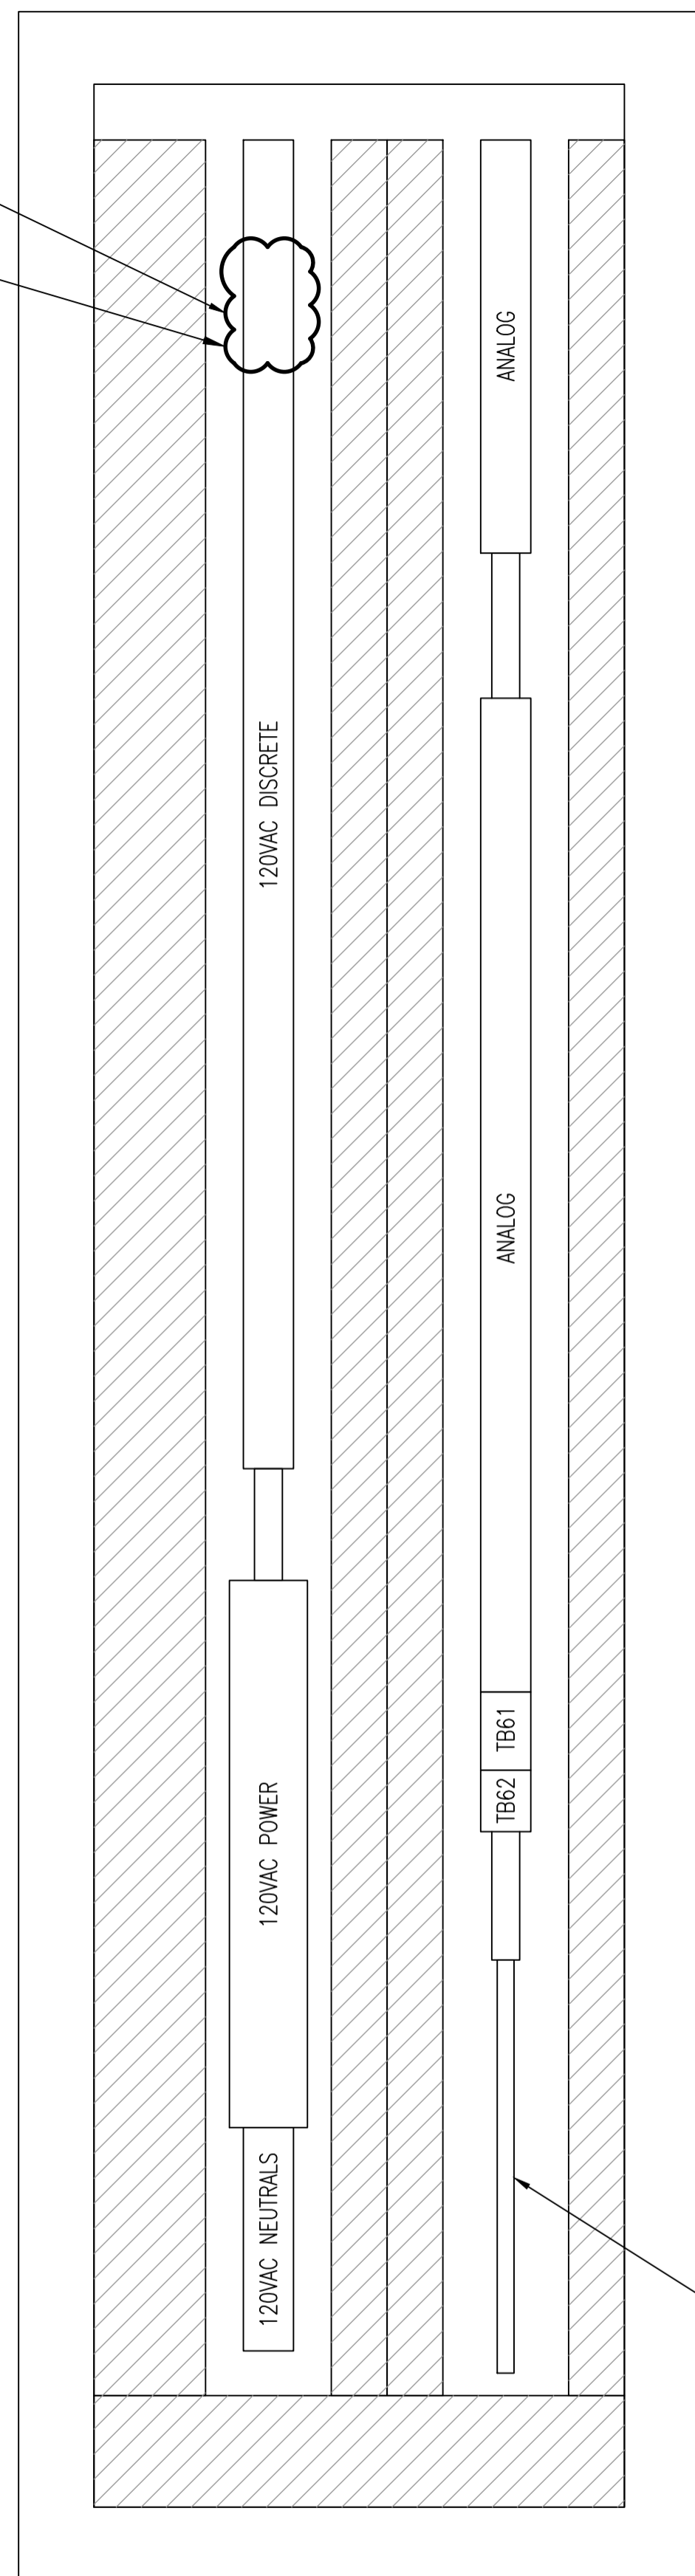


LEFT SIDE
 (FUTURE TERMINALS TB62 TO TB69)

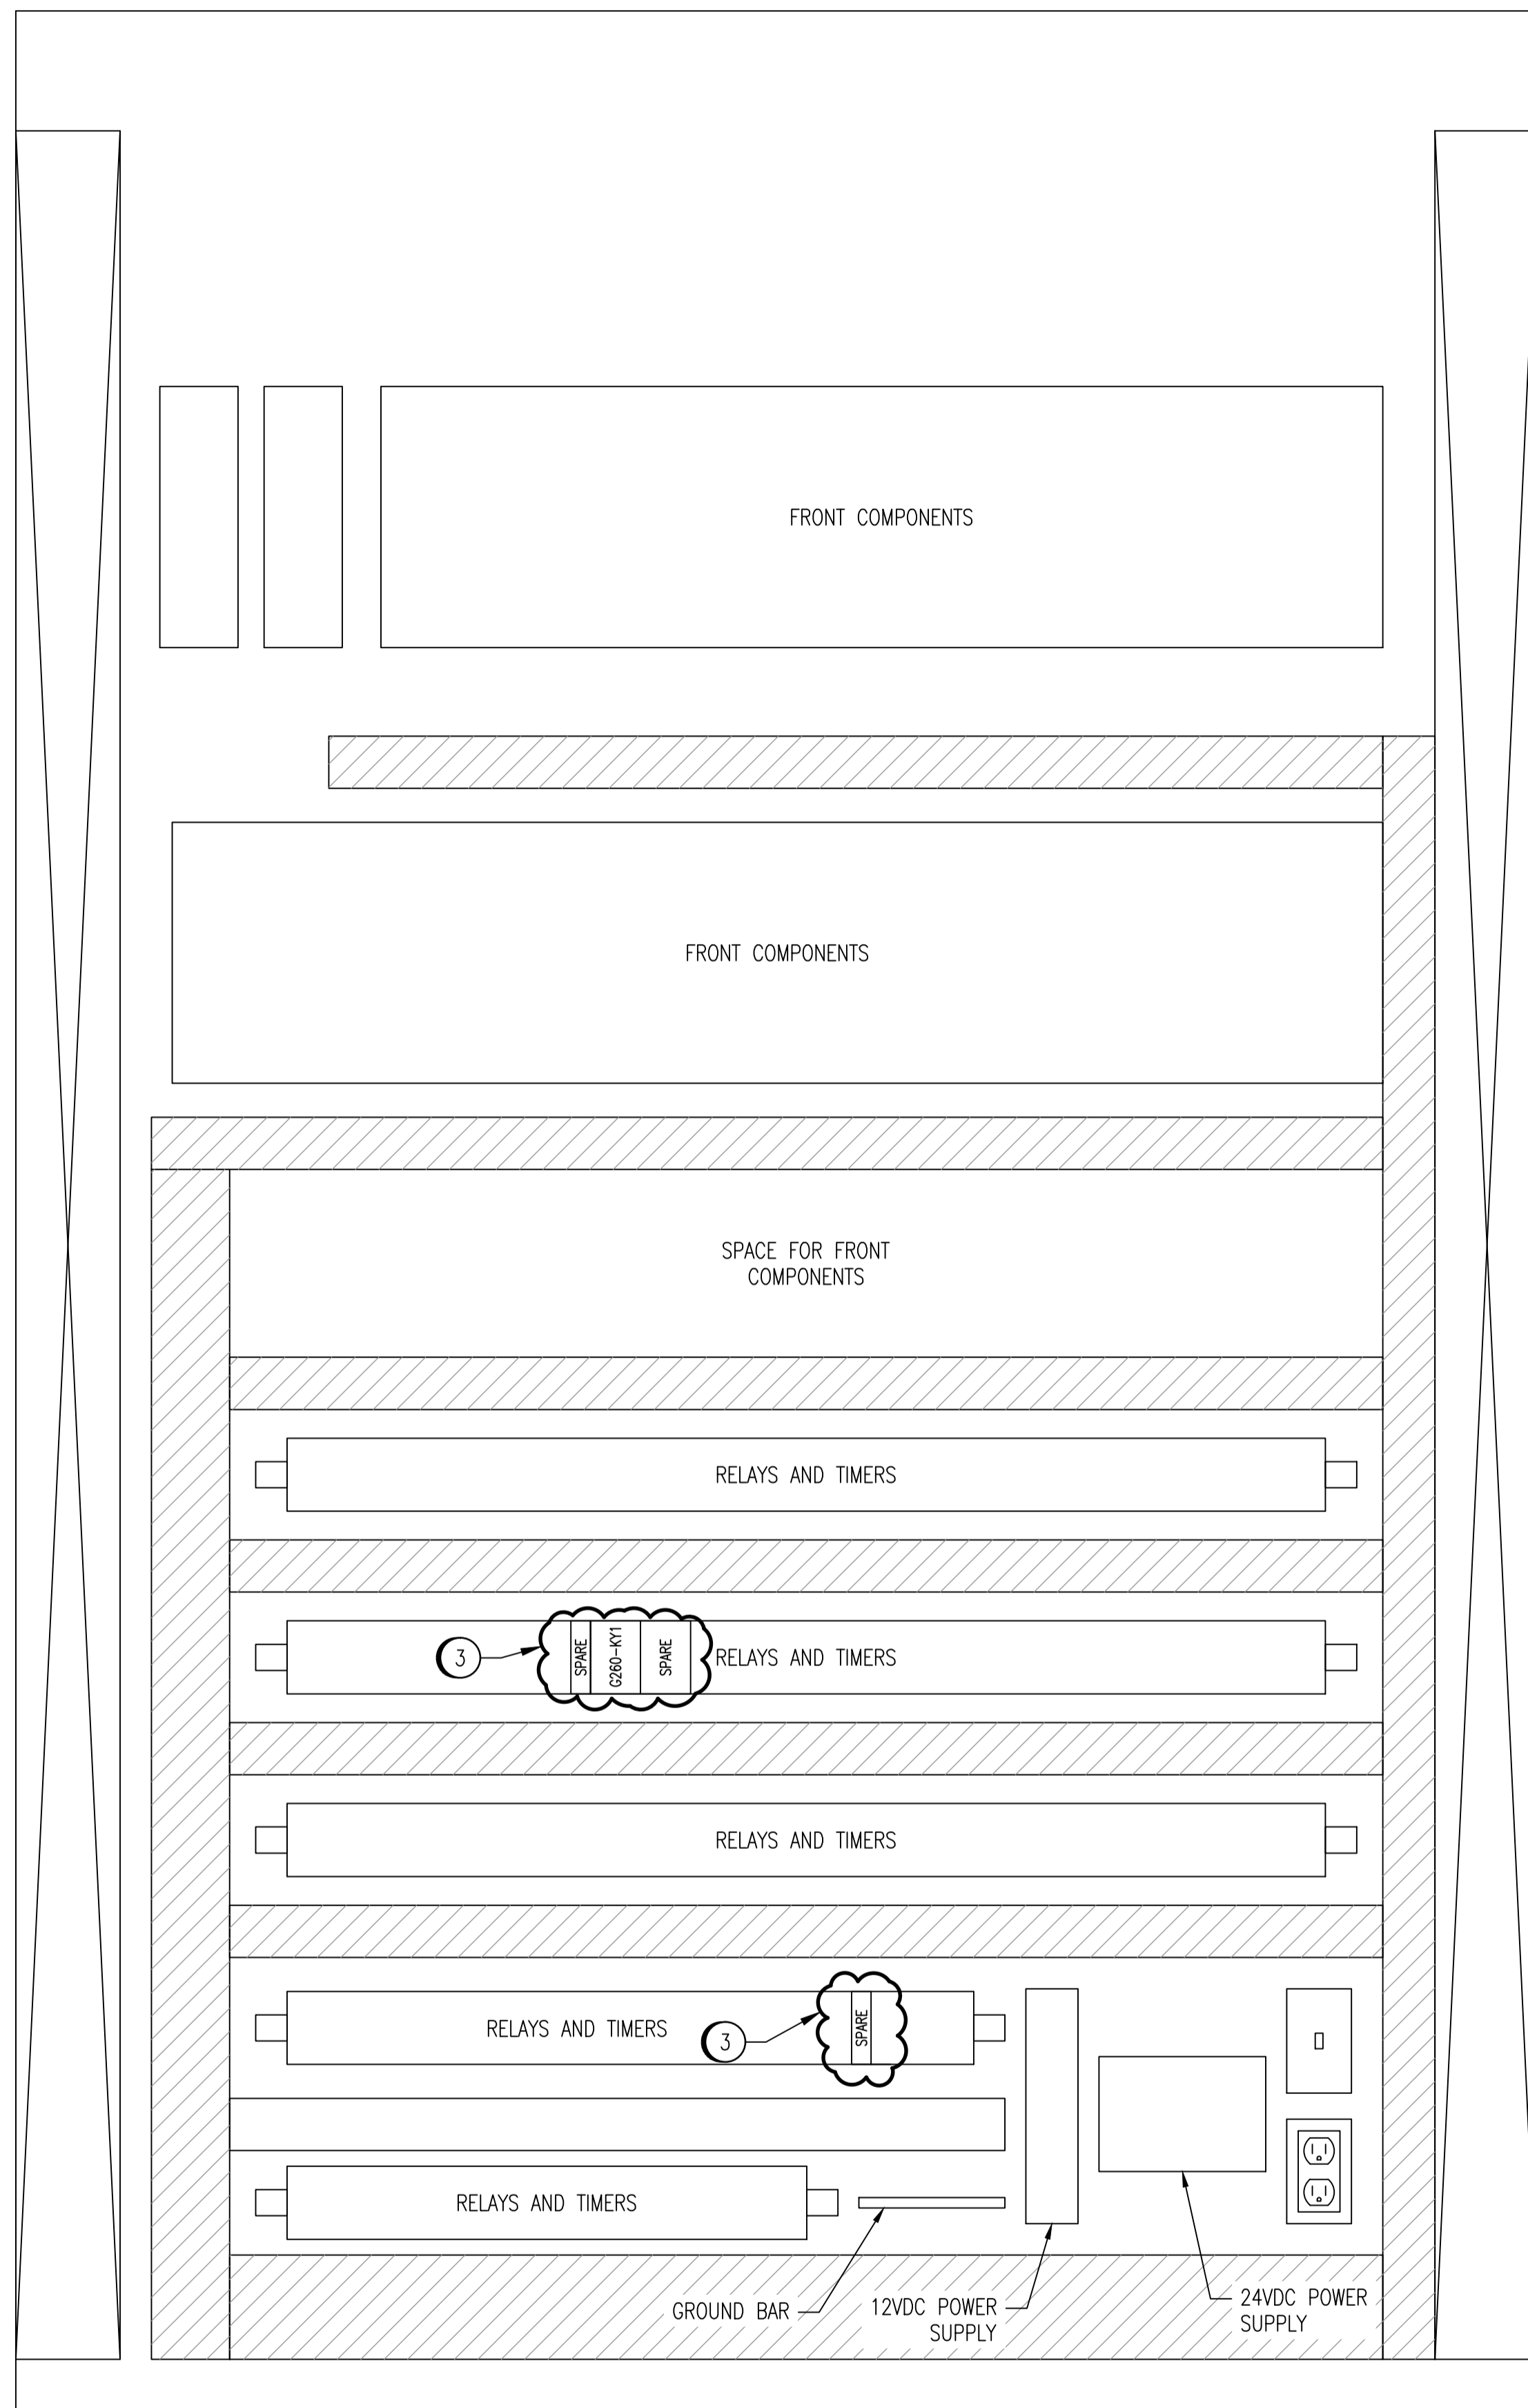

CENTRE
 (FUTURE TERMINALS TB71 TO TB79)

SOUTH CABINET

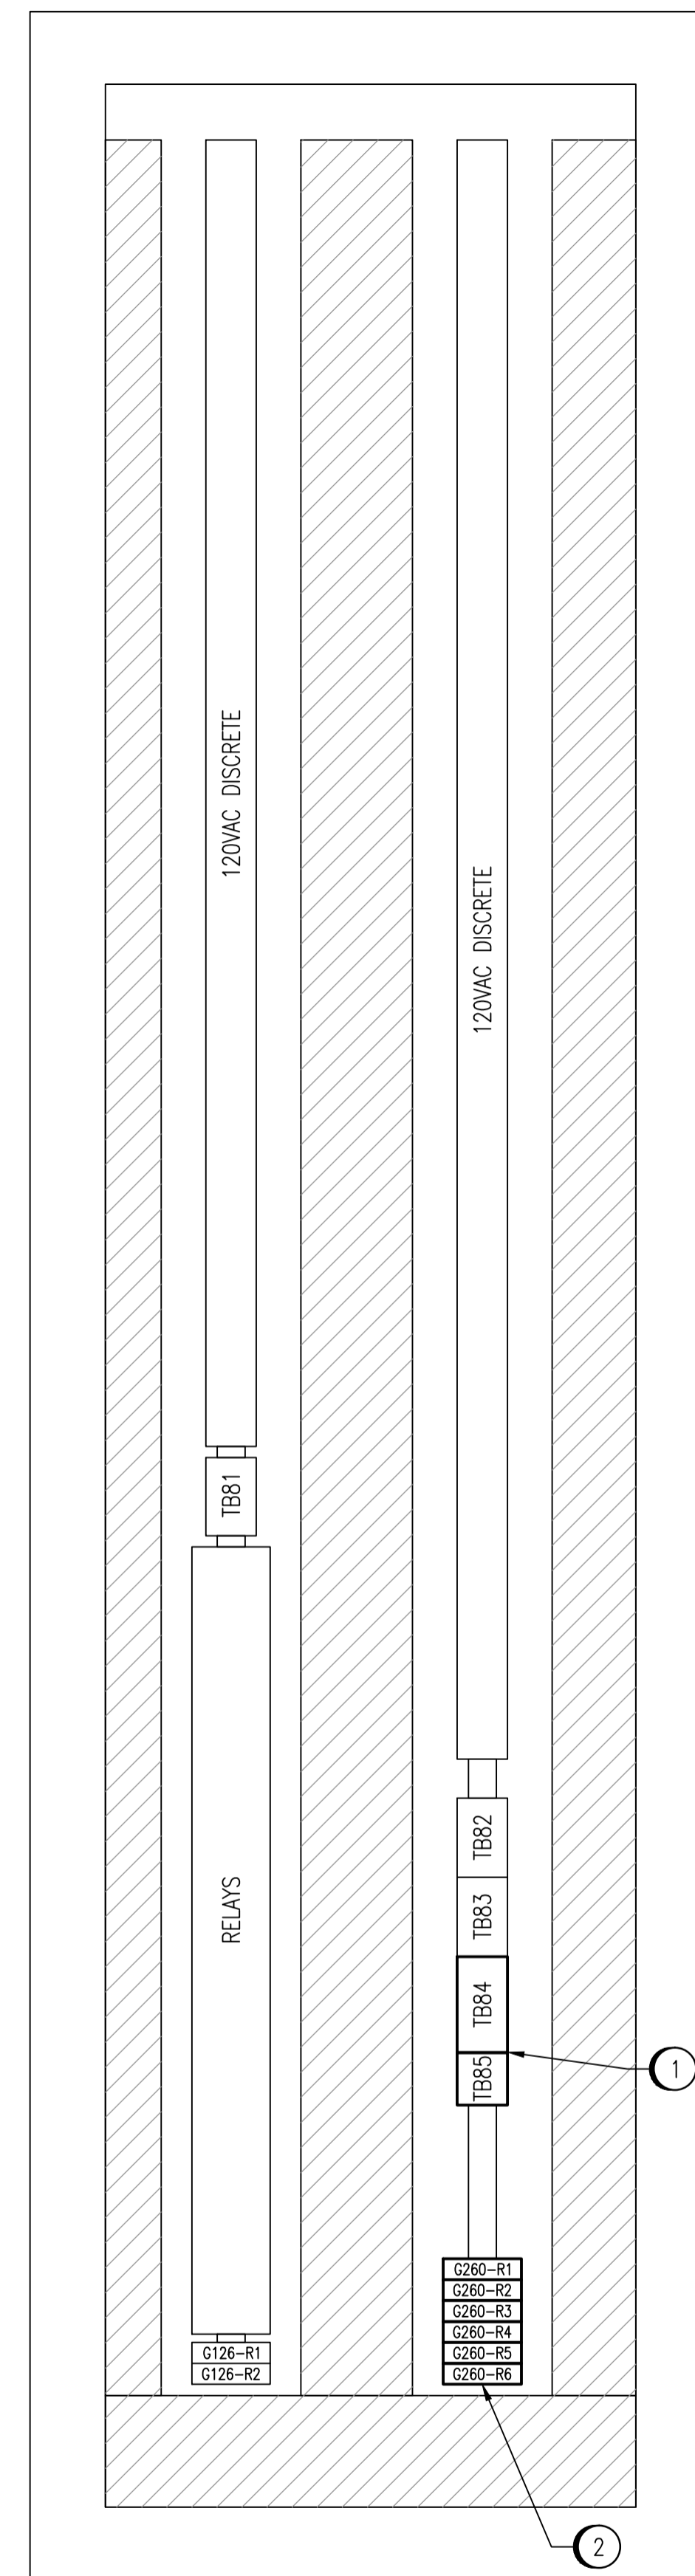

RIGHT SIDE
 (FUTURE TERMINALS TB83 TO TB89)

- CONSTRUCTION NOTES**
- 1 ADD TERMINALS TO TB84 AND TB85 ON EXISTING TS-32 DIN RAIL.
 - 2 ADD TS-35 DIN RAIL FOR RELAYS MOUNTED OVERTOP OF EXISTING TS-32 RAIL. ENSURE TS-35 RAIL IS CENTERED BETWEEN WIREWAYS.
 - 3 REUSE EXISTING TIMER G260-KY-1. LABEL EXISTING G260-R1, G260-R3 AND G260-KY-2 AS SPARE AND REMOVE WIRES FROM DEVICES.
 - 4 RELABEL TERMINALS AND REMOVE WIRES FROM SPARE TERMINALS.

NOTES:
 1. THIS DRAWING SUPERCEDES PART OF SEP-840.

NO.	REVISIONS	DATE	DESIGN	CHECK
02	ADDED G260-CON MODIFICATIONS	2012/02/24	TMC	CJR
01	UPS AND GAS DETECTION MODIFICATIONS	2011/03/11	TMC	CJR
00	ISSUED FOR TENDER	2010/10/01	TMC	CJR

SNC-LAVALIN INC.
 148 Nature Park Way
 Winnipeg, MB, Canada R3P 0X7
 204-786-8080

DESIGNED BY: T. CHURCH
 CHECKED BY: C. REIMER
 DRAWN BY: S. COATES
 APPROVED BY: C. REIMER

SCALE: 1:5
 RELEASED FOR CONSTRUCTION BY: J. VEILLEUX
 DATE: 2010/08/12
 DATE: 2010/10/01

CONSULTANT NO.: 112577-0112-480D-0303

ENGINEER'S SEAL
 ORIGINAL DRAWING
 SEALED BY:
 T. M. CHURCH
 SNC-LAVALIN
 MEMBER # 32682
 2012/02/28
 REV. 02

THE CITY OF WINNIPEG
 WATER AND WASTE DEPARTMENT

SOUTH END WATER POLLUTION CONTROL CENTRE
 HEADWORKS UPGRADES
 PANEL LAYOUT
 FDP-G REAR VIEW

CITY DRAWING NUMBER: 1-0102G-A0086
 SHEET: 001
 REV: 02
 SIZE: A1