
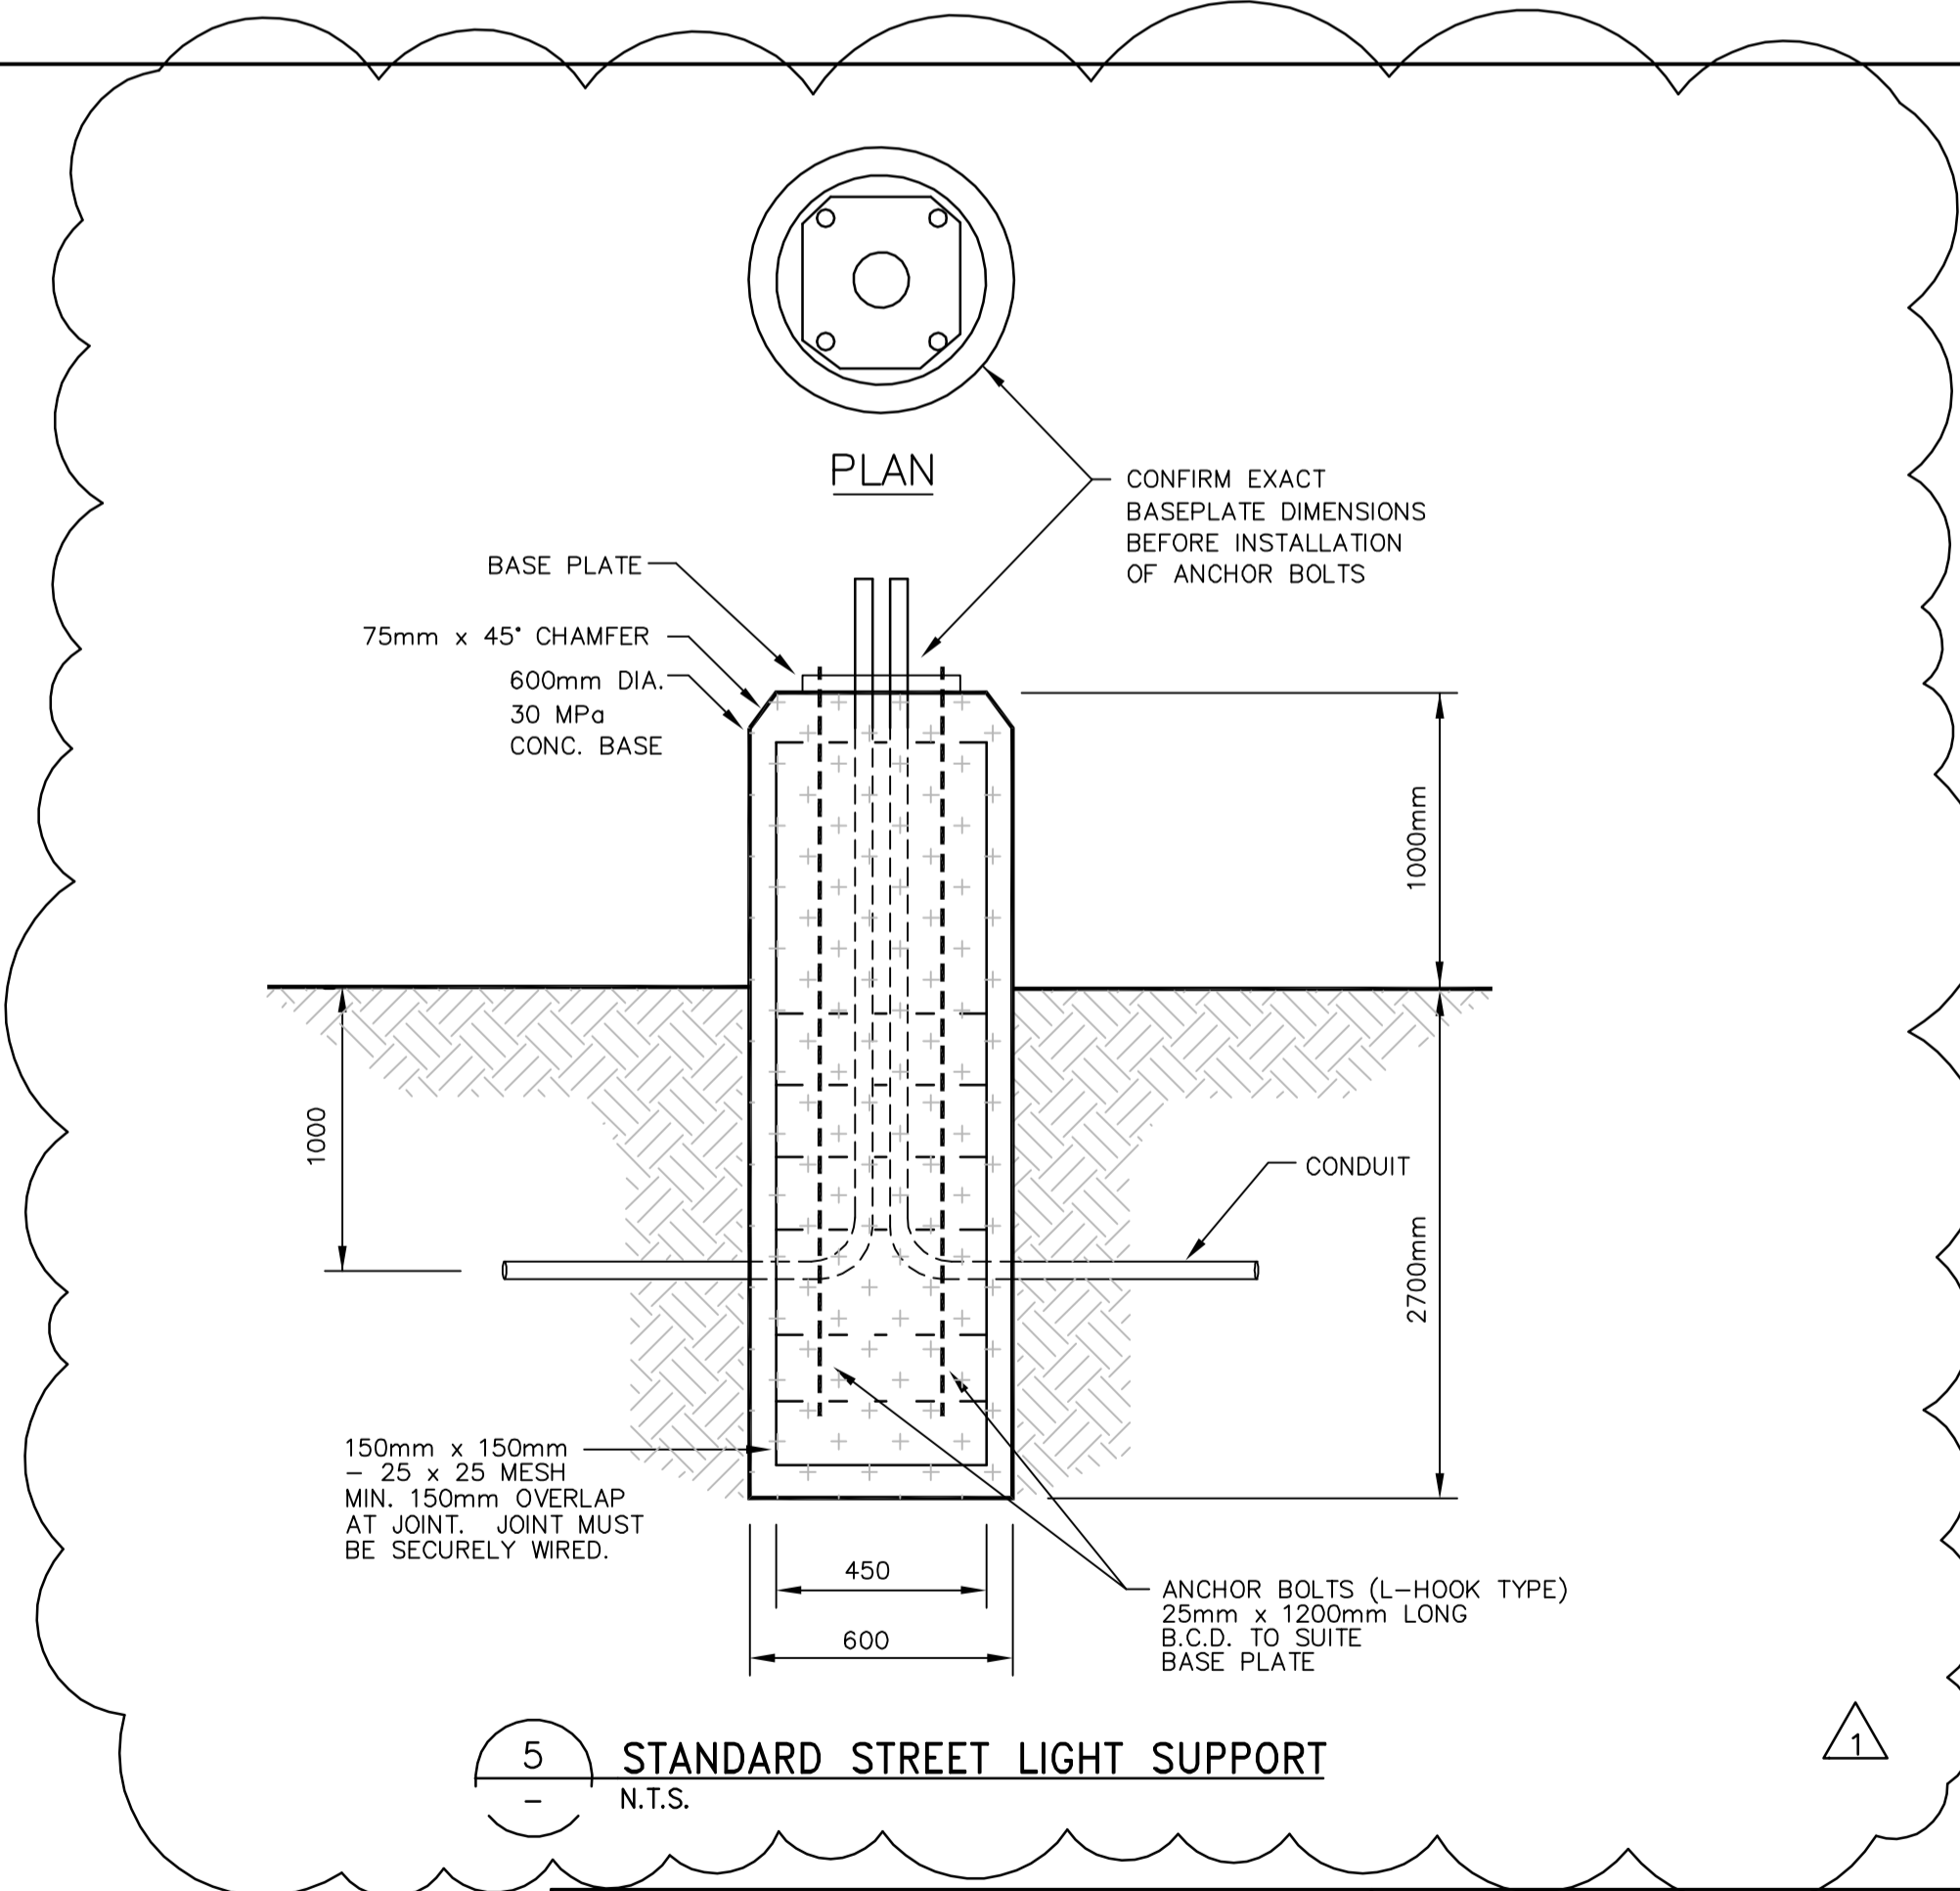


- NOTES:
- THIS DETAIL APPLIES TO ALL INTERNAL AND EXTERNAL SHIELDED CONTROL CABLE WIRING WITHIN A CONTROL PANEL.
 - USE THIS ARRANGEMENT FOR CONNECTING SHIELD TO A TERMINAL STRIP FOR:
 - CONTINUING TO GROUND AT THIS POINT (NOTE - ONLY ONE POINT ALONG SIGNAL CABLE MAY BE CONNECTED TO GROUND) OR,
 - CONTINUING TO ANOTHER SHIELDED CONTROL CABLE WITHOUT CONNECTING TO GROUND AT THIS POINT.

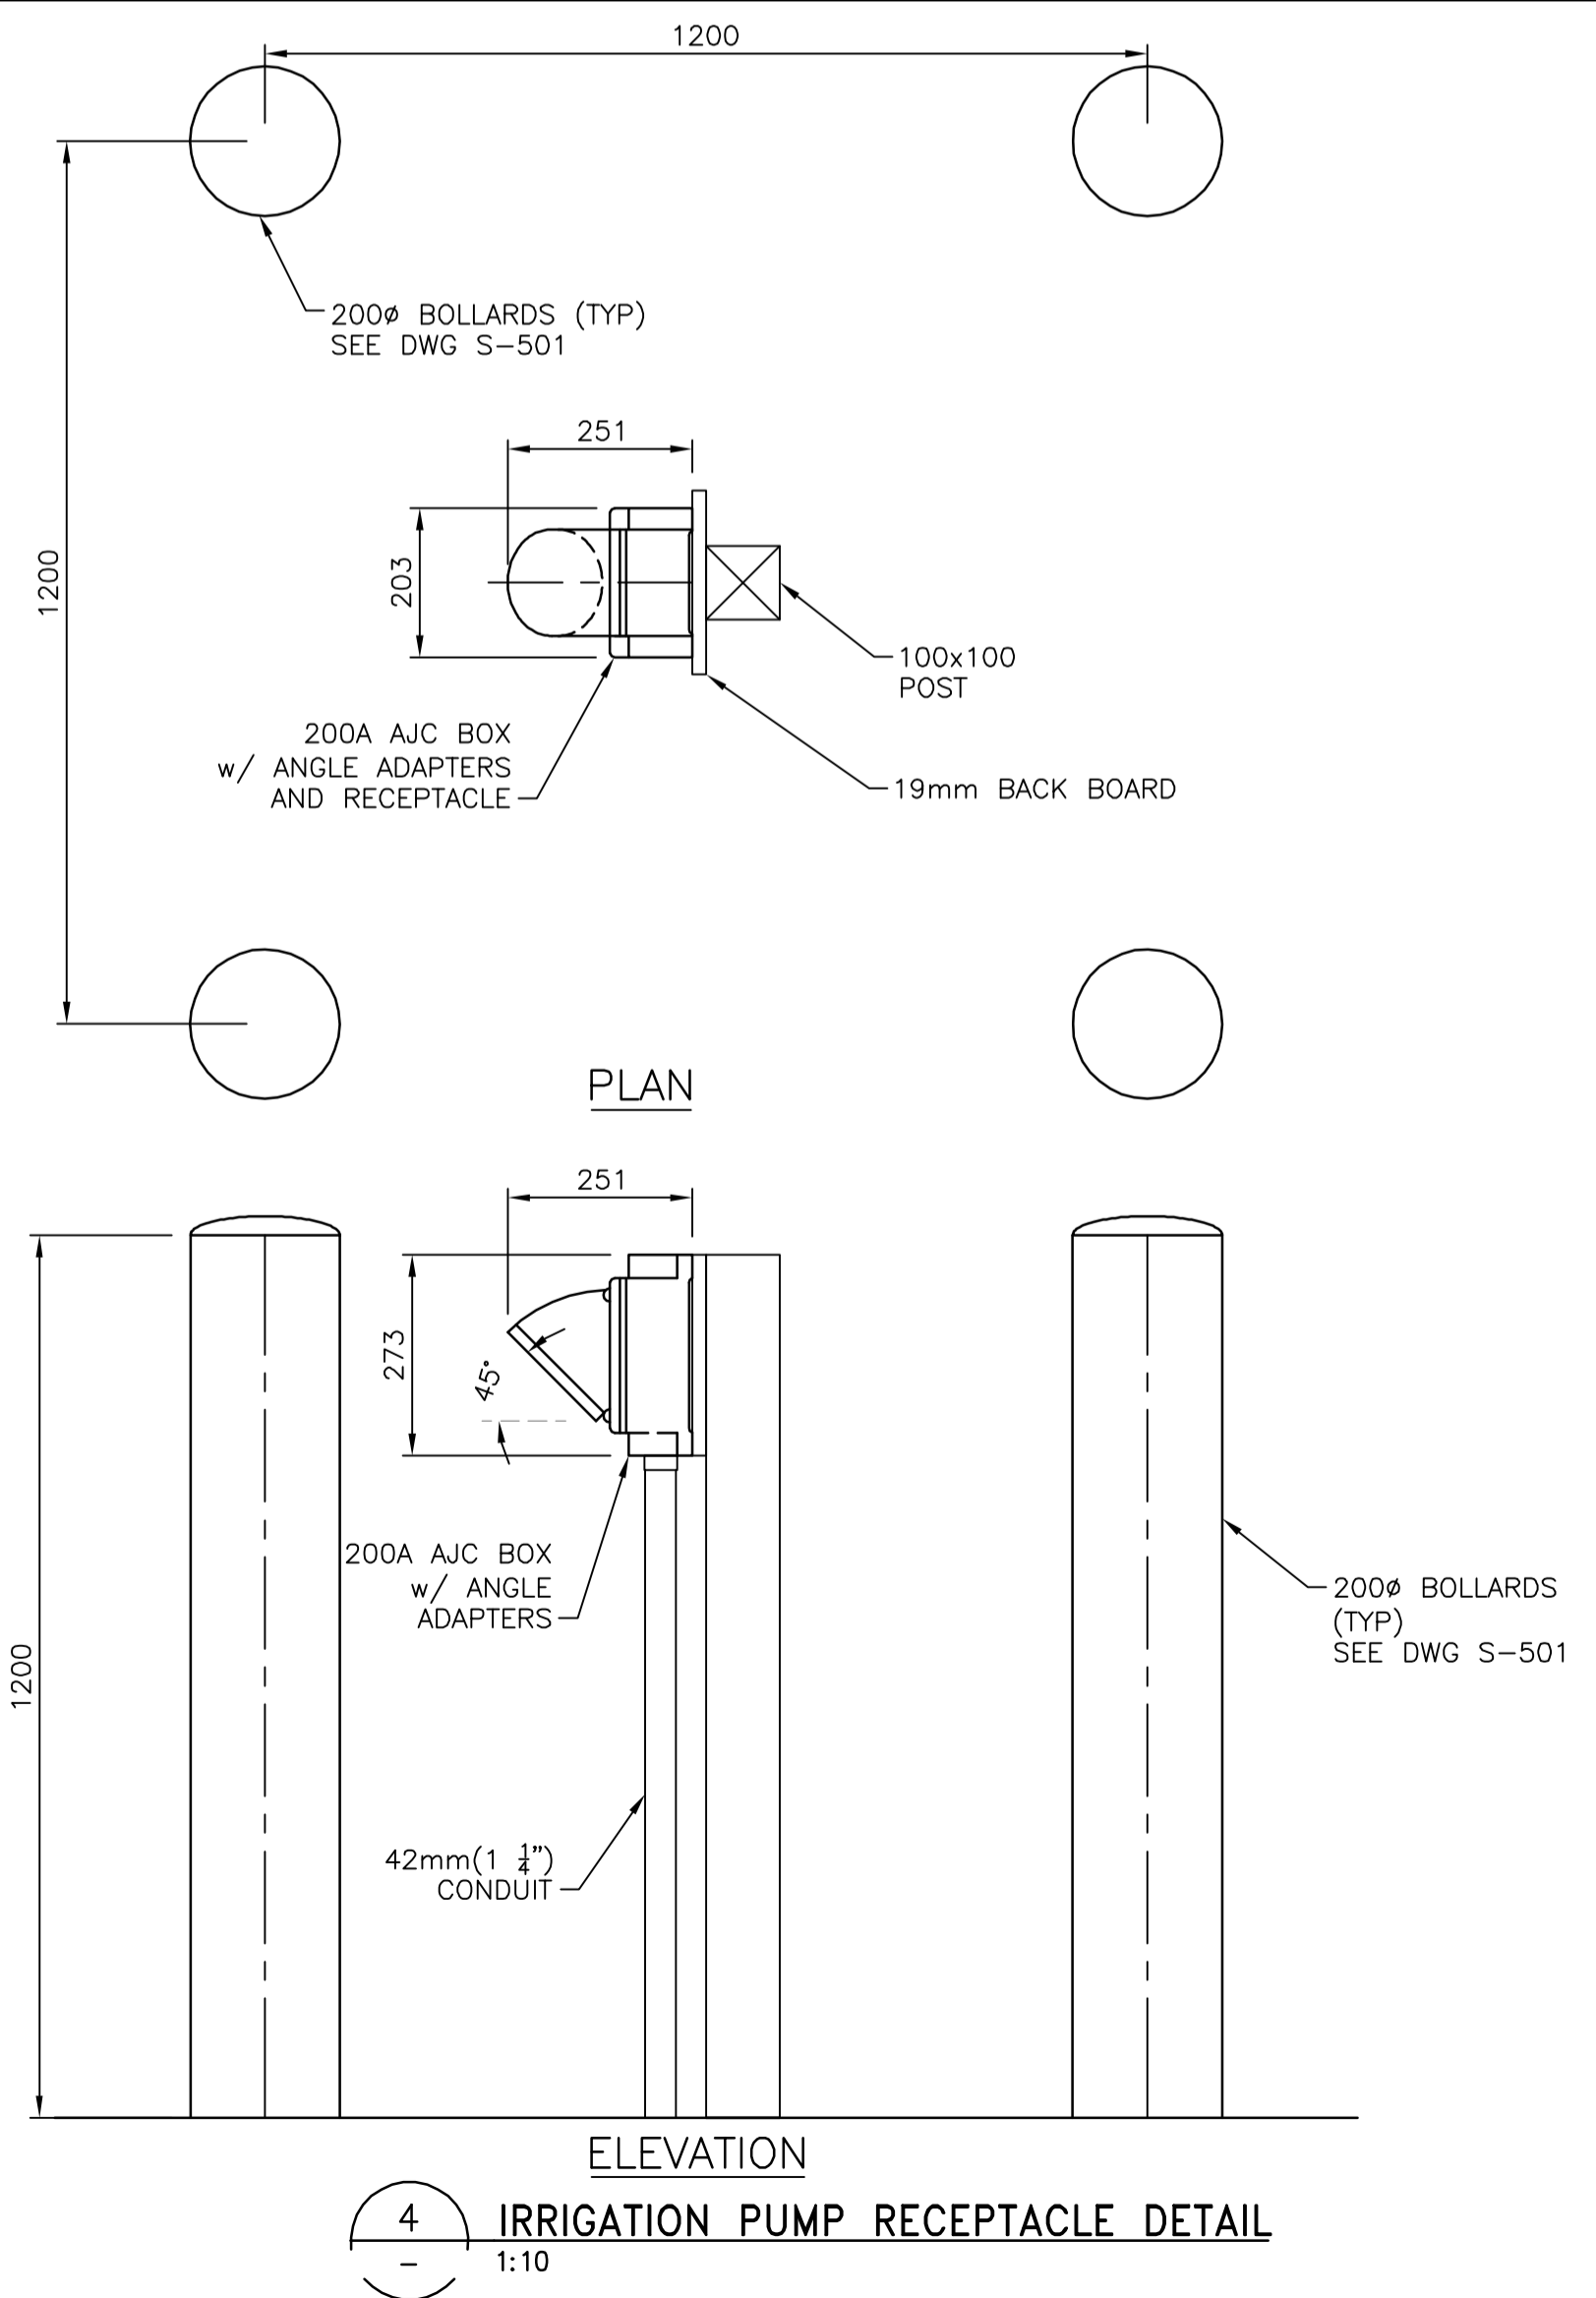

B.M. ELEV.		CH2MHILL®		ENGINEER'S SEAL		THE CITY OF WINNIPEG WATER AND WASTE DEPARTMENT ENGINEERING DIVISION	
CONSTRUCTION COMPLETION DATE: YYYY MM DD		DESIGNED BY	LL	CHECKED BY	WT	ORIGINAL SIGNED BY L.D. LLEWELLYN 13/01/25	
		DRAWN BY	EA	APPROVED BY	BW	BRADY ROAD RESOURCE MANAGEMENT FACILITY LEAF AND YARD WASTE AND PILOT BIOSOLIDS COMPOSTING	
1 ISSUED FOR ADDENDUM 2		13/02/26	JBC	SCALE: HORIZONTAL AS NOTED		SHEET 45 OF 45	
0 ISSUED FOR CONSTRUCTION		13/01/25	JBC	RELEASED FOR CONSTRUCTION		CITY DRAWING NUMBER	
NO. REVISIONS		DATE	BY	DATE		ELECTRICAL DETAILS SHEET 2 OF 2	
		2013 01 25		DATE		1-0400B-E0007-002-01	
				PLOT DATE: 2013 02 26		E-502	
				PLOT DATE: 2013 02 26		CONSULTANT DRAWING NUMBER E-502	
				PLOT DATE: 2013 02 26		FILE PATH: C:\pw_workdir\ch2mhill_wbg\jcoritez1\40198672\ FILE NAME: E-502_438634.dwg	