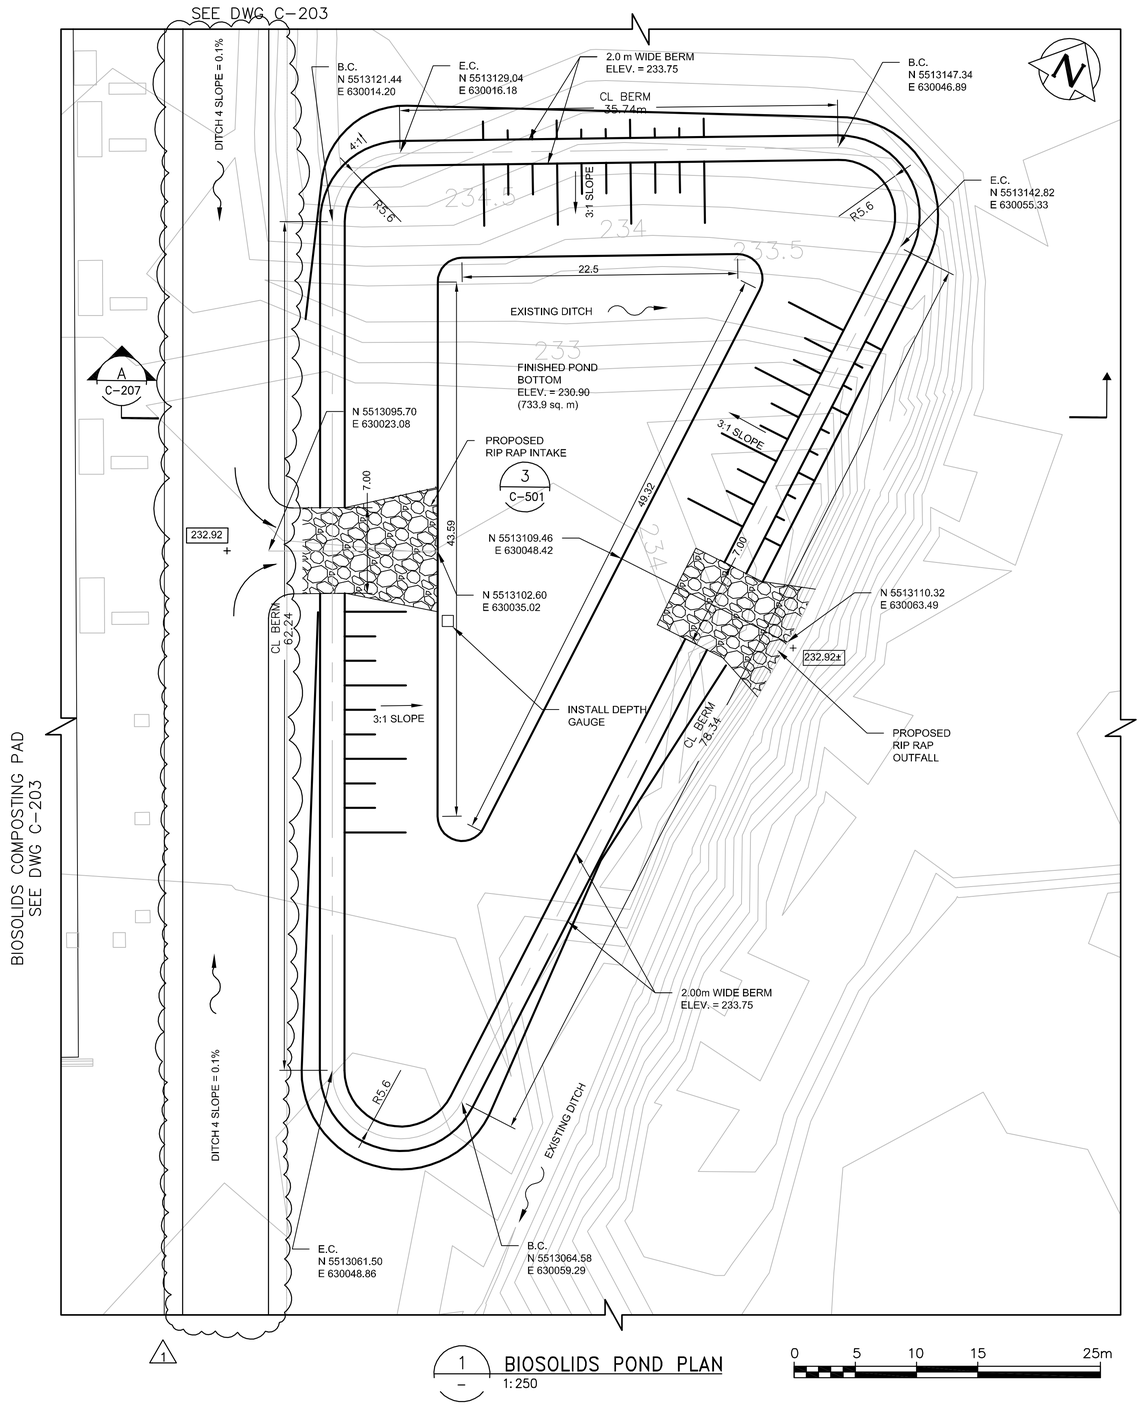

1 BIOSOLIDS POND PLAN
1:250

0 5 10 15 25m

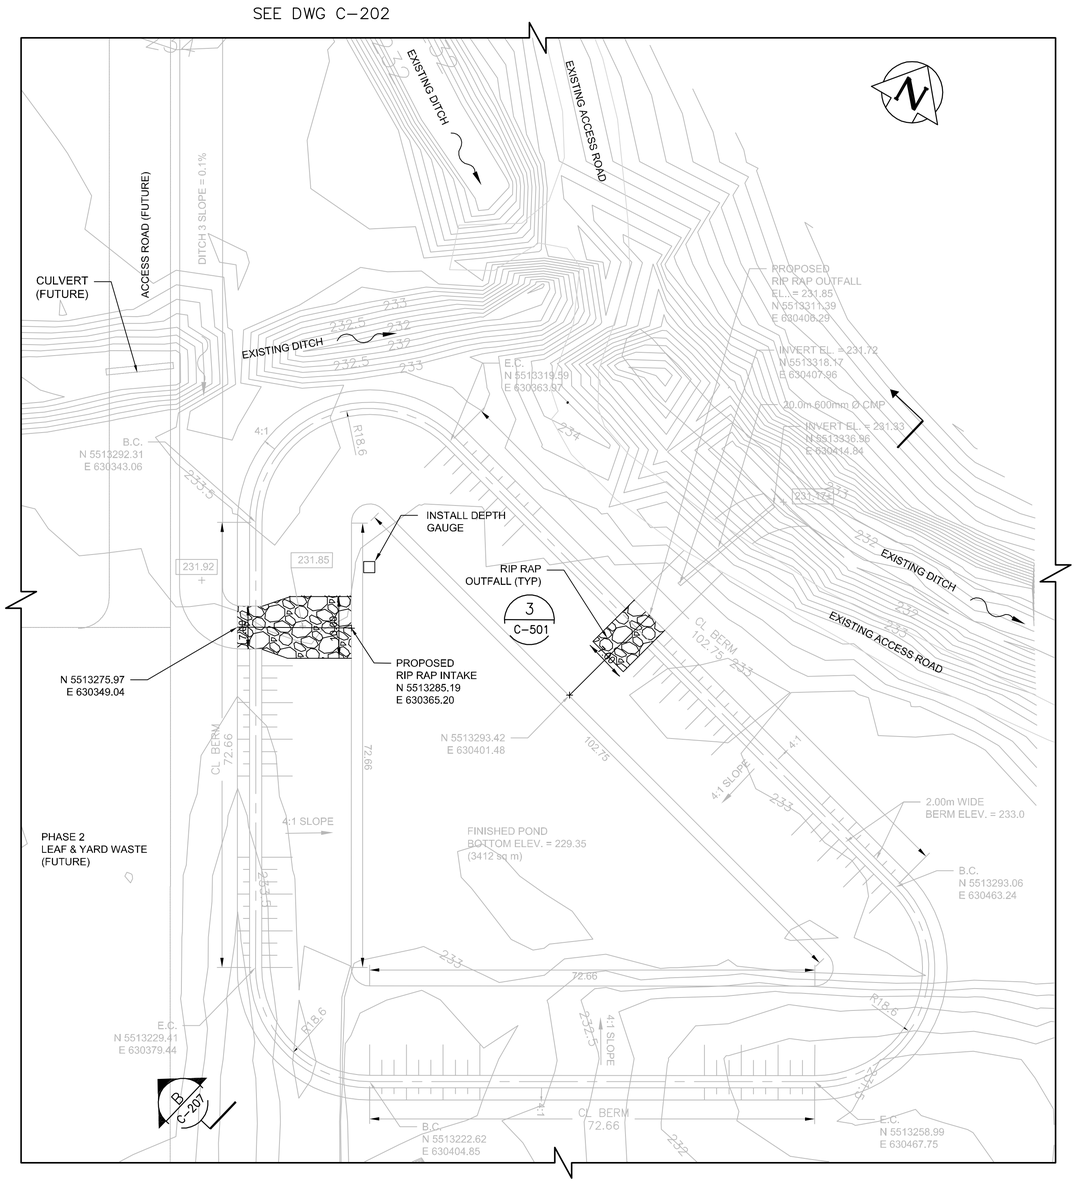

2 LEAF & YARD WASTE POND PLAN (BY OTHERS)
1:500

0 12.5 25 37.5 50m

NOTE:
EXISTING / BY OTHERS
NEW WORK TO BE SUPPLIED AND INSTALLED

NO.	REVISIONS	DATE	BY
1	ISSUED FOR ADDENDUM 3	13/03/04	JBC
0	ISSUED FOR CONSTRUCTION	13/01/25	GMH

B.M.
ELEV.

CONSTRUCTION COMPLETION DATE: YYYY MM DD

CH2MHILL®

DESIGNED BY: BW | CHECKED BY: BW
DRAWN BY: GH | APPROVED BY: BM
SCALE: HORIZONTAL AS NOTED, VERTICAL N/A | RELEASED FOR CONSTRUCTION
DATE 2013 01 25
PLOT DATE: 2013 03 04

ENGINEER'S SEAL
ORIGINAL SIGNED BY
S.B. WILLIAMSON
13/01/25

CONSULTANT DRAWING NUMBER
C-206

BID OPPORTUNITY: 839-2012

Winnipeg

THE CITY OF WINNIPEG
WATER AND WASTE DEPARTMENT
ENGINEERING DIVISION

BRADY ROAD RESOURCE MANAGEMENT FACILITY
LEAF AND YARD WASTE AND
PILOT BIOSOLIDS COMPOSTING
CIVIL
BIOSOLIDS POND & L&YW POND PLAN

SHEET 8 OF 45
CITY DRAWING NUMBER
1-0400B-C0006-001-01

FILE PATH: C:\pw_workdir\ch2mhill_wbg\jcortez1\d0198664\
FILE NAME: C-206.dwg