



**KEY PLAN**  
SCALE: NTS

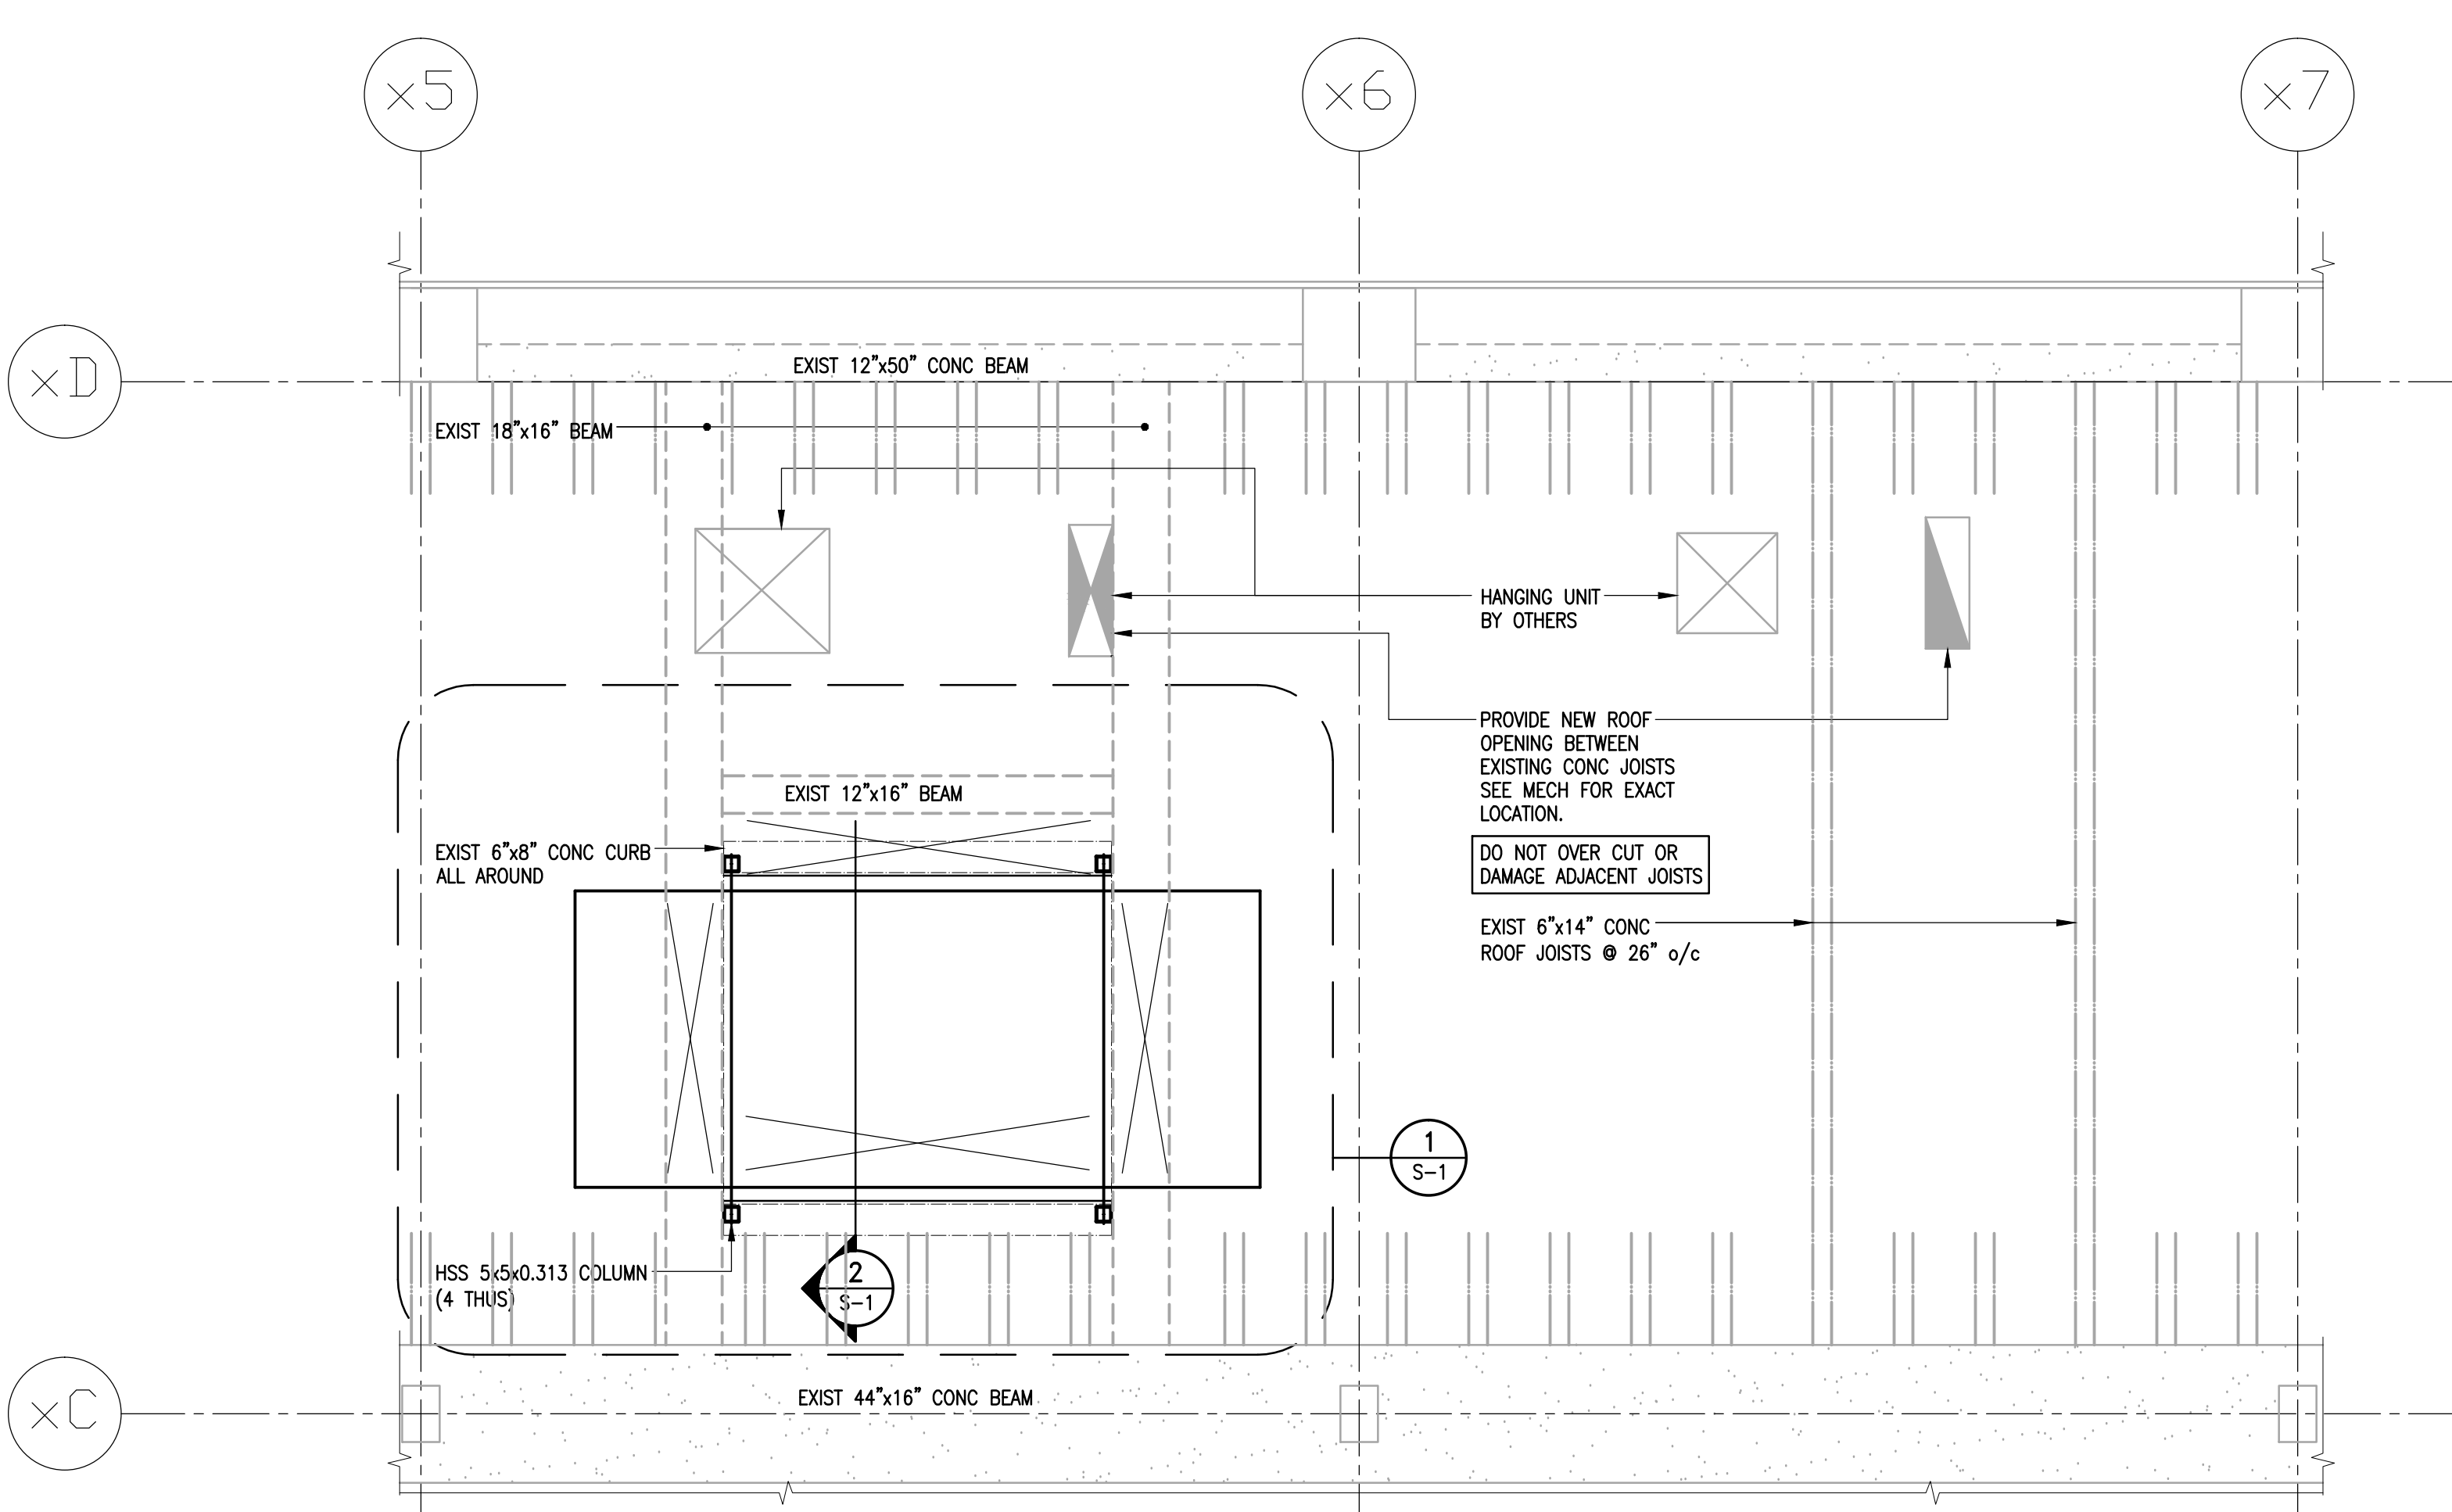

**PARTIAL ROOF PLAN - NEW CONSTRUCTION**  
1/4" = 1'-0"

- REMOVAL OF EXISTING COOLING TOWER UNIT AND FRAMING BY OTHERS. DO NOT DAMAGE EXISTING CONCRETE FRAMING AROUND OPENING.
- DESIGN ROOF LIVE LOAD = 36 PSF

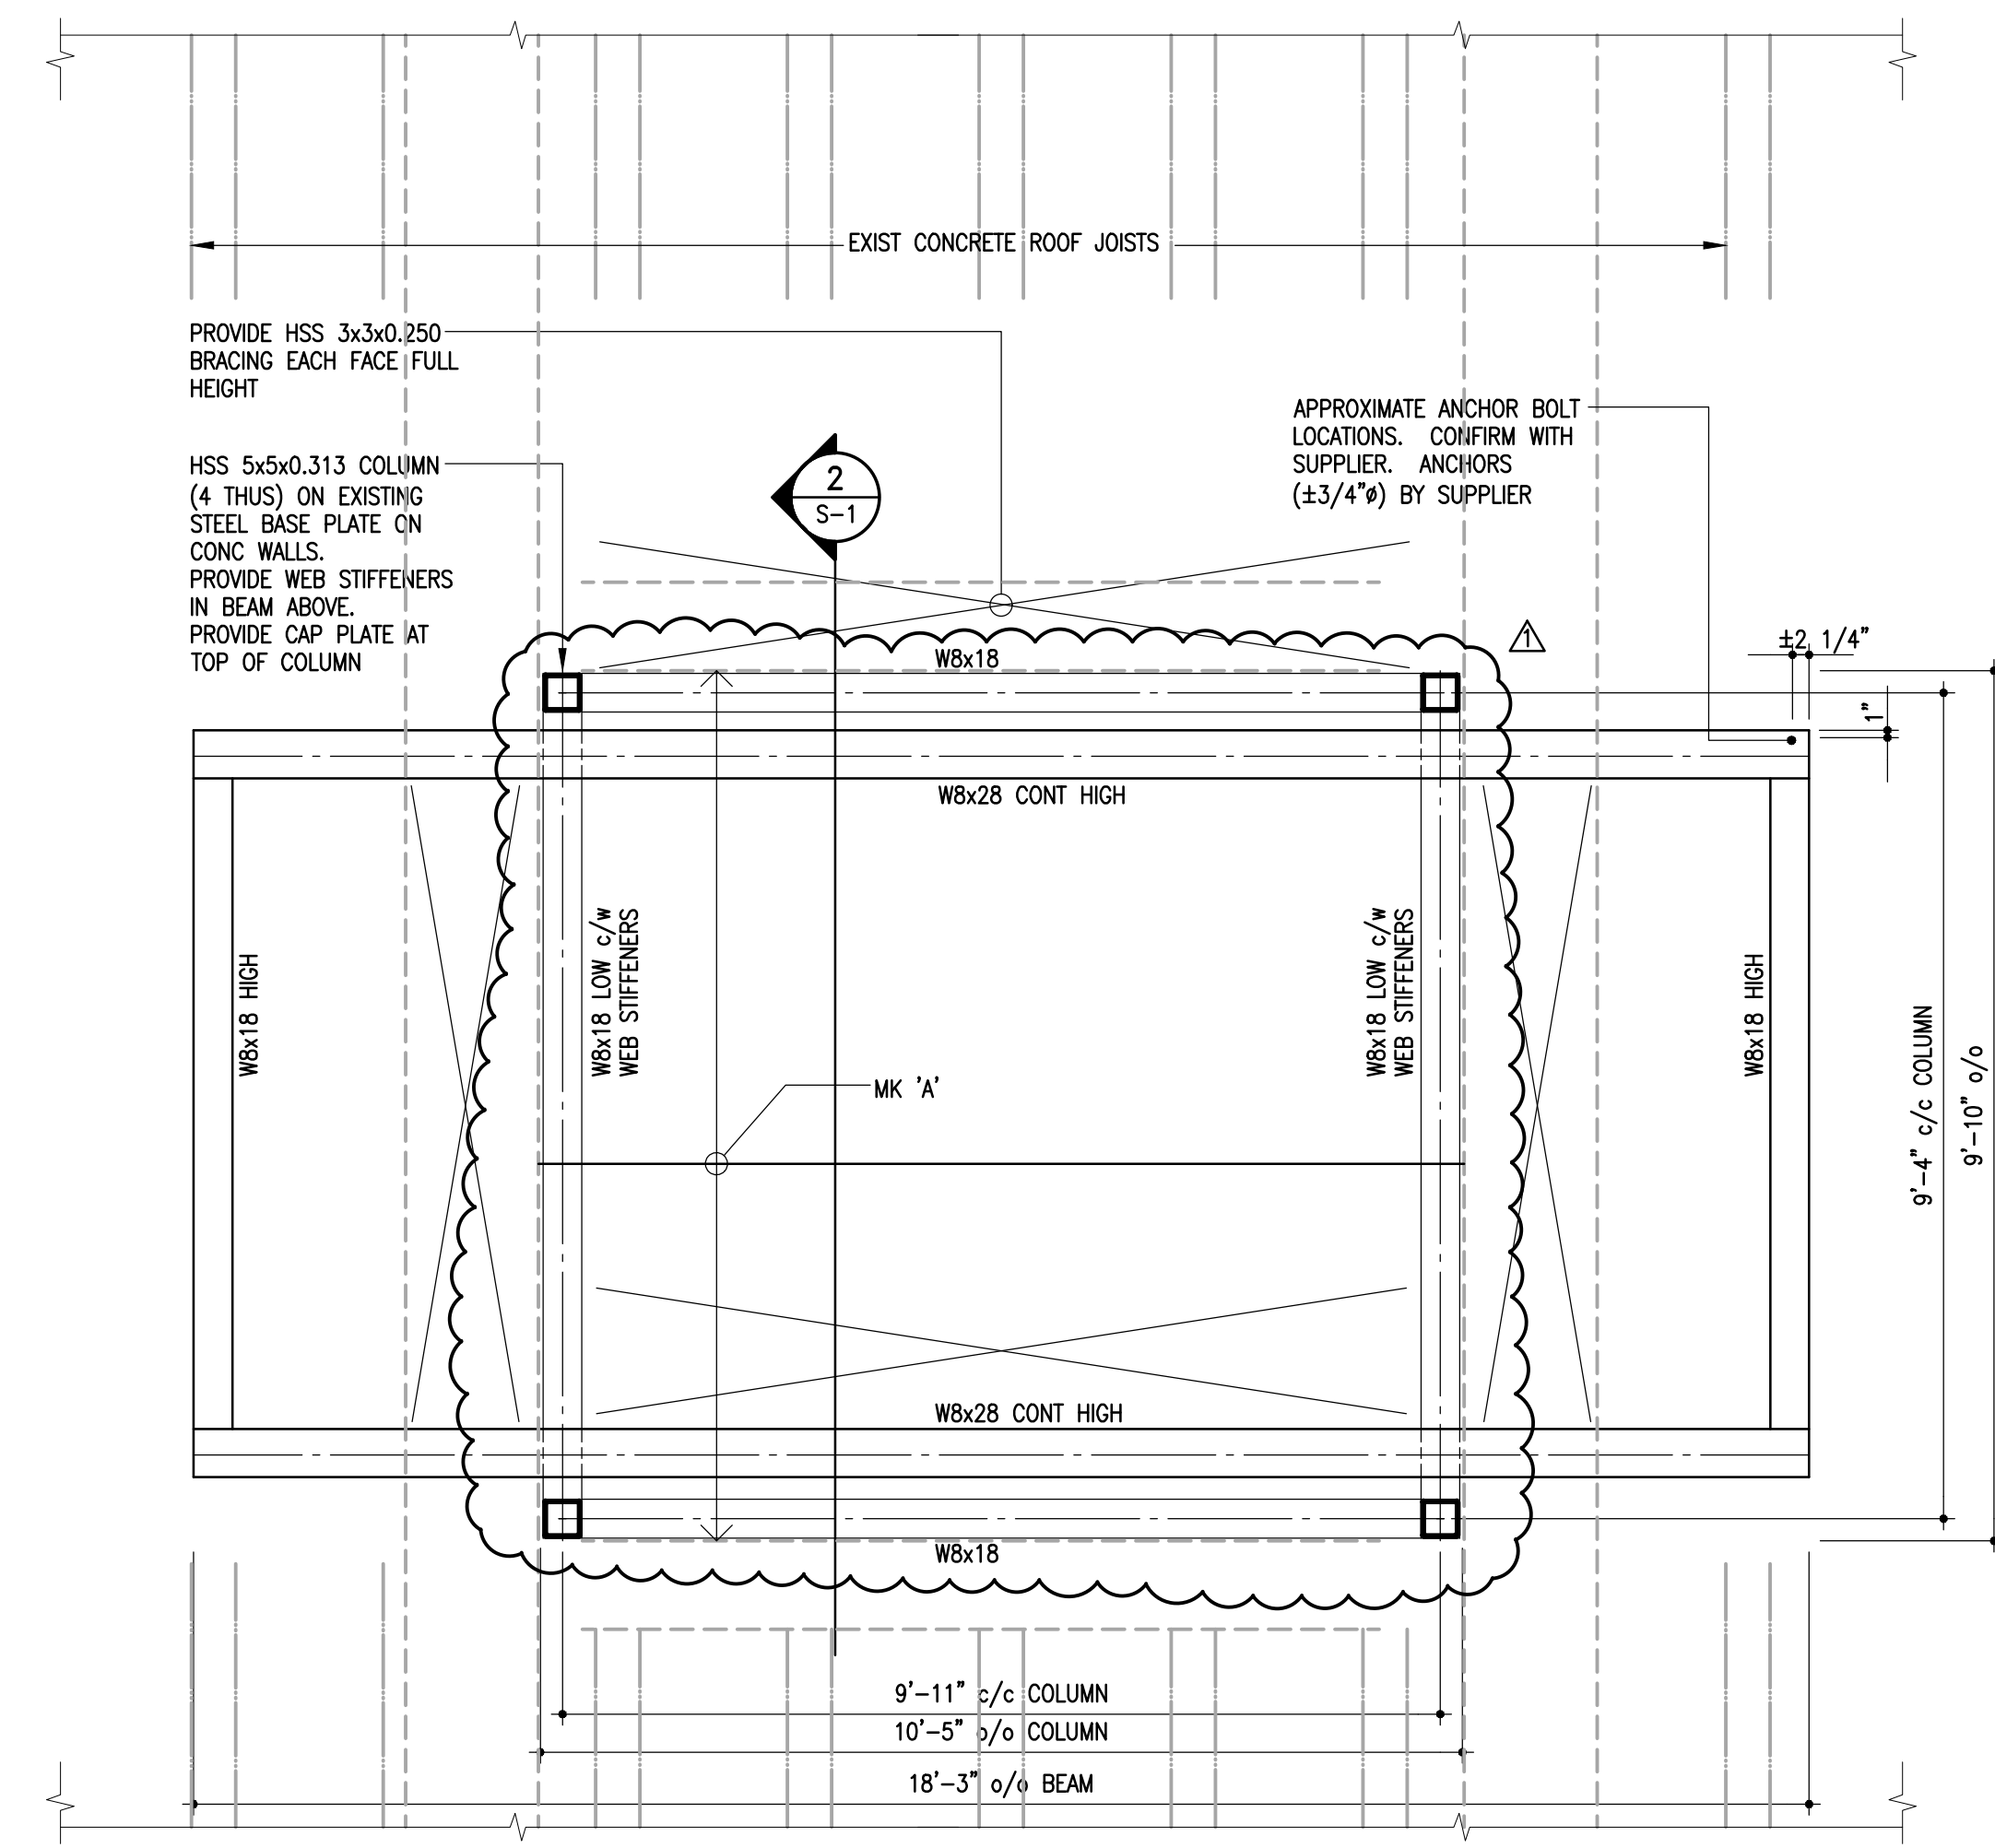


**SECTION 1**  
S-1 1/2" = 1'-0"

- GENERAL CONTRACTOR TO CONFIRM AND COORDINATE EXACT UNIT SIZE AND ANCHOR BOLT LOCATIONS FROM SUPPLIER WITH SUPPORT DIMENSIONS PRIOR TO FABRICATION.
- COOLING TOWER UNIT NOT SHOWN FOR CLARITY (BY OTHERS).
- MAX UNIT OPERATING HEIGHT = 10810#
- MAX VERTICAL REACTION LOAD AT ANCHOR = 4375# (UNFACTORED)
- MAX HORIZONTAL REACTION LOAD AT ANCHOR = 122# (UNFACTORED)
- PROVIDE 3/8" DRILL HOLE AT BASE OF HSS SECTIONS TYP. SITE CONFIRM EXIST STRUCTURE & DIMENSIONS.
- PROVIDE WEB STIFFENERS IN ALL BEAMS WHICH CROSS OVER ALL COLUMNS OR BEAMS.
- CONFIRM FINAL STEEL FINISH WITH OWNER.

**MARK 'X'**  
REMOVE SLIDING HATCH ACCESS AND INFILL EXISTING OPENING AS FOLLOWS:  
PROVIDE 1 1/2 X 0.03 STEEL DECK ON C8x11.5 AT 4'-0" O.C. AND AT EACH SIDE OF COLUMN 6" x 8x10x5/8 WELD PLATE BOLTED TO EXISTING CONCRETE BEAM WITH 2-5/8" HLT X 8" x 4" EMBEDMENT. ELEVATION OF TOP OF CHANNEL 3" BELOW TOP OF EXISTING CONCRETE CURB.


PROVIDE 4x4x1/8 ANGLE DECK SUPPORT AROUND PERIMETER CONNECTED TO CHANNELS AND BOLTED TO CONCRETE BEAMS ON EACH SIDE OF OPENING WITH 1/2" HLT X 8" x 4" EMBEDMENT AT 8" o/c. PROVIDE 15x5x1/4" LG BOLTED TO EXIST CONG BEAM WITH 2-1/2" HLT HIT BY 150 ANCHORS x 4" EMBEDMENT WITH VERTICAL SLOTTED CONNECTION TO TOWER COLUMN.

PROVIDE 1 1/2" RIGID INSULATION OVER STEEL DECK AND PROVIDE ROOFING ABOVE MATERIALS TO MATCH EXISTING SYSTEM WITH FLASHING OVER EXISTING PERIMETER CONCRETE CURB. SEAL ALL OPENINGS REQUIRED FOR MECHANICAL LINE PENETRATIONS AND AT COOLING TOWER SUPPORT COLUMN PENETRATIONS.

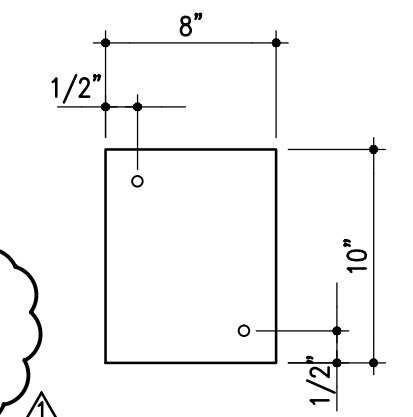


**ADDENDUM #1**

- NEW HOLE FOR CHILLER RELIEF VALVE (1.5" DIAMETER) MAY BE CORED THROUGH ROOF DECK AREA BETWEEN CONCRETE JOISTS AS NOTED ON MECHANICAL. DO NOT DAMAGE EXISTING CONCRETE JOISTS. SEAL ANCHORING.
- SEALED SHOP DRAWINGS ARE TO BE PROVIDED FOR STEEL FRAMING CONNECTIONS AS PER GENERAL NOTE #14.

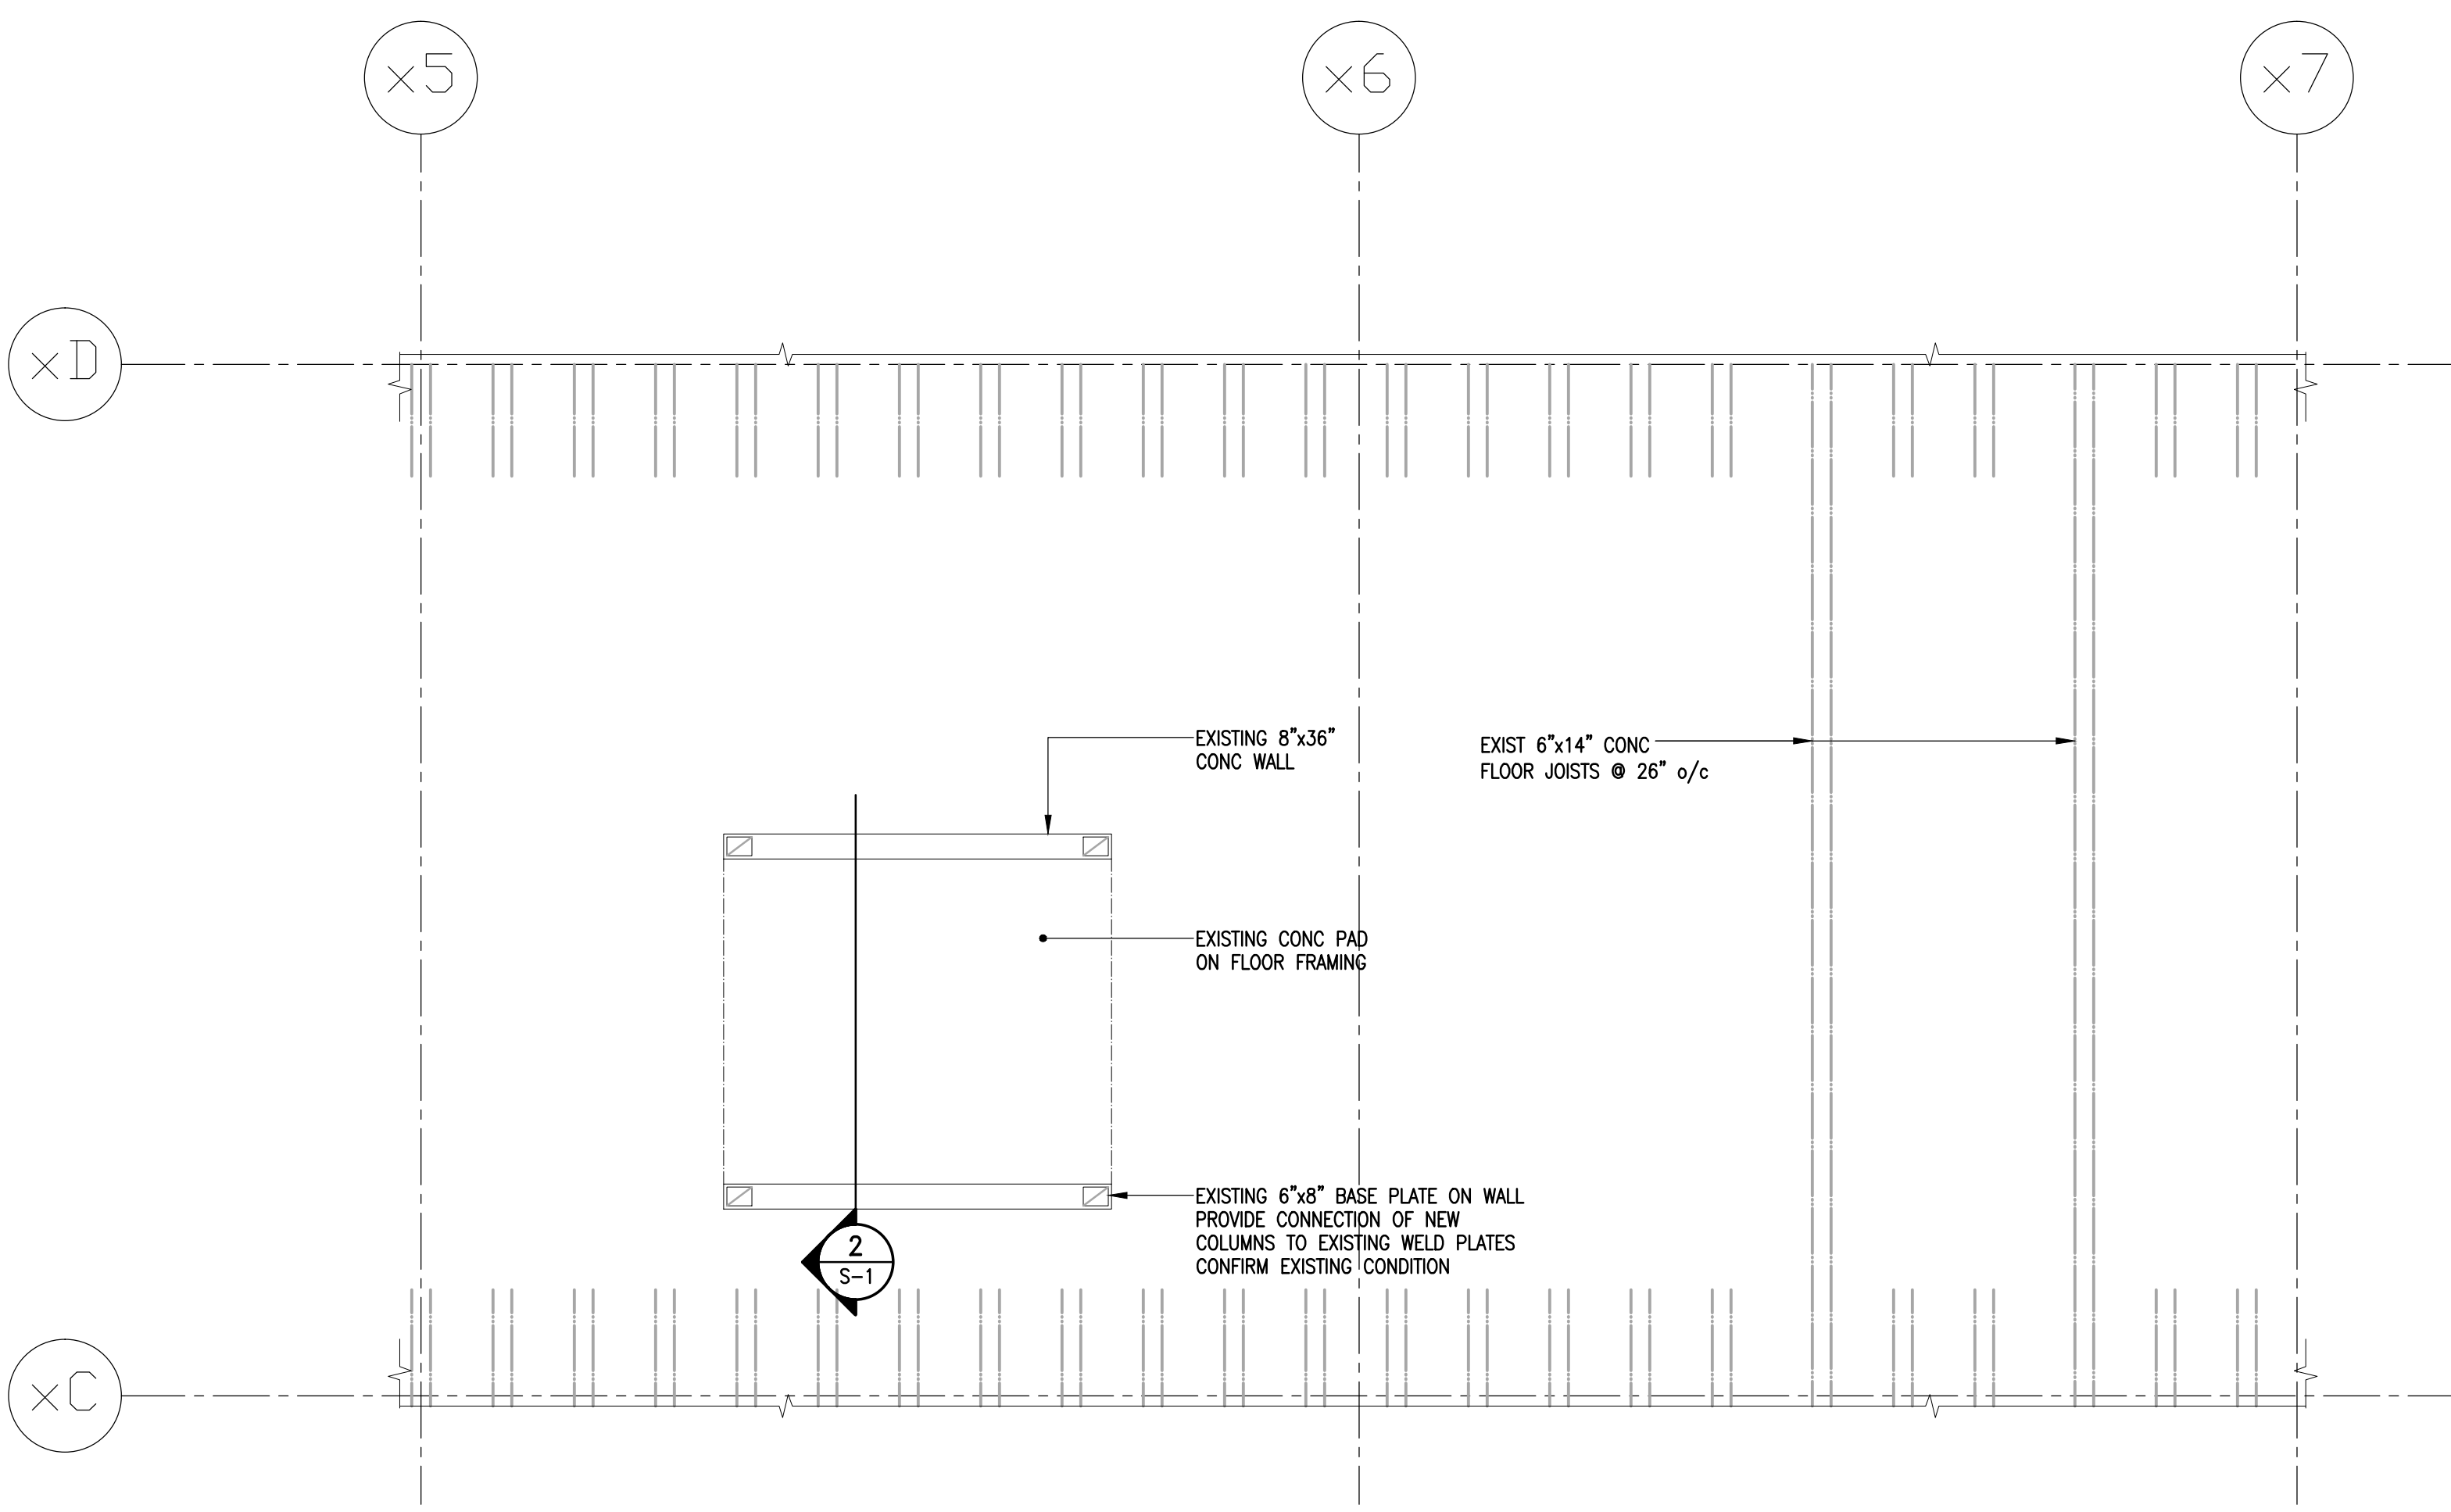

**SIXTH FLOOR MACHINE ROOM PLAN - NEW CONSTRUCTION**  
1/4" = 1'-0"

- REMOVAL OF EXISTING COOLING TOWER UNIT AND FRAMING BY OTHERS. DO NOT DAMAGE EXISTING WELD PLATES ON CONCRETE WALL.
- DESIGN FLOOR LIVE LOAD = 100 PSF

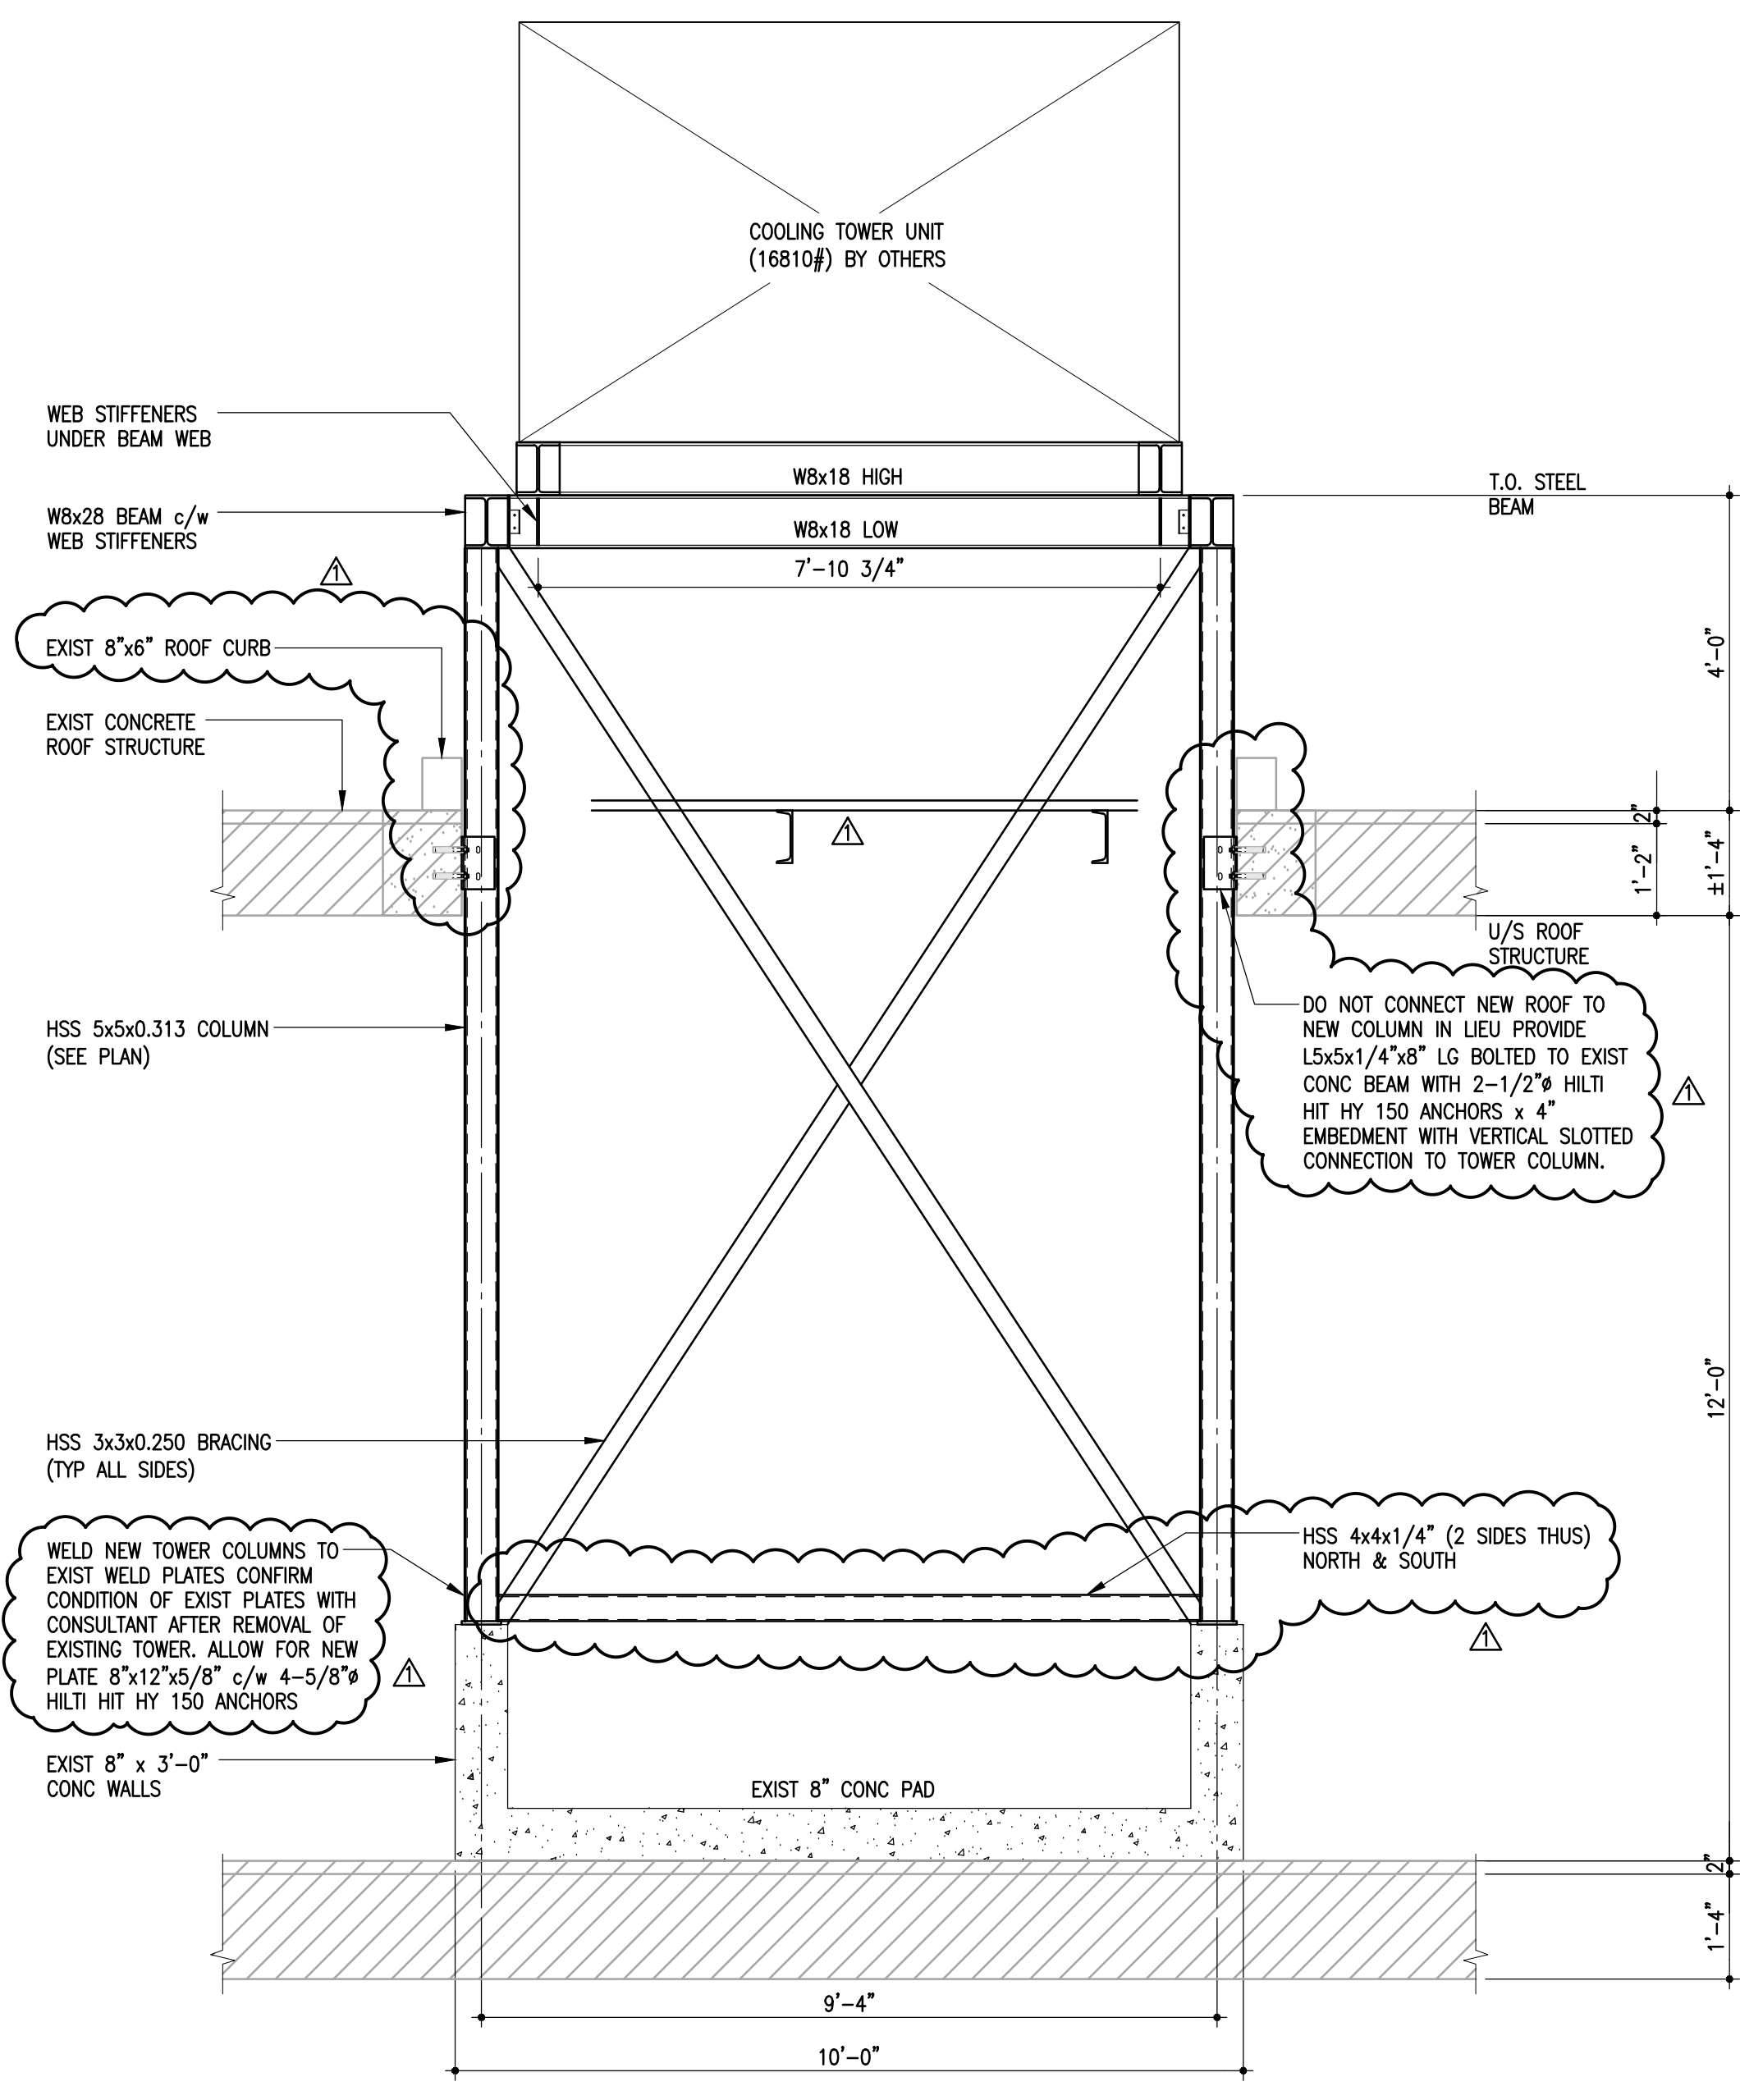

**SECTION 2**  
S-1 1/2" = 1'-0"

WELD NEW TOWER COLUMNS TO EXIST WELD PLATES CONFORM CONDITION OF EXIST PLATES WITH CONSULTANT AFTER REMOVAL OF EXISTING TOWER. ALLOW FOR NEW PLATE 8"x12"x5/16" o/c x 4-5/8" HLT HIT BY 150 ANCHORS

DO NOT CONNECT NEW ROOF TO NEW COLUMN IN LEU PROVIDE 15x5x1/4" LG BOLTED TO EXIST CONG BEAM WITH 2-1/2" HLT HIT BY 150 ANCHORS x 4" EMBEDMENT WITH VERTICAL SLOTTED CONNECTION TO TOWER COLUMN.

7.		
6.		
5.		
4.		
3.		
2.		
1.	ADDENDUM #1	RDW 29/11/12
NO.	Revisions	BY/DO/DATE

300-273 Carlton Street  
Winnipeg, Manitoba R3C 5R6  
T 204.943.7921  
F 204.943.7927  
2010-0547

**Crosier Kilgour & Partners Ltd.**  
CONSULTING STRUCTURAL ENGINEERS

ORIGINAL DRAWING  
SEALED BY  
R.D. MORPHY  
AND DATED  
NOV. 9, 2012

**SMS ENGINEERING**  
SMS Engineering Ltd. Consulting Engineers  
773 Bunker Street Winnipeg MB Canada R3B 0R3  
Telephone 204.775.0591 Fax 204.772.2153  
sms@smseng.com

Project Title  
**CITY OF WINNIPEG  
COOLING PLANT REPLACEMENT  
151 PRINCESS STREET  
BID OPPORTUNITY 887-2012**

Drawing Title  
**MACHINE ROOM COOLING PLANT  
PLANS AND SECTIONS**

Drawn By MPH	Checked By RDW	Approved By RDW
Scale AS NOTED	Date NOV. 2012	Project No. 09-307-02
Revision Number 1	Drawing Number S1	Sheet Order 1 OF 1