

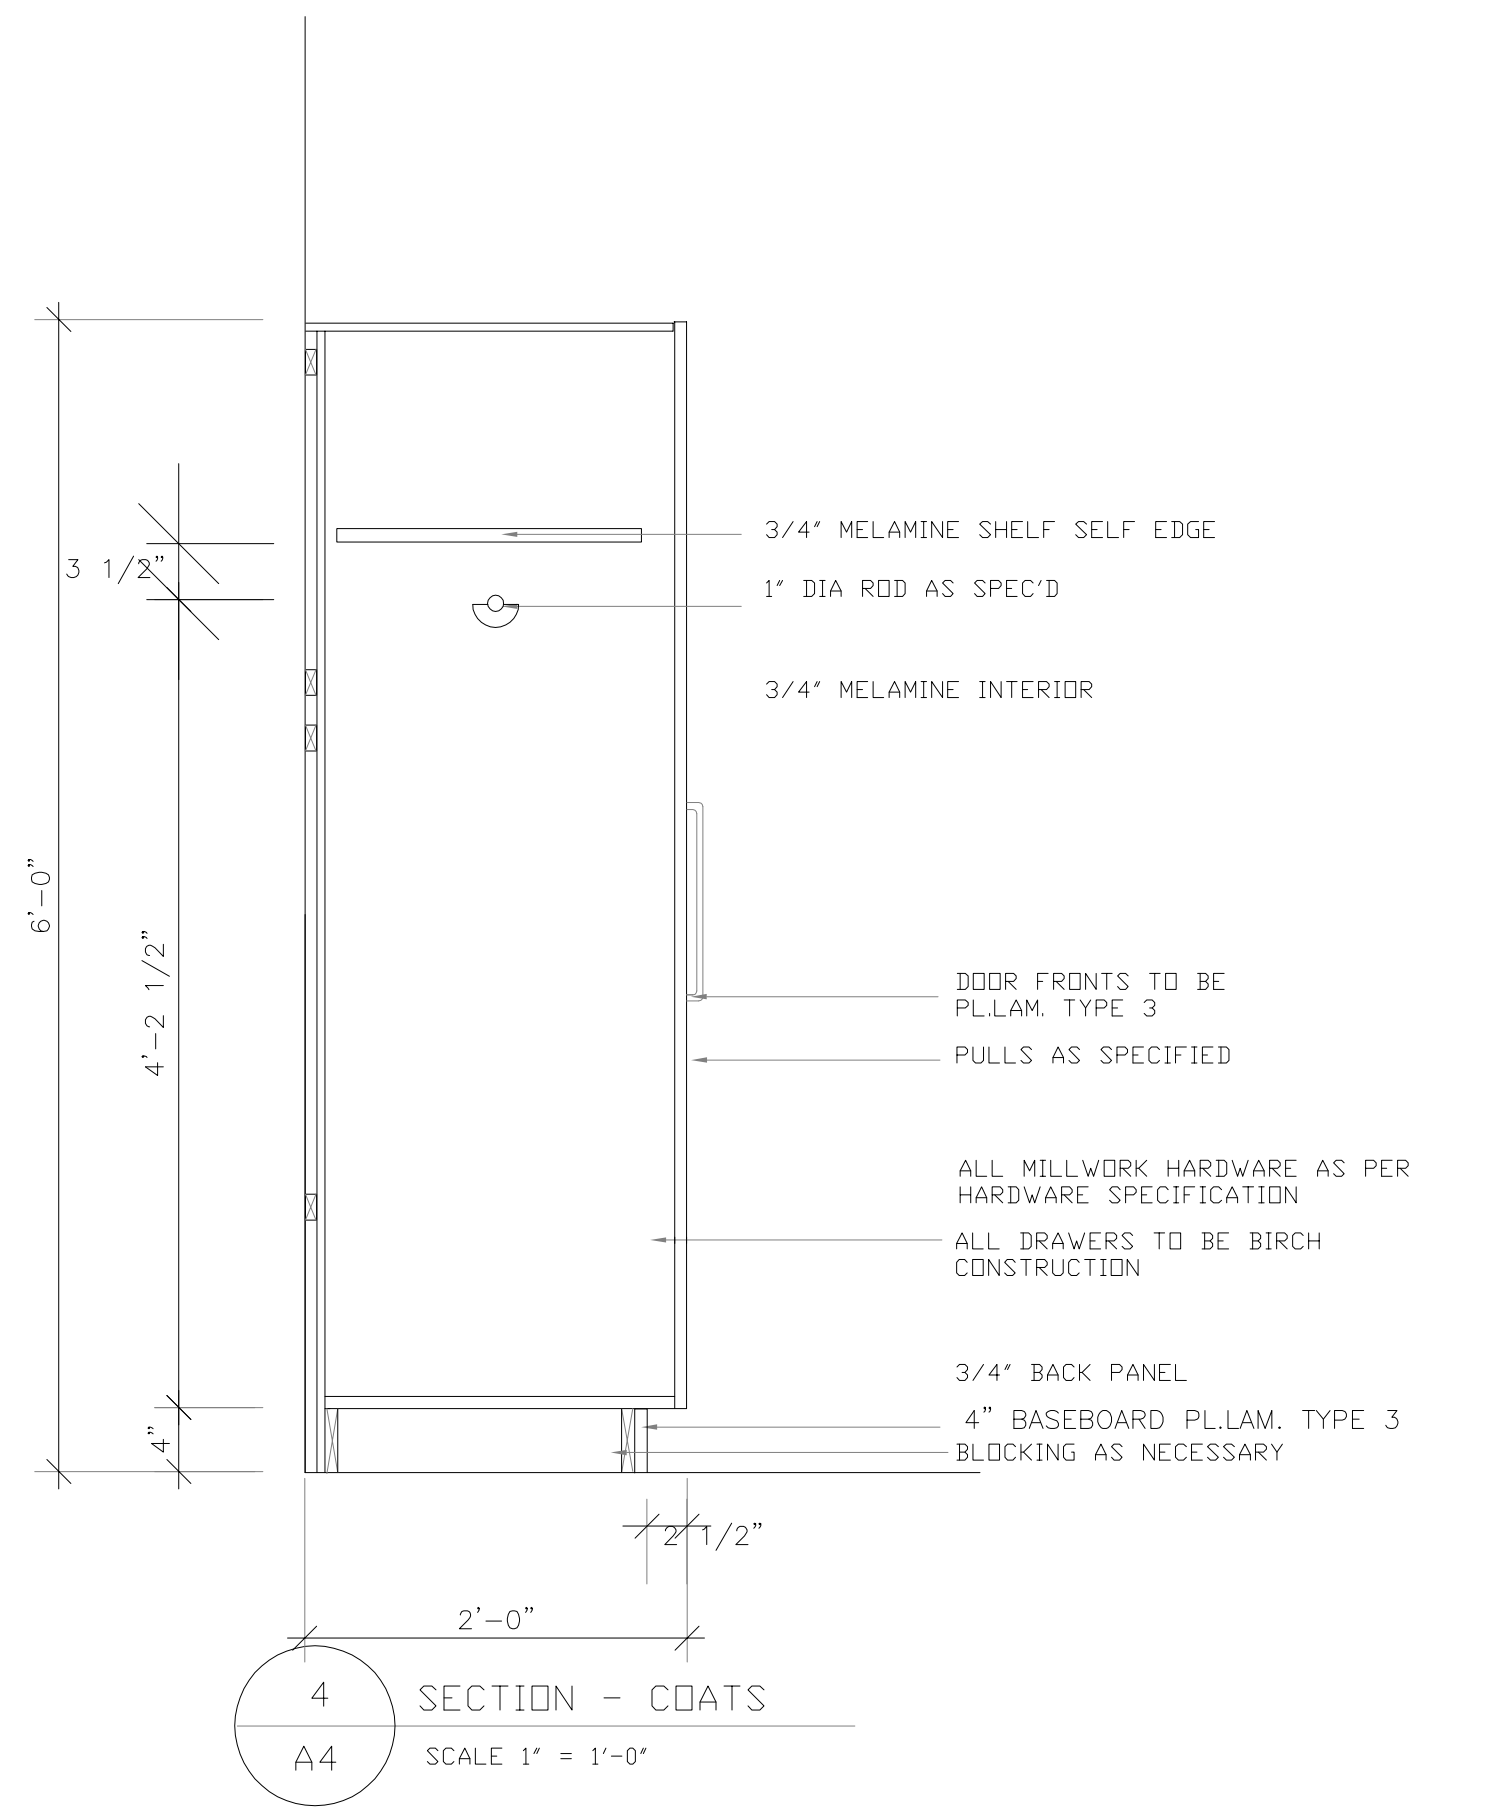
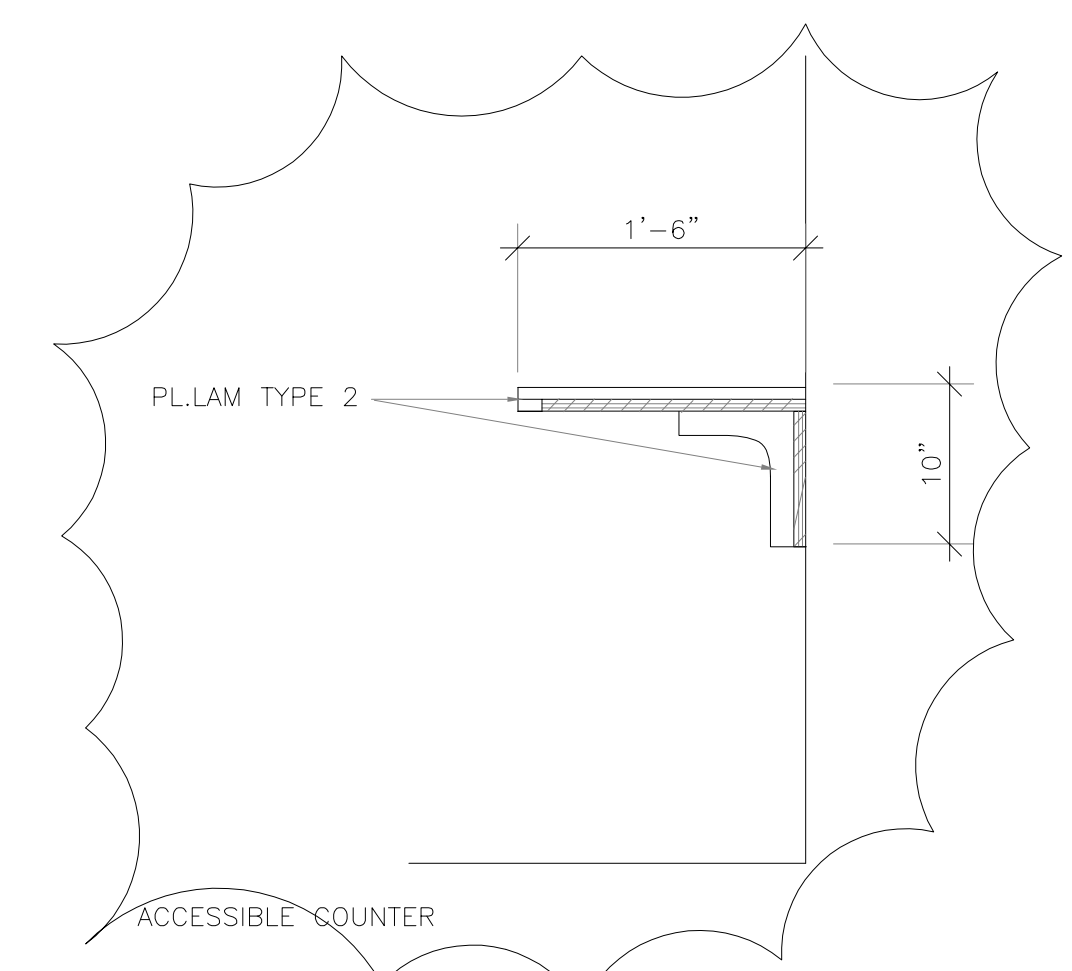
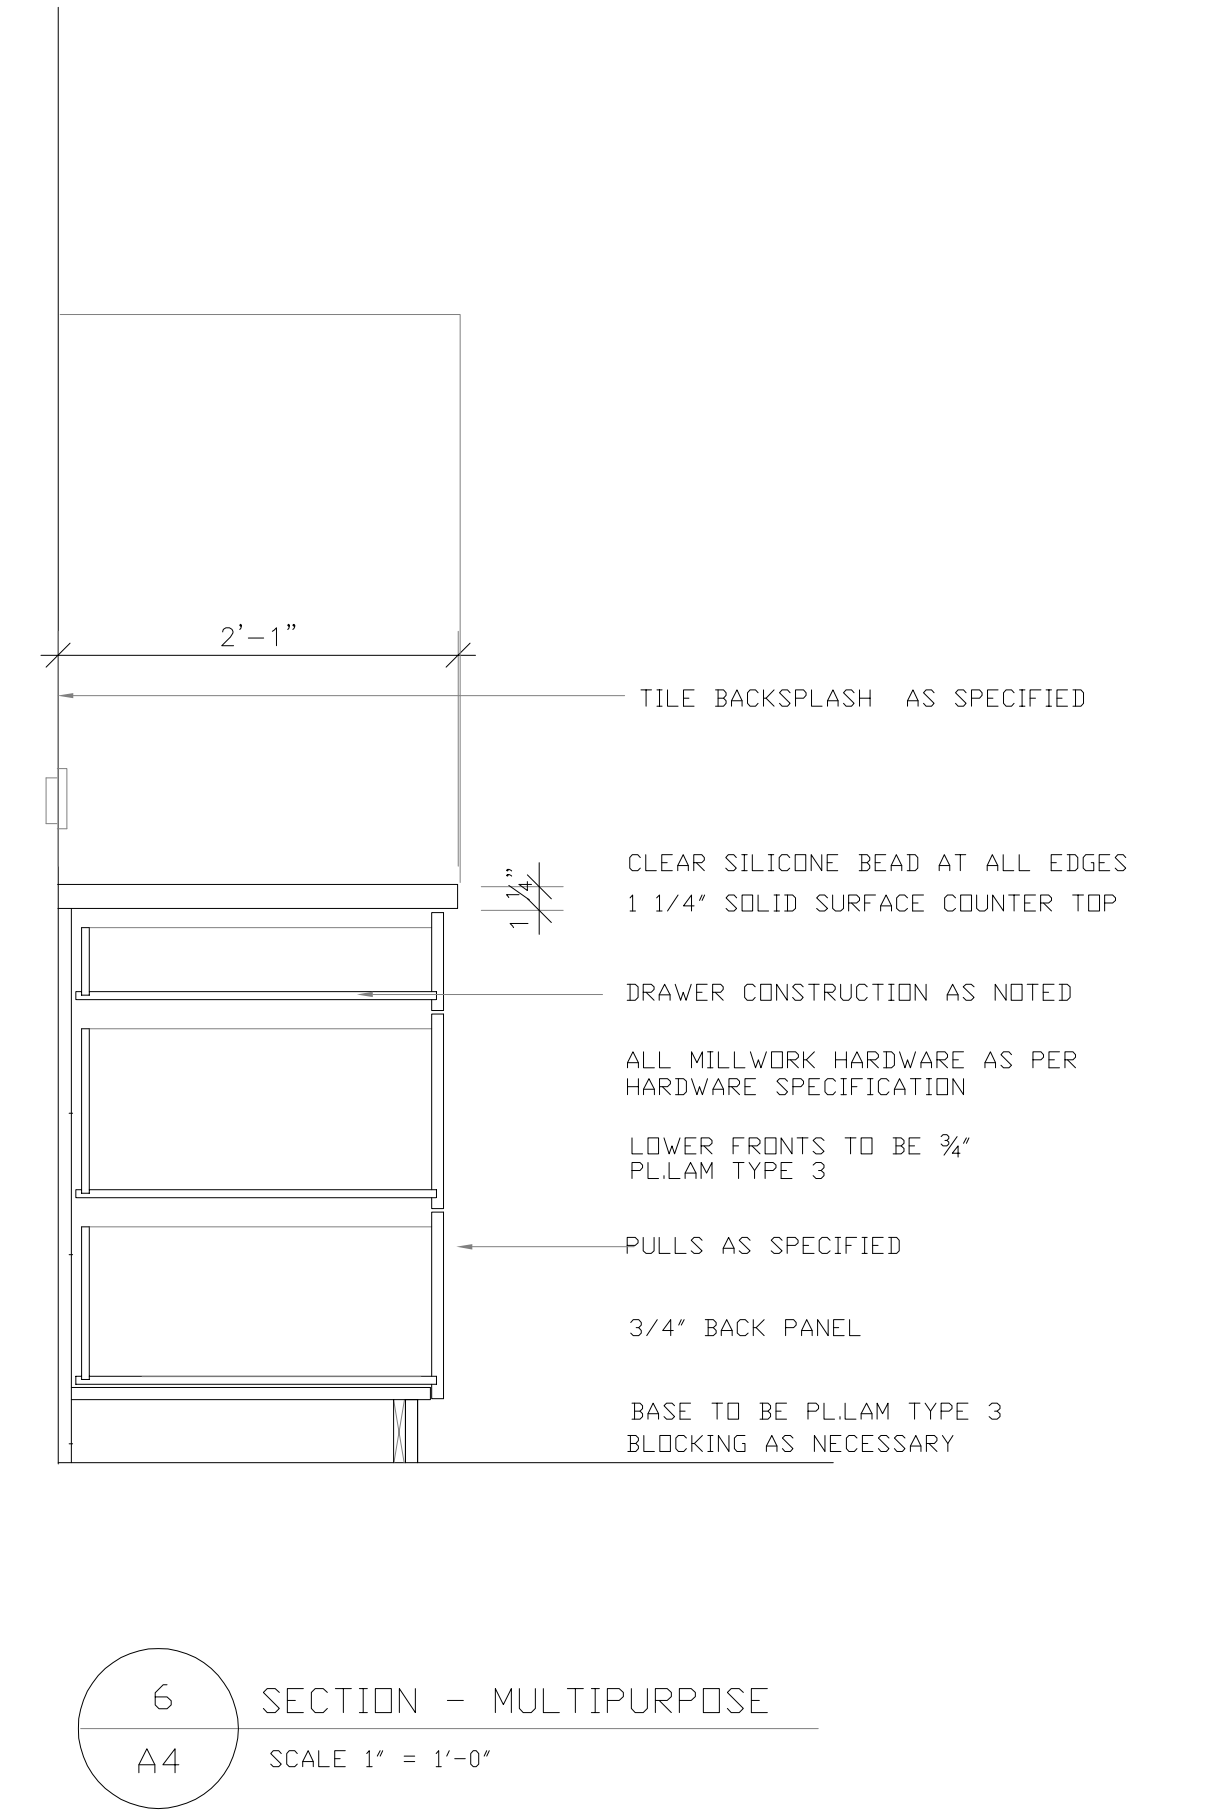
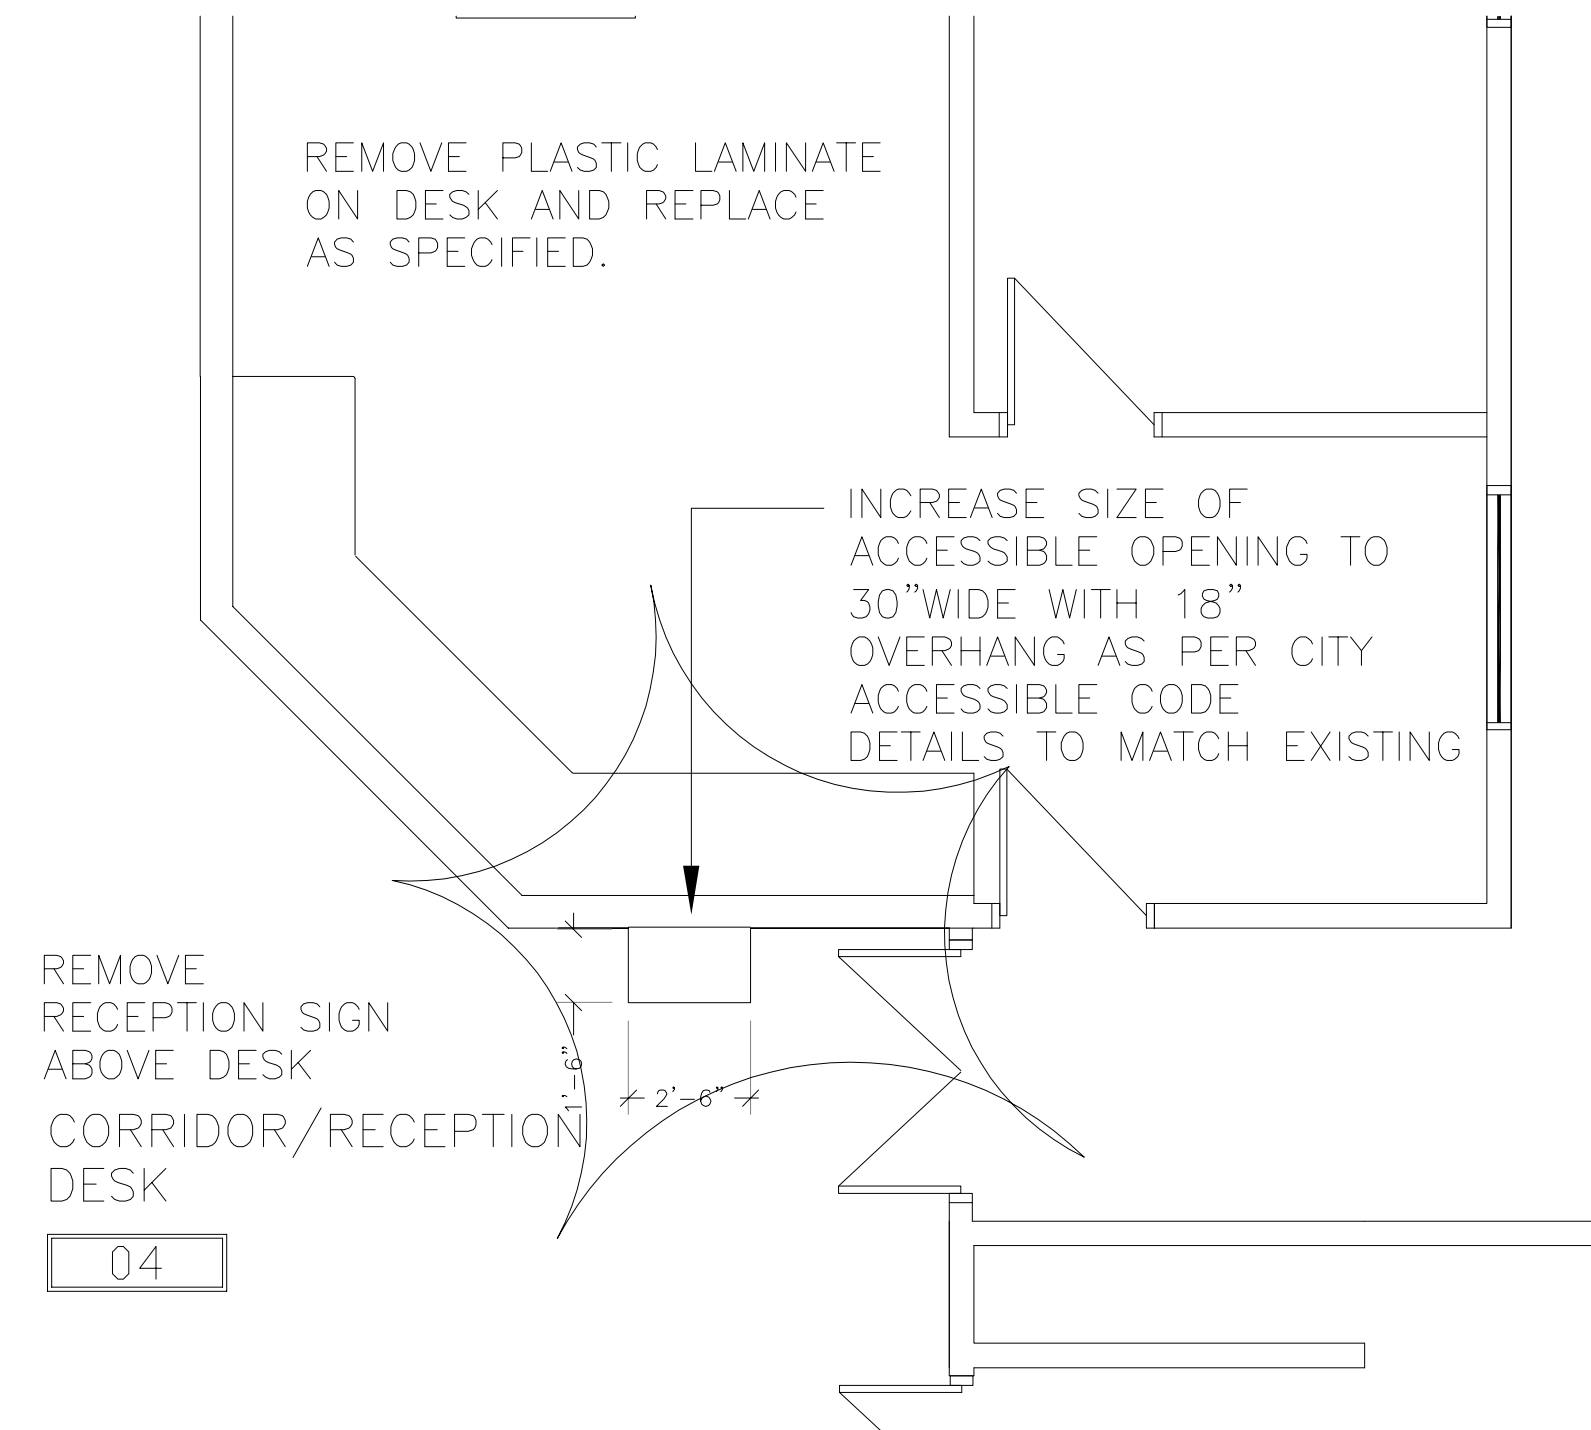


CORRIDOR PLAN

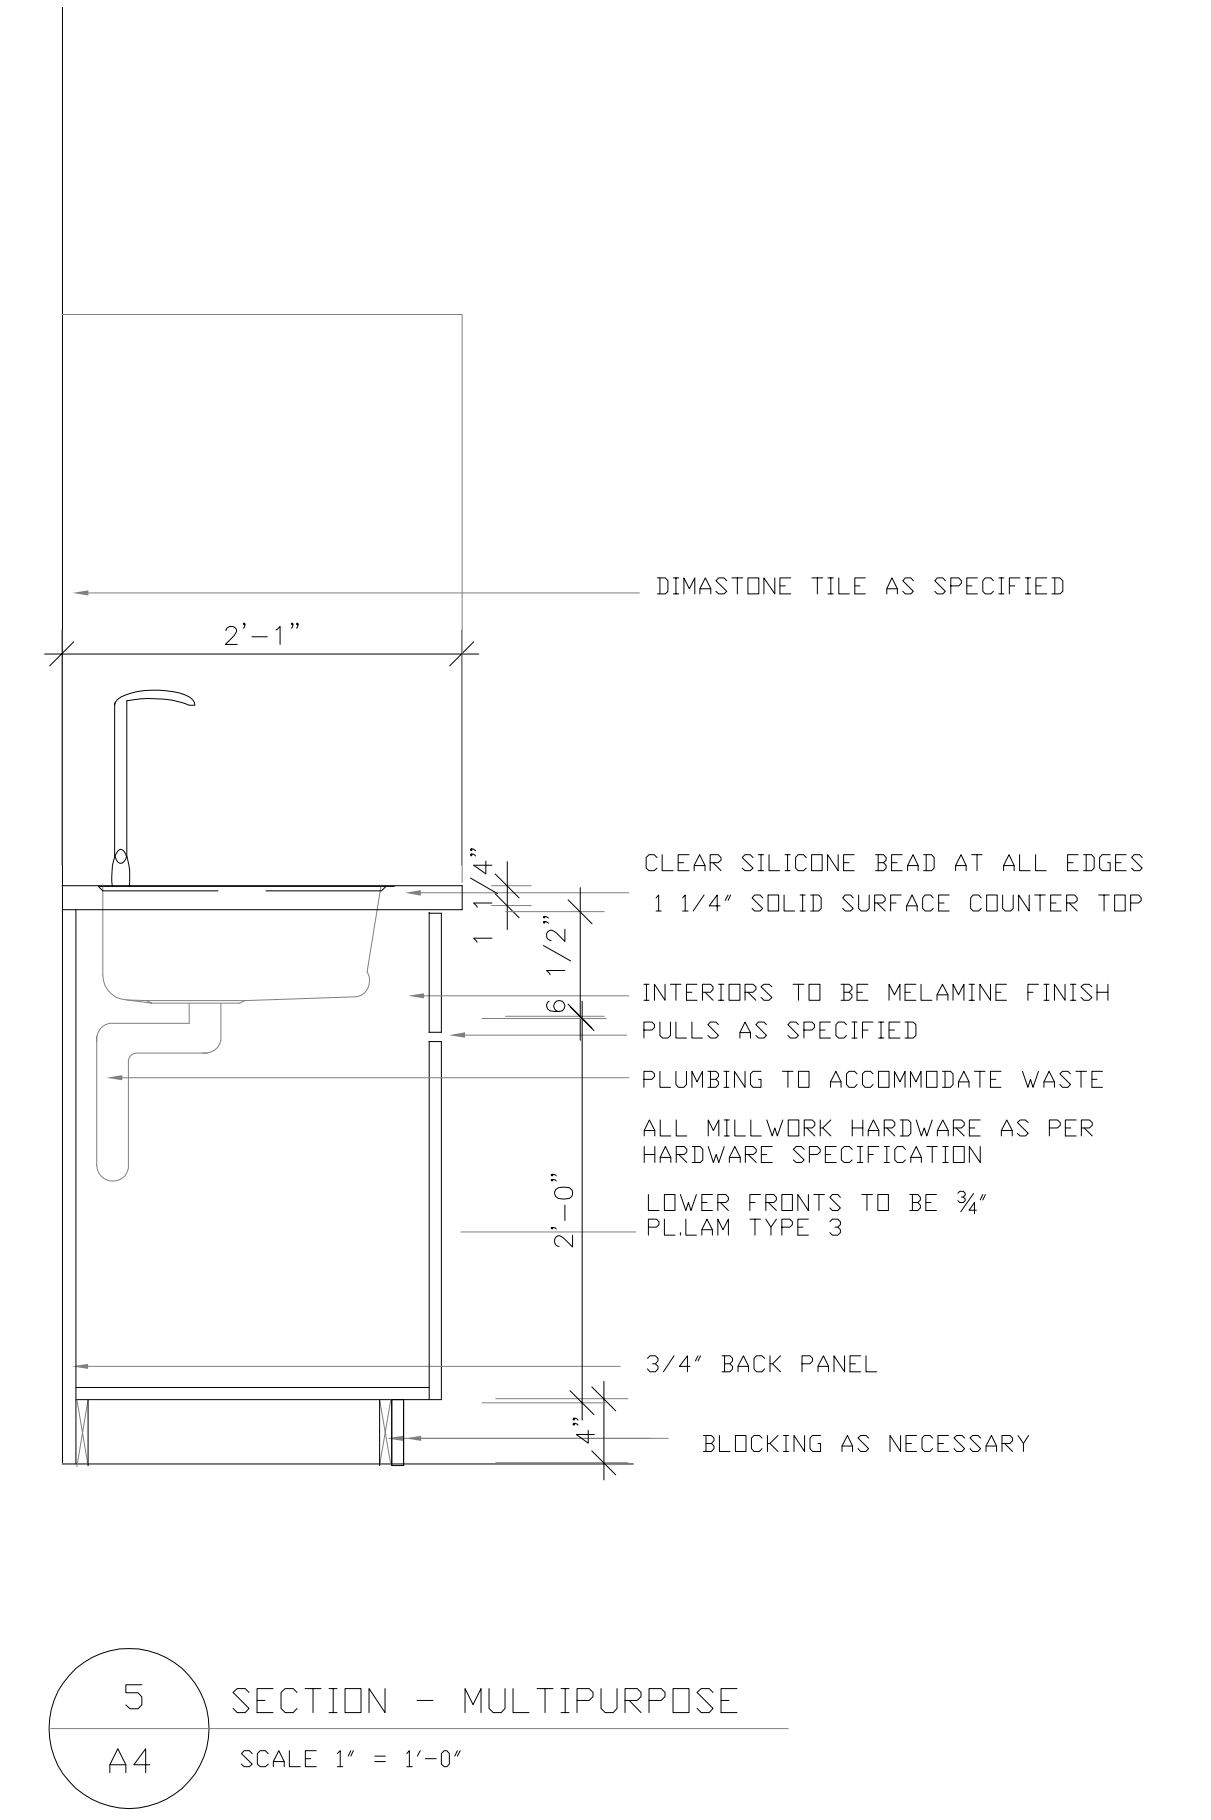

TYPICAL CORRIDOR ELEVATION

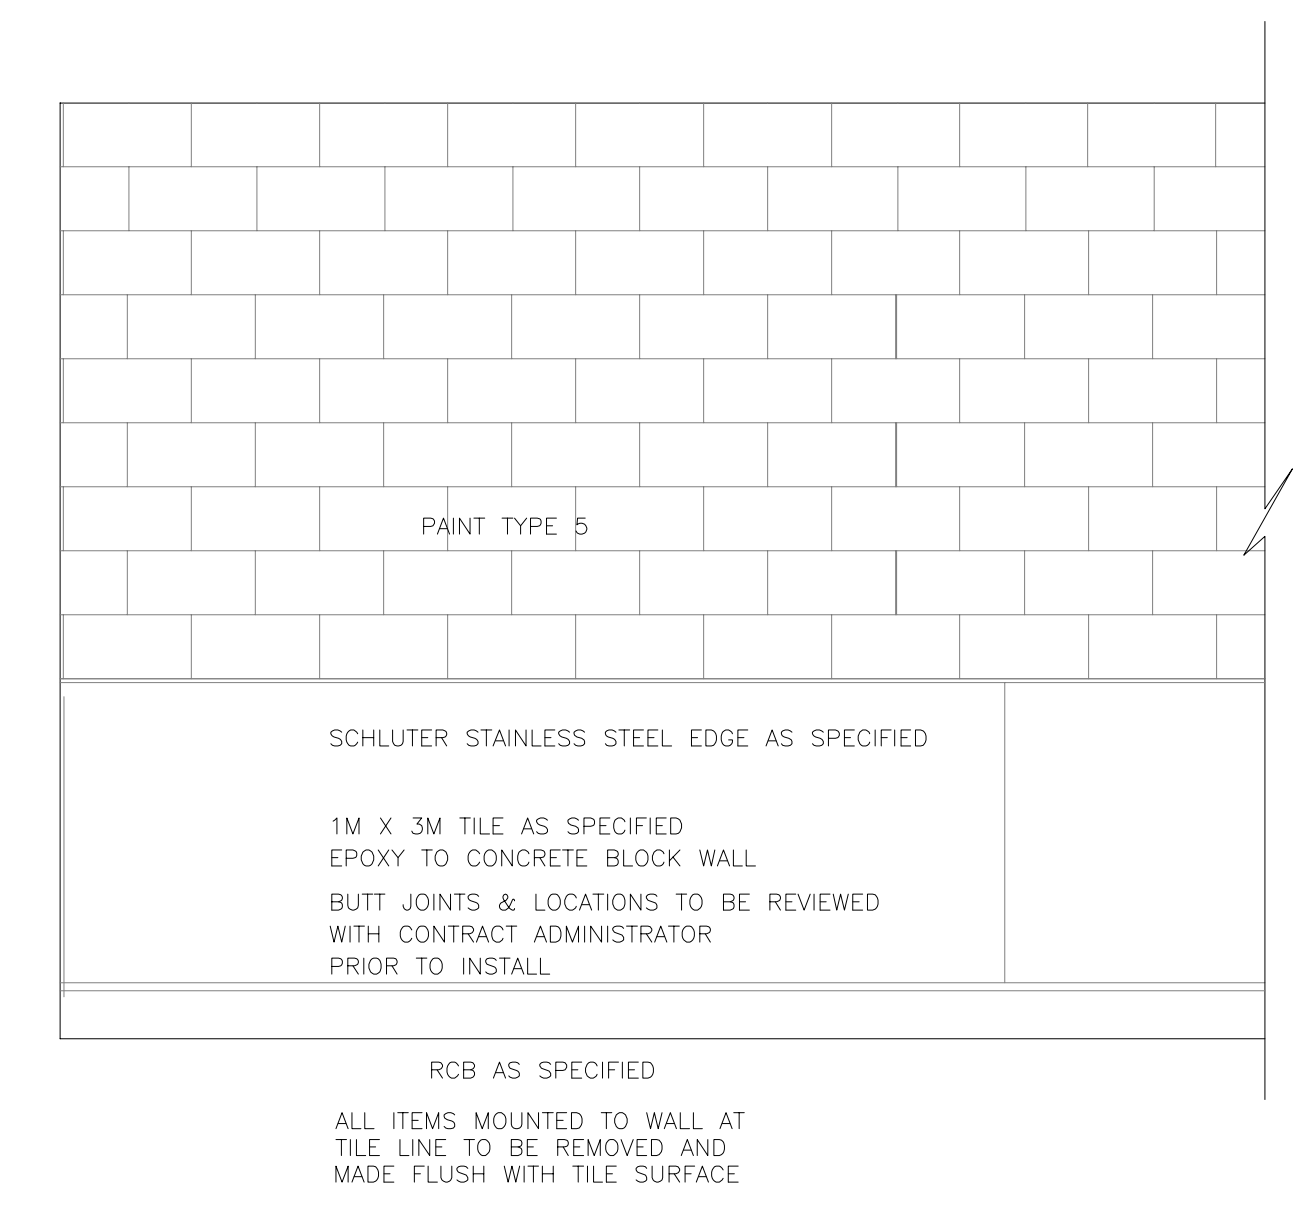

2	APRIL 5, 2013	ADDENDUM #1	M.G.
1	MARCH 20, 2013	ISSUED FOR CONSTRUCTION	M.G.
0	MARCH 11, 2013	ISSUED FOR TENDER	M.G.

NO.	DATE	DESCRIPTION	BY
-----	------	-------------	----

DRAWN BY: PRINTING DATE

The contractor is to verify dimensions and data noted herein with conditions on the site and is held responsible for reporting any discrepancy to the contract administrator for adjustment.



SYNERGY INTERIOR DESIGN INC.  
13 Rosewarne Avenue WINNIPEG, MB Canada R2M 0V8  
204.233.9159  
malvine@synergyinteriors.com

DATE MARCH 11, 2013 SCALE 1/4" = 1'-0" REVISIONS  
DRAWN BY M.G. CHECKED BY M.G.

MULTIPURPOSE/BOARDROOM UPGRADES PHASE 2  
FORT ROUGE LEISURE CENTER 625 OSBORNE ST SOUTH  
WINNIPEG, MANITOBA

PROJECT SHEET  
HALLWAYS & DETAILS SECTIONS, MILLWORK NOTES  
BID OPPORTUNITY NO. 939-2012 DWG.