
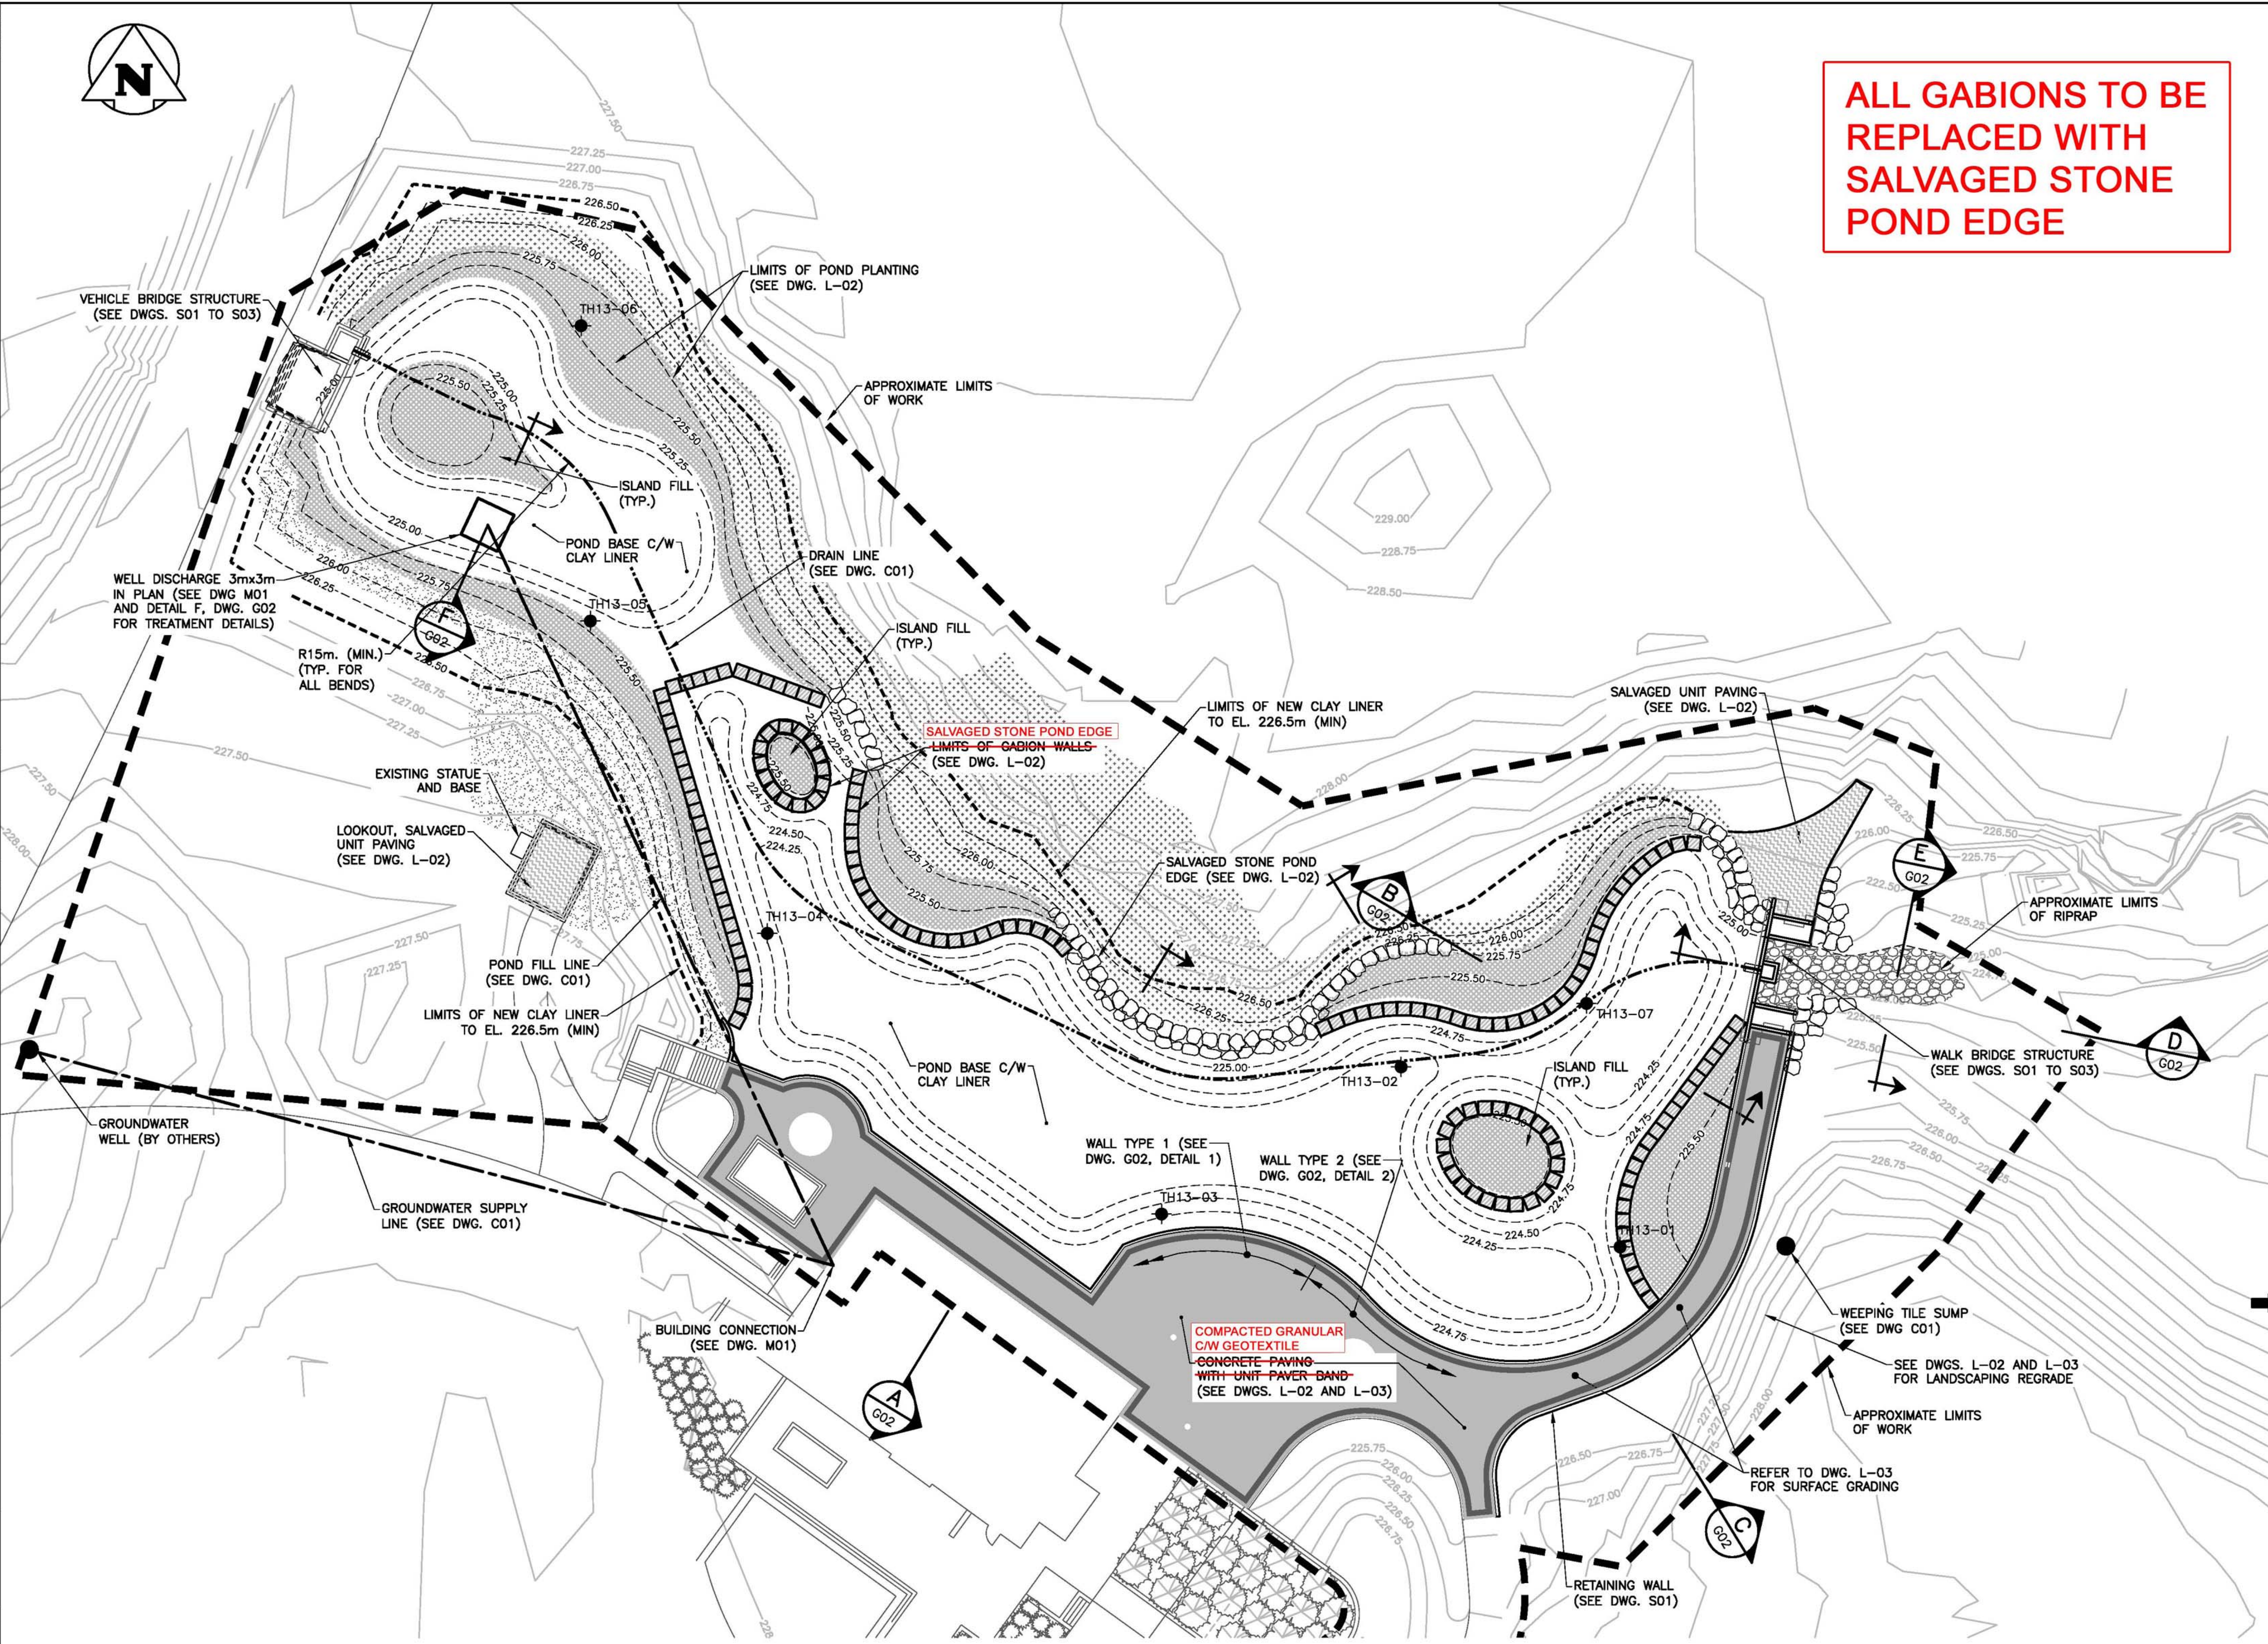


File Name: P:\Projects\2013\13-0109-001\Doc\Control\Released\DWG\13-0109-001-Rev.0.dwg - Tab: 0001 Plotted By: D.Deroche 14/04/14 [Mon 2:20pm]

ALL GABIONS TO BE REPLACED WITH SALVAGED STONE POND EDGE

- LEGEND:**
- TH-01 2013 TESTHOLE BY KGS GROUP
  - 225.00 PRE-CONSTRUCTION TOPOGRAPHY
  - - - 225.00 DESIGN GRADING (REFER TO DWG. L-02)
  - - - - - DRAIN LINE
  - GROUNDWATER SUPPLY LINE OR POND FILL LINE
  - CONCRETE PAVING REFER TO DWG L-02
  - COMPACTED GRANULAR C/W GEOTEXTILE
  - TURF GRASS SEED REFER TO DWG L-02
  - POND PLANTING REFER TO DWG L-02
  - NATIVE GRASS SEED REFER TO DWG L-02
  - CONCRETE UNIT PAVING ON GRANULAR REFER TO DWG L-02

- NOTES:**
1. ALL UNITS ARE IN METERS UNLESS SPECIFIED OTHERWISE. ELEVATIONS ARE IN METERS ABOVE MEAN SEA LEVEL (MSL).
  2. THE PRE-CONSTRUCTION TOPOGRAPHY OUTSIDE THE LIMITS OF THE POND WAS BASED ON KGS GROUP SURVEY, APRIL 30, 2012. THE PRE-CONSTRUCTION TOPOGRAPHY WITHIN THE LIMITS OF THE POND WAS BASED ON KGS GROUP SURVEY, APRIL 8, 2014.
  3. TESTHOLE LOCATIONS ARE APPROXIMATE.

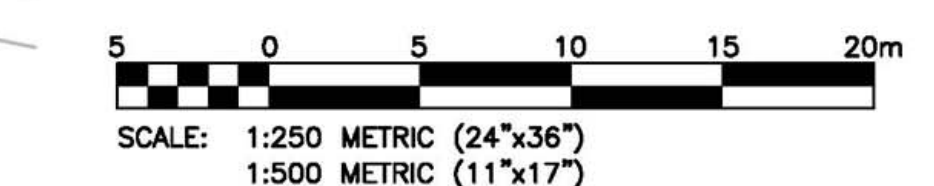

0	14/04/14	ISSUED FOR TENDER	MRJ
NO.	YY/MM/DD	DESCRIPTION	BY

REVISIONS / ISSUE

CLIENT:

**SCATLIF + MILLER + MURRAY Inc.**  
 TEL: 504-878-9444 FAX: 504-872-3443  
 4 - 78 MARKET AVENUE WINNIPEG, MB, CANADA

PROJECT:

**PEGUIS PAVILION  
 POND RENOVATIONS  
 & LANDSCAPING**

DWG. DESCRIPTION:

**SITE PLAN - EARTHWORK**

DESIGN BY:	KJY	DATE (YY/MM/DD):	14/03/12
DESIGN CHECK:	MRJ	DATE:	14/03/18
DRAWN BY:	RBT	DATE:	13/08/30
DWG CHECK:	MRJ	DATE:	14/03/18

DWG. NO. 13-0109-001\_G01

REV: 0

