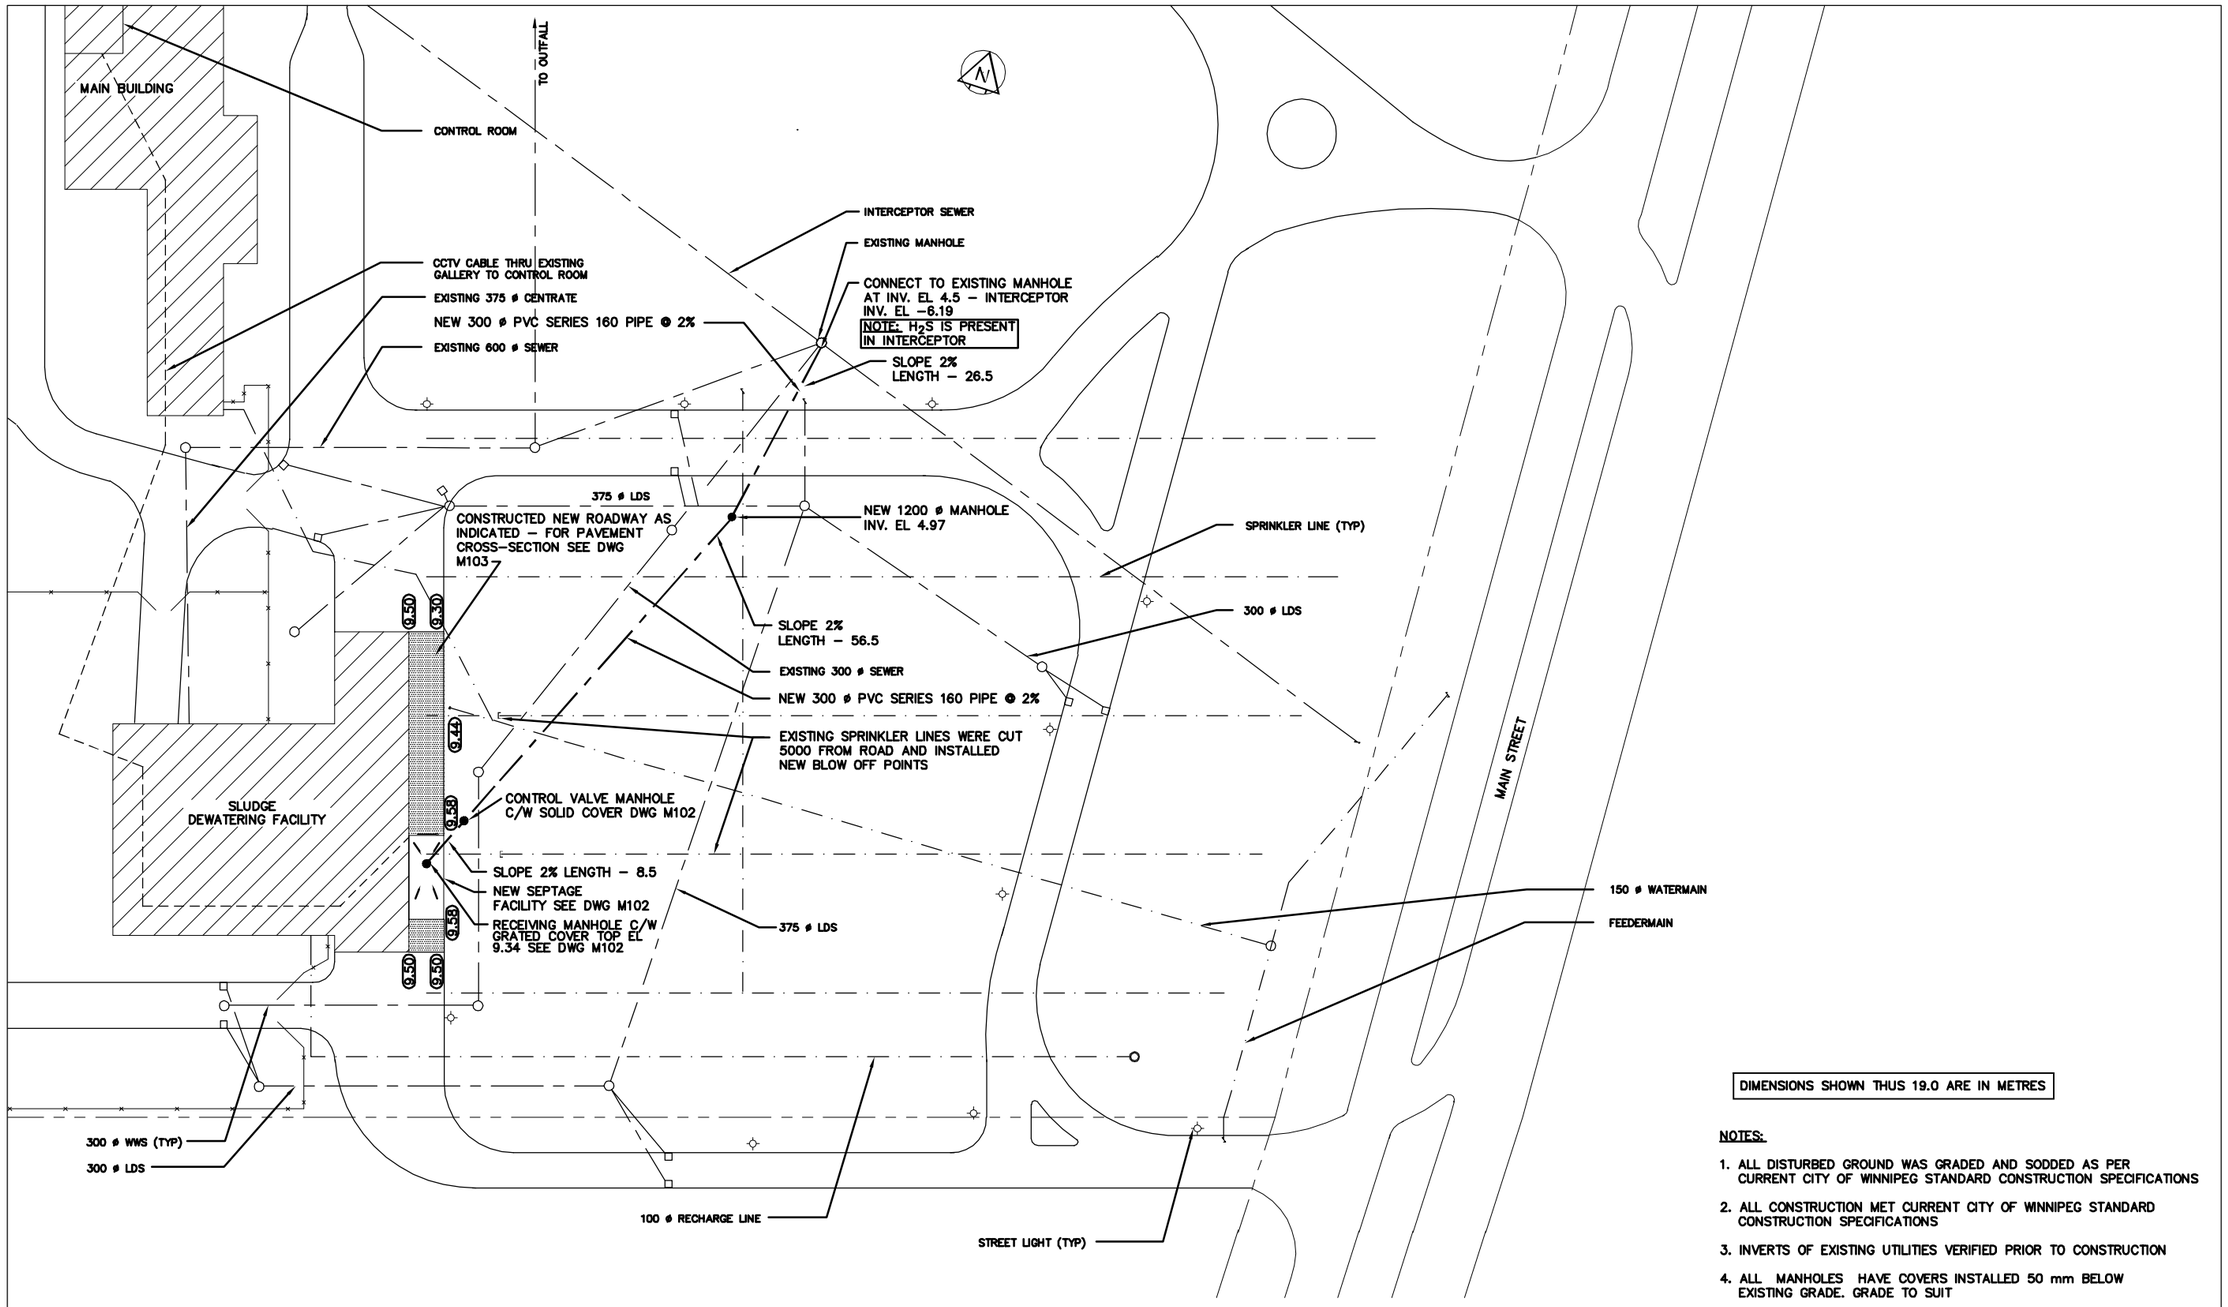

DIMENSIONS SHOWN THUS 19.0 ARE IN METRES

NOTES:

1. ALL DISTURBED GROUND WAS GRADED AND SODDED AS PER CURRENT CITY OF WINNIPEG STANDARD CONSTRUCTION SPECIFICATIONS
2. ALL CONSTRUCTION MET CURRENT CITY OF WINNIPEG STANDARD CONSTRUCTION SPECIFICATIONS
3. INVERTS OF EXISTING UTILITIES VERIFIED PRIOR TO CONSTRUCTION
4. ALL MANHOLES HAVE COVERS INSTALLED 50 mm BELOW EXISTING GRADE. GRADE TO SUIT
5. ALL MANHOLES HAVE SOLID COVERS EXCEPT WHERE NOTED

BENCH MARK – CAP ON PRIMARY CLARIFIER
ELEVATION – 9.784 (PLANT DATUM)

AS CONSTRUCTED
DATE MARCH 1991 BY LOC
APPROVED BY

NO.	REVISIONS	DATE	BY
1.	AS-CONSTRUCTED	MAR91	LOC

B.M. ELEV.

WARDROP ENGINEERING INC.
MacLAREN ENGINEERS INC.
ENGINEERING CONSULTANTS

DESIGNED BY L. C. CHECKED BY
DRAWN BY E. G. /CAD APPROVED BY D. H.
HOR. SCALE: VERTICAL: 1:400
DATE DATE OCT 11/89

CONSULTANT DRAWING NO. 10024–M101

THE CITY OF WINNIPEG
WORKS AND OPERATIONS DIVISION
WATERWORKS, WASTE & DISPOSAL DEPARTMENT

NORTH END WATER POLLUTION CONTROL CENTER
SEPTAGE FACILITIES – MECHANICAL

SITE PLAN

CITY DRAWING NUMBER
SHEET OF
NEP 1795