NOTE :This plot is to be used for general pipe routing information only.
All other data to be confirmed by the Gas Distribution Planning & Design Dept.

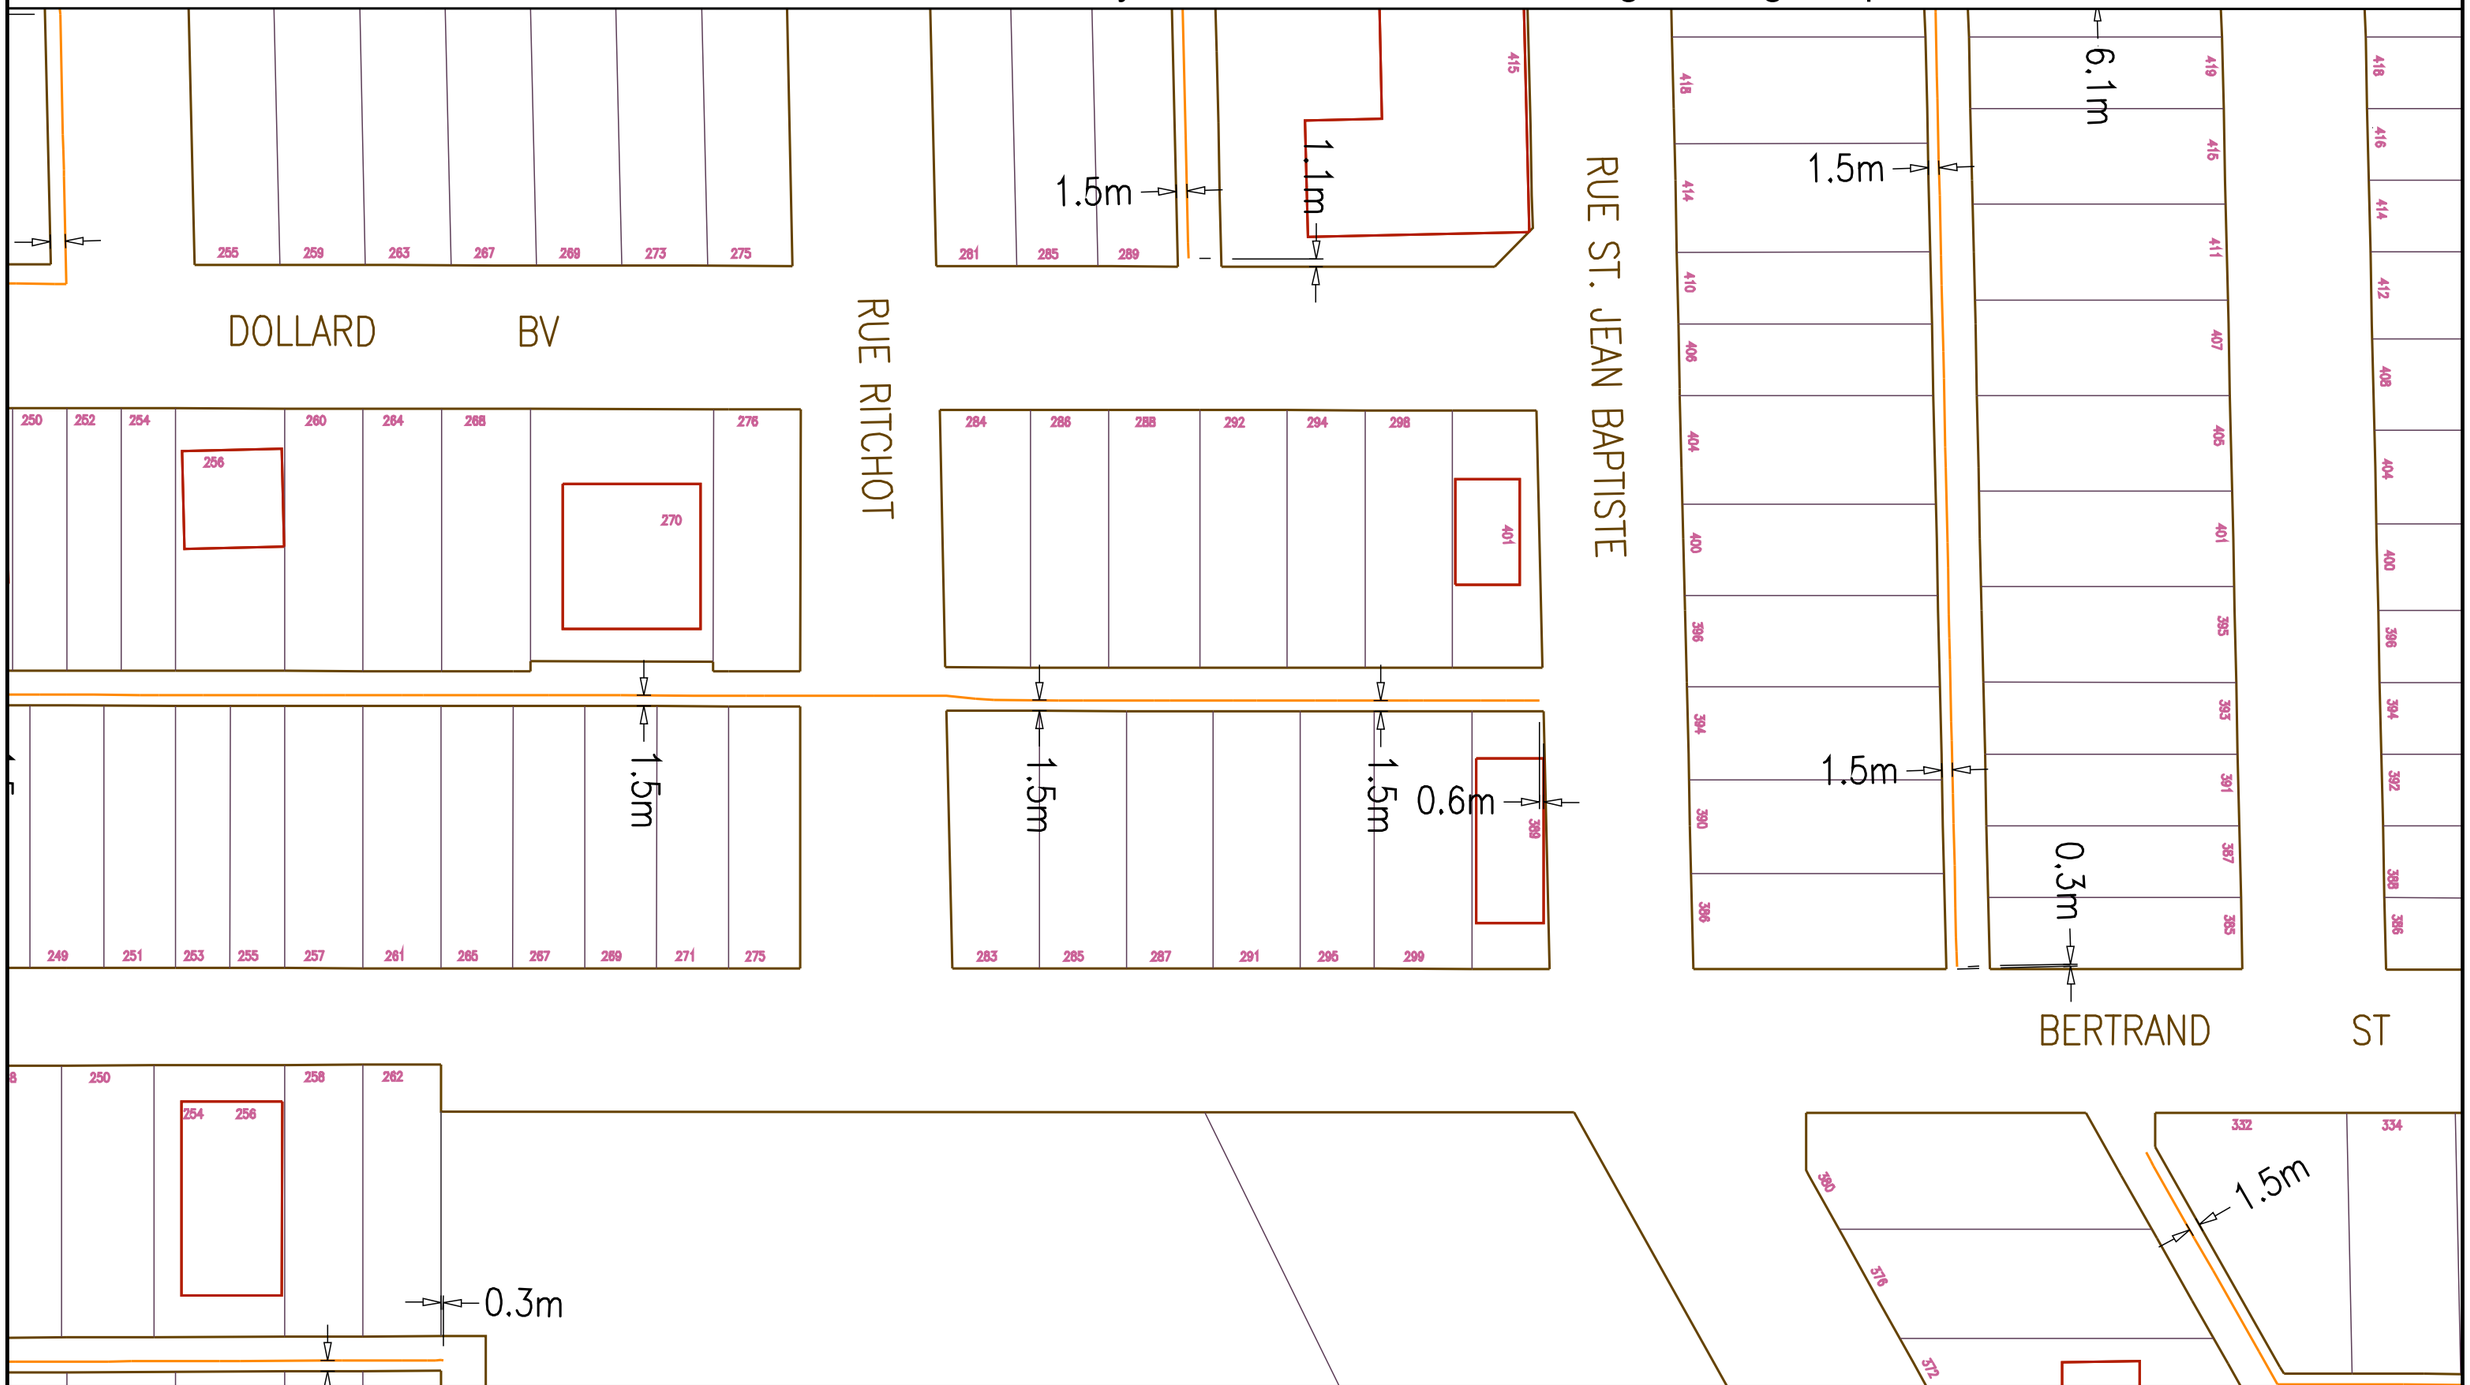

NOTE: Maximum Operating Presure (MOP) is 420 kpa unless otherwise noted.
Outside Diameter (O.D.) of pipe in millimeters unless otherwise noted.