


A1 - 841694
2013-12-10
J:\COMMON_DEFAULT.CBP
P:\60273041\000-CADD\02-SHEETS\CS\60273041-01-CS-602.DWG

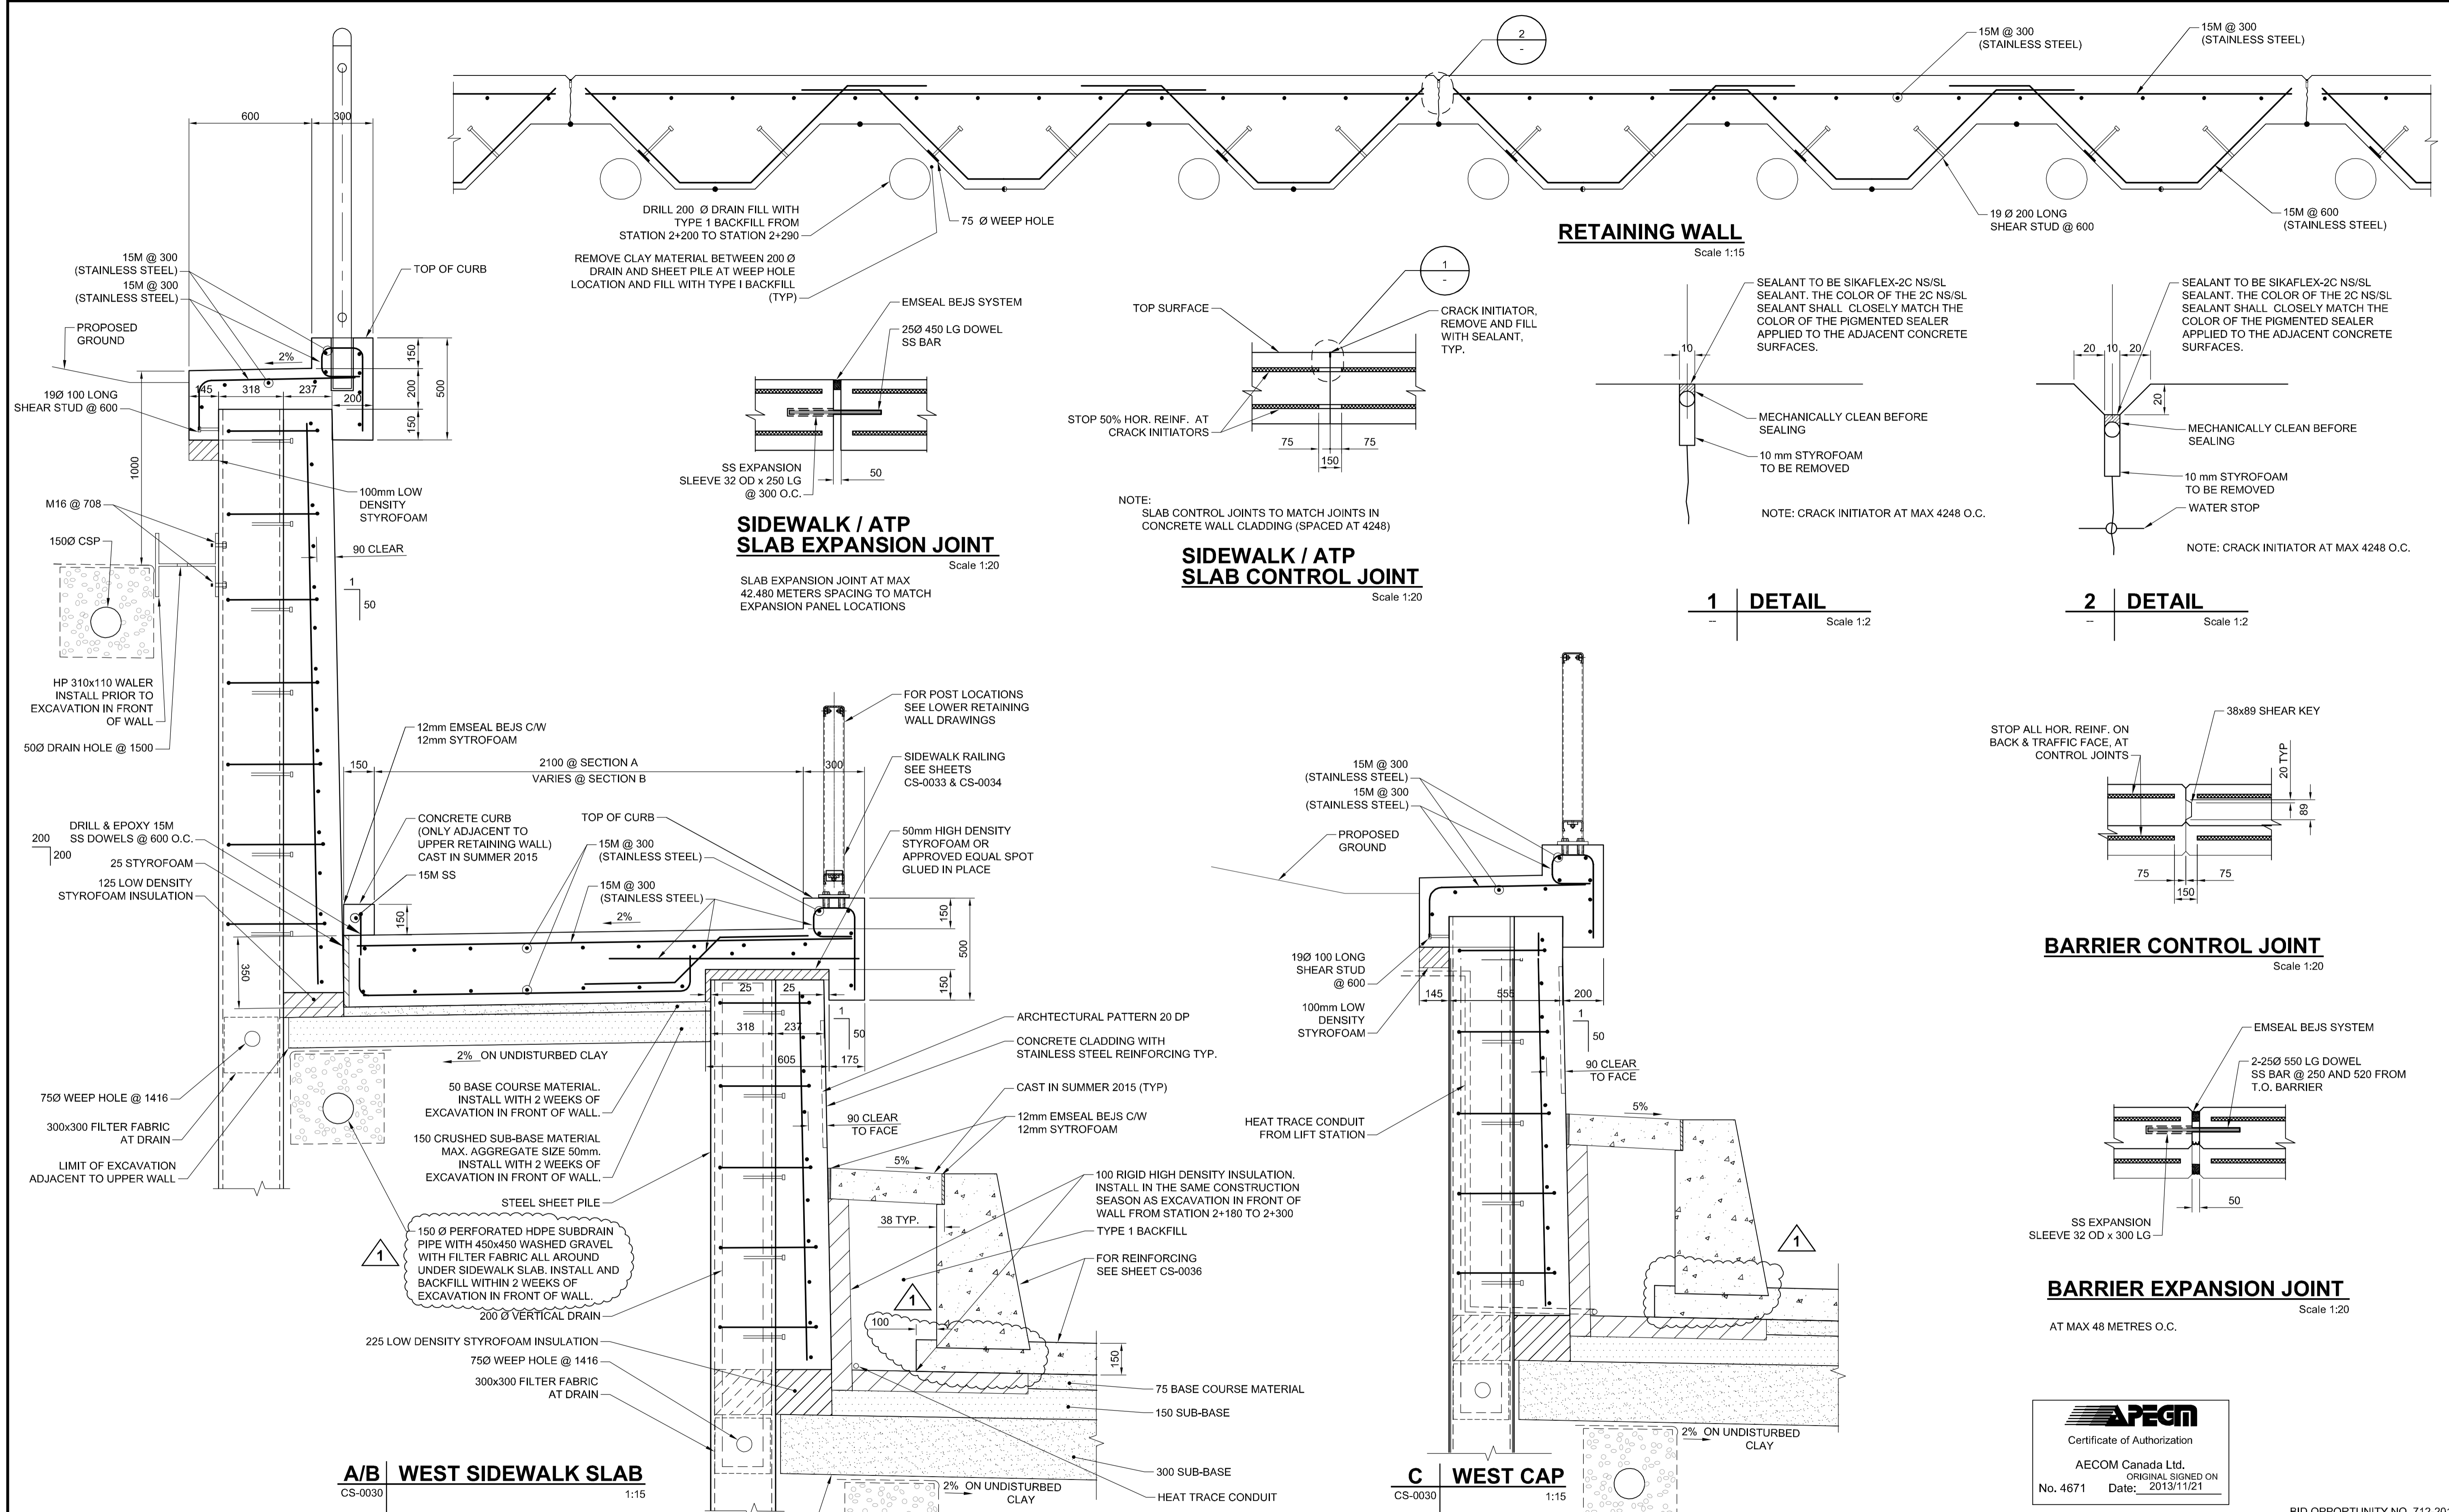

APECM
Certificate of Authorization
AECOM Canada Ltd.
ORIGINAL SIGNED ON
No. 4671 Date: 2013/11/21

BID OPPORTUNITY NO. 712-2013

LOCATION APPROVED UNDERGROUND STRUCTURES		B.M. ELEV.	
SUPV. U/G STRUCTURES COMMITTEE	DATE		
1	ISSUED FOR ADDENDUM	2013/12/10	DJH
0	ISSUED FOR TENDER	2013/11/21	KC
NO.	REVISIONS	DATE	BY

AECOM		ENGINEER'S SEAL	
DESIGNED BY	FT	CHECKED BY	EBL
DRAWN BY	DJH	APPROVED BY	EBL
HOR. SCALE:	AS NOTED	RELEASED FOR CONSTRUCTION BY:	
VERTICAL:	AS NOTED		
DATE	2013-06-04	DATE	

PROVINCE OF MANITOBA
ORIGINAL SIGNED BY
F. TABET
Member 38656
ON NOV 21, 2013
REGISTERED PROFESSIONAL ENGINEER

THE CITY OF WINNIPEG PUBLIC WORKS DEPARTMENT

PLESSIS ROAD TWINNING AND GRADE SEPARATION AT CN REDDITT SUBDIVISION CONTRACT 3

WEST CAP, SIDEWALK SLAB AND DETAILS

CITY DRAWING NUMBER U238-2014-2031
SHEET 31 OF 37

CS-0031