




5 SECTION
1:10

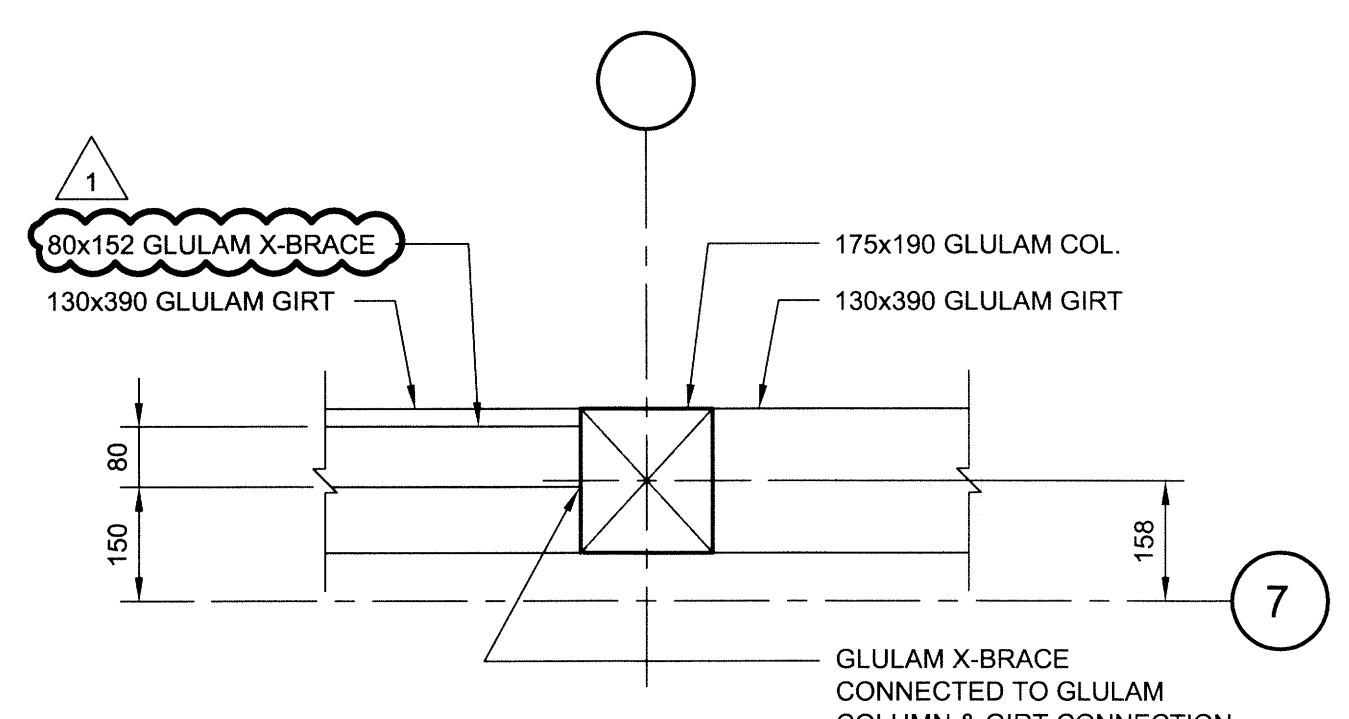


6 SECTION
1:10

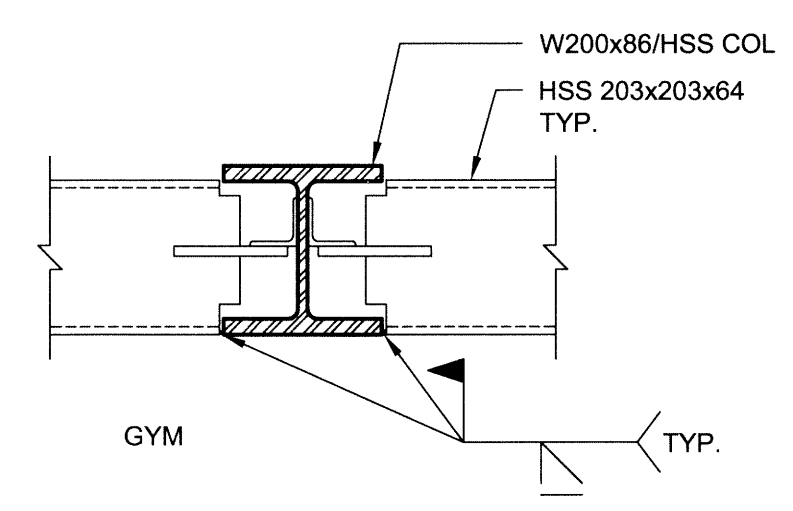


7 TYPICAL DETAIL
1:10

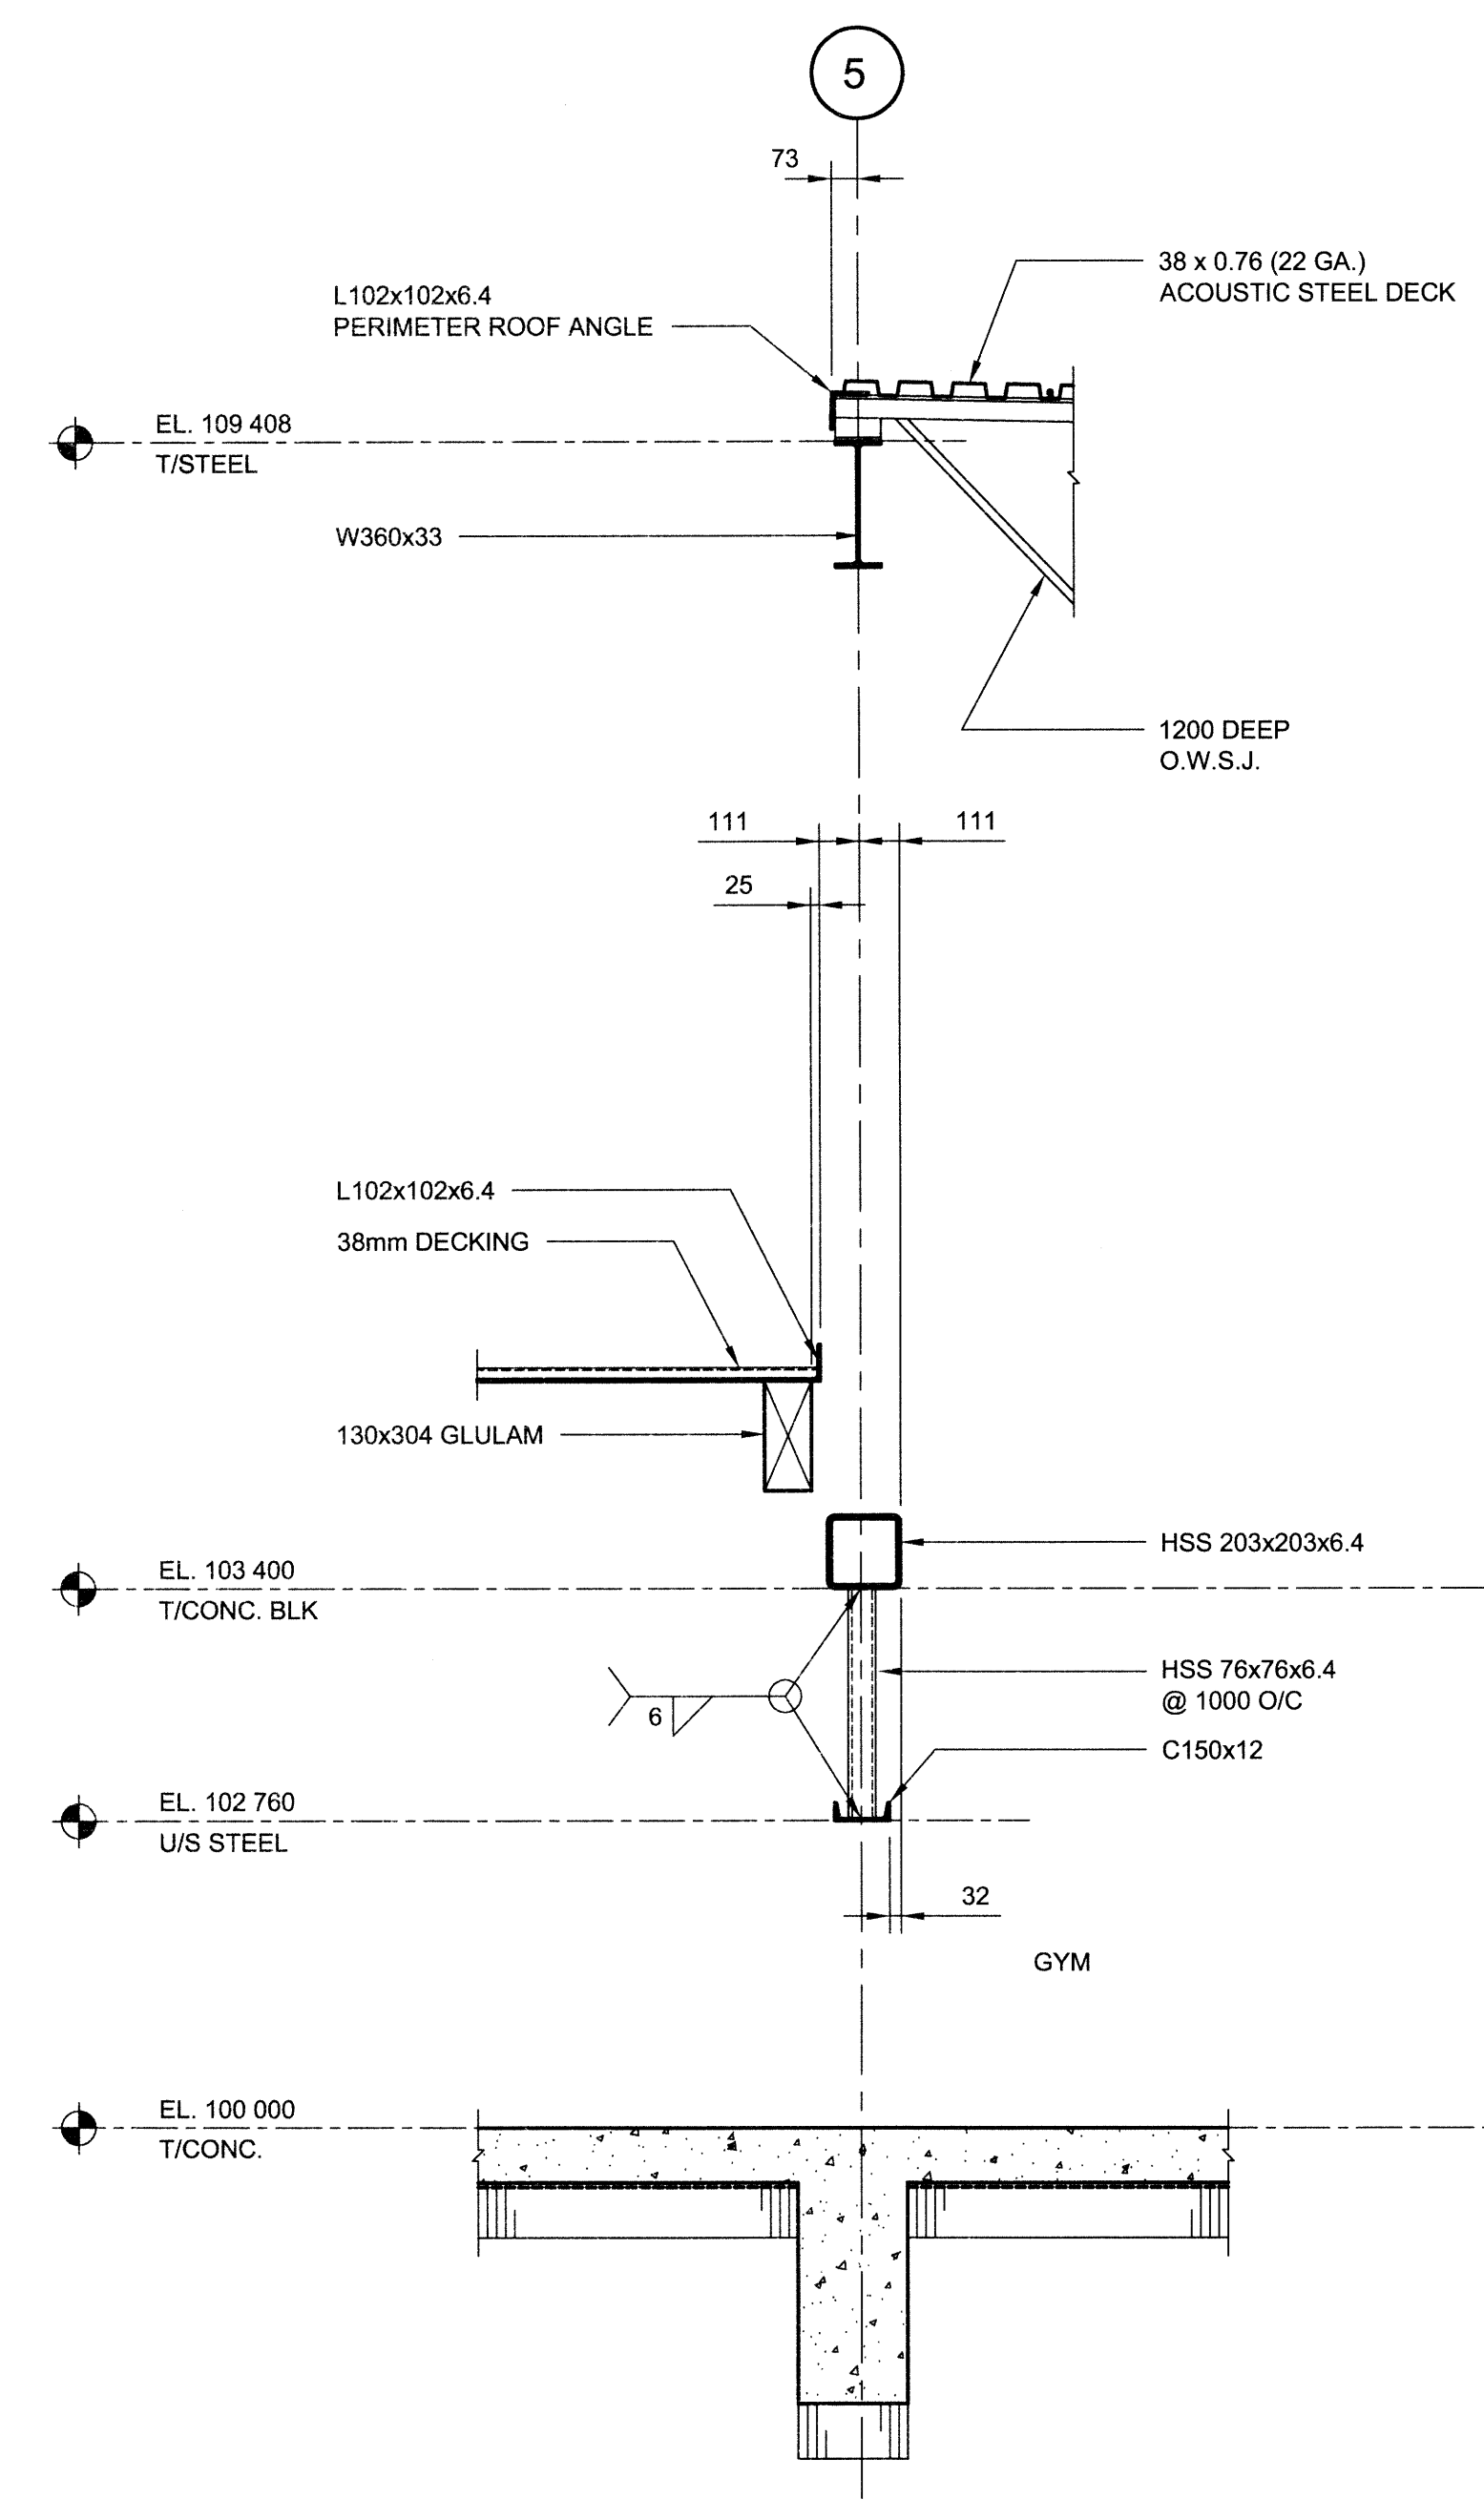

1 SECTION
1:20

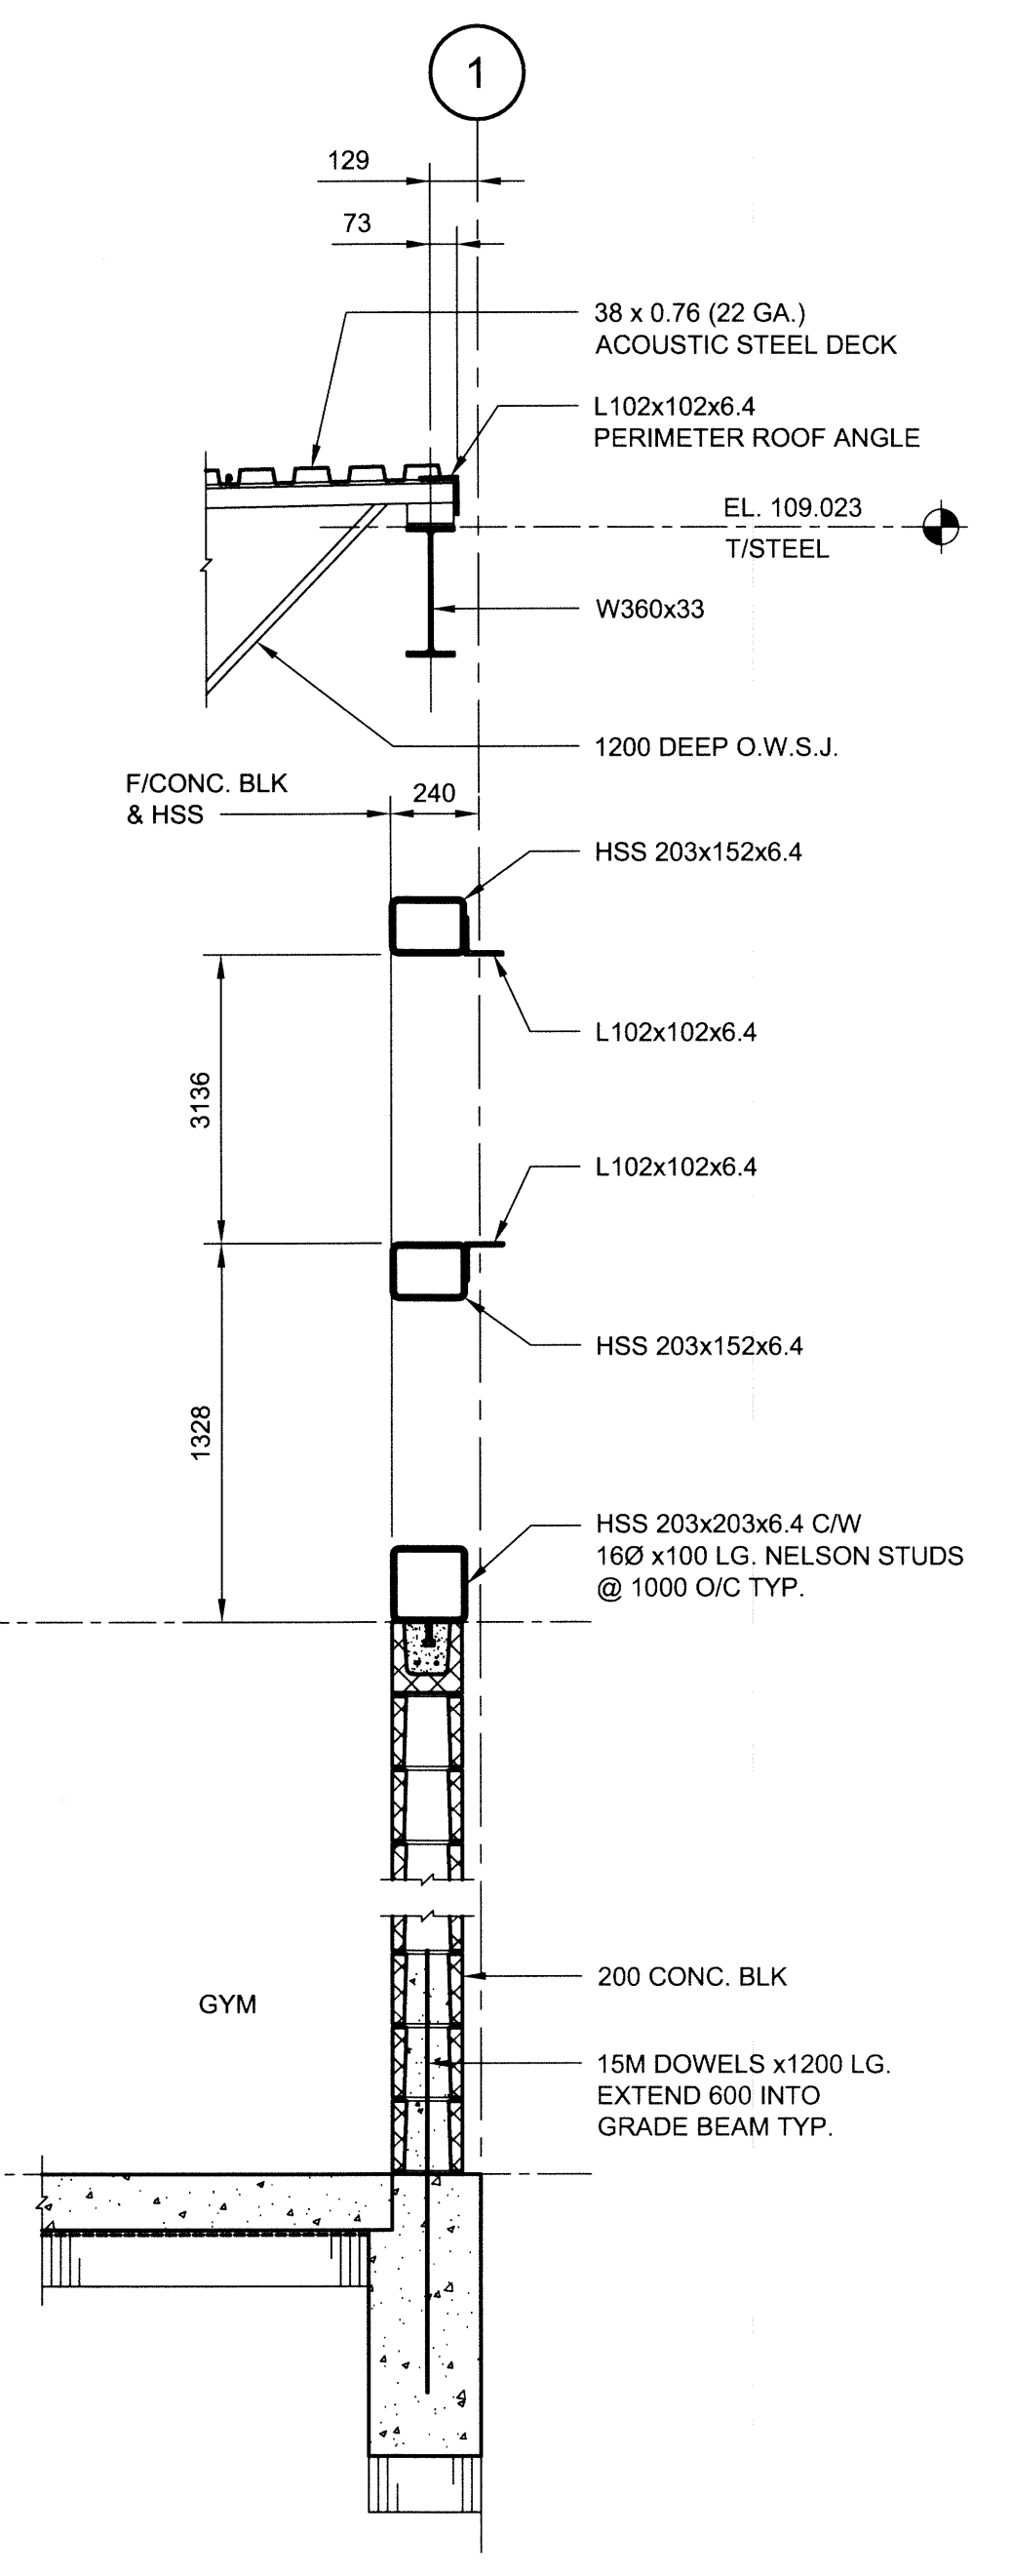

2 SECTION
1:20

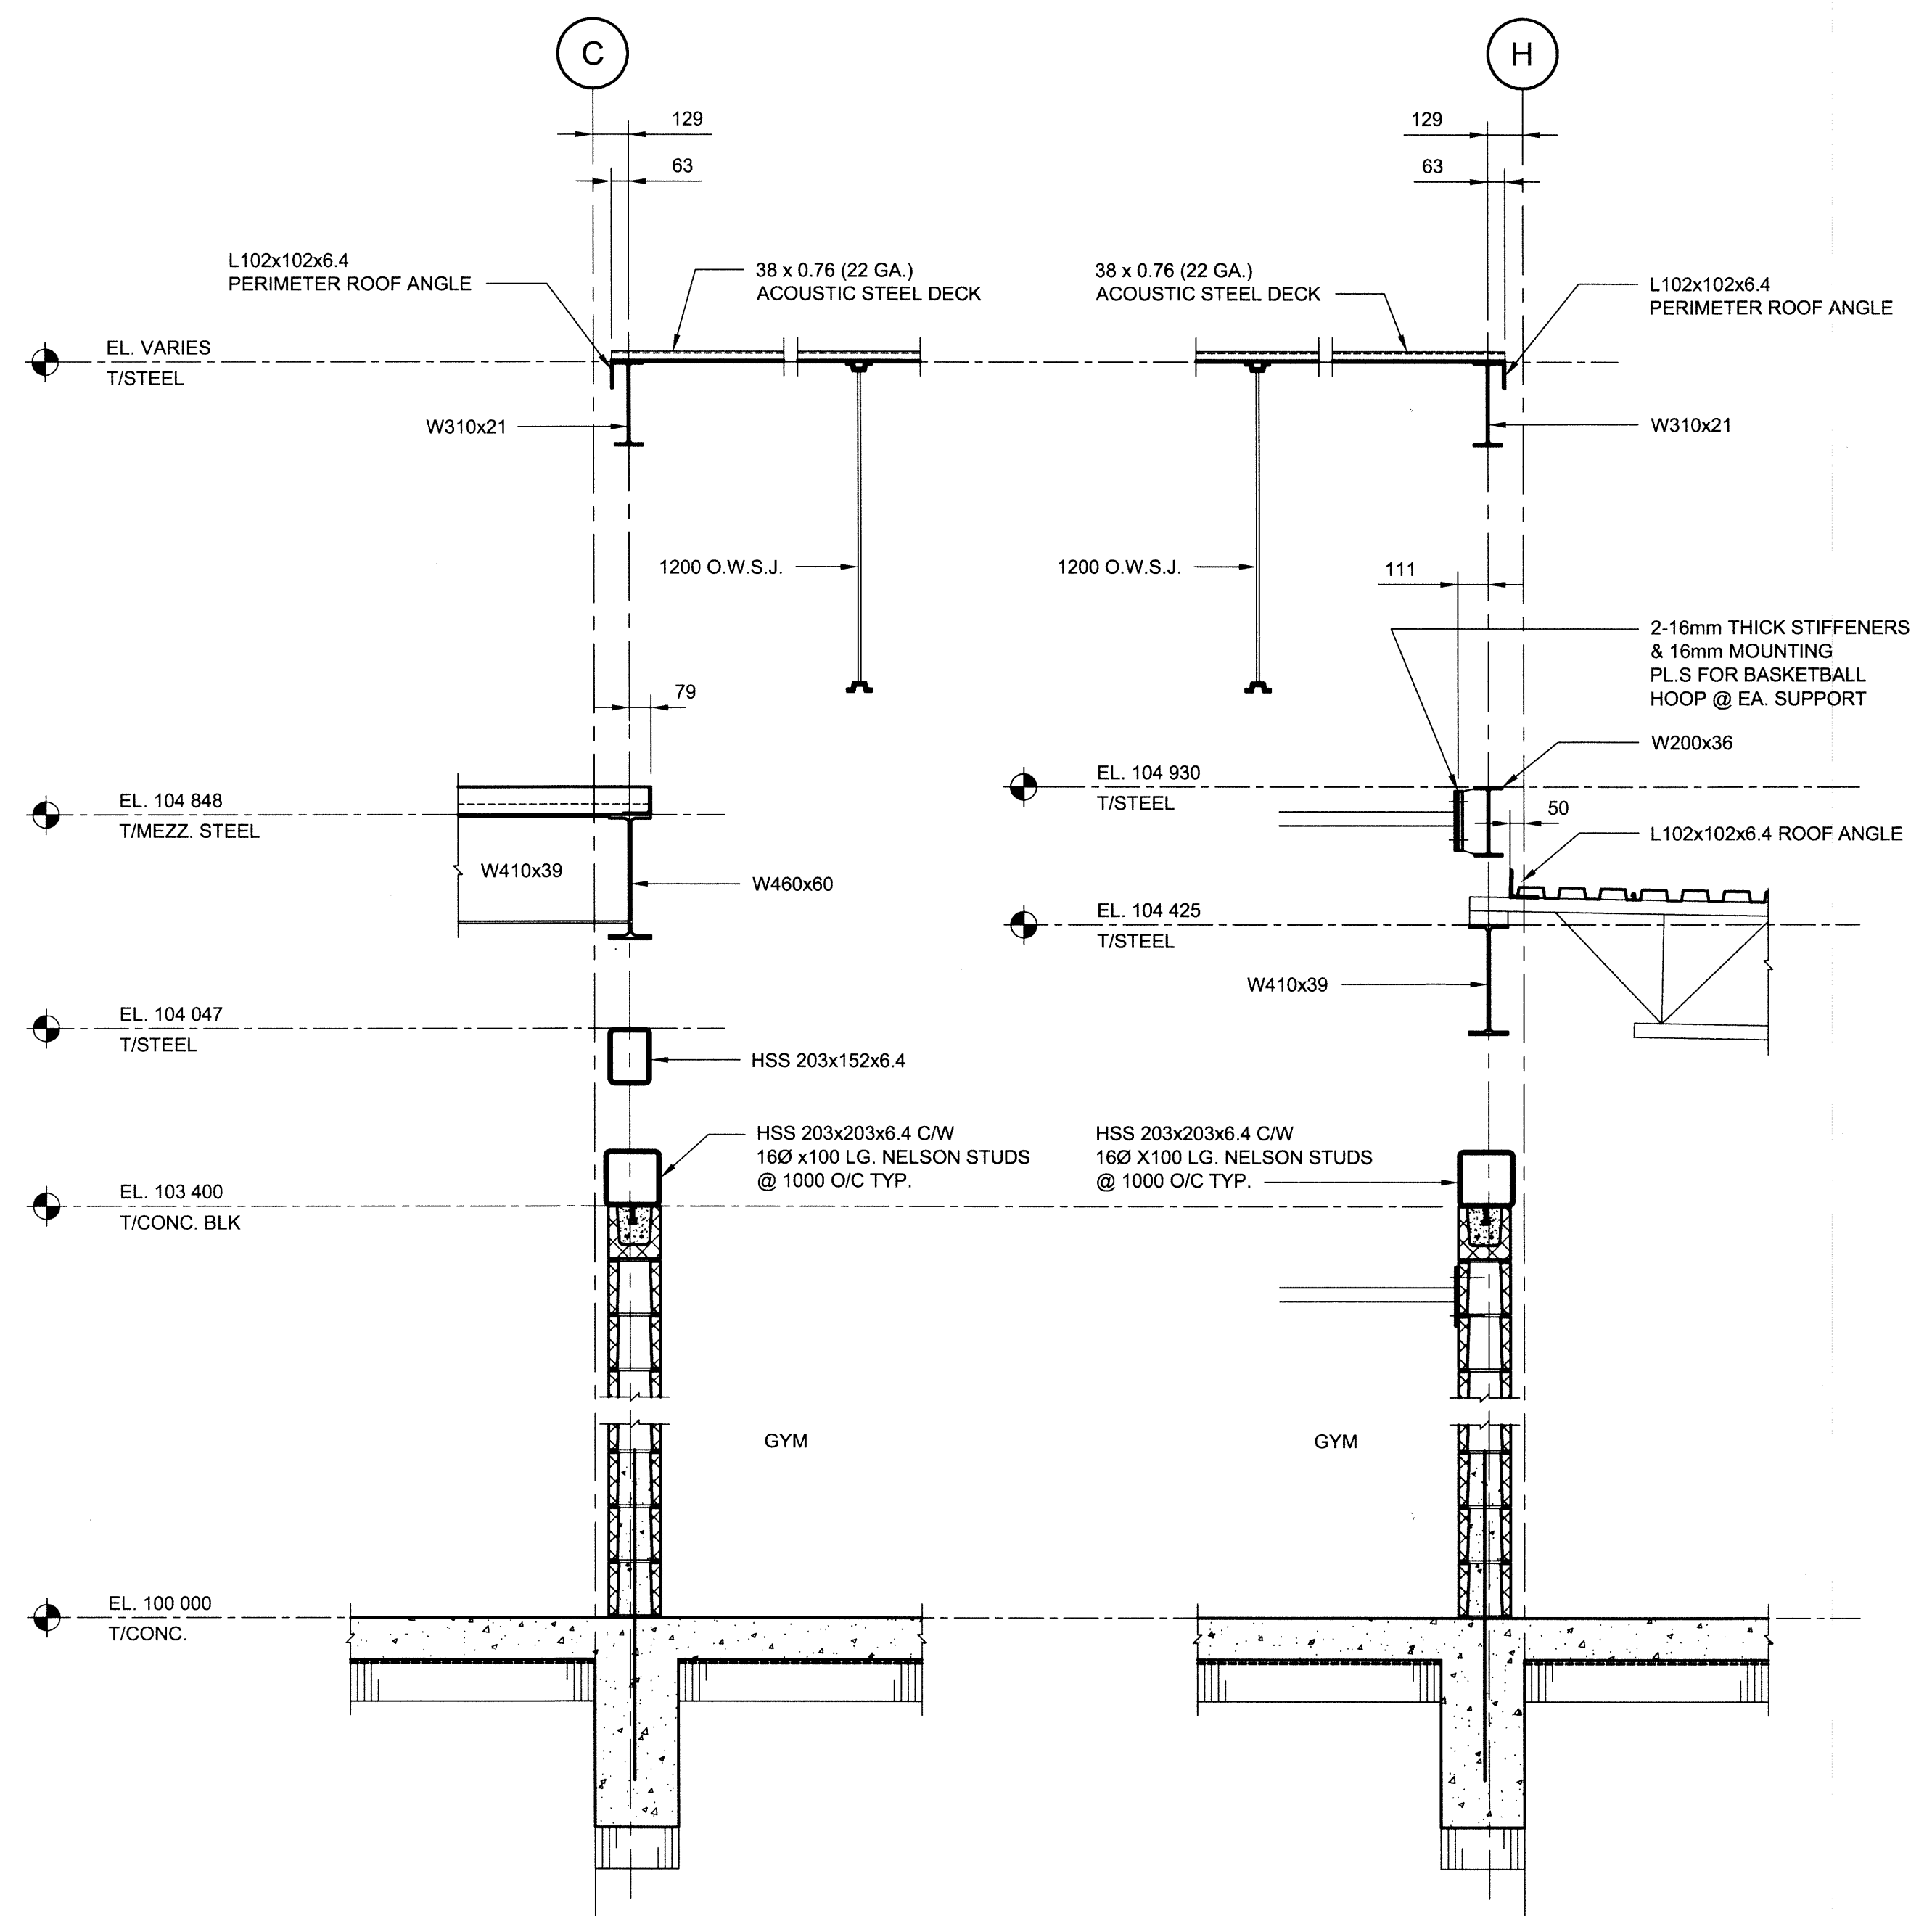

3 SECTION
1:20

4 SECTION
1:20

