



MAIN LEVEL - WEST END
1/16" = 1'-0"

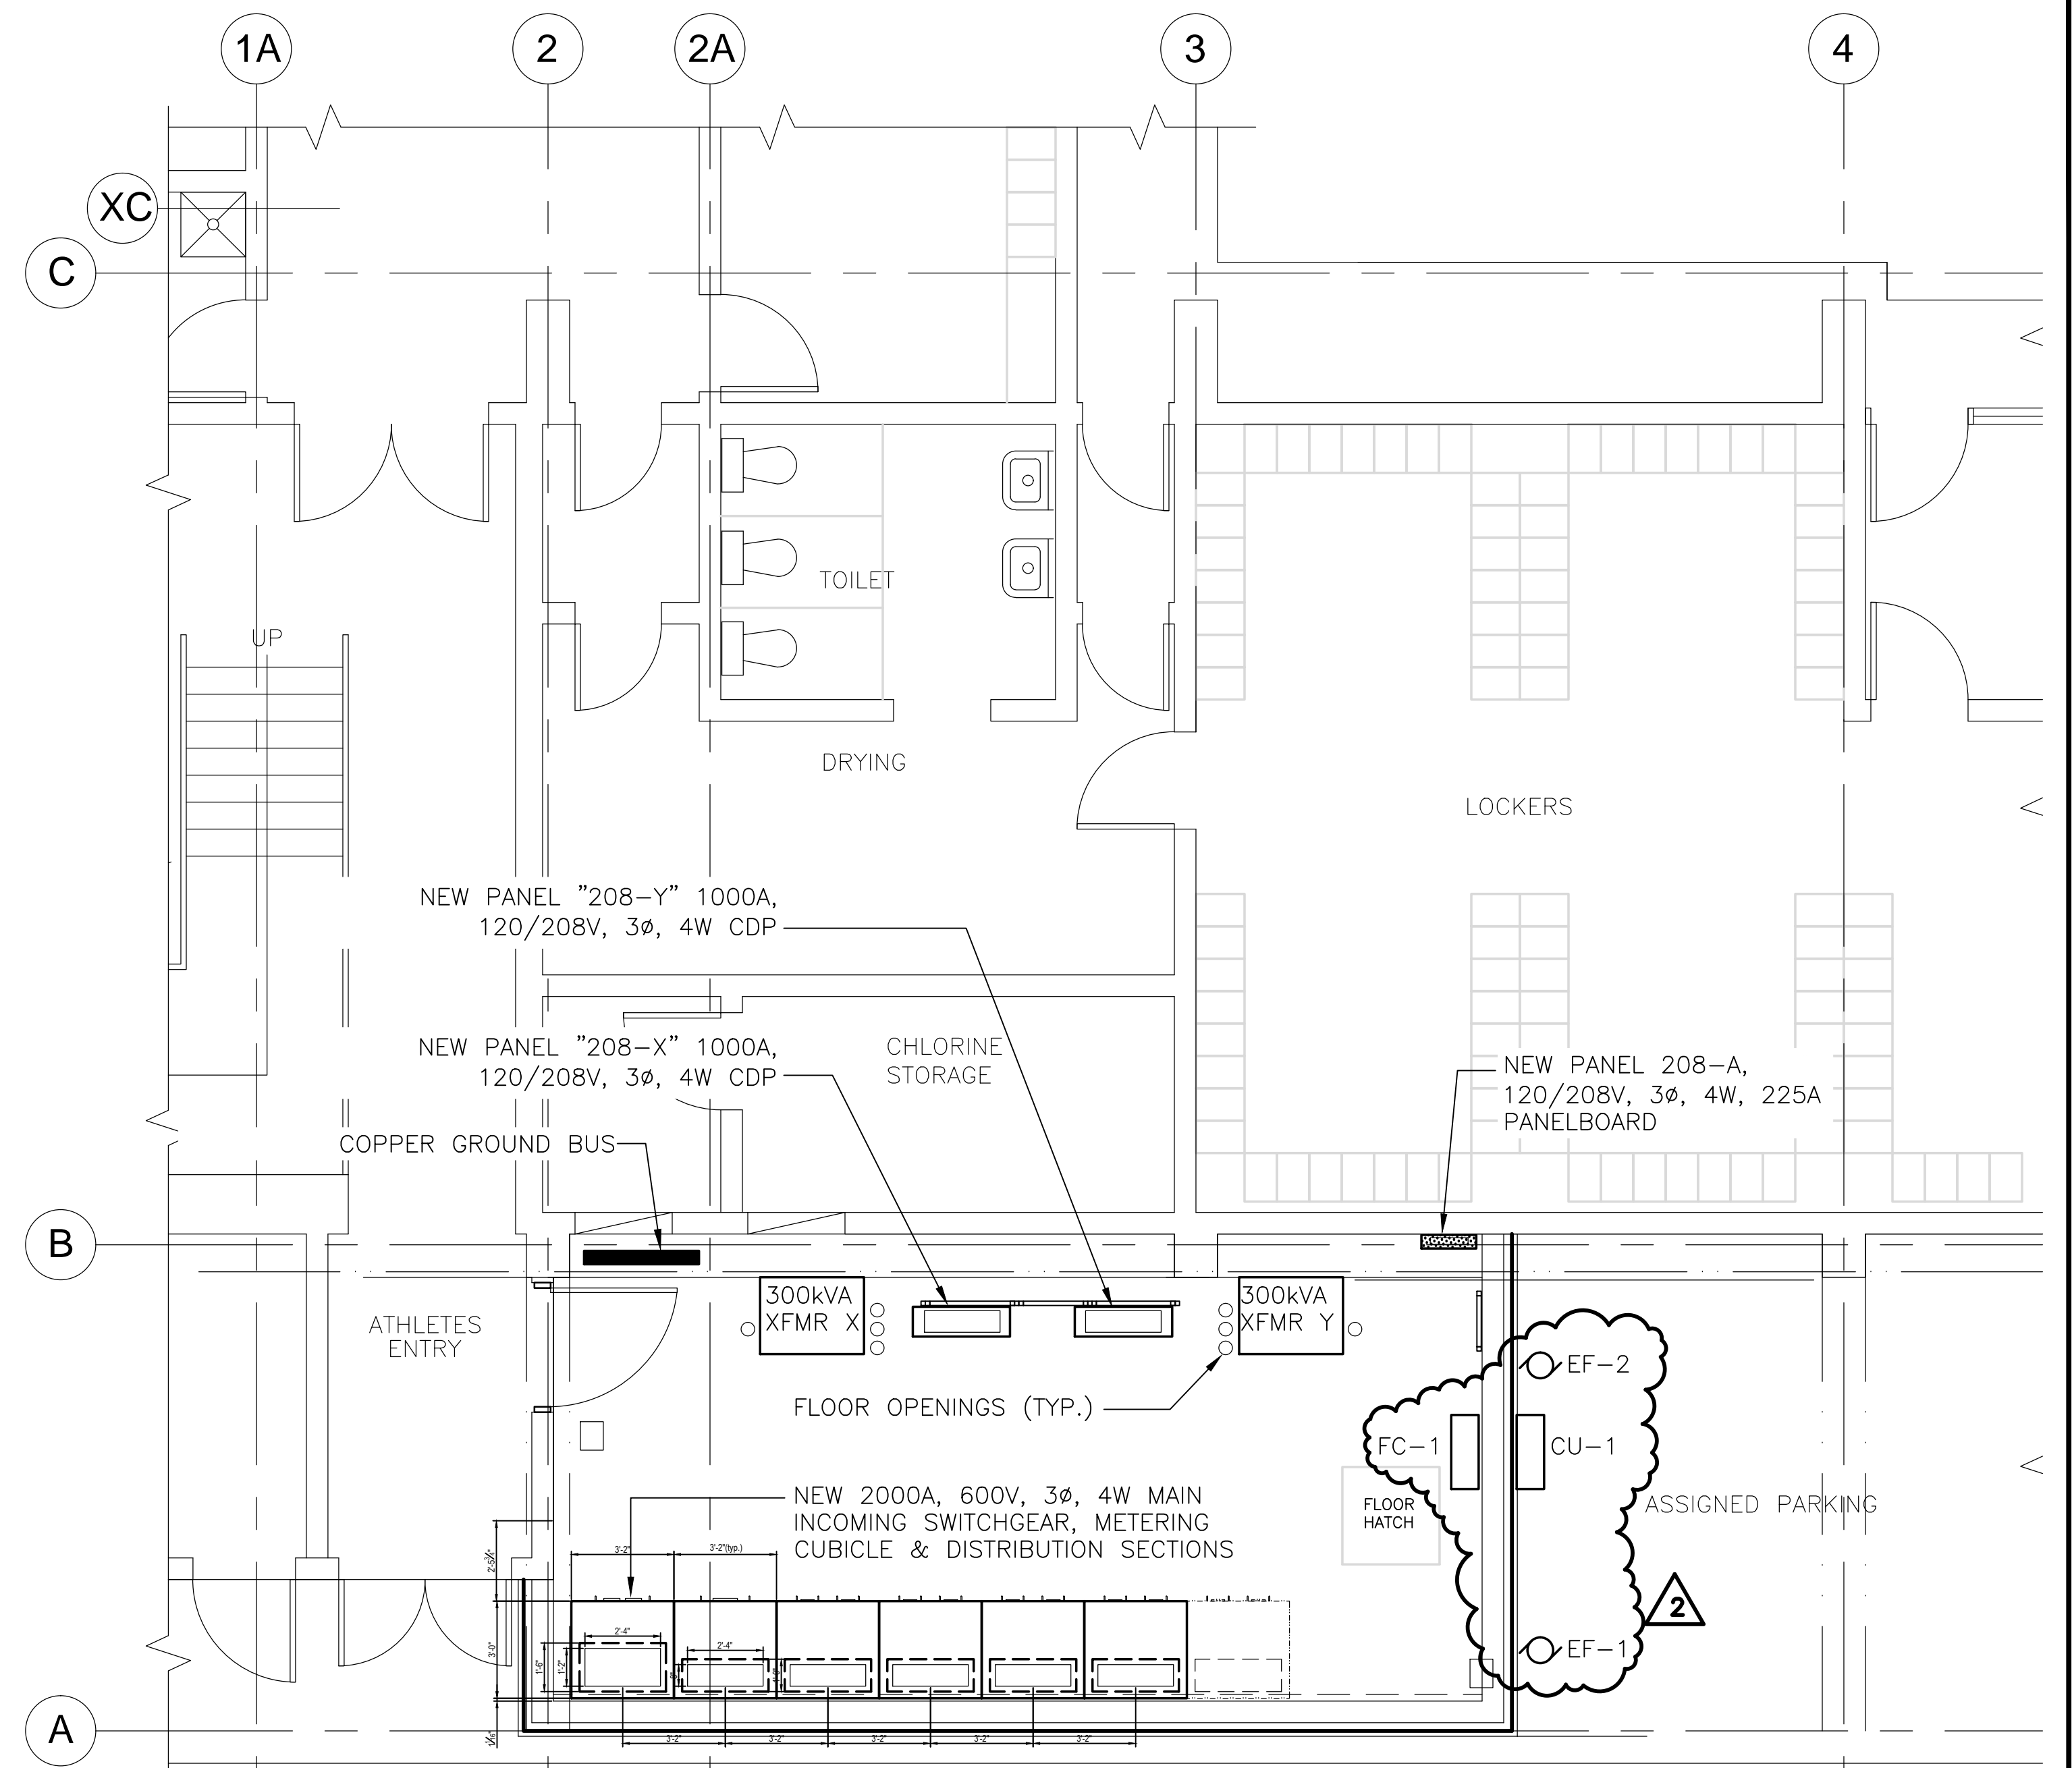

2 MAIN LEVEL AT ELECTRICAL ROOM
E203E203 1/4" = 1'-0"

- NOTES**
- 1) CONNECT GROUND BUS TO EXISTING BUILDING GROUND SYSTEM WITH TWO (2) #2/0 AWG BARE COPPER CONDUCTORS.
 - 2) THE EXISTING CONCRETE BASE SHALL BE UTILIZED FOR THE NEW CSTE. EXISTING CABLE RACEWAY BETWEEN TRANSFORMER AND CSTE SHALL BE USED FOR NEW CABLING. THE RACEWAY SHALL BE MODIFIED TO SUIT NEW EQUIPMENT.

Conditions of Use
Verify elevations and/or dimensions on drawing prior to use. Report any discrepancies to Dillon Consulting Limited.
Do not scale dimensions from drawing.
Do not modify drawing, re-use it, or use it for purposes other than those intended at the time of its preparation without prior written permission from Dillon Consulting Limited.

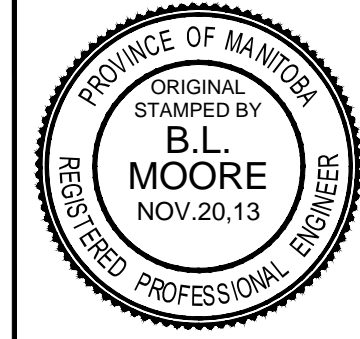

DESIGN	BLM	REVIEWED BY
DRAWN	SCK	CHECKED BY
DATE	APR 3, 2013	
SCALE	AS SHOWN	
2	ISSUED FOR ADDENDUM No 3	13-12-16 SCK
1	ISSUED FOR ADDENDUM No 1	13-12-10 SCK
0	ISSUED FOR BID OPPORTUNITY NUMBER 850-2013	13-11-20 SCK
No.	ISSUED FOR	DATE BY

PAN AM POOL ELECTRICAL UPGRADE		PROJECT NO. 137300
ELECTRICAL MAIN LEVEL - WEST & ELECTRICAL ROOM		SHEET NO. E204