

THE CITY OF WINNIPEG  
WATERWORKS, WASTE AND DISPOSAL DEPARTMENT

FILE No. \_\_\_\_\_

SUBJECT INSTALLATION OF 750  $\phi$  MODEL 10C DATE JAN 16 1985


ARMCO FLAP GATE IN OLIVE PUMPING STATION SHEETS No. S-424

COMPUTED BY GATE CHAMBER CHECKED BY TW

MADE IN CONNECTION WITH \_\_\_\_\_

METRIC


PLAN VIEW (n.t.s.)

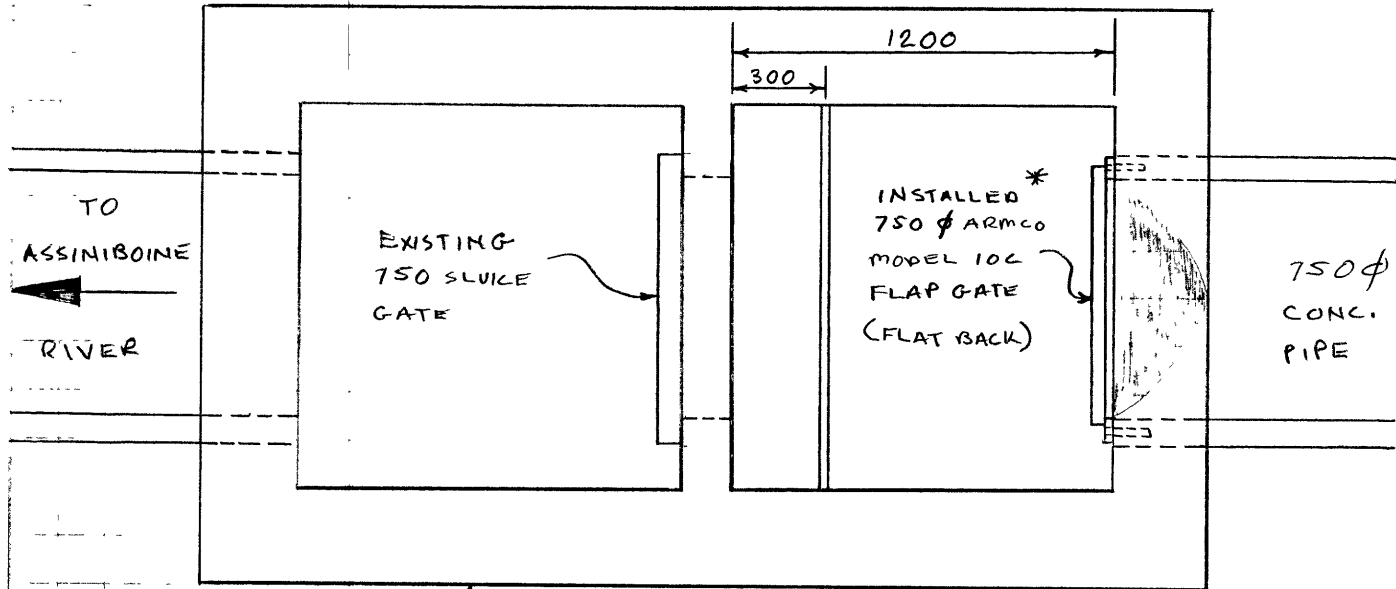

CONCRETE GATE CHAMBER

\* GATE INSTALLED BY WATERWORKS, WASTE AND DISPOSAL DEPARTMENT REGIONAL OPERATIONS PERSONNEL

PROFILE (n.t.s.)

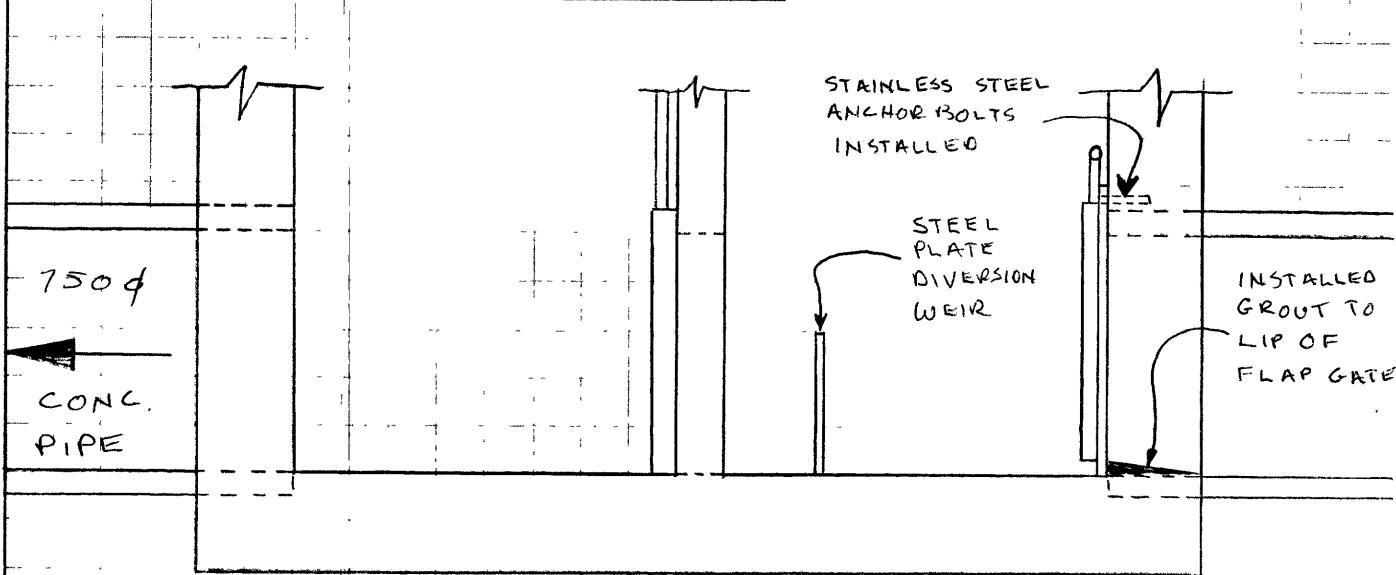

2.0 # MS 11952