DWG NORTH

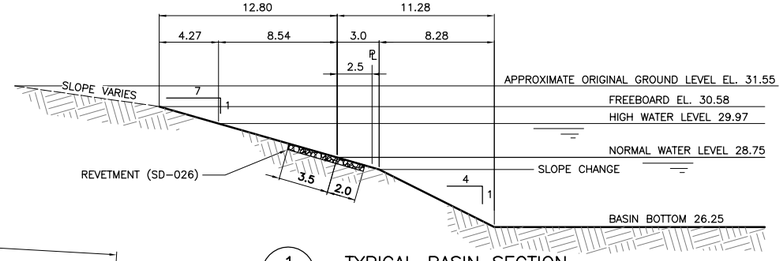


1 TYPICAL BASIN SECTION
HOR 1 : 200, VER 1 : 100

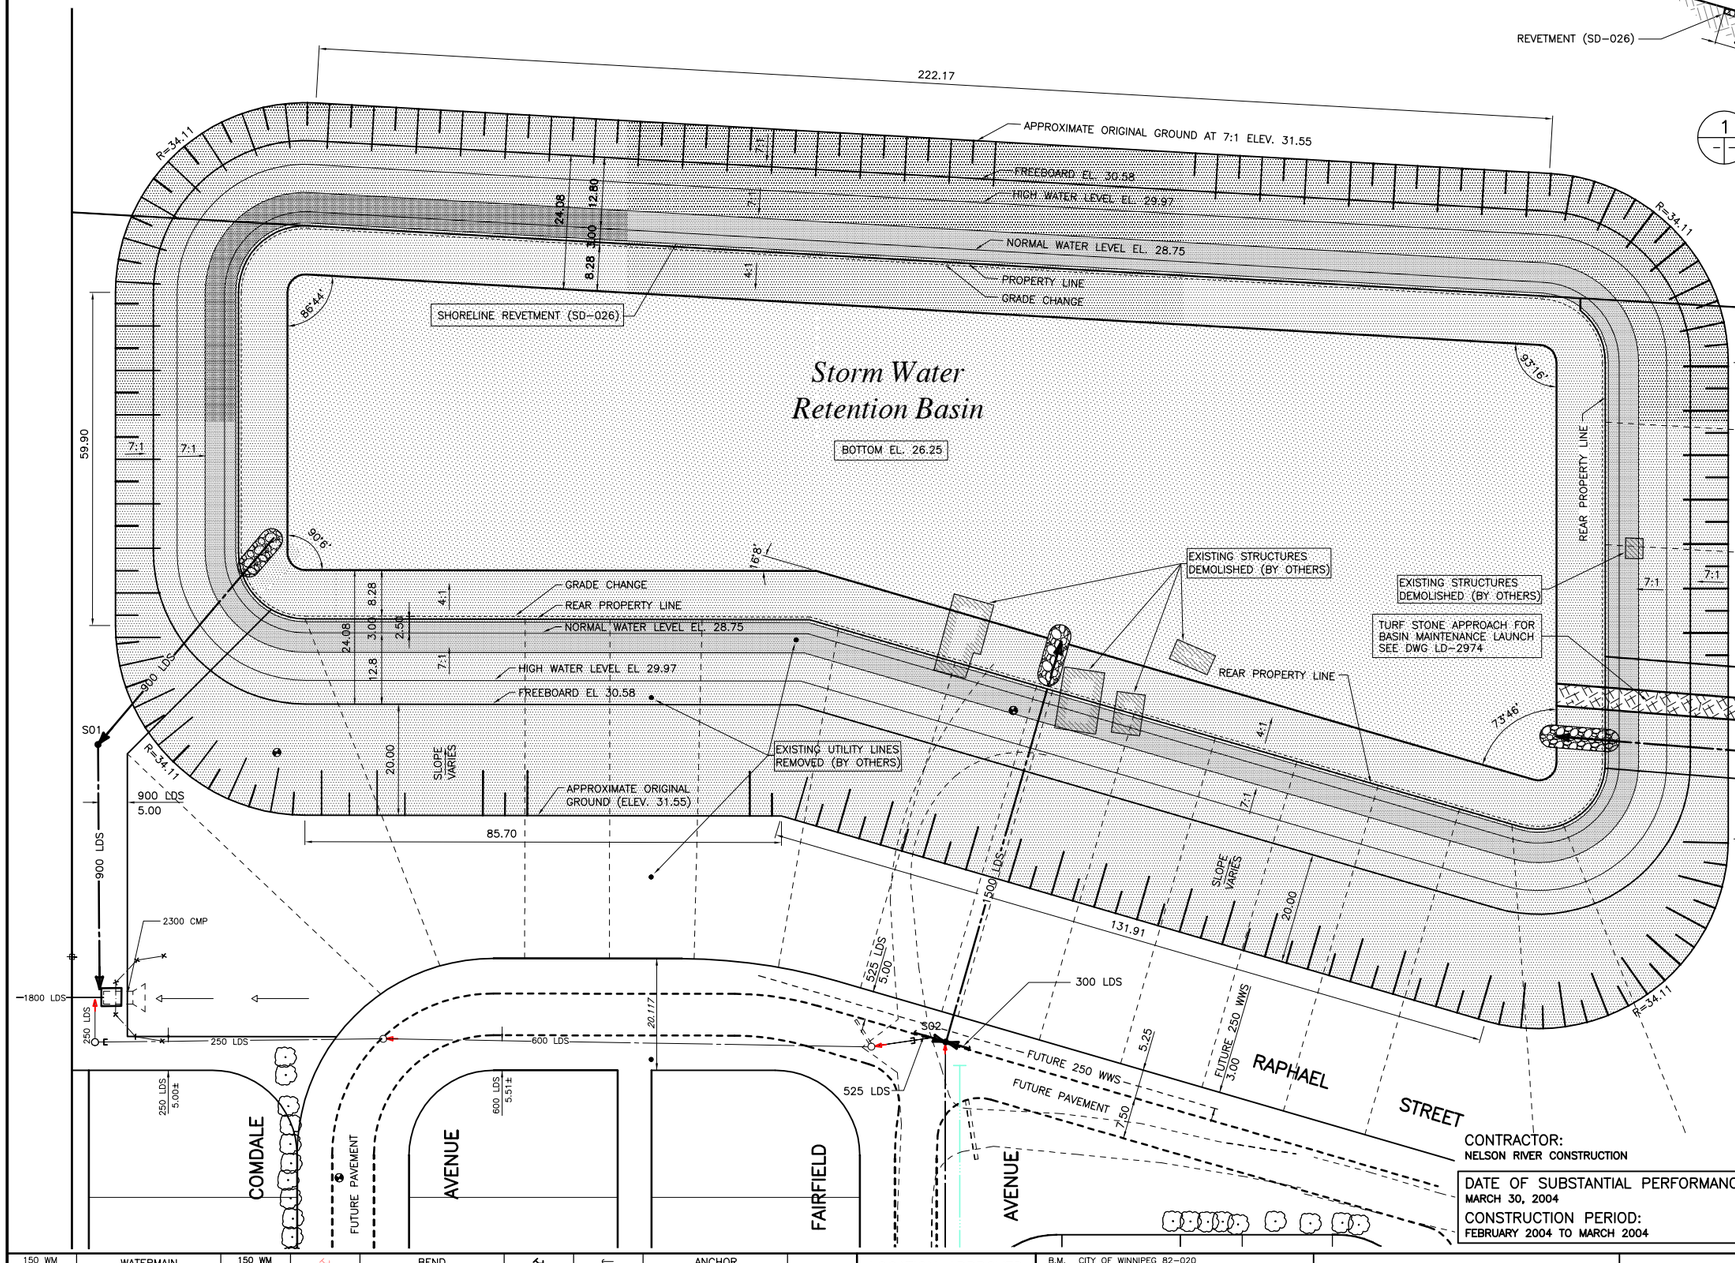


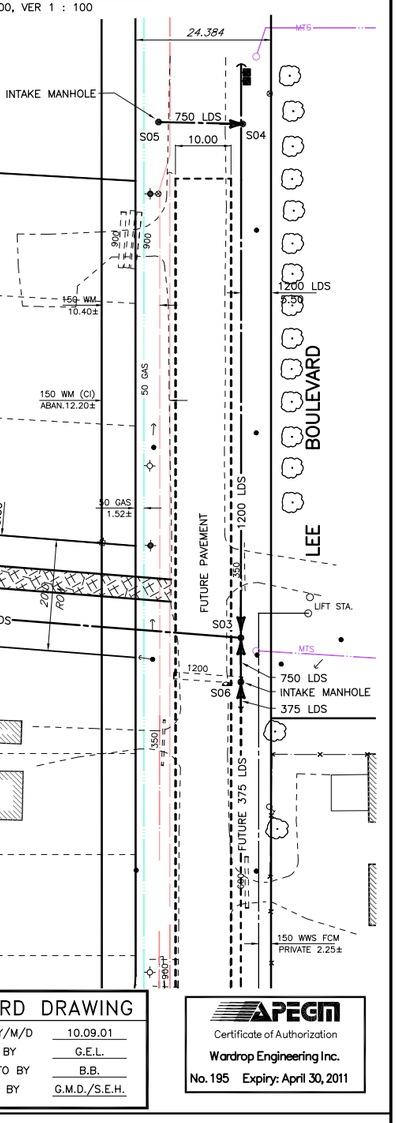


CONTRACTOR:
NELSON RIVER CONSTRUCTION

DATE OF SUBSTANTIAL PERFORMANCE:
MARCH 30, 2004

CONSTRUCTION PERIOD:
FEBRUARY 2004 TO MARCH 2004

RECORD DRAWING

| | |
|---|---|
| DATE Y/M/D | 10.09.01 |
| DRAFTED BY | G.E.L. |
| FIELD INFO BY | B.B. |
| CHECKED BY | G.M.D./S.E.H. |

APEGM
Certificate of Authorization
Wardrop Engineering Inc.
No. 195 Expiry: April 30, 2011

| | | | | | | | | |
|---|---|---|---|---|---|---|---|---|
| 150 WM | WATERMAIN | 150 WM | | BEND | | | ANCHOR | |
| 400 FM | FEEDERMAIN | 400 FM | | TEE | | | TREE | |
| 300 LDS | LAND DRAINAGE SEWER | 300 LDS | | CURB STOP | | 15.240 | LEGAL DIMENSION | |
| 250 WWS | WASTEWATER SEWER | 250 WWS | | PLUG | | | SURVEY BAR | |
| 300 CS | COMBINED SEWER | 300 CS | | MANHOLE | | | TRAFFIC SIGNAL | |
| 200 FCM | FORCEMAIN | 200 FCM | | CATCHBASIN | | | GAS | |
| | JUNCTIONS | | | CURB INLET | | | HYDRO | |
| | HYDRANT | | 66 | ADDRESS | | | MTS | |
| | VALVE | | | HYDRO POLE | | | SIDEWALK | |
| | REDUCER | | | LIGHT STANDARD | | | CURB | |
| EXISTING | LEGEND-PLAN | PROPOSED | EXISTING | LEGEND-PLAN | PROPOSED | EXISTING | LEGEND-PLAN | PROPOSED |

LOCATION APPROVED
UNDERGROUND STRUCTURES

SUPV. U/G STRUCTURES COMMITTEE — DATE

NOTE:
LOCATION OF UNDERGROUND STRUCTURES AS SHOWN ARE BASED ON THE BEST INFORMATION AVAILABLE, BUT NO GUARANTEE IS GIVEN THAT ALL EXISTING UTILITIES ARE SHOWN OR THAT THE GIVEN LOCATIONS ARE EXACT. CONFIRMATION OF EXISTENCE AND EXACT LOCATION OF ALL SERVICES MUST BE OBTAINED FROM THE INDIVIDUAL UTILITIES BEFORE PROCEEDING WITH CONSTRUCTION.

B.M. CITY OF WINNIPEG 82-020
ELEV. 232.892m

| NO. | REVISIONS | DATE | BY |
|---|---|---|---|
| 2 | REVISED TO RECORD DRAWING | 10.09.01 | GWC |
| 1 | ISSUED FOR CONSTRUCTION | 04.01.26 | SH |
| 0 | ISSUED FOR TENDER | 03.12.09 | SH |
| - | ISSUED FOR APPROVAL | 03.12.09 | SH |

WARDROP | Engineering Inc.

| | | | |
|---|---|---|---|
| DESIGNED BY | SEH | CHECKED BY | |
| DRAWN BY | GMD | APPROVED BY | |
| HOR. SCALE: | 1 : 500 | RELEASED FOR CONSTRUCTION | |
| VERTICAL: | | | |
| DATE | 03.11.17 | DATE | |

ORIGINAL DRAWING REVISION "01" SEALED BY S.E. HARNISH P. ENG 2004.01.26

CONSULTANT DRAWING NO.
0312940900-DWG-C0001-02

Winnipeg
THE CITY OF WINNIPEG
PLANNING, PROPERTY & DEVELOPMENT DEPARTMENT

FAIRFIELD PARK LOCAL IMPROVEMENT DISTRICT
STORMWATER RETENTION BASIN EXCAVATION, OUTFALLS & ASSOCIATED WORKS

STORMWATER RETENTION BASIN
SITE PLAN (LAKE 6-29)

CITY DRAWING NUMBER
LD-2974

SHEET 1 OF 7

C0001