




**1**  
TYPICAL WEST SLOPE LEACHATE COLLECTION SYSTEM CLEANOUT  
1:20

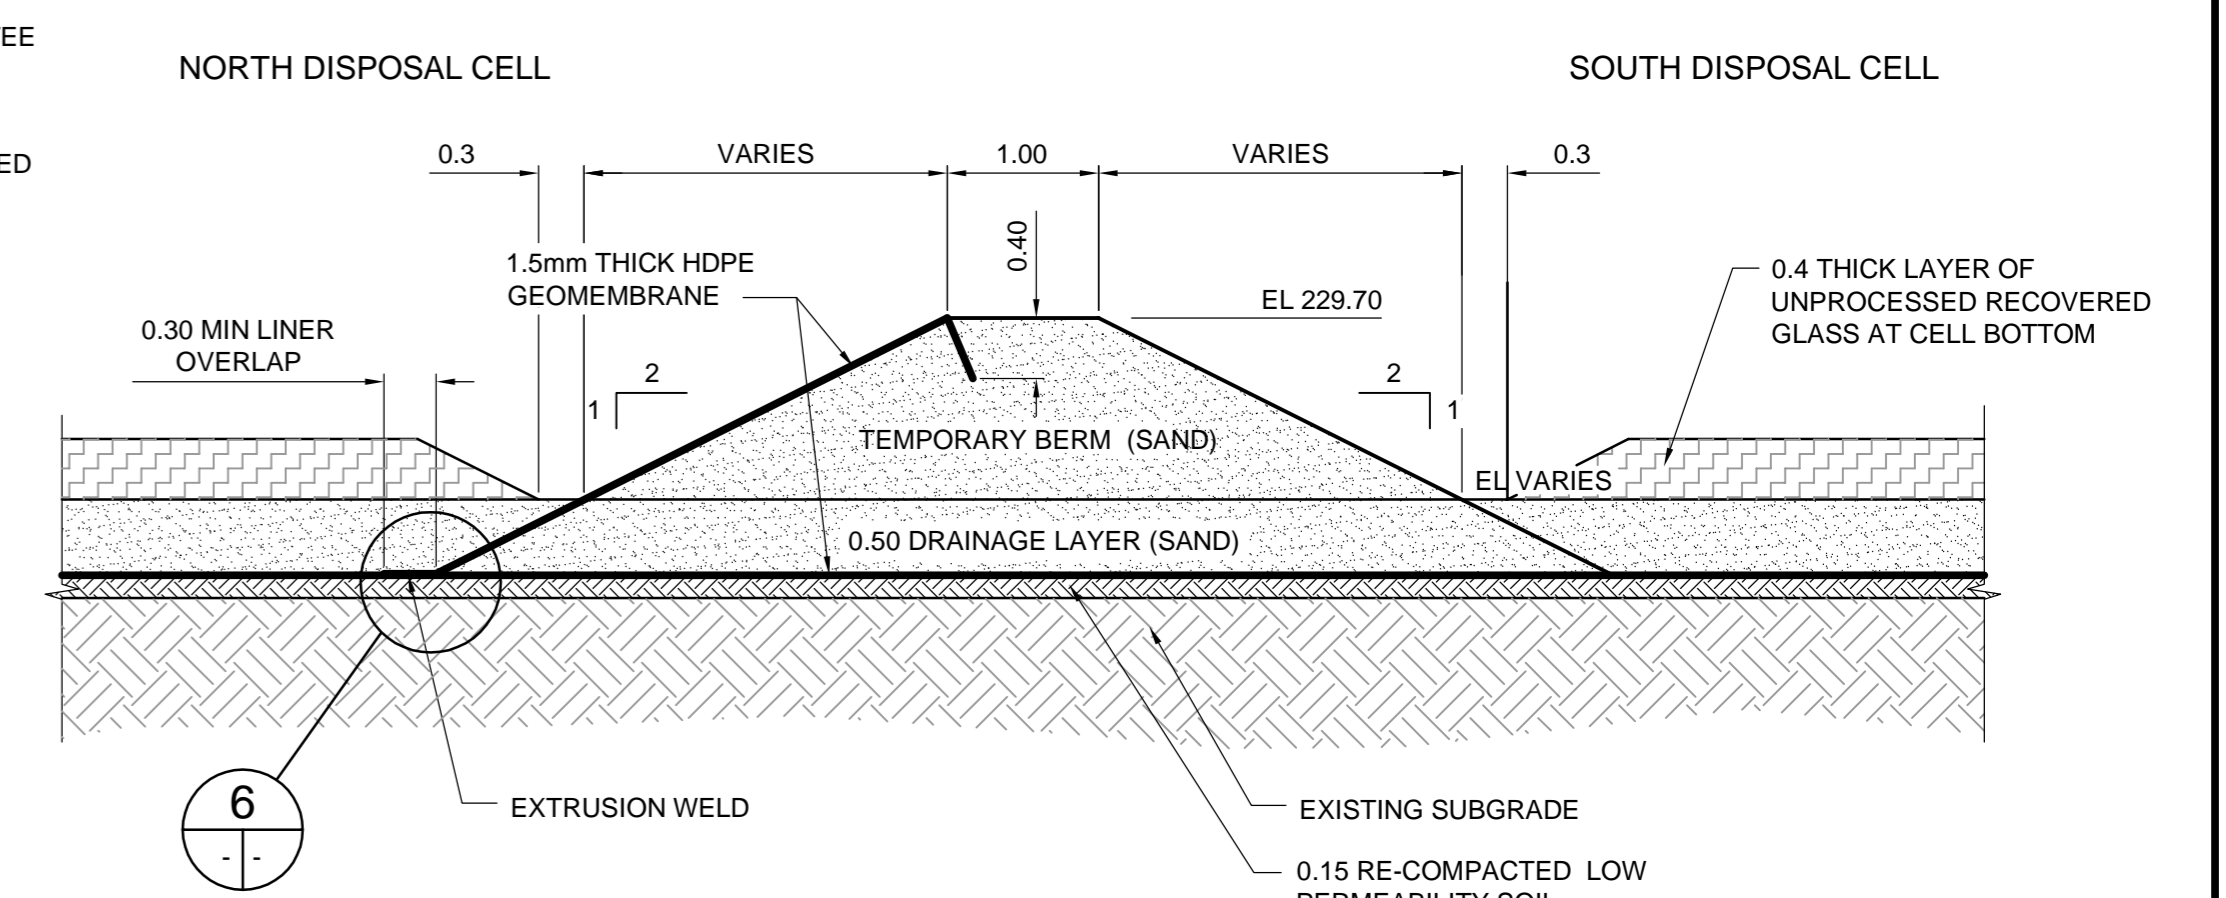


**2**  
TEMPORARY SEPARATION BERM SECTION  
1:50

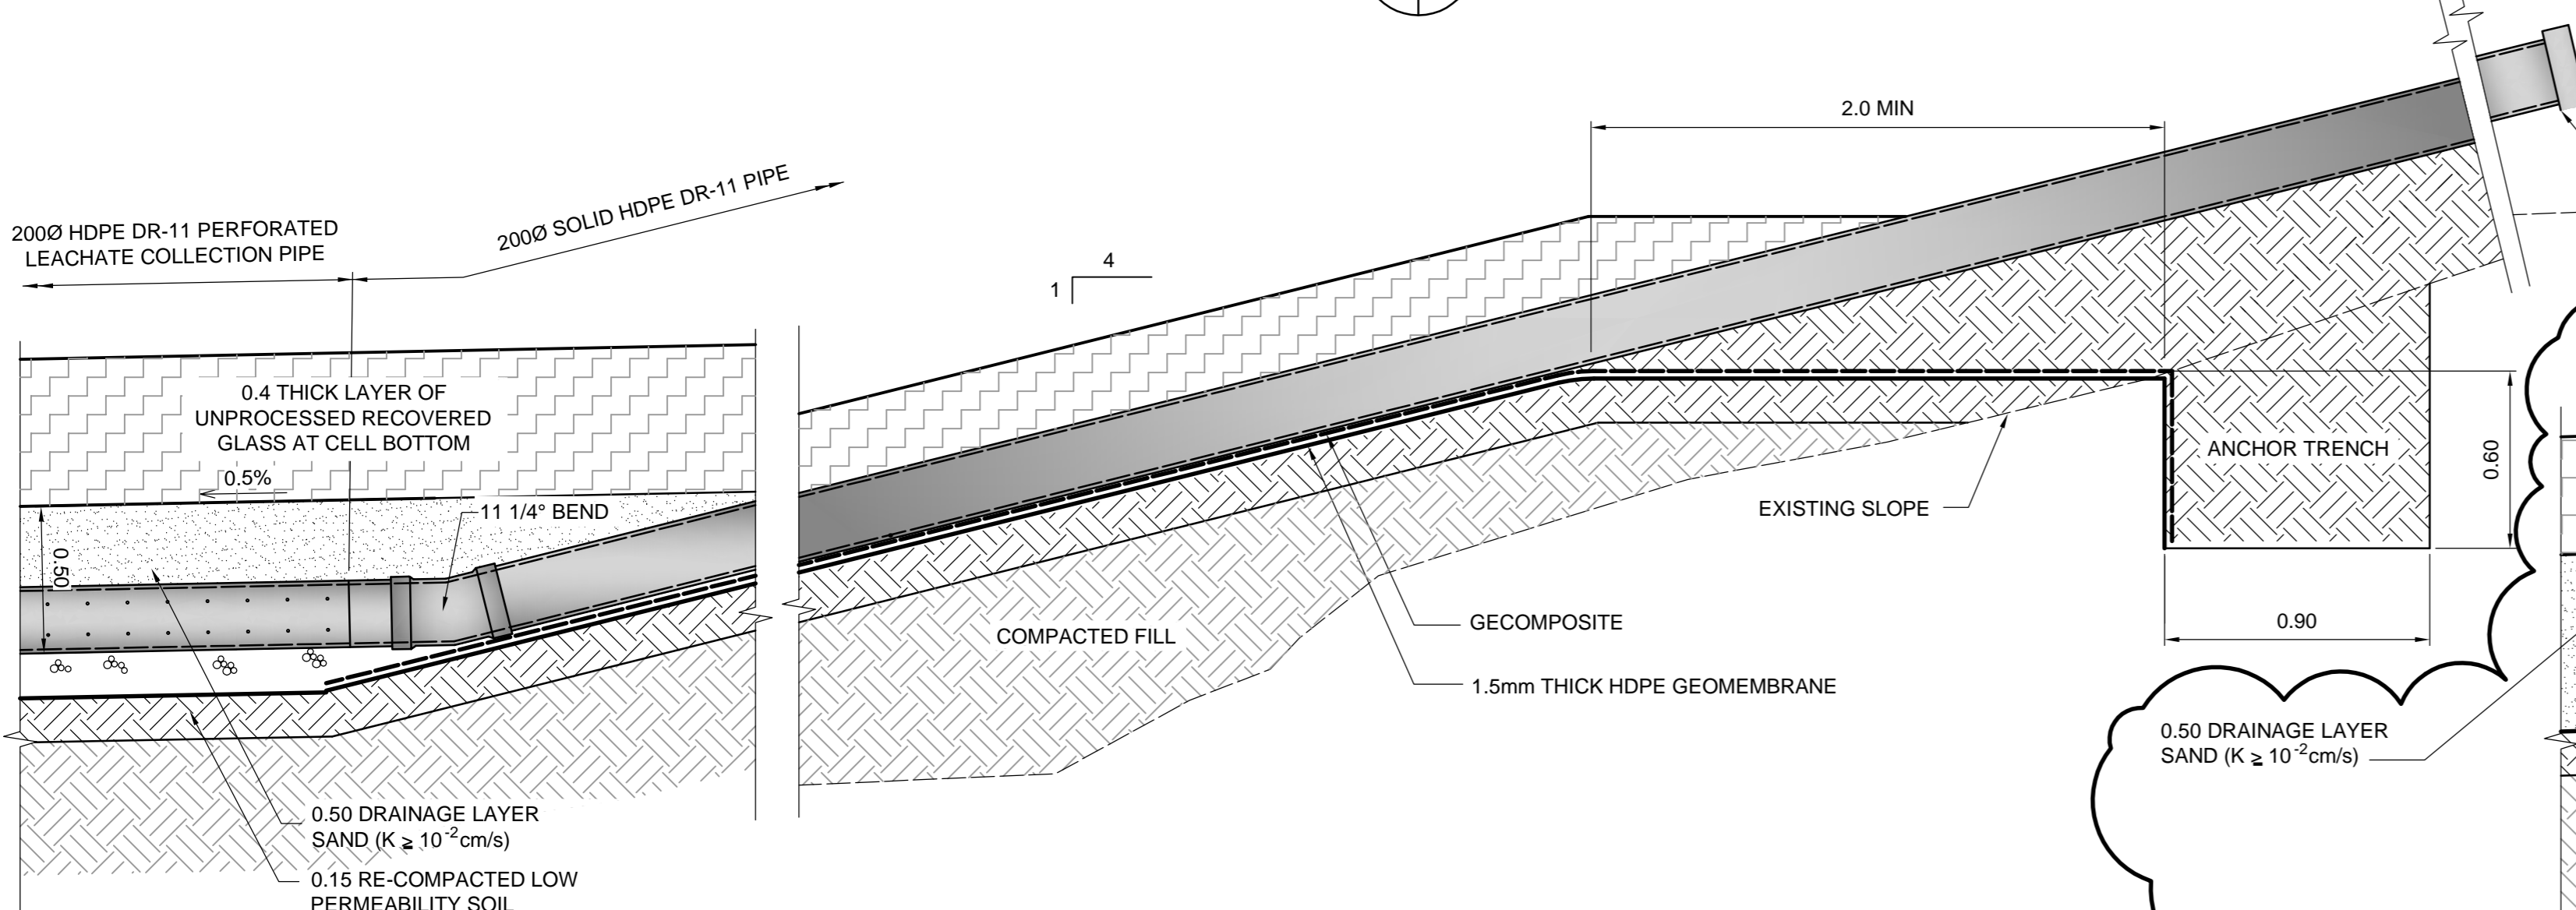


**3**  
TYPICAL EAST SLOPE LEACHATE COLLECTION SYSTEM CLEAN-OUT  
1:20

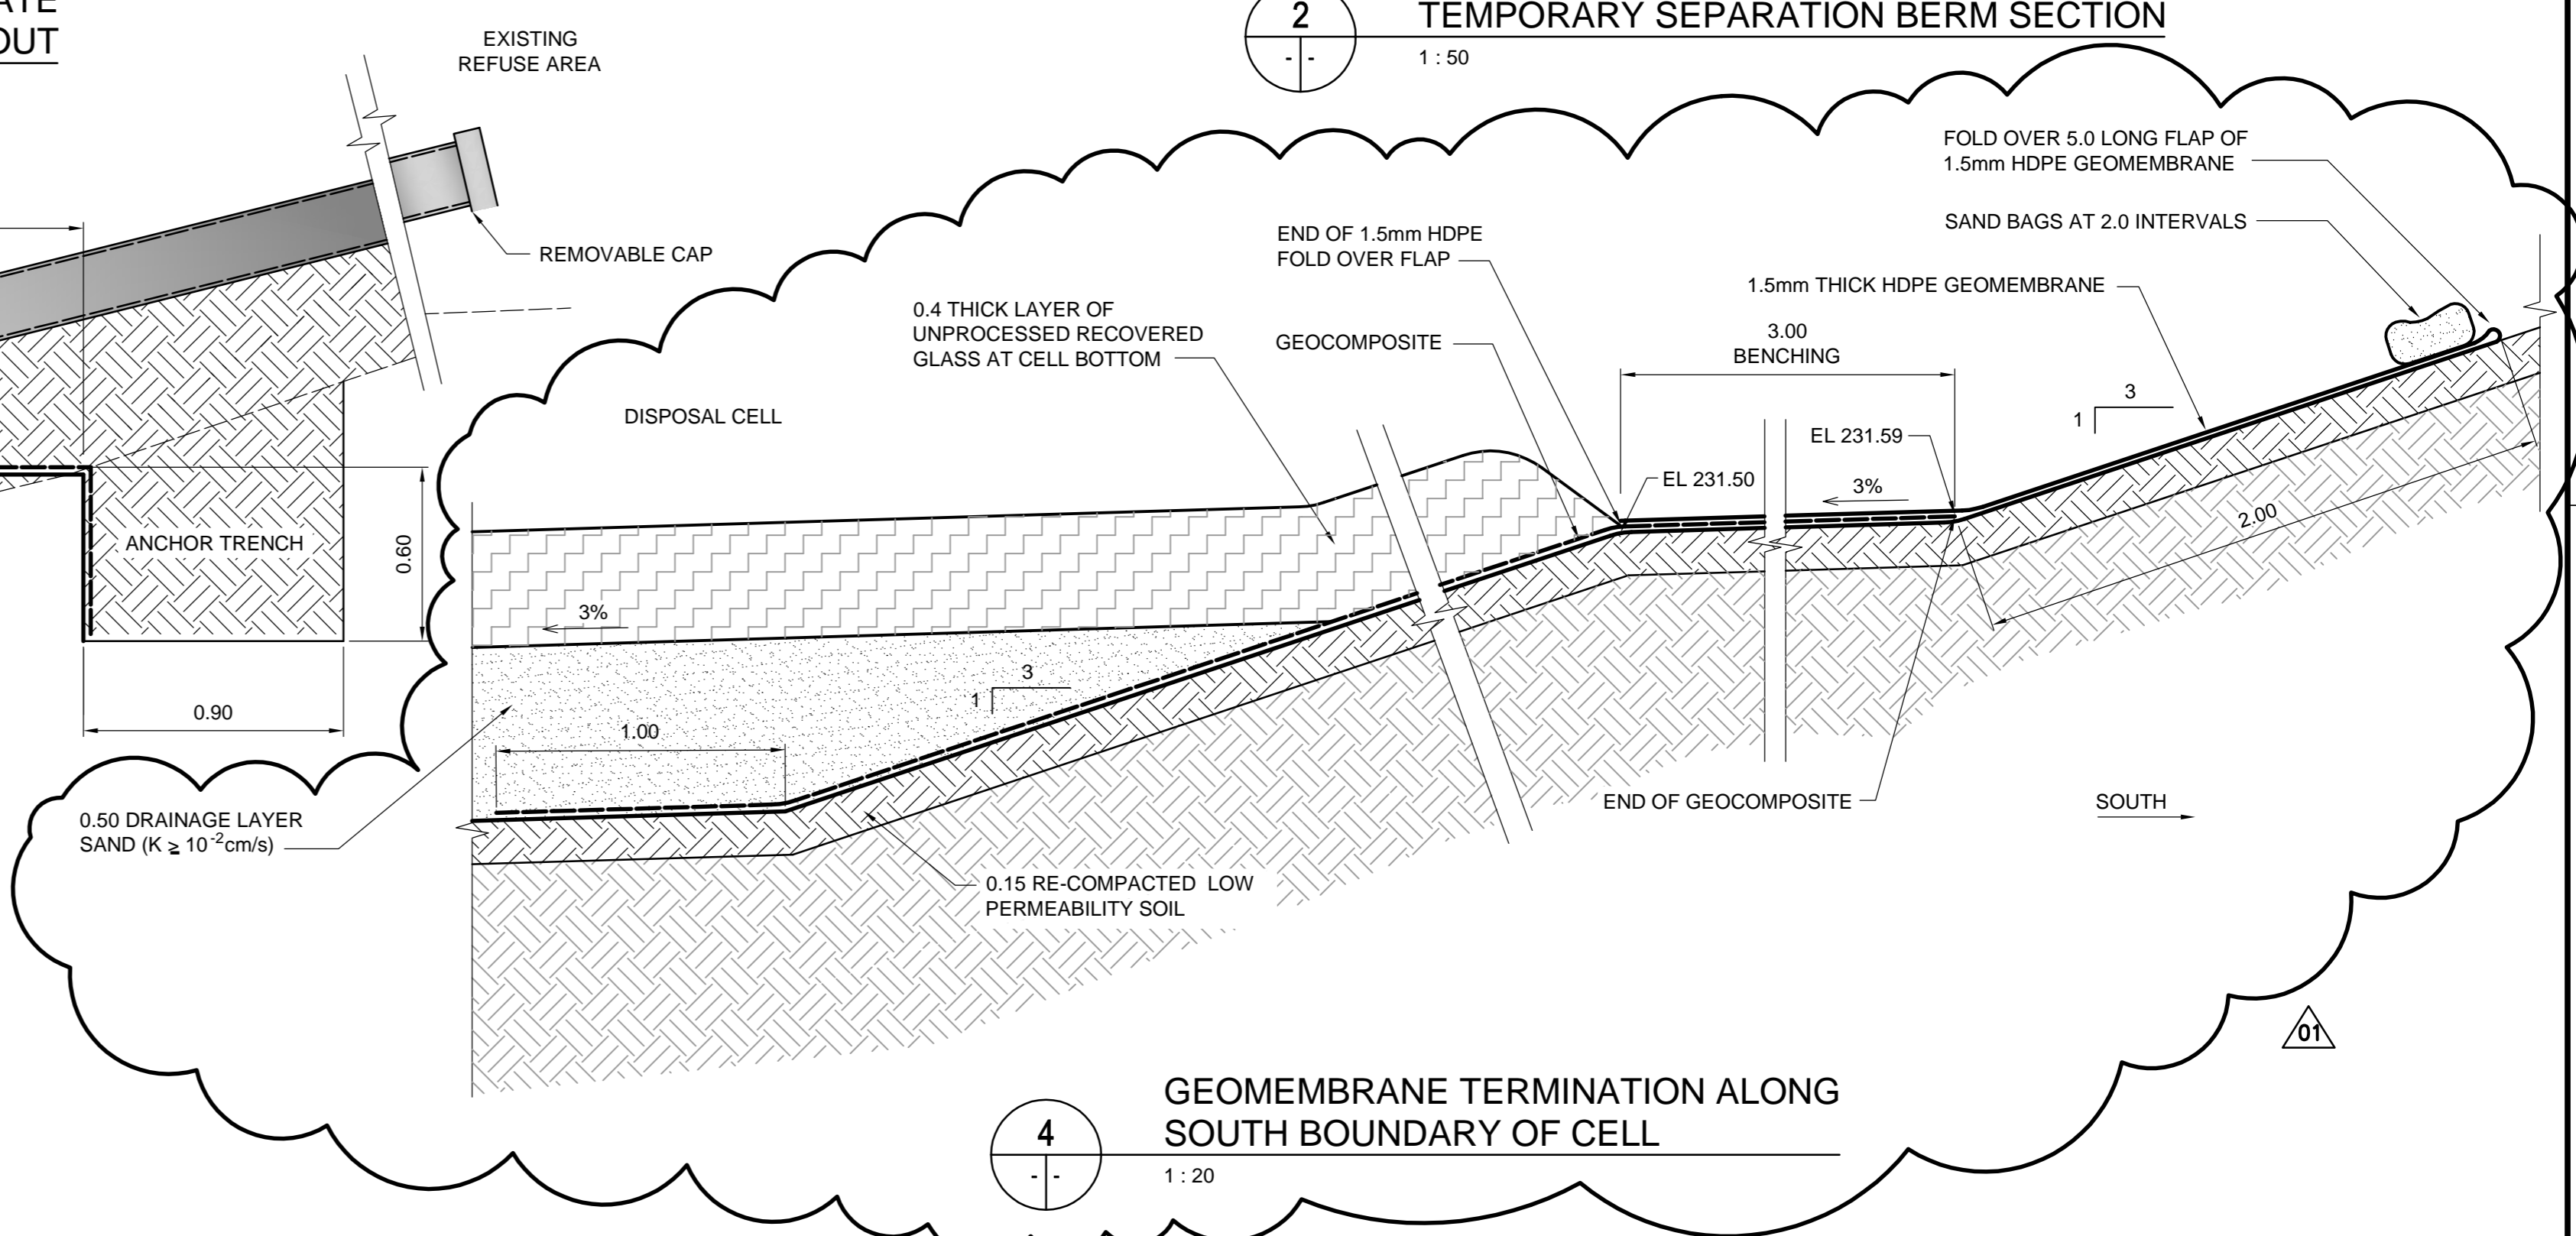


**4**  
GEOMEMBRANE TERMINATION ALONG SOUTH BOUNDARY OF CELL  
1:20

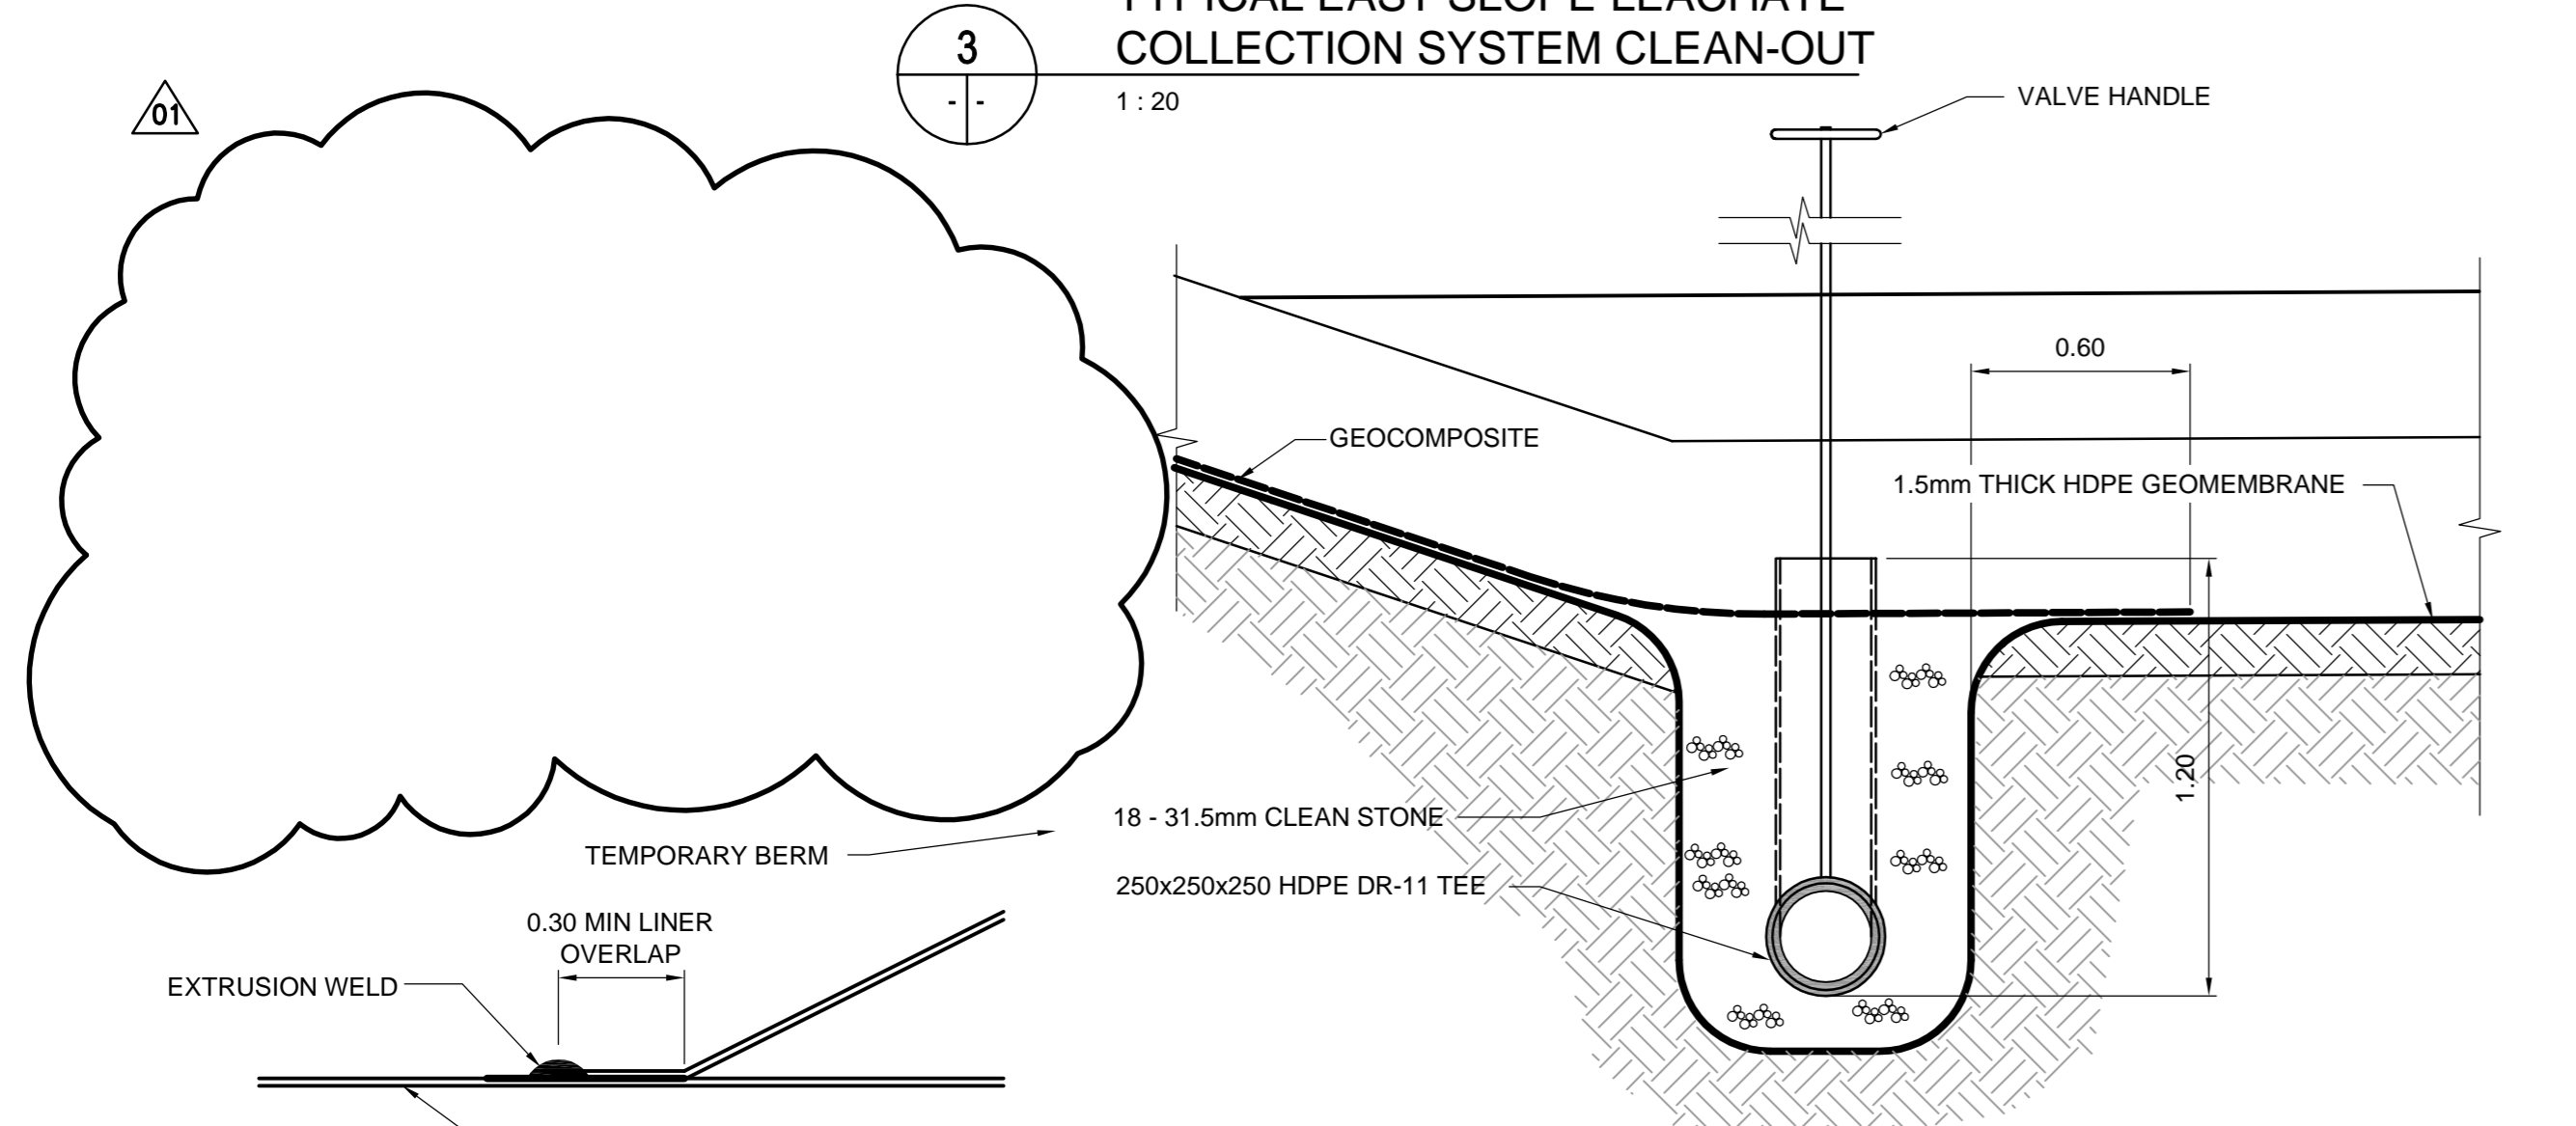

**7**  
VALVE EXTENSION DETAIL  
1:20

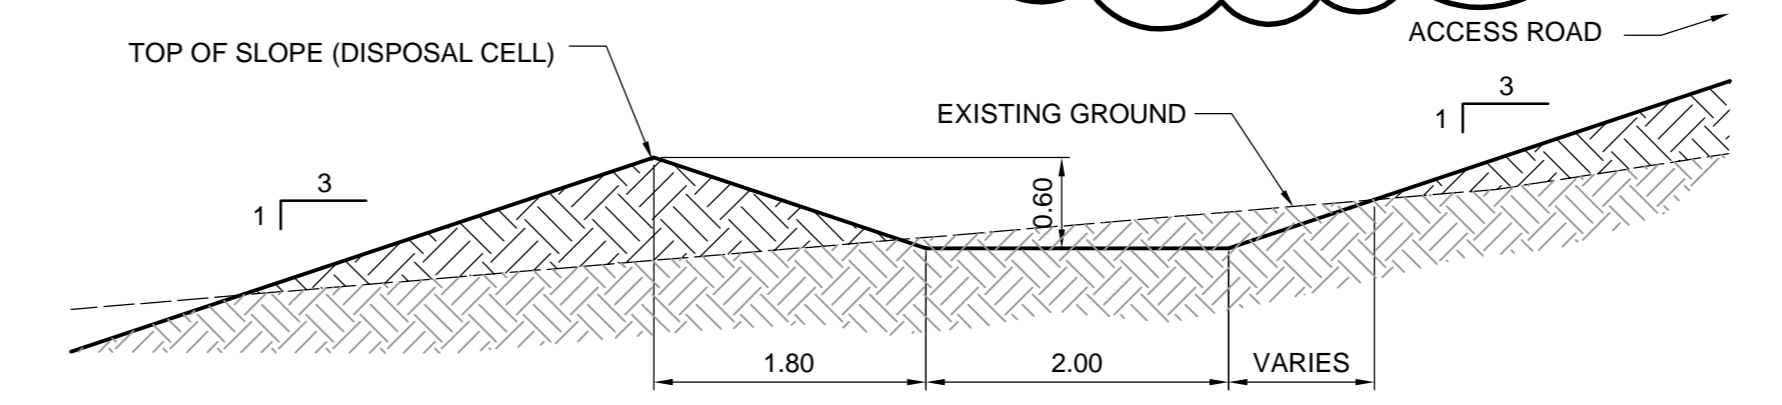

**8**  
DRAINAGE DIVERSION CHANNEL (TYPICAL NORTH SECTION)  
1:50

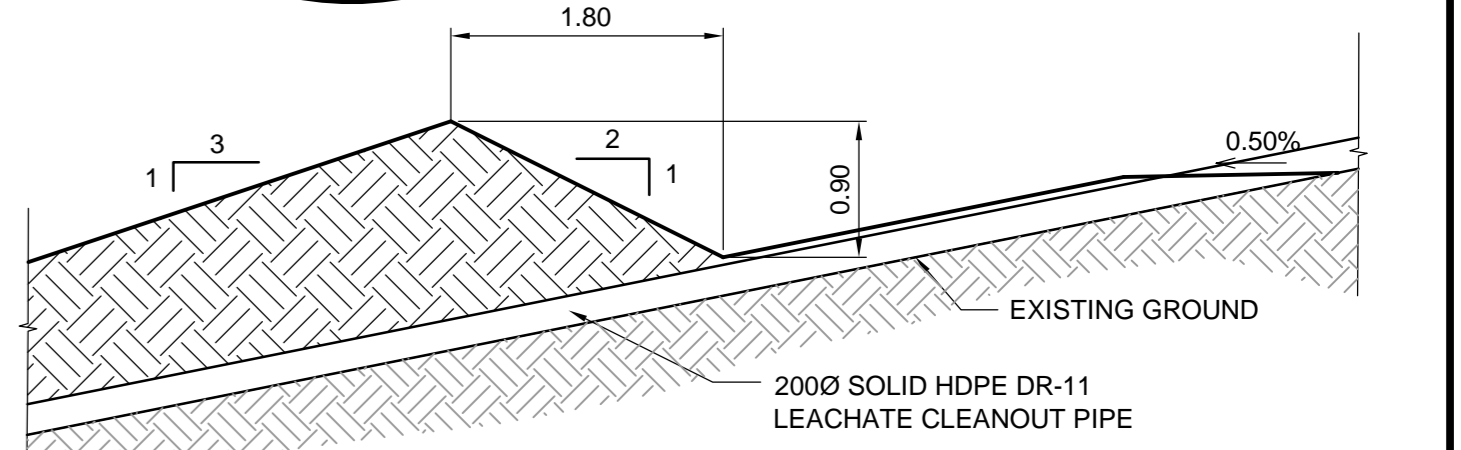

**9**  
DRAINAGE DIVERSION BERM (TYPICAL EAST SECTION)  
1:50

**6**  
GEOMEMBRANE FLAP DETAIL  
NTS

01

01

B.M.	ELEV.			

<b>TETRA TECH</b>	
DESIGNED BY: JM	CHECKED BY: GS
DRAWN BY: GMD	APPROVED BY: BLM
HOR. SCALE: AS NOTED	RELEASED FOR CONSTRUCTION
DATE: 14.01.09	DATE:

ORIGINAL DRAWING REVISION "00" SEALED BY J.H.J. MULLER 14.03.25  
CONSULTANT DRAWING NO. 1300120600-DWG-C0015

**THE CITY OF WINNIPEG**  
WATER AND WASTE DEPARTMENT

BRADY ROAD LANDFILL ACCESS ROAD AND DISPOSAL CELL  
DISPOSAL CELL DETAILS

CITY DRAWING NUMBER: SWD-D-442  
SHEET 15 OF 20

C4004

**APEGM**  
Certificate of Authorization  
**TETRA TECH WEI Inc.**  
No. 5313 Date: April 30, 2014

BID OPPORTUNITY 259-2014