



LEGEND

LEGEND	EXISTING
SEWER	—
SEWER MH	○
SEWER PLUG	⊥
SEWER CB	□
SEWER STRUCT	□
WM	—
WM VALVE	⊗
WM HYDRANT	⊕
GAS	—
HYDRO	—
HYDRO POLE	●HP
HYDRO STR	□
HYDRO POLE	●H
STREET LIGHT	⊙
HYDRO TRANSFORMER	⊗
BOLLARD	⊙
TREE	⊙
SHRUBS/BUSH	⊙
CULVERT	—
DITCH	—
ROAD	—
FENCE	—
LEASED LAND UNDER CULTIVATION	—
HILL CONTOURS	234.0
REVCLOUD	⊙

NOTE:
HORIZONTAL DATUM: NAD83 ZONE 14 CGVD28

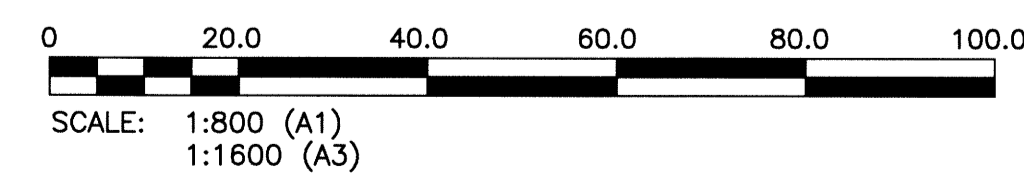

NOTE:
1. ALL WORK SHALL BE PERFORMED IN ACCORDANCE WITH THE CITY OF WINNIPEG STANDARD CONSTRUCTION SPECIFICATIONS

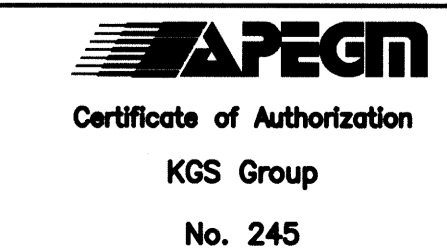

B.M.	BRASS PLATE LOCATED IN GRADE BEAM OF ADMINSTRATOR BUILDING
ELEV.	234.059
DESIGNED BY:	EMS
CHECKED BY:	BJM
DRAWN BY:	DMW
APPROVED BY:	RJH
SCALE:	AS NOTED
RELEASED FOR CONSTRUCTION BY:	
DATE:	2014/06/27
CONSULTANT NO.:	13-0338-002

CH2MHILL.

SNC-LAVALIN

KGS GROUP

ENGINEER'S SEAL

PROVINCE OF MANITOBA
B.J. MIKOLAYENKO
Member 24688
REGISTERED PROFESSIONAL ENGINEER

July 17/2014

THE CITY OF WINNIPEG
Winnipeg WATER AND WASTE DEPARTMENT

**SOUTH END WATER POLLUTION CONTROL CENTRE
SEWPPC UPGRADE/EXPANSION PROJECT**
CIVIL
EXISTING SITE PLAN

CITY DRAWING NUMBER: 1-0102-CGAD-A001
SHEET: 001
REV: 01
SIZE: A1