


**LEGEND**

	EXISTING	NEW
SEWER	○	●
SEWER MH	○	●
SEWER PLUG	⊕	⊕
SEWER CB	□	□
SEWER STRUCT	□	□
WM	—	—
WM VALVE	⊗	⊗
WM HYDRANT	⊕	⊕
GAS	—	—
HYDRO	—	—
HYDRO POLE	●HP	●HP
HYDRO STR	□	□
HYDRO POLE	●	●
STREET LIGHT	⊕	⊕
HYDRO TRANSFORMER	⊗	⊗
BOLLARD	⊗	⊗
TREE	○	○
SHRUBS/BUSH	○	○
CULVERT	—	—
DITCH	—	—
ROAD	—	—
FENCE	—	—
LEASED LAND UNDER CULTIVATION	—	—
EXIST. STRUCTURE TO BE MODIFIED	▨	▨
NEW STRUCTURE	▨	▨
NEW ROAD	▨	▨
REVCLOUD	○	○

**NOTE:**  
1. ALL WORK SHALL BE PERFORMED IN ACCORDANCE WITH THE CITY OF WINNIPEG STANDARD CONSTRUCTION SPECIFICATIONS

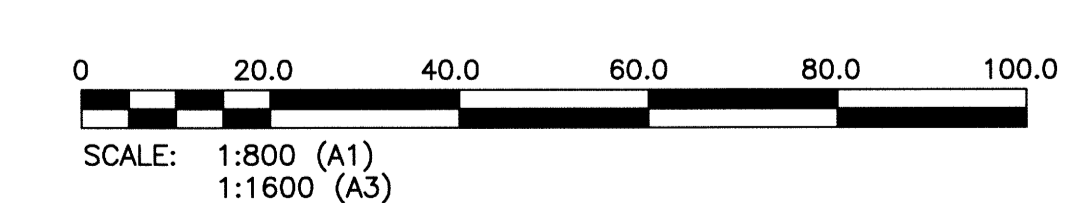

**APEGN**  
Certificate of Authorization  
KGS Group  
No. 245

B.M. BRASS PLATE LOCATED IN GRADE BEAM OF ADMINISTRATOR BUILDING ELEV. 234.059		<b>CH2MHILL</b>		ENGINEER'S SEAL	
SNC-LAVALIN		KGS GROUP		PROVINCE OF MANITOBA B.J. MIKOLAYENKO Member 24688 REGISTERED PROFESSIONAL ENGINEER	
DESIGNED BY: EMS	CHECKED BY: BJM	DRAWN BY: DMW	APPROVED BY: RJH	DATE: 2014/06/27	
SCALE: AS NOTED		RELEASED FOR CONSTRUCTION BY:		DATE:	
NO. REVISIONS		DATE	DESIGN/CHECK	CONSULTANT NO.: 13-0338-002	
01	ISSUED FOR ADDENDUM NO.1	07/2014	BJM	DATE: 2014/06/27	
00	ISSUED FOR TENDER	06/2014	BJM RJH	DATE:	

**THE CITY OF WINNIPEG**  
WATER AND WASTE DEPARTMENT

**SOUTH END WATER POLLUTION CONTROL CENTRE**  
SEWPPC UPGRADE/EXPANSION PROJECT  
CIVIL  
SITE PLAN SOUTH

CITY DRAWING NUMBER: 1-0102-CGAD-A002  
SHEET: 002  
REV: 01  
SIZE: A1