


LEGEND	EXISTING	NEW
SEWER	—	—
SEWER MH	○	●
SEWER PLUG	⊥	—
SEWER CB	□	—
SEWER STRUCT	□	□
WM	—	—
WM VALVE	⊗	⊙
WM HYDRANT	⊕	—
GAS	—	—
HYDRO	—	—
HYDRO POLE	●HP	—
HYDRO STR	□	—
HYDRO POLE	●H	—
STREET LIGHT	⊙	—
HYDRO TRANSFORMER	⊗	⊕
BOLLARD	⊙	—
TREE	⊙	—
SHRUBS/BUSH	⊙	—
CULVERT	—	—
DITCH	—	—
ROAD	—	—
FENCE	—	—
LEASED LAND UNDER CULTIVATION	—	—
EXIST STRUCTURE TO BE MODIFIED	—	▨
NEW STRUCTURE	—	▩
NEW ROAD	—	▩
CONSTRUCTION ROAD	—	▩
REVCLOUD	—	☁

NOTE:  
 1. ALL WORK SHALL BE PERFORMED IN ACCORDANCE WITH THE CITY OF WINNIPEG STANDARD CONSTRUCTION SPECIFICATIONS

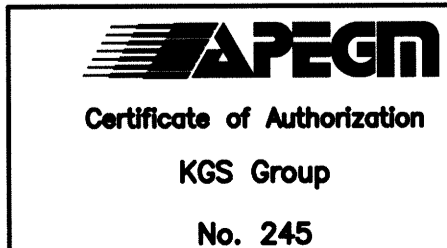

B.M. BRASS PLATE LOCATED IN GRADE BEAM OF ADMINISTRATION BUILDING ELEV. 234.059			
01	ISSUED FOR ADDENDUM NO.1	07/2014	BJM
00	ISSUED FOR TENDER	06/2014	BJM RJH
NO.	REVISIONS	DATE	DESIGN/CHECK

**CH2MHILL**

SNC-LAVALIN  
 DESIGNED BY: EMS  
 DRAWN BY: DMW  
 SCALE: AS NOTED  
 DATE: 2014/06/27  
 CONSULTANT NO.: 13-0338-002

CHECKED BY: BJM  
 APPROVED BY: RJH  
 RELEASED FOR CONSTRUCTION BY:  
 DATE:

ENGINEER'S SEAL

PROVINCE OF MANITOBA  
 B.J. MIKOLAYENKO  
 Member  
 24688  
 REGISTERED PROFESSIONAL ENGINEER

July 17, 2014

**THE CITY OF WINNIPEG**  
 WATER AND WASTE DEPARTMENT

SOUTH END WATER POLLUTION CONTROL CENTRE  
 SEWPPC UPGRADE/EXPANSION PROJECT  
 CIVIL

OVERALL SITE EXCAVATION AND STOCKPILE LOCATION PLAN

CITY DRAWING NUMBER: 1-0102-CGAD-A003  
 SHEET: 001  
 REV: 01  
 SIZE: A1