



PROFILE VIEW-B
SCALE: 1:250

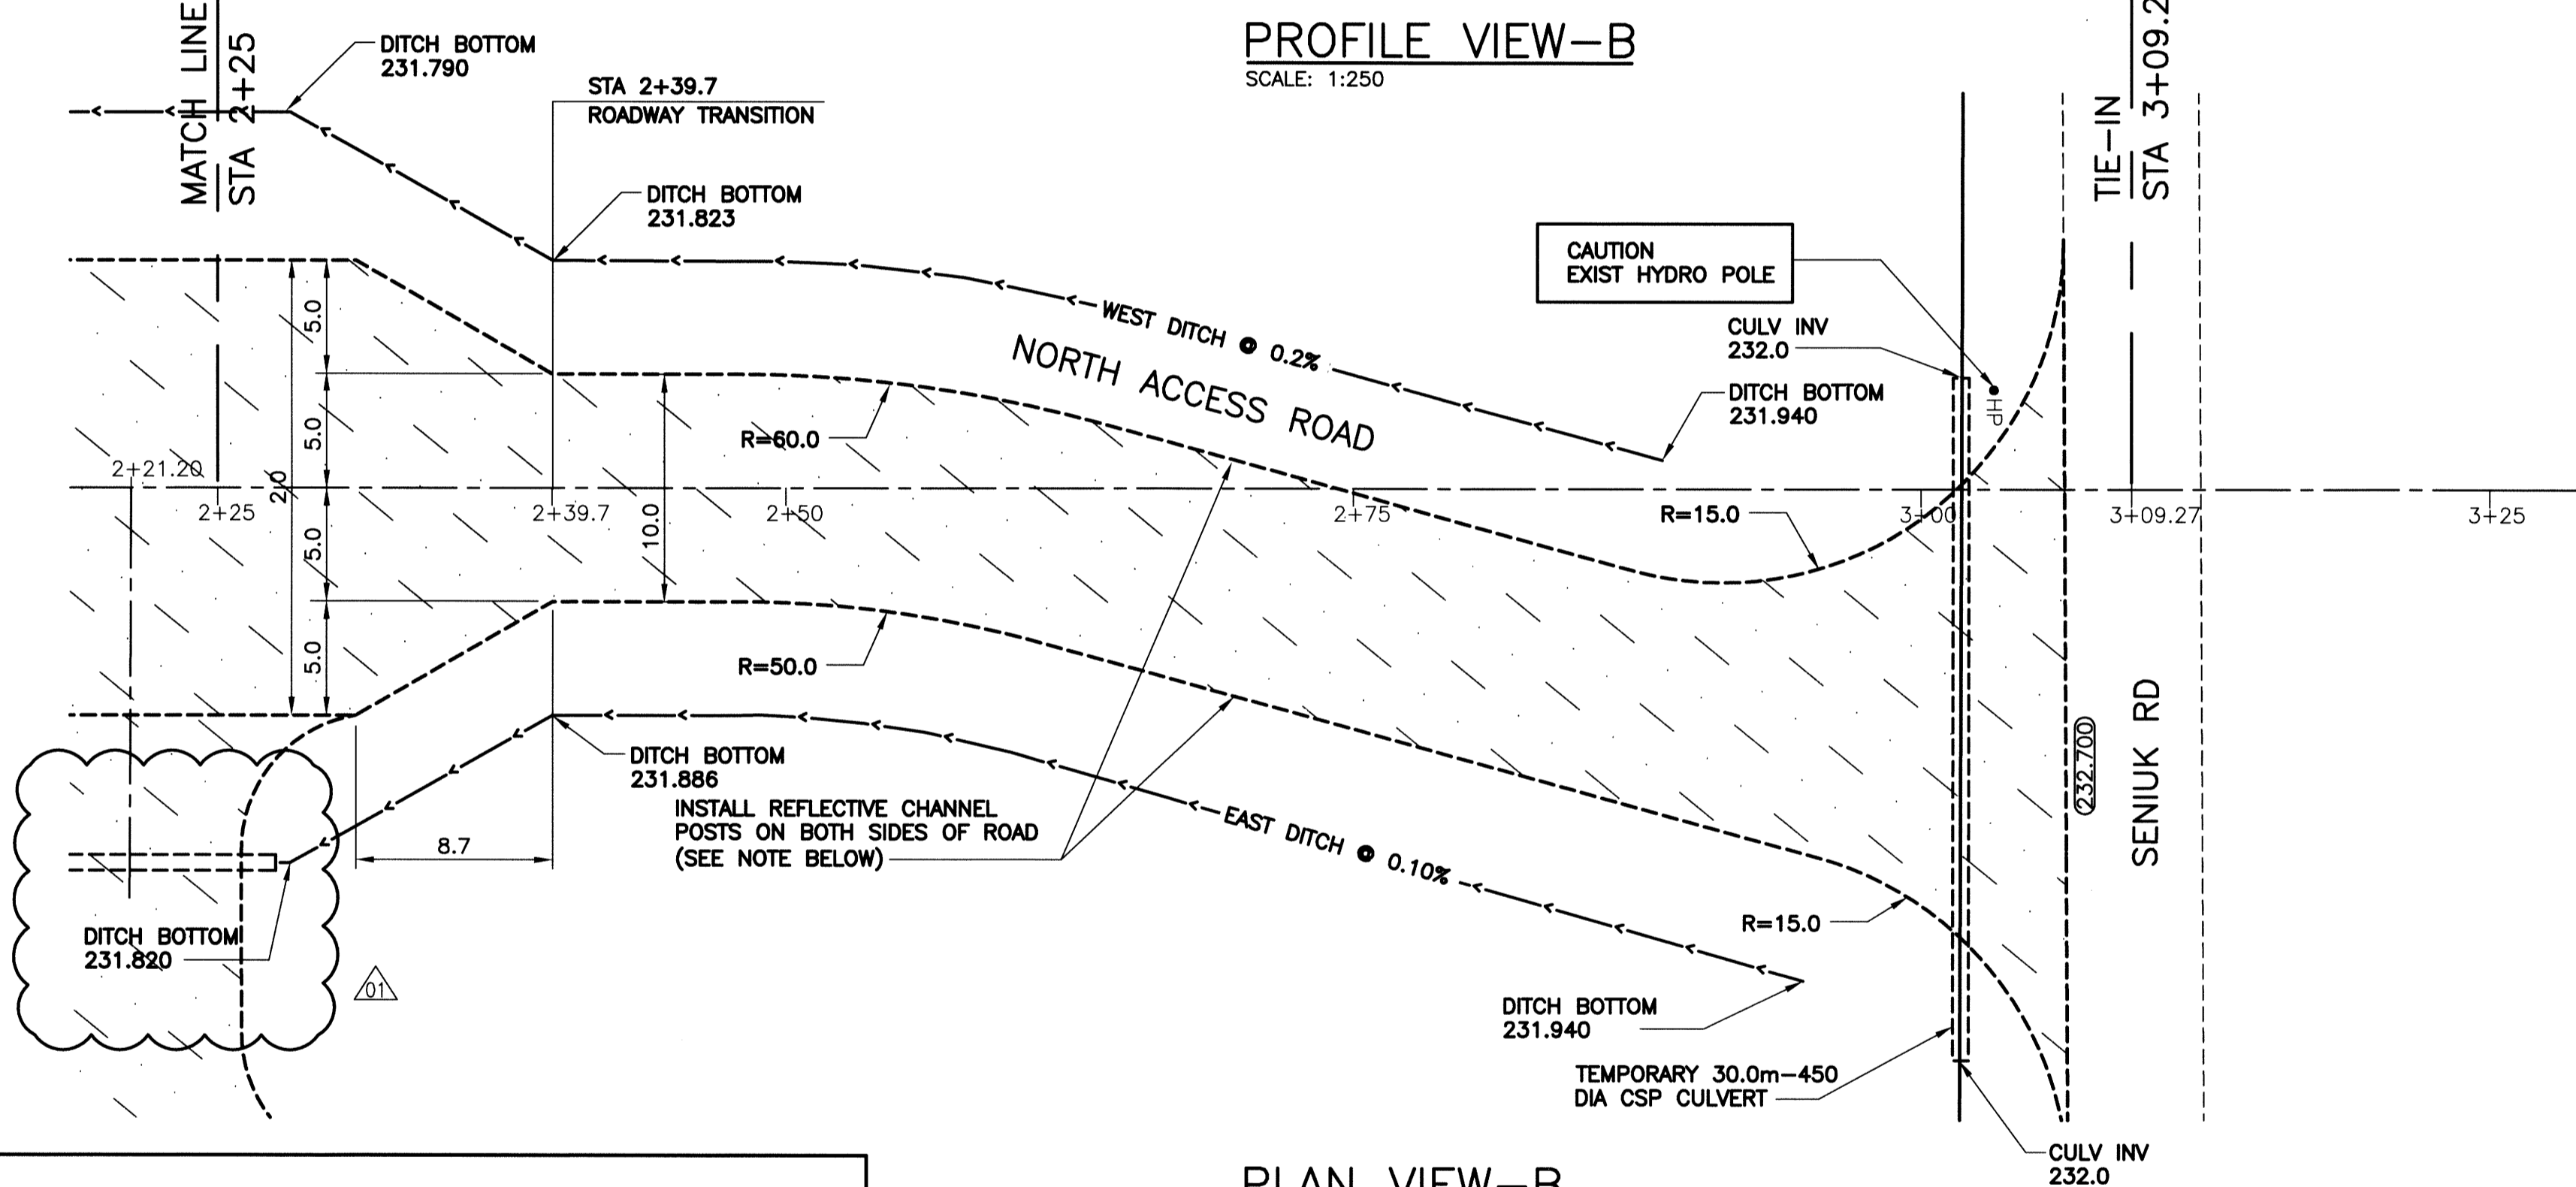

PLAN VIEW-B
SCALE: 1:250

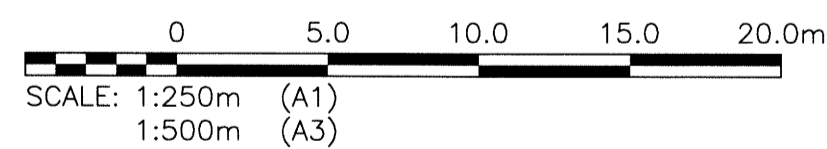


REFLECTIVE CHANNEL POST NOTE

- CONTRACTOR TO SUPPLY AND INSTALL GALVANIZED STEEL CHANNEL POSTS C/W 100mm WHITE REFLECTIVE BAND.
- CHANNELS TO BE 1.2m ABOVE FINISHED GRADE AND EMBEDDED MIN 600mm BELOW FINISHED GRADE.
- CHANNELS TO BE SPACED AT 10.0m O.C. ON BOTH SIDES OF ROAD.
- CHANNELS LOCATED AT SENUIK DRIVE AND INTERSECTION ARCS TO BE SPACED AT 2.4m O.C.

ACCESS ROAD LAYOUT CO-ORDINATES			
STATION	EASTING (X)	NORTHING (Y)	REMARKS
2+39.70	636568.760	5517604.241	ROAD TRANSITION
3+08.80	636535.003	5517664.534	ROAD TIE-IN

NOTE:
 1. ALL WORK SHALL BE PERFORMED IN ACCORDANCE WITH THE CITY OF WINNIPEG STANDARD CONSTRUCTION SPECIFICATIONS

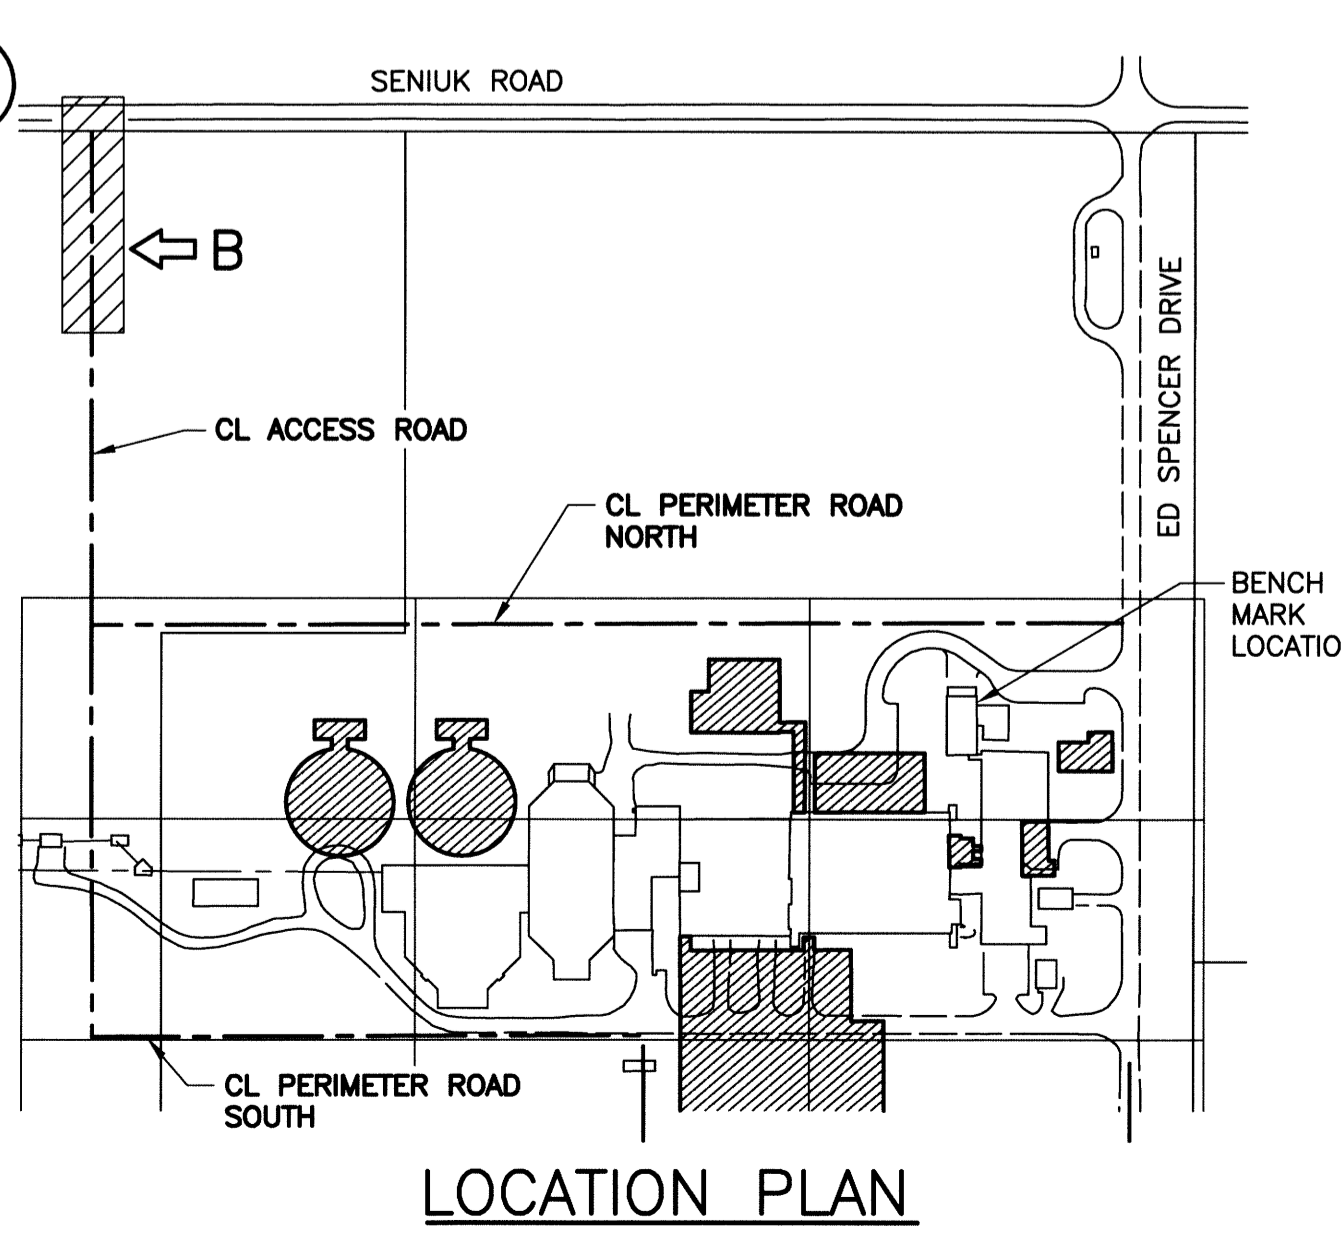


LOCATION PLAN

LEGEND							
ITEM	EXISTING	NEW	ABANDONED	ITEM	EXISTING	NEW	ABANDONED

B.M. BRASS PLATE LOCATED IN GRADE BEAM OF ADMINSTRATOR BUILDING			
B.M. ELEV.	234.059		
01	ISSUED FOR ADDENDUM NO.1	07/2014	EMS
00	ISSUED FOR TENDER	06/2014	EMS
NO. REVISIONS	DATE	DESIGN	CHECK

CH2MHILL.	
DESIGNED BY: SNC-LAVALIN	CHECKED BY: BJM
DRAWN BY: EMS	APPROVED BY: RJH
SCALE: AS NOTED	RELEASED FOR CONSTRUCTION
DATE: 2014/06/27	DATE:
CONSULTANT NO.: 13-0338-002	

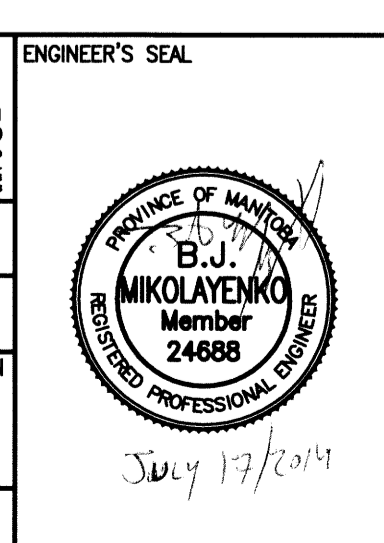

THE CITY OF WINNIPEG
 WATER AND WASTE DEPARTMENT

SOUTH END WATER POLLUTION CONTROL CENTRE
 SEWPPC UPGRADE/EXPANSION PROJECT
 CIVIL
 CONSTRUCTION ACCESS ROAD NORTH
 STA 2+25 TO STA 3+25

CITY DRAWING NUMBER	SHEET	REV.	SIZE
1-0102-CRSW-A001	002	01	A1