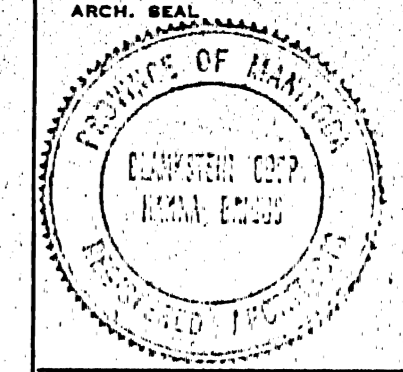


DATE	DR	AS BUILT DRAWING
REVISION		

- THIS DRAWING MUST NOT BE SCALED.
- THE GENERAL CONTRACTOR SHALL VERIFY ALL DIMENSIONS, DATUMS AND LEVELS PRIOR TO COMMENCEMENT OF WORK. ALL ERRORS AND OMISSIONS TO BE REPORTED IMMEDIATELY TO THE ARCHITECT.
- VARIATIONS & MODIFICATIONS TO WORK SHOWN ON THESE DRAWINGS SHALL NOT BE CARRIED OUT WITHOUT WRITTEN PERMISSION FROM THE ARCHITECT.
- THIS DRAWING IS THE EXCLUSIVE PROPERTY OF THE ARCHITECTS AND CAN BE REPRODUCED ONLY WITH THE PERMISSION OF THE ARCHITECTS. IN WHICH CASE THE REPRODUCTION MUST BEAR THEIR NAME AS ARCHITECTS.

**NUMBER TEN ARCHITECTURAL GROUP**  
 ARCHITECTS ENGINEERS PLANNERS  
 10 DONALD STREET NORTH WINNIPEG CANADA (204) 942 0981

ASSOCIATE ARCHITECT  
 CONSULTING ENGINEER

ARCH. SEAL  
  
 ENG. SEAL

PROJECT  
**INDOOR SWIMMING POOL**  
 FOR  
**THE CITY OF WINNIPEG**  
 WINNIPEG MANITOBA

SHEET TITLE  
**POOL PLAN AND DETAILS**

DRAWN BY  
 R.L.  
 DATE  
 OCT-17-75  
 SHEET NO.  
 A-12

CHECKED BY  
 PROJECT NO.  
 7508  
 FILE NO.

SCALE: 1/4" = 1'-0"