## **ASBESTOS INVENTORY CONTROL**



Planning, Property and Development Department Municipal Accommodations Division 4th Floor - 185 King Street • Winnipeg, MB • R3B 1J1

| Building Name:                  | Pan Am Pool - Building  | ng Inspection Date: February 2 |                       | February 28                 | ebruary 28, 2014 |           |           |  |
|---------------------------------|---|--------------------------------|-----------------------|-----------------------------|------------------|-----------|-----------|--|
| Building Code:                  | PI-13Inspected25 Poseidon BayConstruction                                     |                                | By:                   | Ryan Matthews & Matt Kanabe |                  |           |           |  |
| Building Address:               |   |                                | Construction Date:    |                             | 1967             |           |           |  |
| Material Location               | Material Description  | Drawing<br>Label               | Material<br>Condition | Testing<br>Status           | Date<br>M/Y      | Test<br>% | Est.<br>% |  |
|                                 | All Plaster Walls & Ceilings Contain Asbestos                                 |                                | Good                  | TESTED                      |                  | 1-10      |           |  |
|                                 | All pre existing door jams are insulated with asbestos containing insulation. |                                | Good                  | TESTED                      | May'12           | 20        |           |  |
| Basement                        |   |                                |                       |                             |                  |           |           |  |
| Boiler Room                     | Duct Insulation   | DI                             | Good                  | TESTED                      |                  | 40-50     |           |  |
|                                 | Pipe Fitting Insulation   | PF                             | Good                  |                             |                  |           |           |  |
|                                 | Pipe Insulation   | PI                             | Good                  | TESTED                      |                  | 20-50     |           |  |
|                                 | Pipe Insulation Yellow  | PI                             | Good                  | TESTED                      | Jan/'11          | 65-80     |           |  |
|                                 | Boiler Tanks Inspections Holes  | TI                             | Good                  | TESTED                      | Aug/11           | 3-40      |           |  |
|                                 | Tank Insulation (Hot Water Tanks)   | TI                             | Removed /11           | TESTED                      | Dec/11           | 60-75     |           |  |
|                                 | Tank Gasket   | TI                             | Good                  | TESTED                      | Aug/11           | 0         |           |  |
|                                 | Transite Pipe   | TP                             | Good                  |                             |                  |           |           |  |
| North Stairwell                 | Drain Pipe Elbow Insulation   | PF                             | Good                  | TESTED                      |                  | 0         |           |  |
| Communication Room              | 9x9 Floor Tile  | F9                             | Removed /13           |                             |                  |           |           |  |
| Pool Engineers Office           | Plaster - Ceiling   | PL                             | Good                  |                             |                  |           | 1-10      |  |
| Main Floor                      | All Plaster Walls & Ceilings Contain Asbestos                                 |                                |                       |                             |                  |           | 1-10      |  |
| Men's Washroom/ Locker Room     | Pipe Fitting Insulation   | PF                             | Good                  |                             |                  |           |           |  |
|                                 | Plaster - Ceiling   | PL                             | Good                  |                             |                  |           | 1-10      |  |
| North Stairwell                 | Plaster - Ceiling   | PL                             | Good                  |                             |                  |           | 1-10      |  |
|                                 | Plaster - Walls   | PL                             | Good                  |                             |                  |           | 1-10      |  |
| Women's Washroom/Locker<br>Room | Pipe Fitting Insulation (Inside Of North Wall)                                | PF                             | Good                  |                             |                  |           |           |  |
|                                 | Plaster - Ceiling   | PL                             | Good                  |                             |                  |           | 1-10      |  |
| South Stairwell                 | Plaster - Ceiling   | PL                             | Good                  |                             |                  |           | 1-10      |  |
|                                 | Plaster - Walls   | PL                             | Good                  |                             |                  |           | 1-10      |  |
| South Pool Room                 | Pipe Fitting Insulation   | PF                             | Good                  | _                           |                  |           |           |  |
|                                 |   |                                |                       |                             |                  |           |           |  |
|                                 |   |                                |                       |                             |                  |           |           |  |

| Metavial Lagation                      | Meterial Description                                      | Drawing | Material<br>Condition | Testing | Date<br>M/Y | Test  | Est.  |
|--|---|---------|-----------------------|---------|-------------|-------|-------|
| Material Location<br>Second Floor      | Material Description                                      | Label   | Condition             | Status  | IVI/ Y      | %     | %     |
| Track Exterior Walls/ Elevator<br>Wall | Plaster Walls encapsulated behind retrofitted stucco wall |         | Good                  |         |             |       | 1-10  |
| Under South Bleachers                  | All Plaster Walls & Ceilings Contain Asbestos             |         |                       |         |             |       | 1-10  |
| West Mechanical Area                   | Spray On Insulation                                       | SO      | Removed               |         |             |       |       |
|  | Pipe Fitting Insulation                                   | PF      | Good                  |         |             |       | 20-40 |
|  | Pipe Mastic   | MA      | Good                  |         |             |       | 10    |
|  | Mastic - Duct   | MA      | Good                  | TESTED  | Feb/'12     | 10    |       |
|  | Plaster - Walls   | PL      | Good                  | _       |             |       | 1-10  |
| Canteen & Washrooms                    | Plaster - Ceiling   | PL      | Good                  |         |             |       | 1-10  |
|  | Plaster - Walls   | PL      | Good                  |         |             |       | 1-10  |
| Centre Mechanical Area                 | Spray On Insulation                                       | SO      | Removed               |         |             | 20-40 |       |
|  | Pipe Fitting Insulation                                   | PF      | Good                  |         |             |       |       |
|  | Pipe Mastic   | MA      | Good                  |         |             |       | 10    |
|  | Plaster - Walls   | PL      | Good                  |         |             |       | 1-10  |
| East Mechanical Area                   | Spray On Insulation                                       | SO      | Removed               | TESTED  |             | 50-60 |       |
|  | Pipe Fitting Insulation                                   | PF      | Good                  |         |             |       |       |
|  | Pipe Mastic   | MA      | Good                  |         |             |       | 10    |
|  | Plaster - Walls   | PL      | Good                  |         |             |       | 1-10  |
| South Bleachers Attic Area             | Spray On Insulation                                       | SO      | Removed               |         |             |       |       |
|  | Pipe Fitting Insulation                                   | PF      | Removed               |         |             |       |       |
| Top Of Bleachers                       |   |         |                       |         |             |       |       |
| Stairways and Back Walls               | Plaster - Walls   | PL      | Good                  |         |             |       | 1-10  |
| Storage Room                           | Plaster - Walls   | PL      | Good                  |         |             |       | 1-10  |
|  | Plaster - Ceiling   | PL      | Good                  |         |             |       | 1-10  |
| Under North Bleachers                  |   |         |                       |         |             |       |       |
| West Mechanical Area                   | Spray On Insulation                                       | SO      | Removed               |         |             |       |       |
|  | Pipe Fitting Insulation                                   | PF      | Removed               |         |             |       |       |
|  | Pipe Mastic   | MA      | Good                  |         |             |       | 10    |
|  | Plaster - Walls   | PL      | Good                  |         |             |       | 1-10  |
| Washrooms & Canteen                    | Plaster - Ceiling   | PL      | Good                  |         |             |       | 1-10  |
|  | Plaster - Walls   | PL      | Good                  |         |             |       | 1-10  |
| Central Mechanical Area                | Spray On Insulation                                       | SO      | Removed               |         |             |       |       |
|  | Pipe Fitting Insulation                                   | PF      | Good                  | TESTED  |             | 40-50 |       |
|  | Pipe Mastic   | MA      | Good                  | TESTED  | Jan/'12     | 10    |       |
|  | Plaster - Walls   | PL      | Good                  |         |             |       | 1-10  |

|                                   |                                     | Drawing | Material  | Testing | Date    | Test  | Est.  |
|-----------------------------------|-------------------------------------|---------|-----------|---------|---------|-------|-------|
| Material Location                 | Material Description                | Label   | Condition | Status  | M/Y     | %     | %     |
| East Mechanical Area              | Plaster - Walls                     | PL      | Good      |         |         |       | 1-10  |
|                                   | Spray On Insulation                 | SO      | Removed   |         |         |       | 1-10  |
|                                   | Pipe Fitting Insulation             | PF      | Good      |         |         |       | 40-50 |
|                                   | Pipe Mastic                         | MA      | Good      |         |         |       | 10    |
| Offices                           | Plaster - Ceiling                   | PL      | Good      |         |         |       | 1-10  |
|                                   | Plaster - Walls                     | PL      | Good      |         |         |       | 1-10  |
|                                   | Sheet Flooring                      | FS      | Good      | TESTED  | Feb/'13 | 15    |       |
| Under North Bleachers Attic       | Spray On Insulation                 | SO      | Removed   |         |         |       |       |
|                                   | Pipe Fitting Insulation             | PF      | Removed   |         |         |       | 10    |
| Top Of Bleachers                  |                                     |         |           |         |         |       |       |
| Stairways and Back Walls          | Plaster - Walls                     | PL      | Good      |         |         |       |       |
| Storage Room                      | Plaster - Ceiling                   | PL      | Good      |         |         |       |       |
|                                   | Plaster - Walls                     | PL      | Good      |         |         |       |       |
| Catwalk Area                      |                                     |         |           |         |         |       |       |
|                                   | Duct Insulation (Black Mastic Only) | DI      | Good      | TESTED  |         | 15    |       |
| Southwest Air Handling Unit       | Pipe Fitting Insulation             | PF      | Good      | TESTED  | Mar/'12 | 30-50 |       |
| Northwest Air Handling Unit       | Pipe Fitting Insulation             | PF      | Good      |         |         |       | 40-50 |
| Northeast Air Handling Unit       | Pipe Fitting Insulation             | PF      | Good      |         |         |       | 40-50 |
| Centre Fan Unit                   | Pipe Fitting Insulation             | PF      | Good      |         |         |       | 40-50 |
|                                   | Duct Insulation                     | DI      | Good      | TESTED  | Feb/'13 | 0     |       |
| 30"Exhaust Pipe @ North East      | Transite Pipe                       | TP      | Good      |         |         |       |       |
| 30"Exhaust Pipe @ South East      | Transite Pipe                       | TP      | Good      |         |         |       |       |
| Roof Drains                       | Transite Pipe                       | TP      | Good      |         |         |       |       |
| Above Pool Area                   | Transite Ceiling Tile               | С       | Good      | TESTED  |         | 30-50 |       |
| Roof                              |                                     |         |           |         |         |       |       |
| 30" Exhaust Pipe East End of Roof | Transite Pipe                       | TP      | Good      |         |         |       |       |
|                                   |                                     |         |           |         |         |       |       |
|                                   |                                     |         |           |         |         |       |       |
|                                   |                                     |         |           |         |         |       |       |
|                                   |                                     |         |           | 1       |         |       |       |
|                                   |                                     |         |           | 1       |         |       |       |
|                                   |                                     |         |           |         |         |       |       |
|                                   |                                     |         |           |         |         |       |       |
|                                   |                                     |         |           |         |         |       |       |

|                    |                         | Drawing | Material  | Testing | Date | Test | Est. |
|--------------------|-------------------------|---------|-----------|---------|------|------|------|
| Material Location  | Material Description    | Label   | Condition | Status  | M/Y  | %    | %    |
|                    |                         |         |           |         |      |      |      |
| Exterior           |                         |         |           |         |      |      |      |
| C O 2 Storage Room | Pipe Fitting Insulation | PF      | Good      |         |      |      |      |
|                    | Stucco - Ceiling        | ST      | Good      |         |      |      |      |
|                    | Stucco - Walls          | ST      | Good      |         |      |      |      |
|                    |                         |         |           |         |      |      |      |

NOTES:

1. Asbestos inspections and inventory updates are conducted annually.


2. There may be asbestos containing materials present that were not located during asbestos inspections.


3. Floor tile and sheet flooring installed before 1990 may contain asbestos and must be treated as an asbestos containing material.


4. Vermiculite insulation may contain pockets of asbestos. All vermiculite insulation must be treated as an asbestos containing material.

5. For asbestos related inquiries, call Central Control at 204-986-2382

**PI-13** 

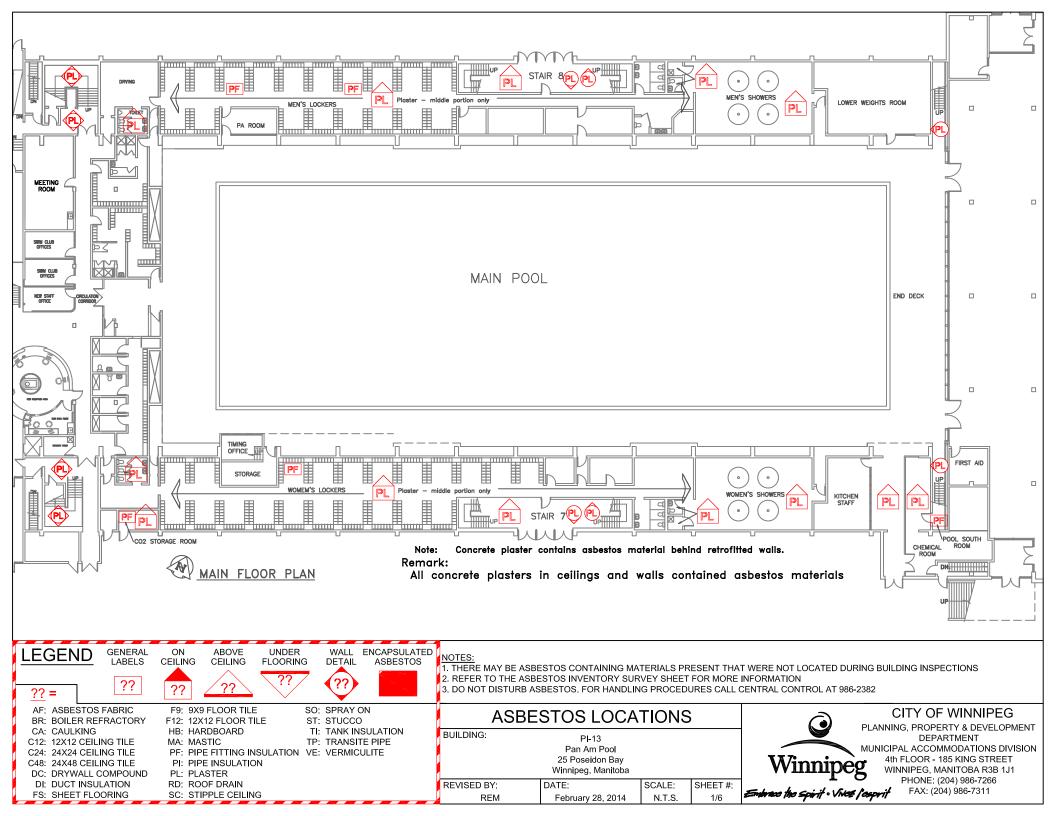

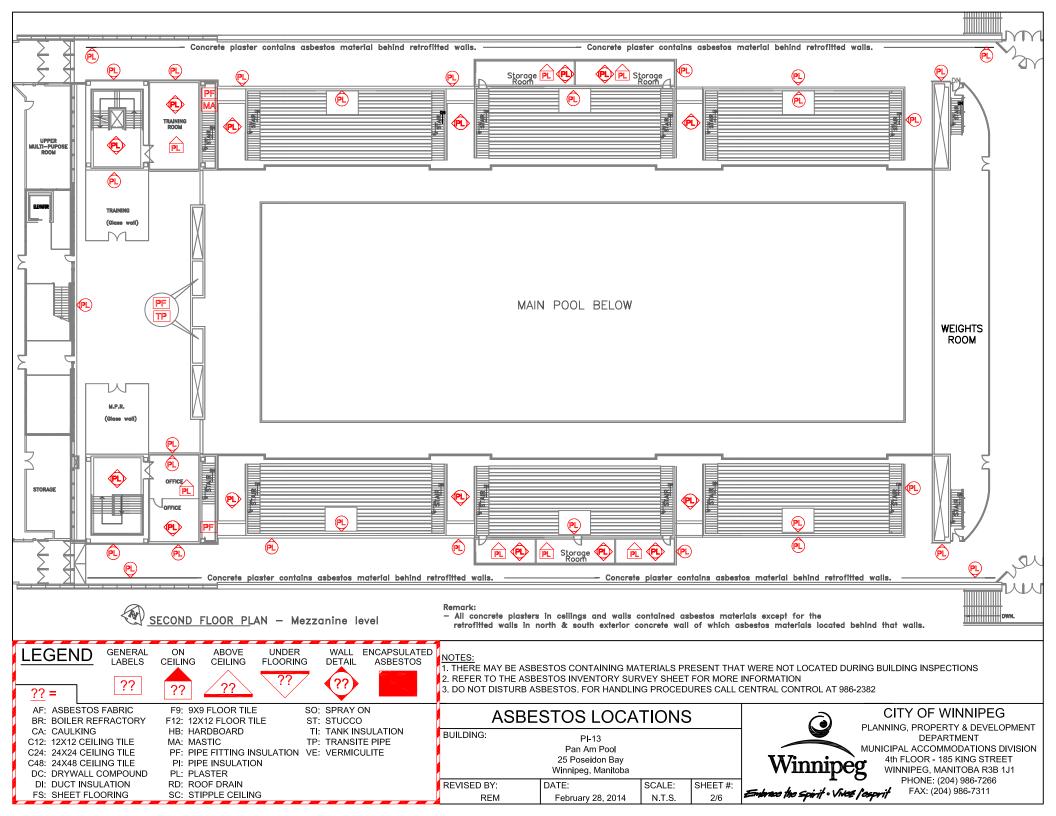

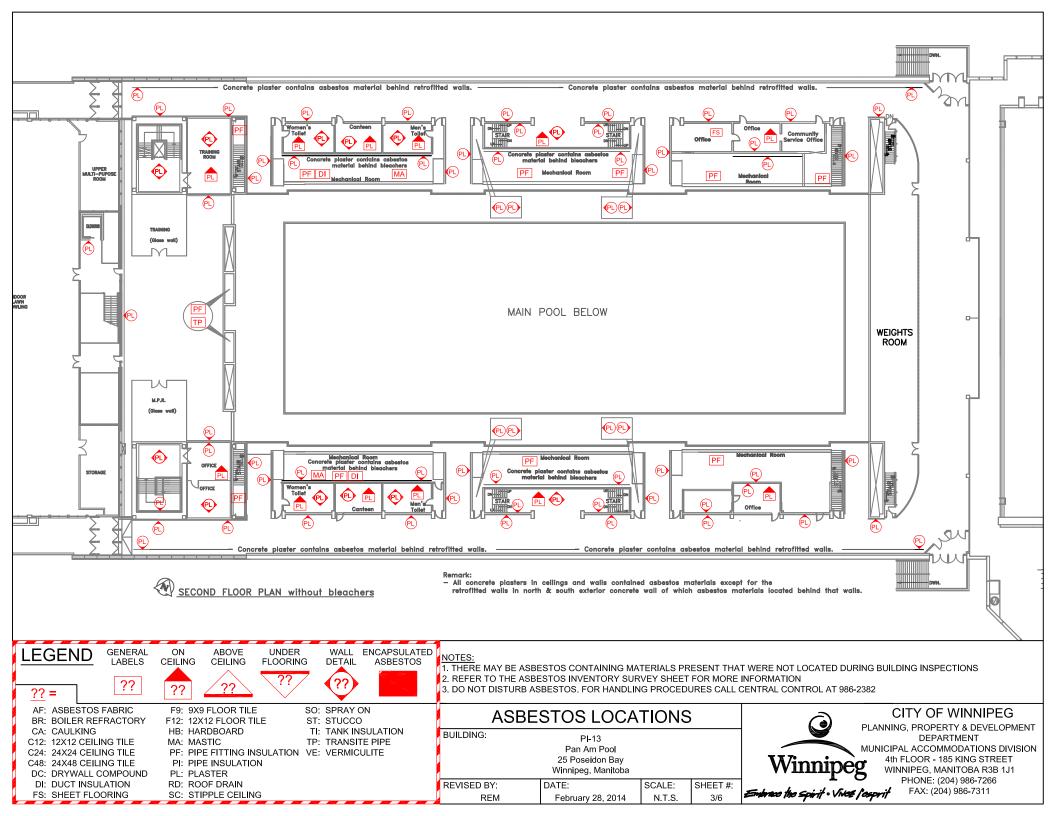

|   |  |   | Dwn.  |  |  |  |
|---|--|---|---|--|--|--|
| e e e e e e e e e e e e e e e e e e e   | concrete plaster contains asbestos material behind retrofitted v   |   |   |  |  |  |
|   |  |   | SERVICE CRAWL SPACE   |  |  |  |
|   | - Concrete plaster contains asbestos material behind retrofit  |   |   |  |  |  |
| LEGEND   GENERAL<br>LABELS   ON<br>CEILING   ABOVE<br>CEILING   UNDER<br>FLOORING   WALL<br>DETAIL   ENCAPSULATED<br>ASBESTOS   NOTES:     ?? |  |   |   |  |  |  |
| C24: 24X24 CEILING TILE PI<br>C48: 24X48 CEILING TILE P<br>DC: DRYWALL COMPOUND PI<br>DI: DUCT INSULATION RI  | A: MASTIC TP: TRANSITE PIPE<br>F: PIPE FITTING INSULATION VE: VERMICULITE<br>I: PIPE INSULATION<br>C: PLASTER<br>D: ROOF DRAIN<br>C: STIPPLE CEILING | Pan Am Pool<br>25 Poseidon Bay<br>Winnipeg, Manitoba<br>PEVISED RY: DATE: SCALE: SHEET #: | DEPAR IMENI<br>ACCOMMODATIONS DIVISION<br>.OOR - 185 KING STREET<br>IPEG, MANITOBA R3B 1J1<br>HONE: (204) 986-7266<br>FAX: (204) 986-7311 |  |  |  |

| T4   |  |   |  |
|--|--|---|--|
|  | T2 T3 T4 T5 T6 T7  |   |  |
|  |  |   |  |
|  |  |   |  |
|  | Remark:<br>– Asbestos  | containing pipe fittings are through out catwalk area in various locations.   |  |
| LEGEND GENERAL   LABELS ??   | ON<br>CEILING ABOVE<br>CEILING UNDER<br>FLOORING WALL<br>DETAIL ENCAPSULATED<br>ASBESTOS   ?? ?? ?? ??   | NOTES:<br>1. THERE MAY BE ASBESTOS CONTAINING MATERIALS PRESENT THA<br>2. REFER TO THE ASBESTOS INVENTORY SURVEY SHEET FOR MORE<br>3. DO NOT DISTURB ASBESTOS. FOR HANDLING PROCEDURES CALL (                 | INFORMATION  |
| AF: ASBESTOS FABRIC<br>BR: BOILER REFRACTORY<br>CA: CAULKING<br>C12: 12X12 CEILING TILE<br>C24: 24X24 CEILING TILE<br>C48: 24X48 CEILING TILE<br>DC: DRYWALL COMPOUND<br>DI: DUCT INSULATION<br>FS: SHEET FLOORING | F9: 9X9 FLOOR TILE   SO: SPRAY ON     F12: 12X12 FLOOR TILE   ST: STUCCO     HB: HARDBOARD   TI: TANK INSULATION     MA: MASTIC   TP: TRANSITE PIPE     PF: PIPE FITTING INSULATION   VE: VERMICULITE     PI: PIPE INSULATION   PL: PLASTER     RD: ROOF DRAIN   SC: STIPPLE CEILING | ASBESTOS LOCATIONS     BUILDING:   PI-13     Pan Am Pool   25 Poseidon Bay     Vinnipeg, Manitoba   Winnipeg, Manitoba     REVISED BY:   DATE:   SCALE:   SHEET #:     REM   February 28, 2014   N.T.S.   5/6 | CITY OF WINNIPEG<br>PLANNING, PROPERTY & DEVELOPMENT<br>DEPARTMENT<br>MUNICIPAL ACCOMMODATIONS DIVISION<br>4th FLOOR - 185 KING STREET<br>WINNIPEG, MANITOBA R3B 1J1<br>PHONE: (204) 986-7266<br>FAX: (204) 986-7311 |

