



FILE NAME: 201315\NO.dwg DATE: 2014.09.05 SHEET TITLE: PROJECT No: ADDRESS: 6 FERMOR AVENUE


NOTES:

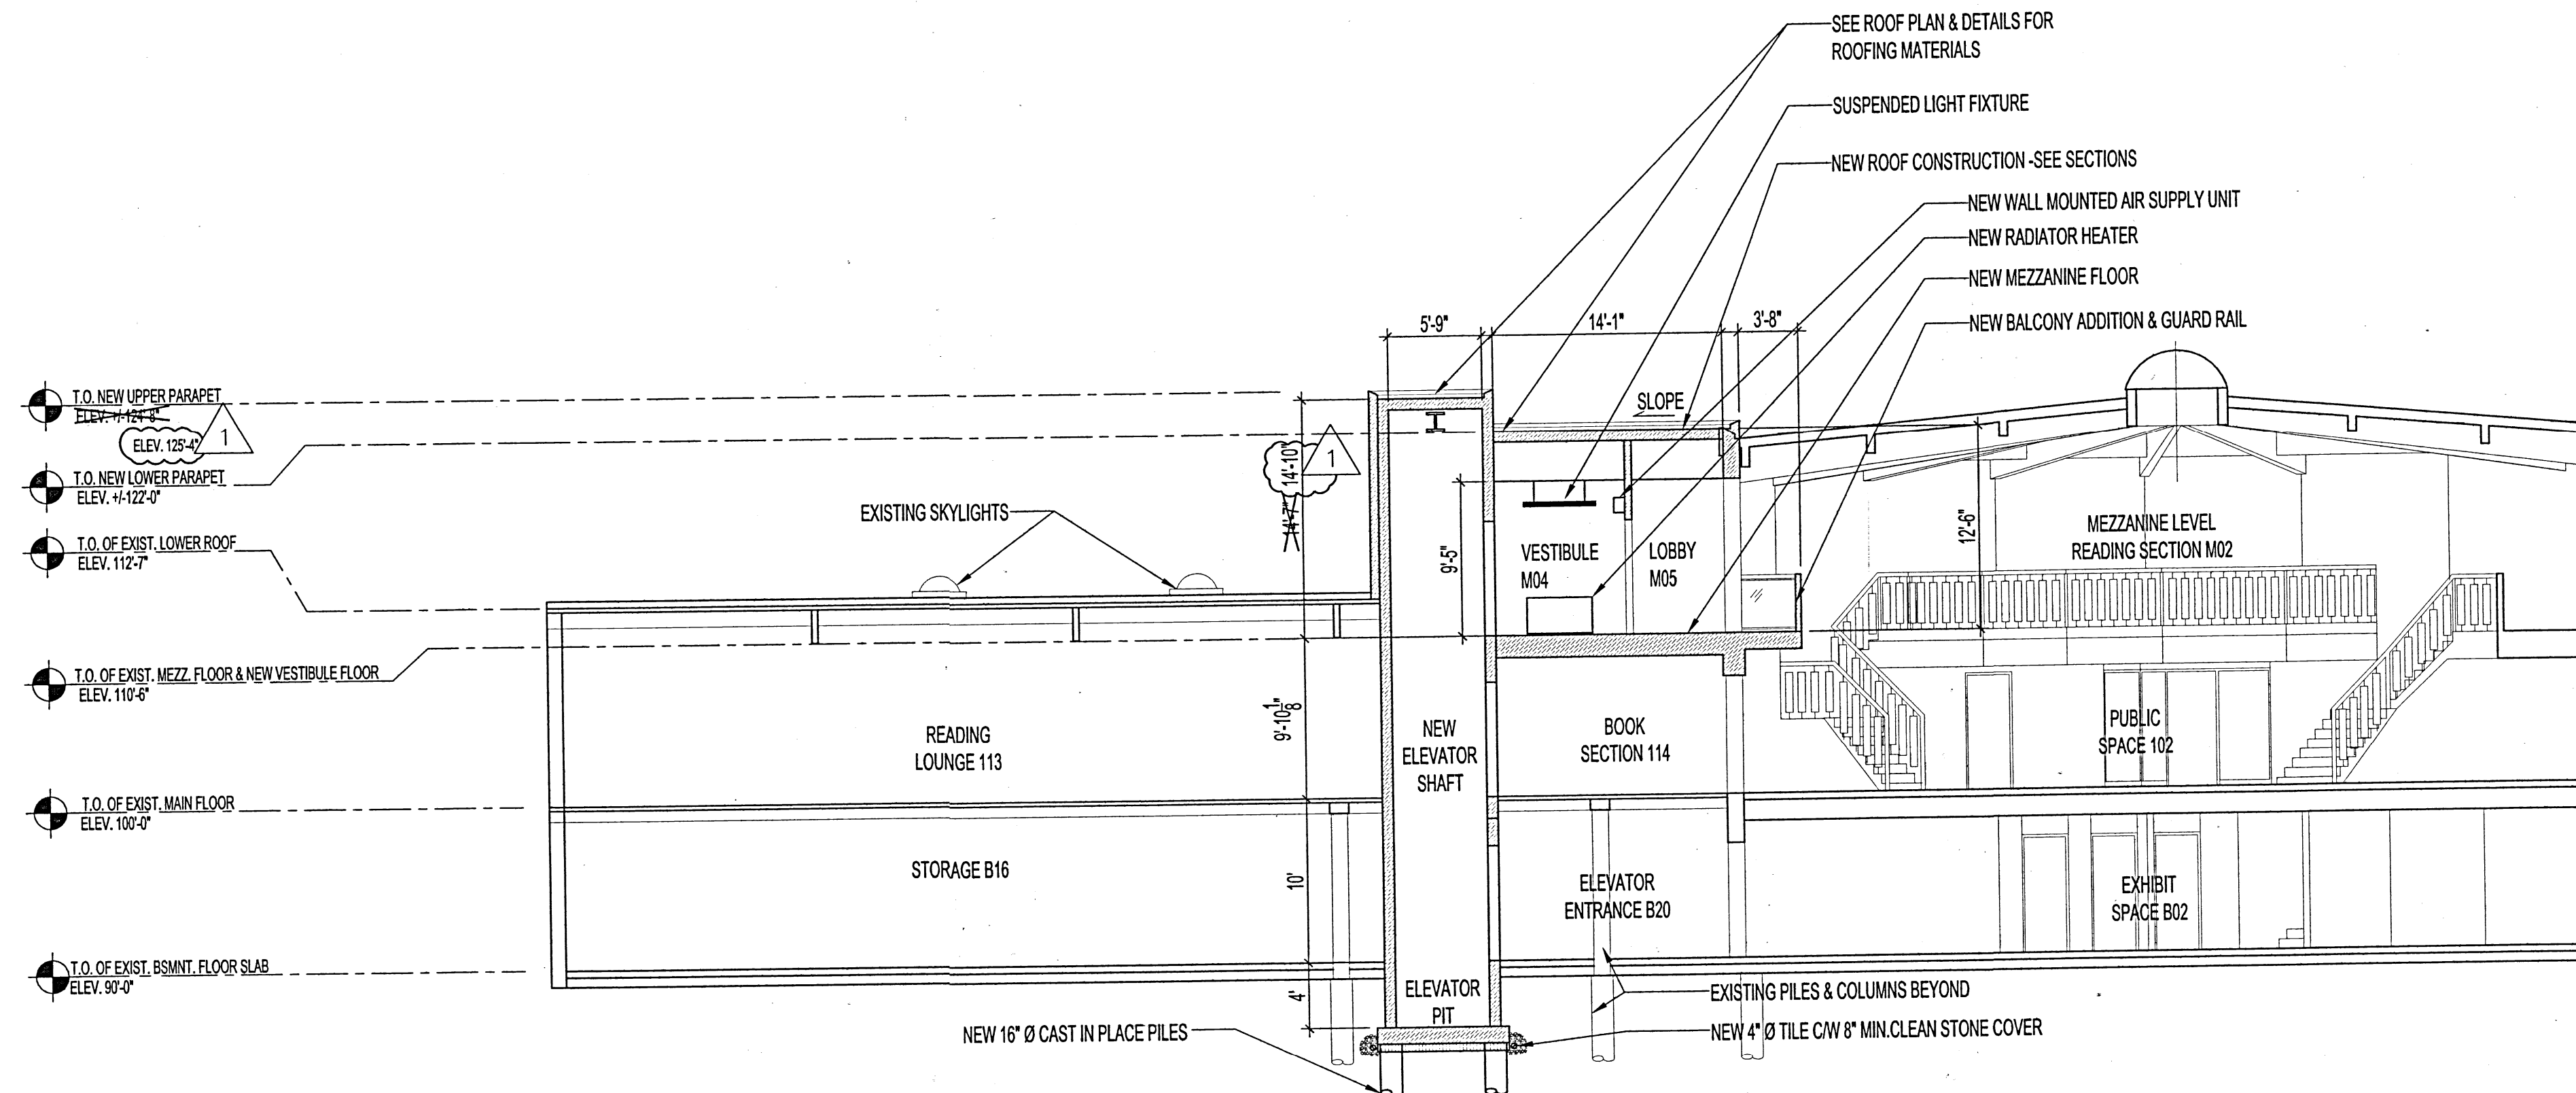


1 BUILDING SECTION  
A2 | A4 SCALE 1/8" = 1'-0"

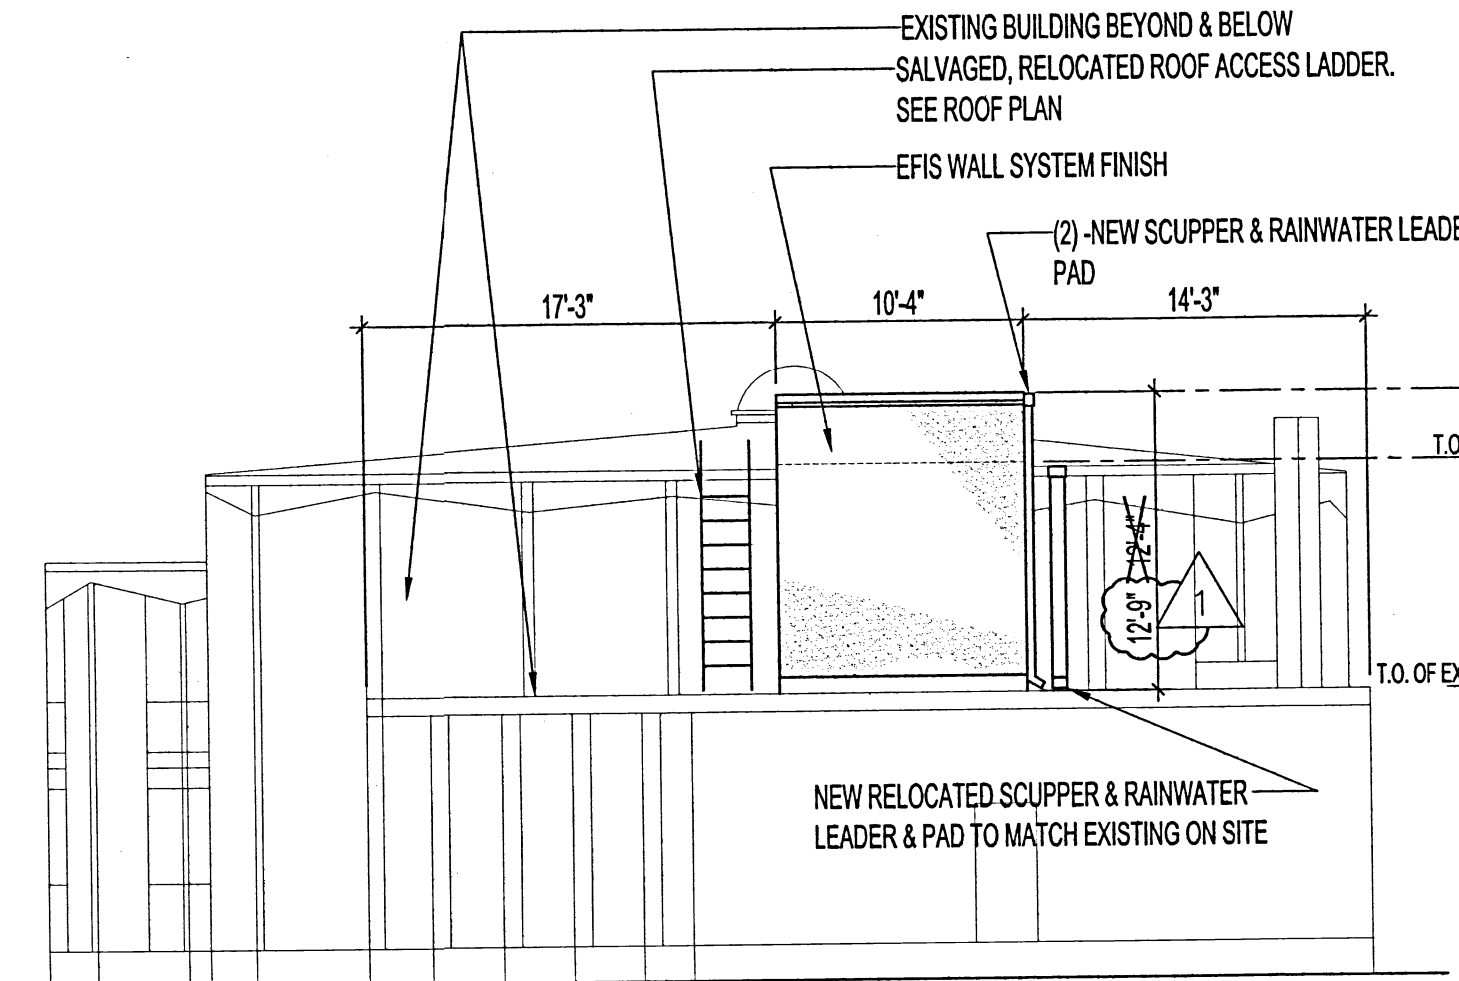

2 BUILDING ELEVATION SOUTH  
A4 | A4 SCALE 1/8" = 1'-0"

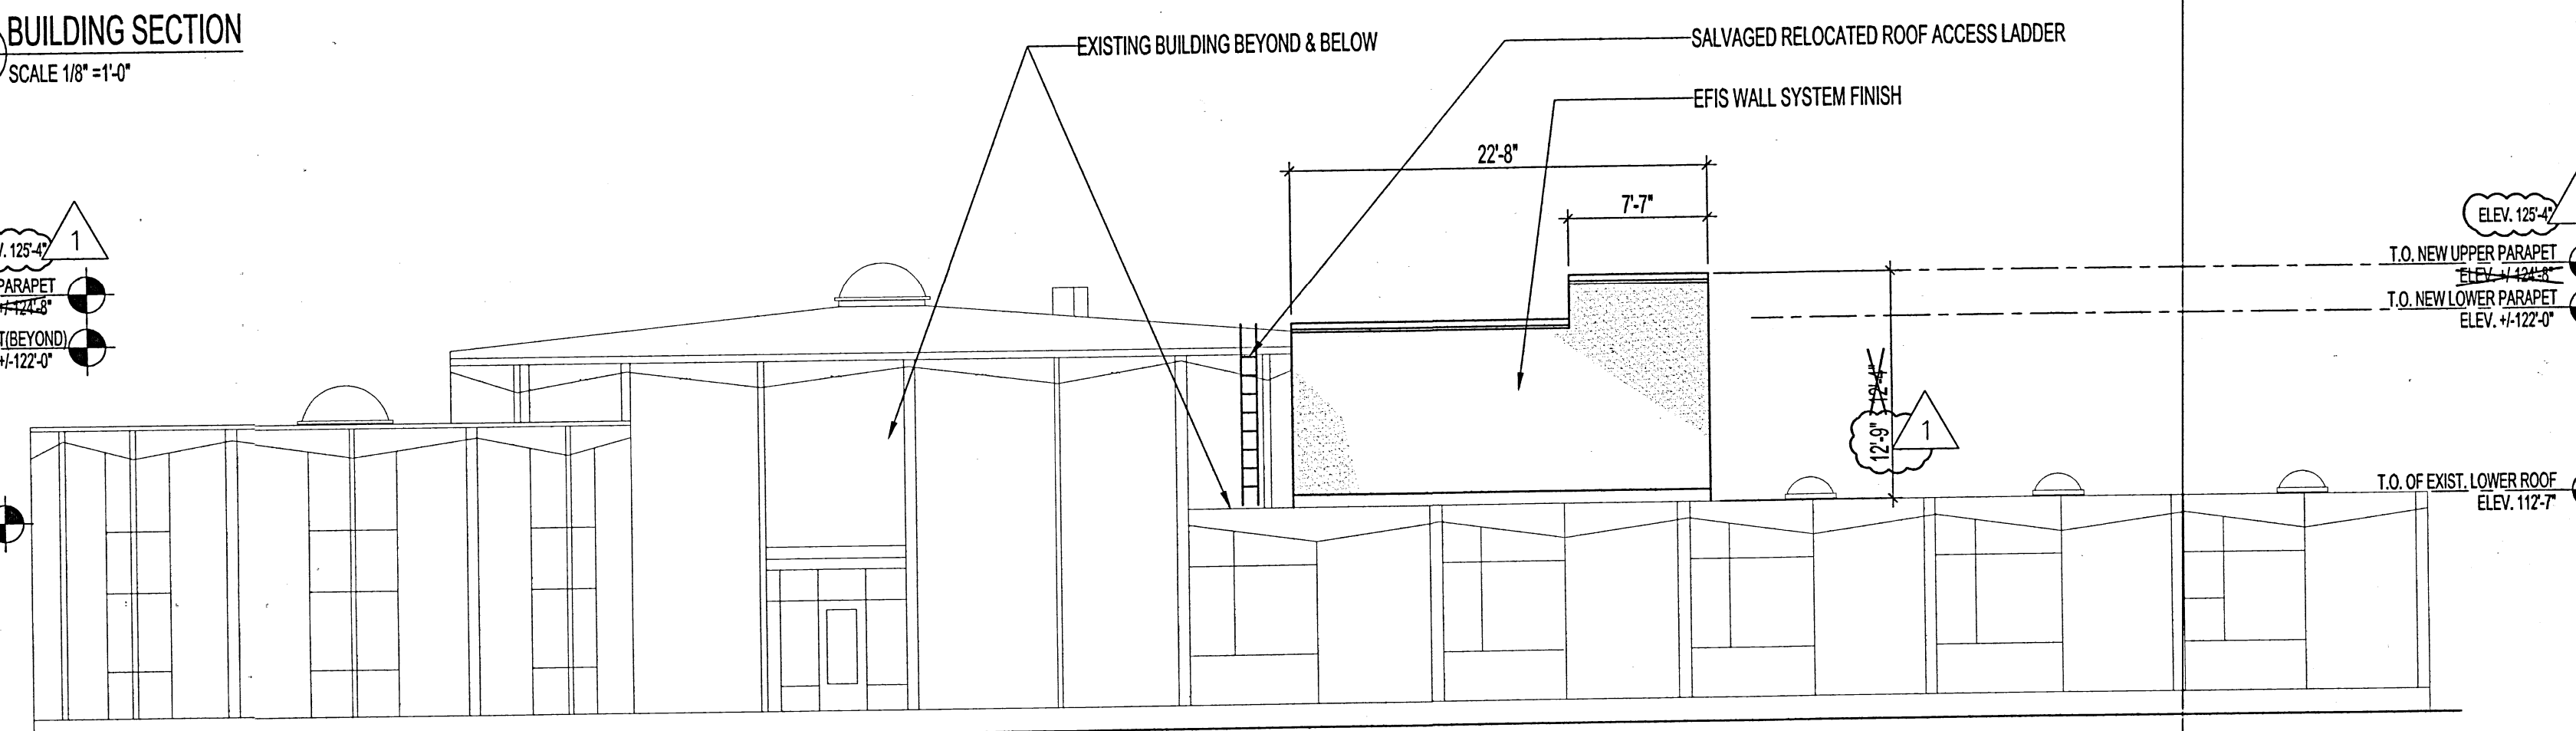

3 BUILDING ELEVATION WEST  
A4 | A4 SCALE 1/8" = 1'-0"

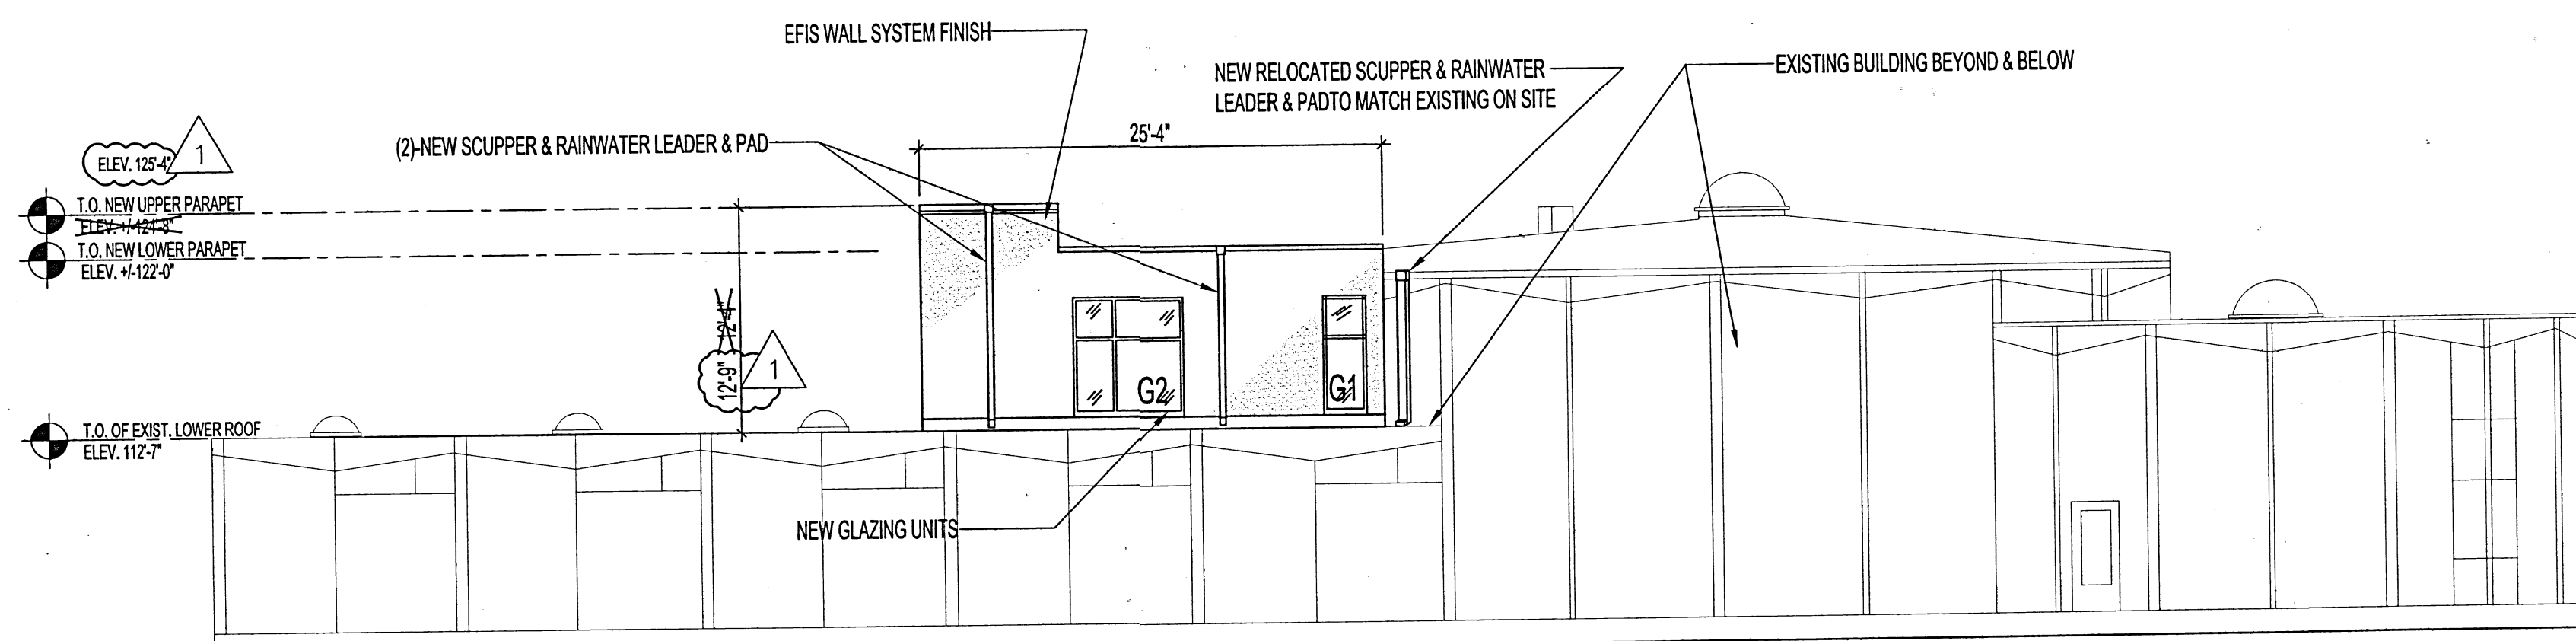

4 BUILDING ELEVATION EAST  
A4 | A4 SCALE 1/8" = 1'-0"

No.	REVISION/DESCRIPTION	BY	DATE
1	ELEVATOR SHAFT HEIGHTS (ELEVATIONS) REVISED		MMK 2014.10.06



DRAWN	CHECKED	DESIGNED	APPROVED
MMK			

THE CITY OF WINNIPEG  
PLANNING, PROPERTY AND  
DEVELOPMENT DEPARTMENT  
MUNICIPAL ACCOMMODATIONS DIVISION  
3-65 GARRY STREET, R3C 4K4

PROJECT  
ST. VITAL LIBRARY  
NEW ELEVATOR INSTALLATION

6 FERMOR AVENUE  
SHEET TITLE  
BUILDING SECTION  
& BUILDING ELEVATIONS

SCALE	PROJECT No:	SHEET No:
AS SHOWN		A4R1

DRAWING SHEET SIZE: A1 (841mm x 594mm) PLOT 1:1