



NOTE: ALL ELEVATOR SHAFT PENETRATIONS TO BE FIRE STOPPED FOR A 3/4 HR. FIRE RATING

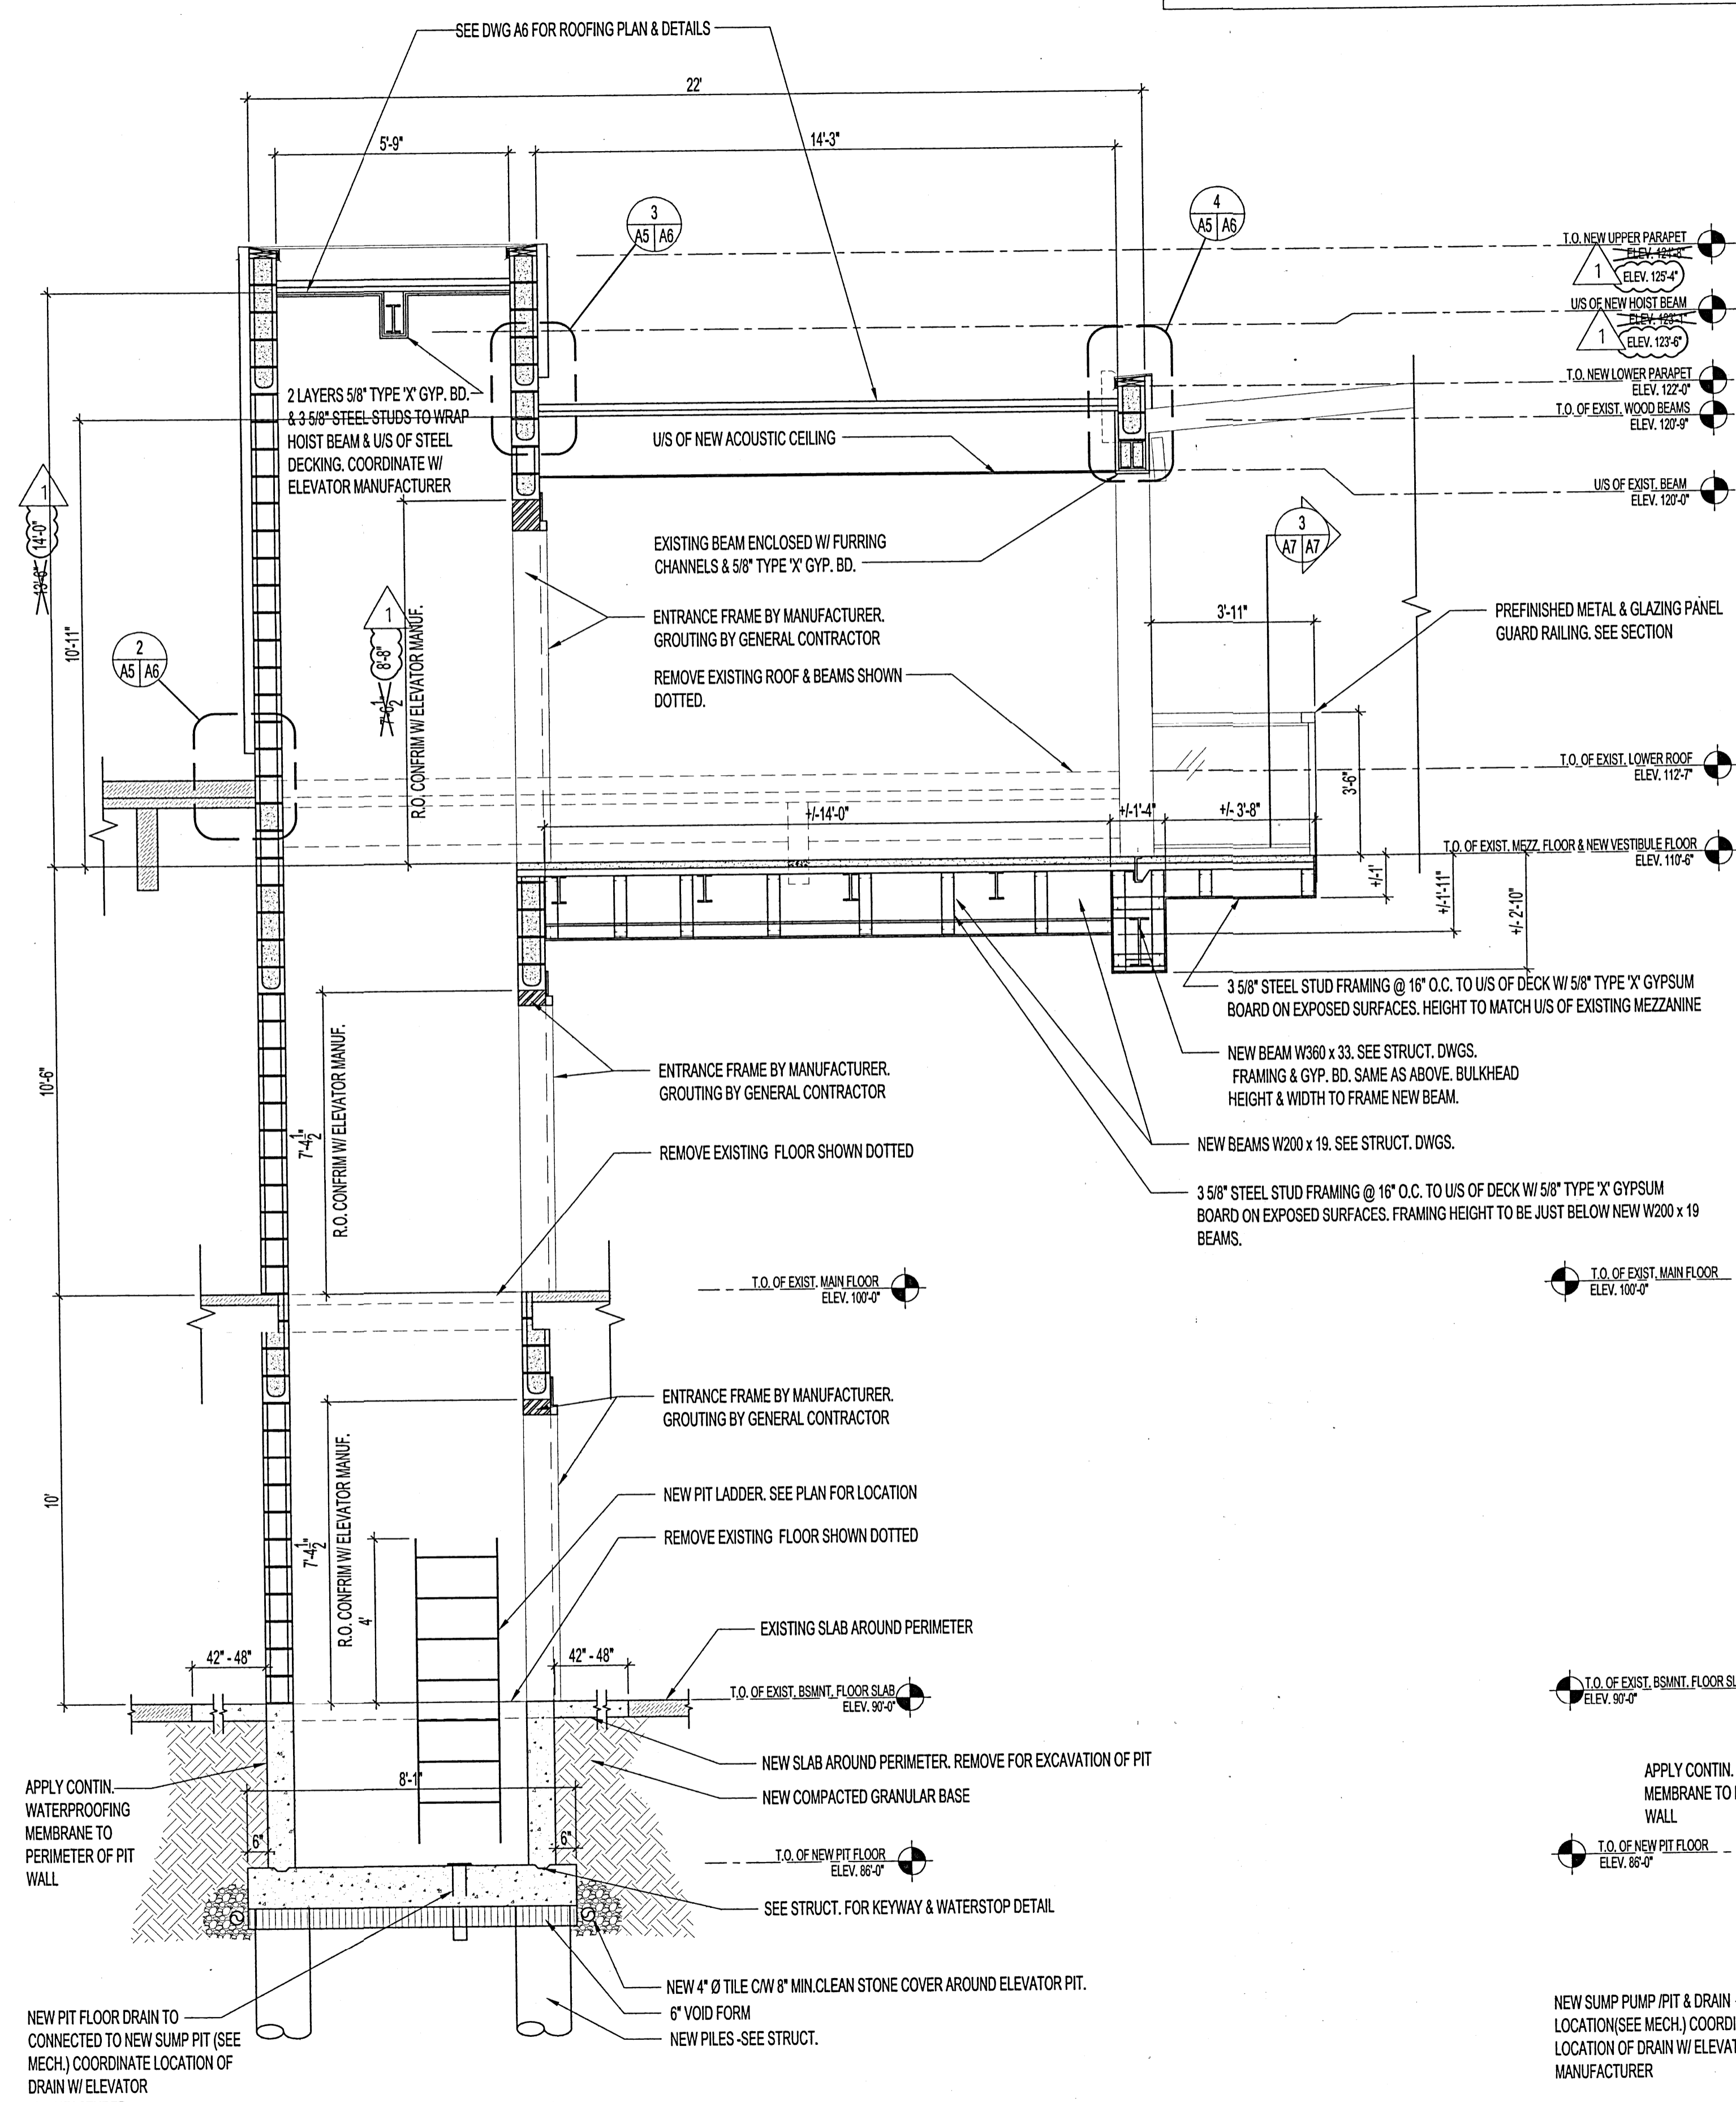

1 ELEVATOR SHAFT SECTION SCALE 3/8" = 1'-0"

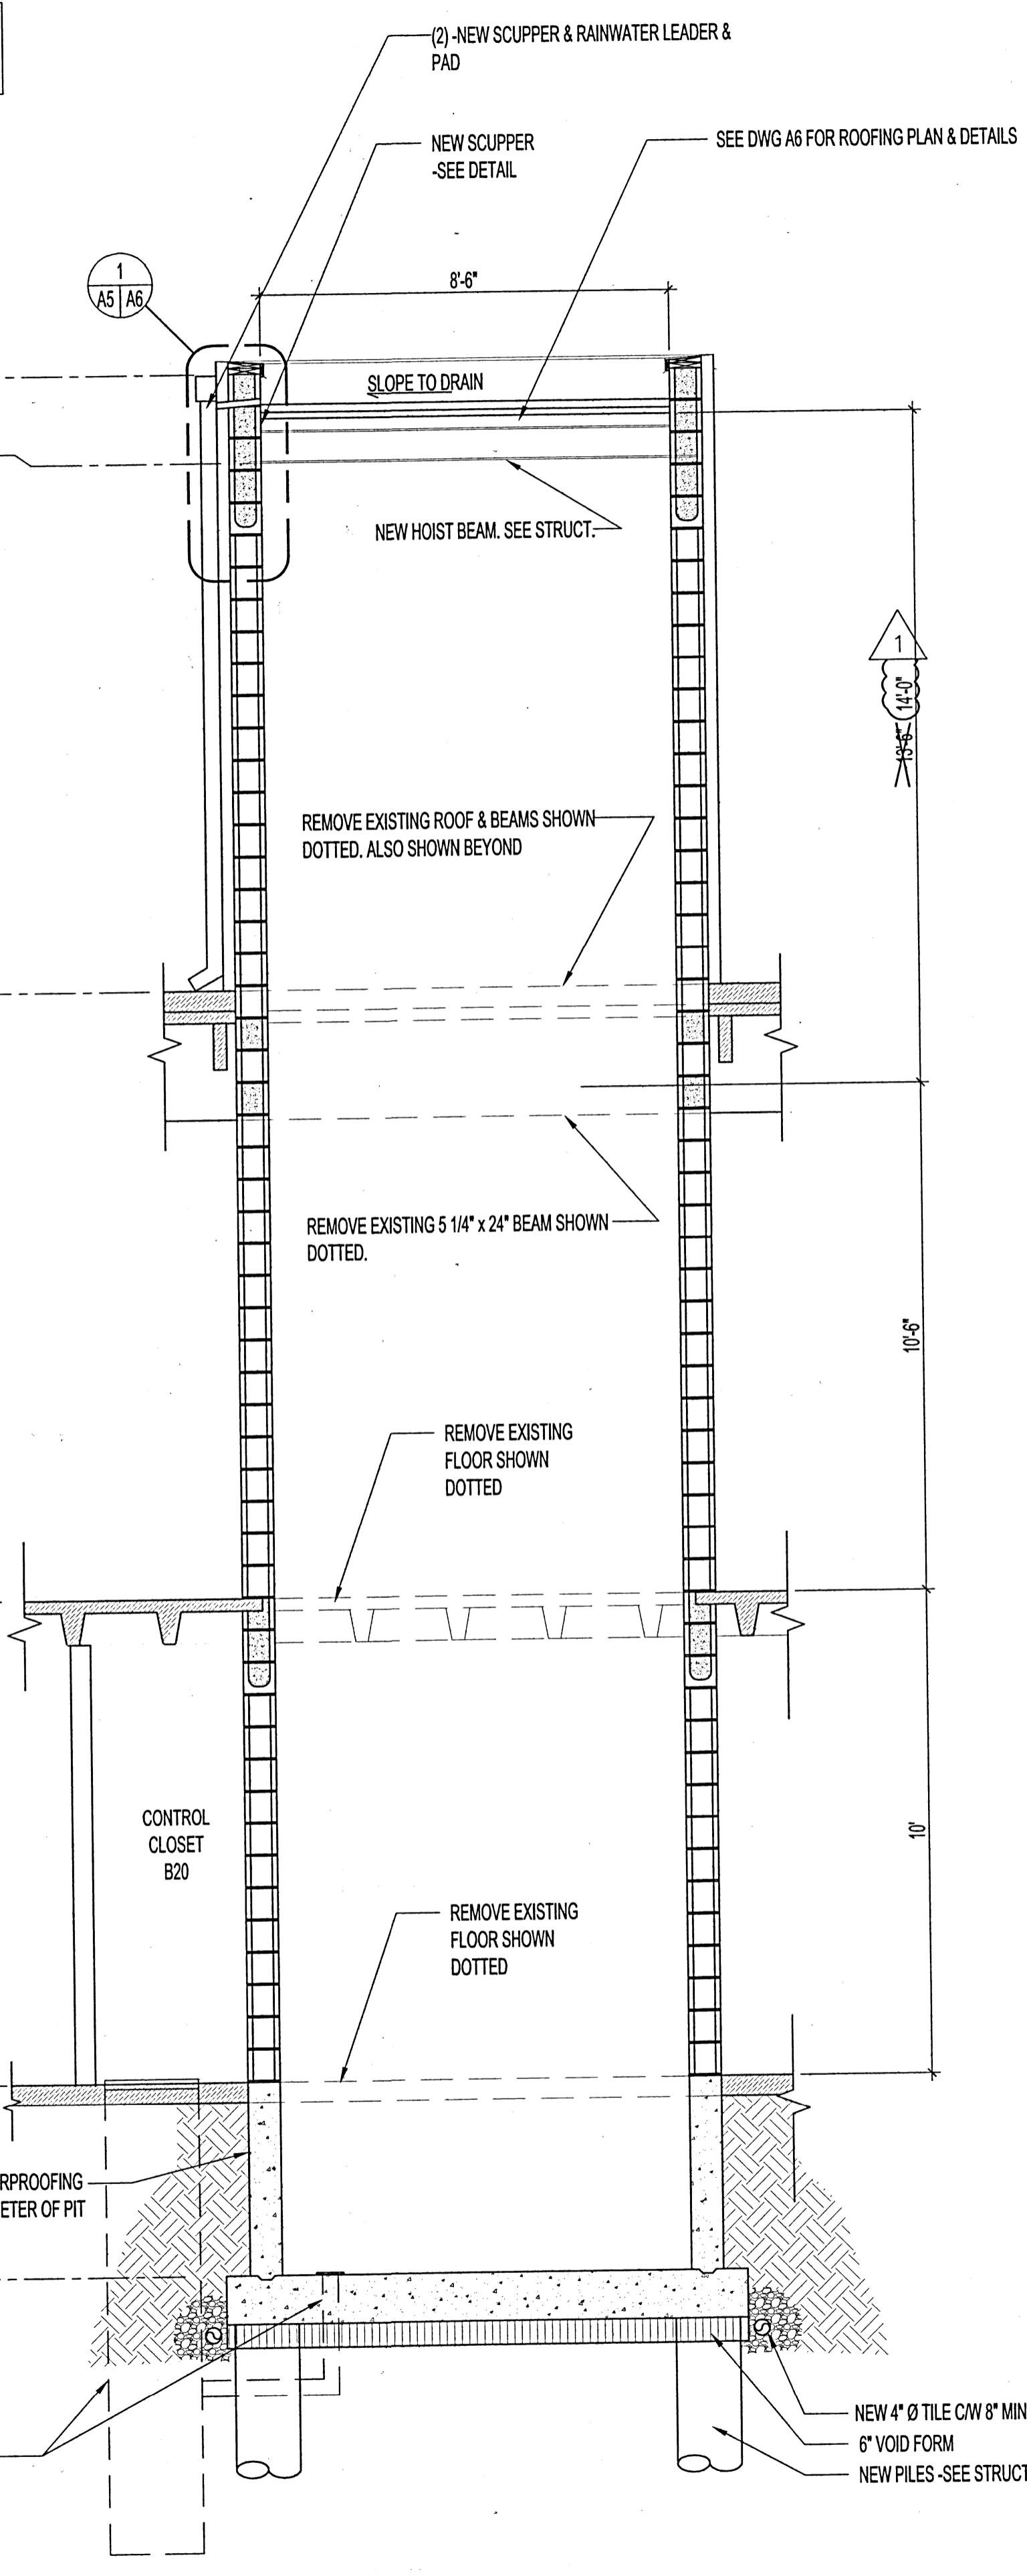

2 ELEVATOR SHAFT SECTION SCALE 3/8" = 1'-0"

1	-ELEVATOR DOOR R.O. HEIGHT REVISED ON MEZZANINE LEVEL.	MMK 2014.10.06
	-ELEVATOR (ELEVATIONS) ROOF & HOIST BEAM HEIGHTS REVISED	

No.	REVISION/DESCRIPTION	BY	DATE
SEAL			



DRAWN	CHKD	CHECKED	DESIGNED	APPROVED
DATE	2014.02.26	USER	APPROVAL	

THE CITY OF WINNIPEG
 PLANNING, PROPERTY AND
 DEVELOPMENT DEPARTMENT
 MUNICIPAL ACCOMMODATIONS DIVISION
 3-65 GARRY STREET, R3C 4K4

PROJECT
 ST. VITAL LIBRARY
 NEW ELEVATOR INSTALLATION

6 FERMOR AVENUE
 SHEET TITLE
 ELEVATOR SECTIONS

SCALE	PROJECT No:	SHEET No:
AS SHOWN		A5R1