


# South Area South East Snow Contract Alleys

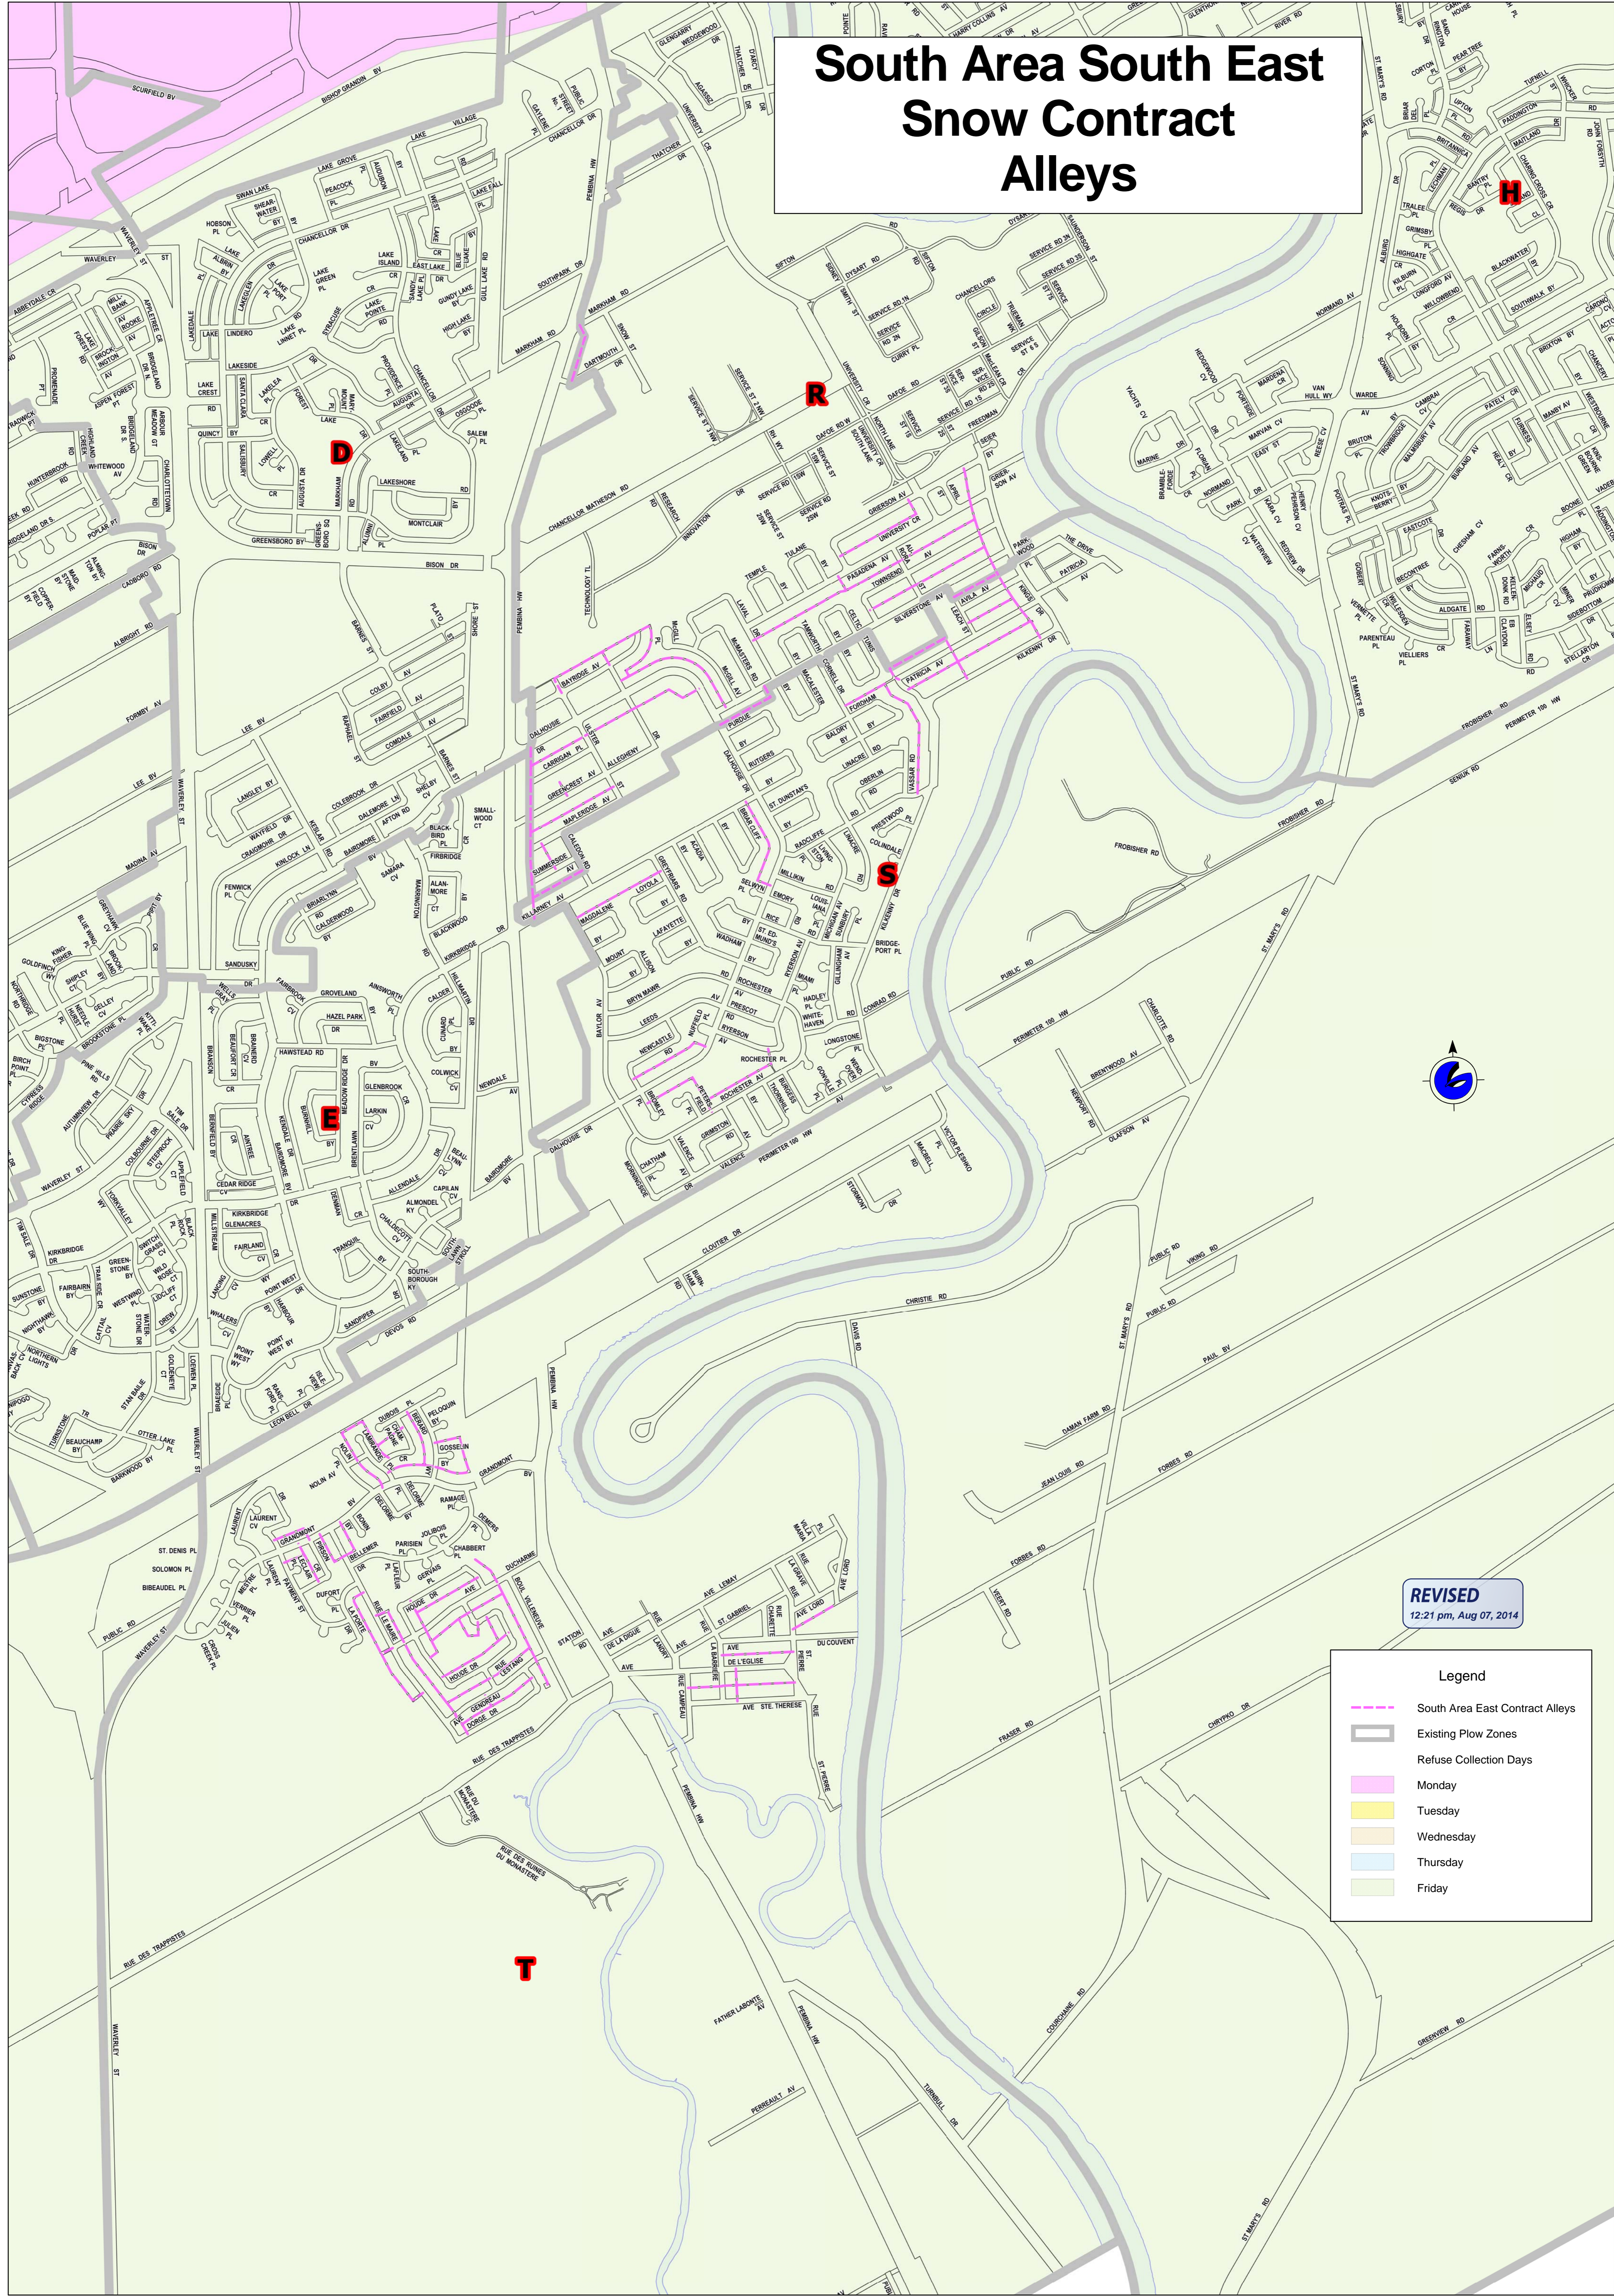

**REVISED**  
12:21 pm, Aug 07, 2014

**Legend**

- South Area East Contract Alleys
- Existing Plow Zones
- Refuse Collection Days
- Monday
- Tuesday
- Wednesday
- Thursday
- Friday