



File Name: P:\Projects\2013\13-0107-026-A-E40.1-40.2.dwg - Tab: E40.1 Plotted By: adereche 09/12/2014 [Fri 1:59pm]

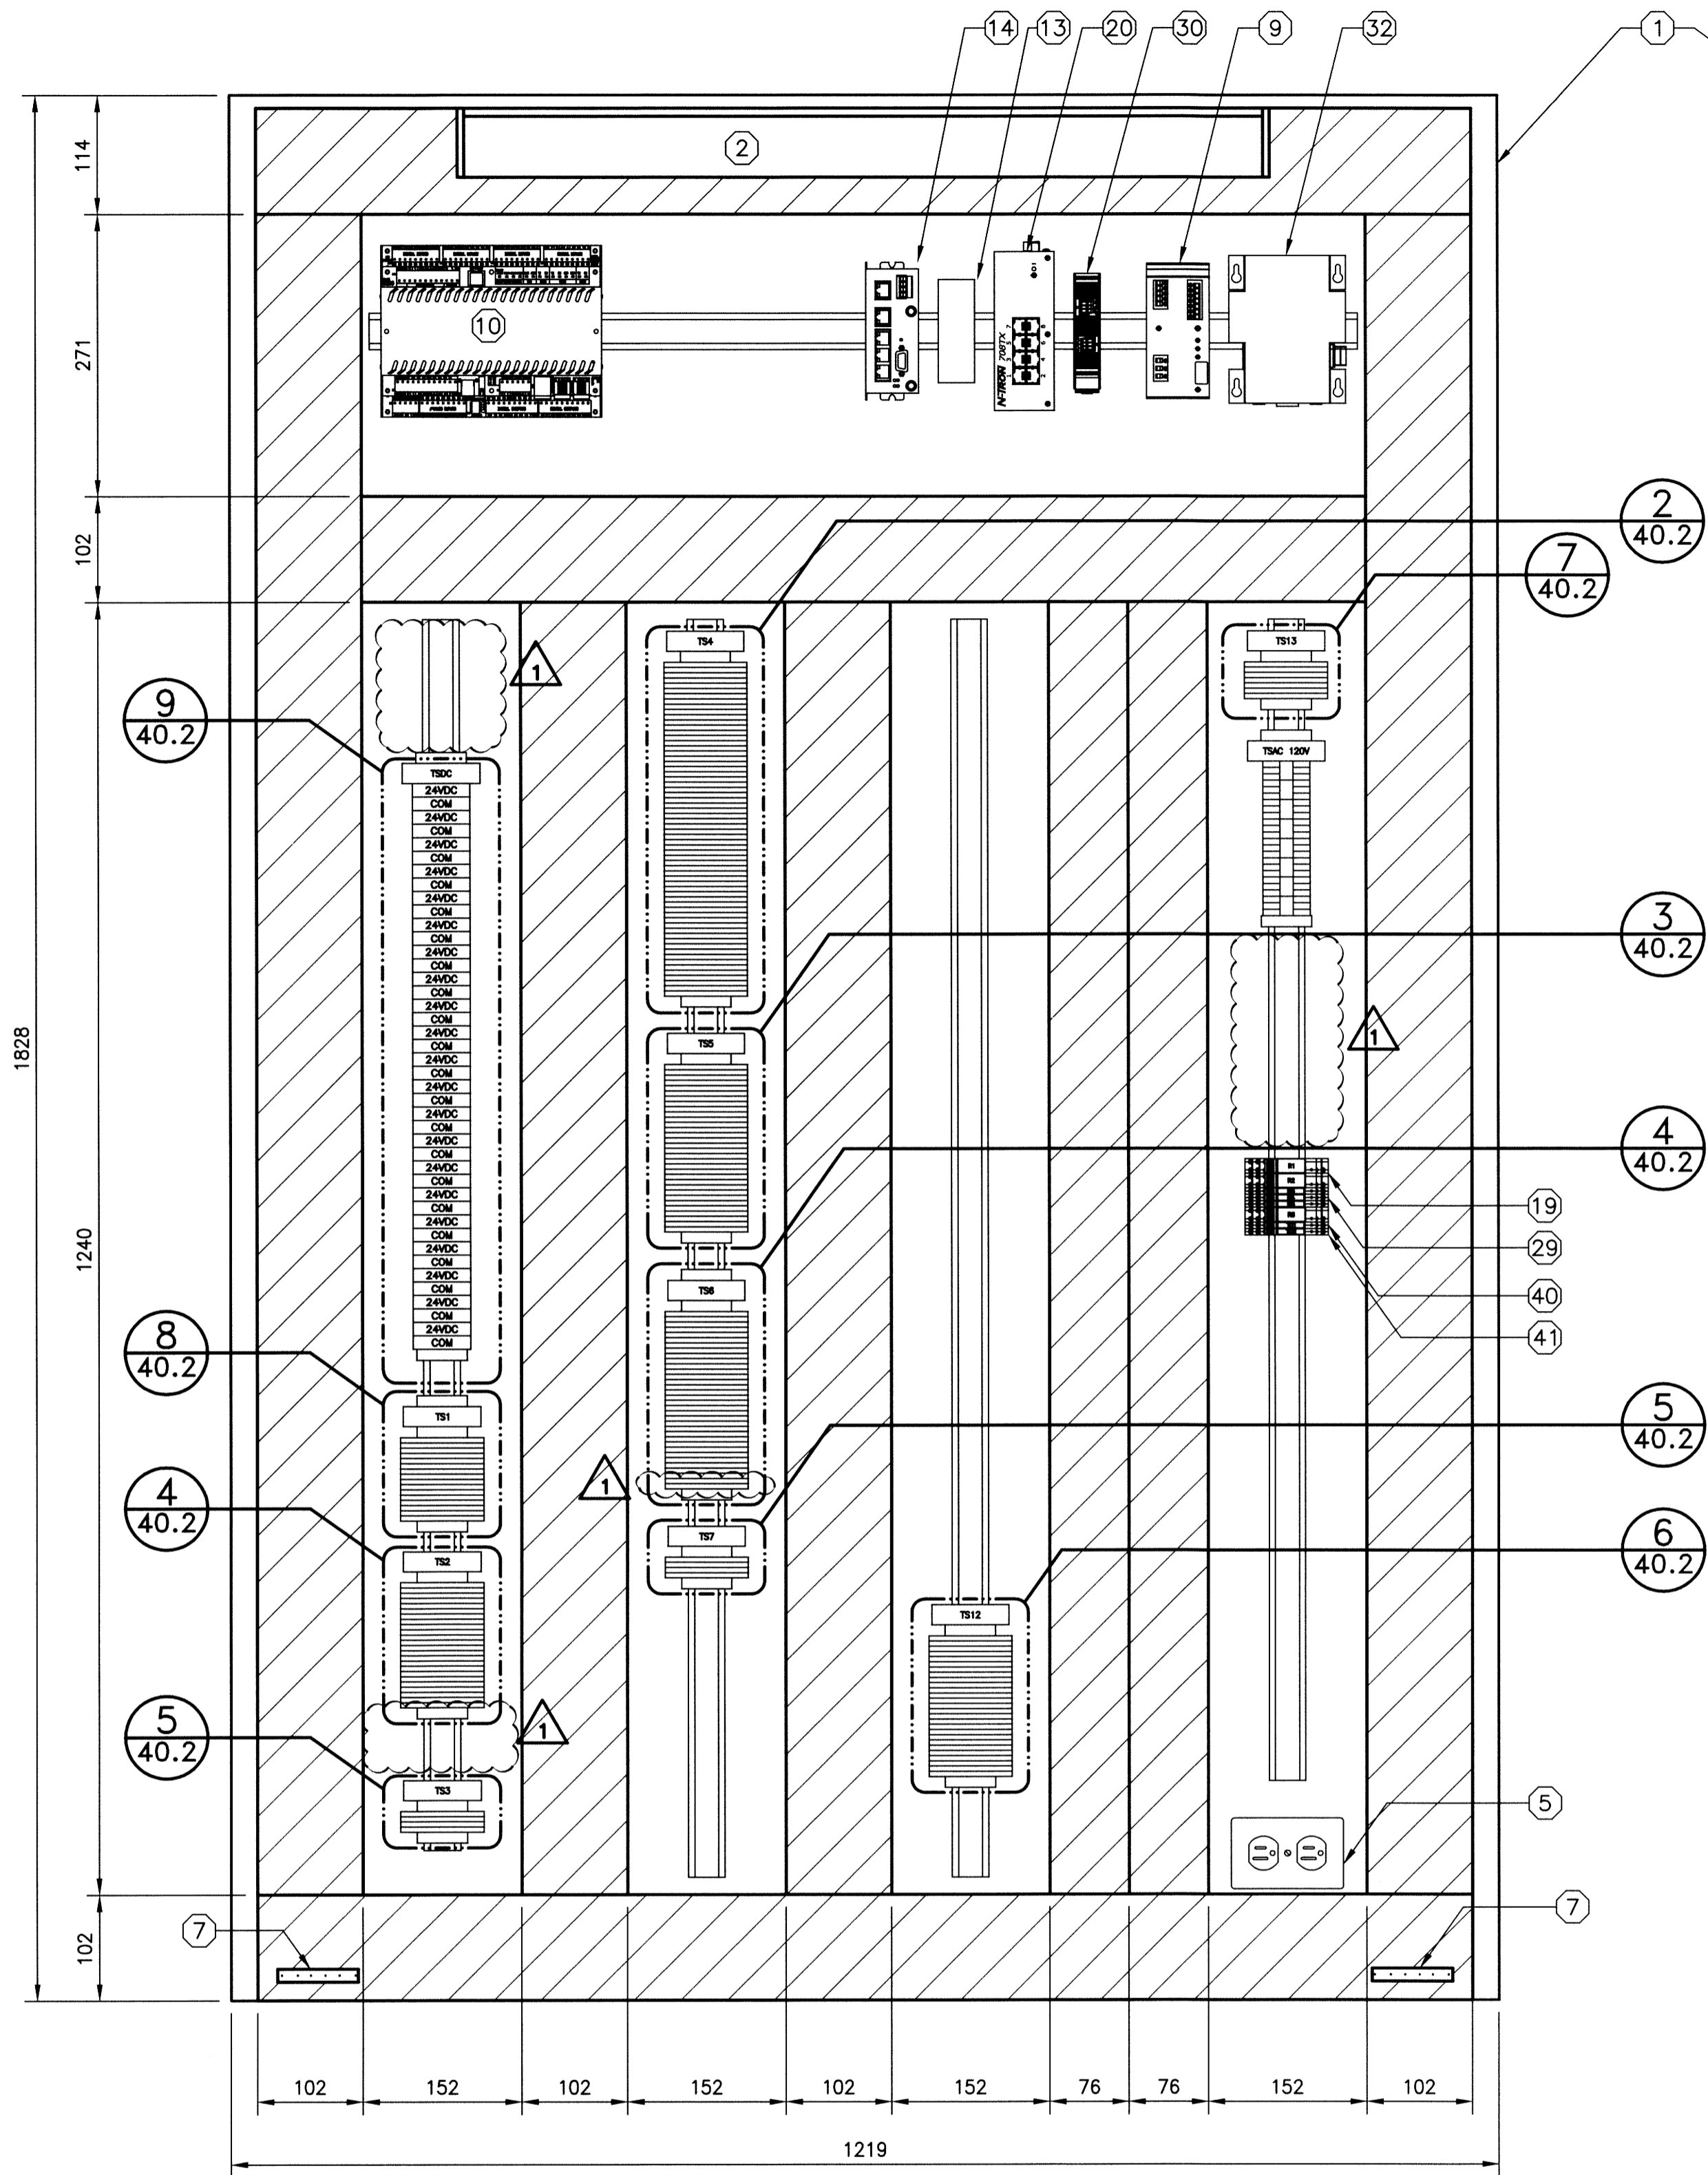

**1** ENCLOSURE AND DEVICE ARRANGEMENT  
SCALE: N.T.S.

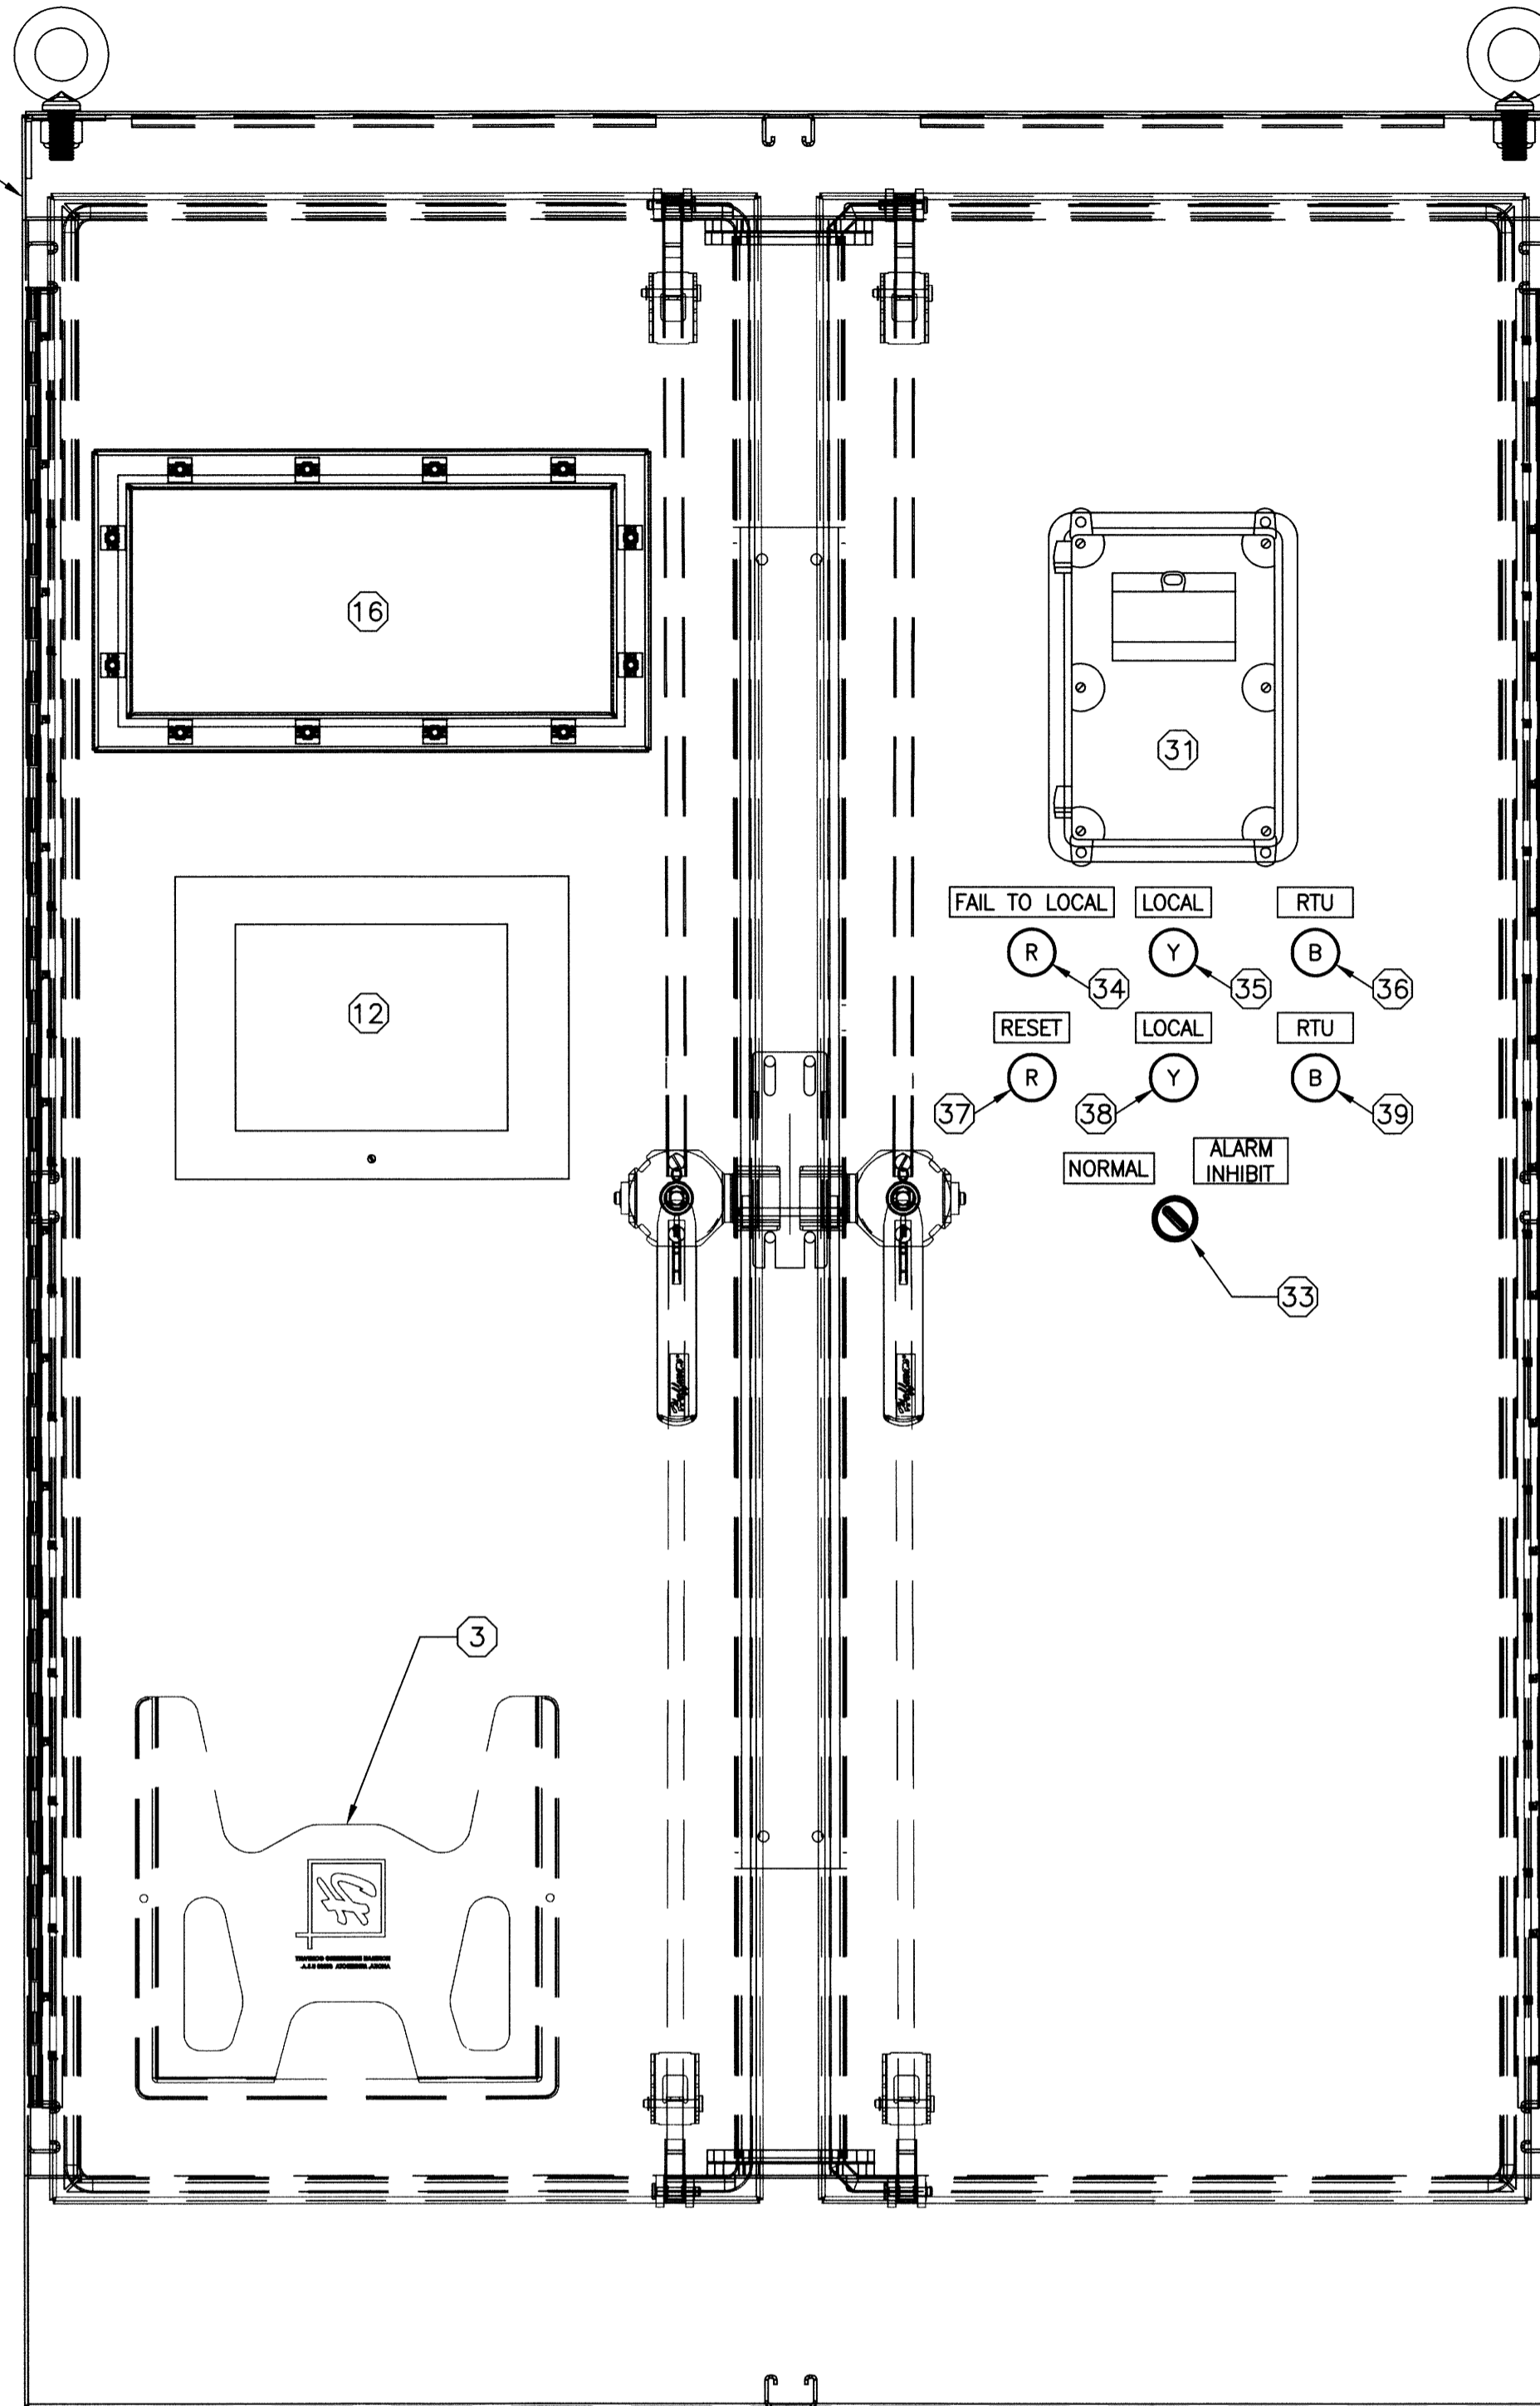

**2** ENCLOSURE AND DEVICE FRONT PANEL  
SCALE: N.T.S.

**NOTES:**

1. PROVIDE MOUNTING RAIL TO MAXIMUM AVAILABLE LENGTH.
2. REMOVE PORTIONS OF WIRE DUCT SIDEWALL TO ALLOW ENTRY OF FIELD CABLES FROM PANEL SIDES.



NO.	REVISIONS	DATE	BY
1	RE-ISSUED FOR CONSTRUCTION	14/09/11	AP
0	ISSUED FOR CONSTRUCTION	14/08/18	AP

DESIGNED BY	DDW/MAM	CHECKED BY	[Signature]
DRAWN BY	GCN	APPROVED BY	[Signature]
HOR. SCALE	N.T.S.	RELEASED FOR CONSTRUCTION	
VERTICAL	N.T.S.		
DATE	2014 04 04	DATE	

ENGINEER'S SEAL

A-E40.1

**THE CITY OF WINNIPEG**  
WATER AND WASTE DEPARTMENT

FLOOD PUMPING STATION UPGRADES  
ASSINIBOINE STATION  
**ELECTRICAL**  
RTU PANEL ENCLOSURE  
120VAC POWER AND FUSE DISTRIBUTION

SHEET 1 OF 2  
CITY DRAWING NUMBER  
1-0115F-E0019-001