


FROM TSDC-FU11  
24 VDC  
(NOTE 1)


FROM TSDC-FU12  
24 VDC  
(NOTE 1)

P:\Projects\2013\13-0107-026-M-E34.1.dwg - Tab: E34.1 Plotted By: dderoche 09/12/2014 [Fri 1:57pm]

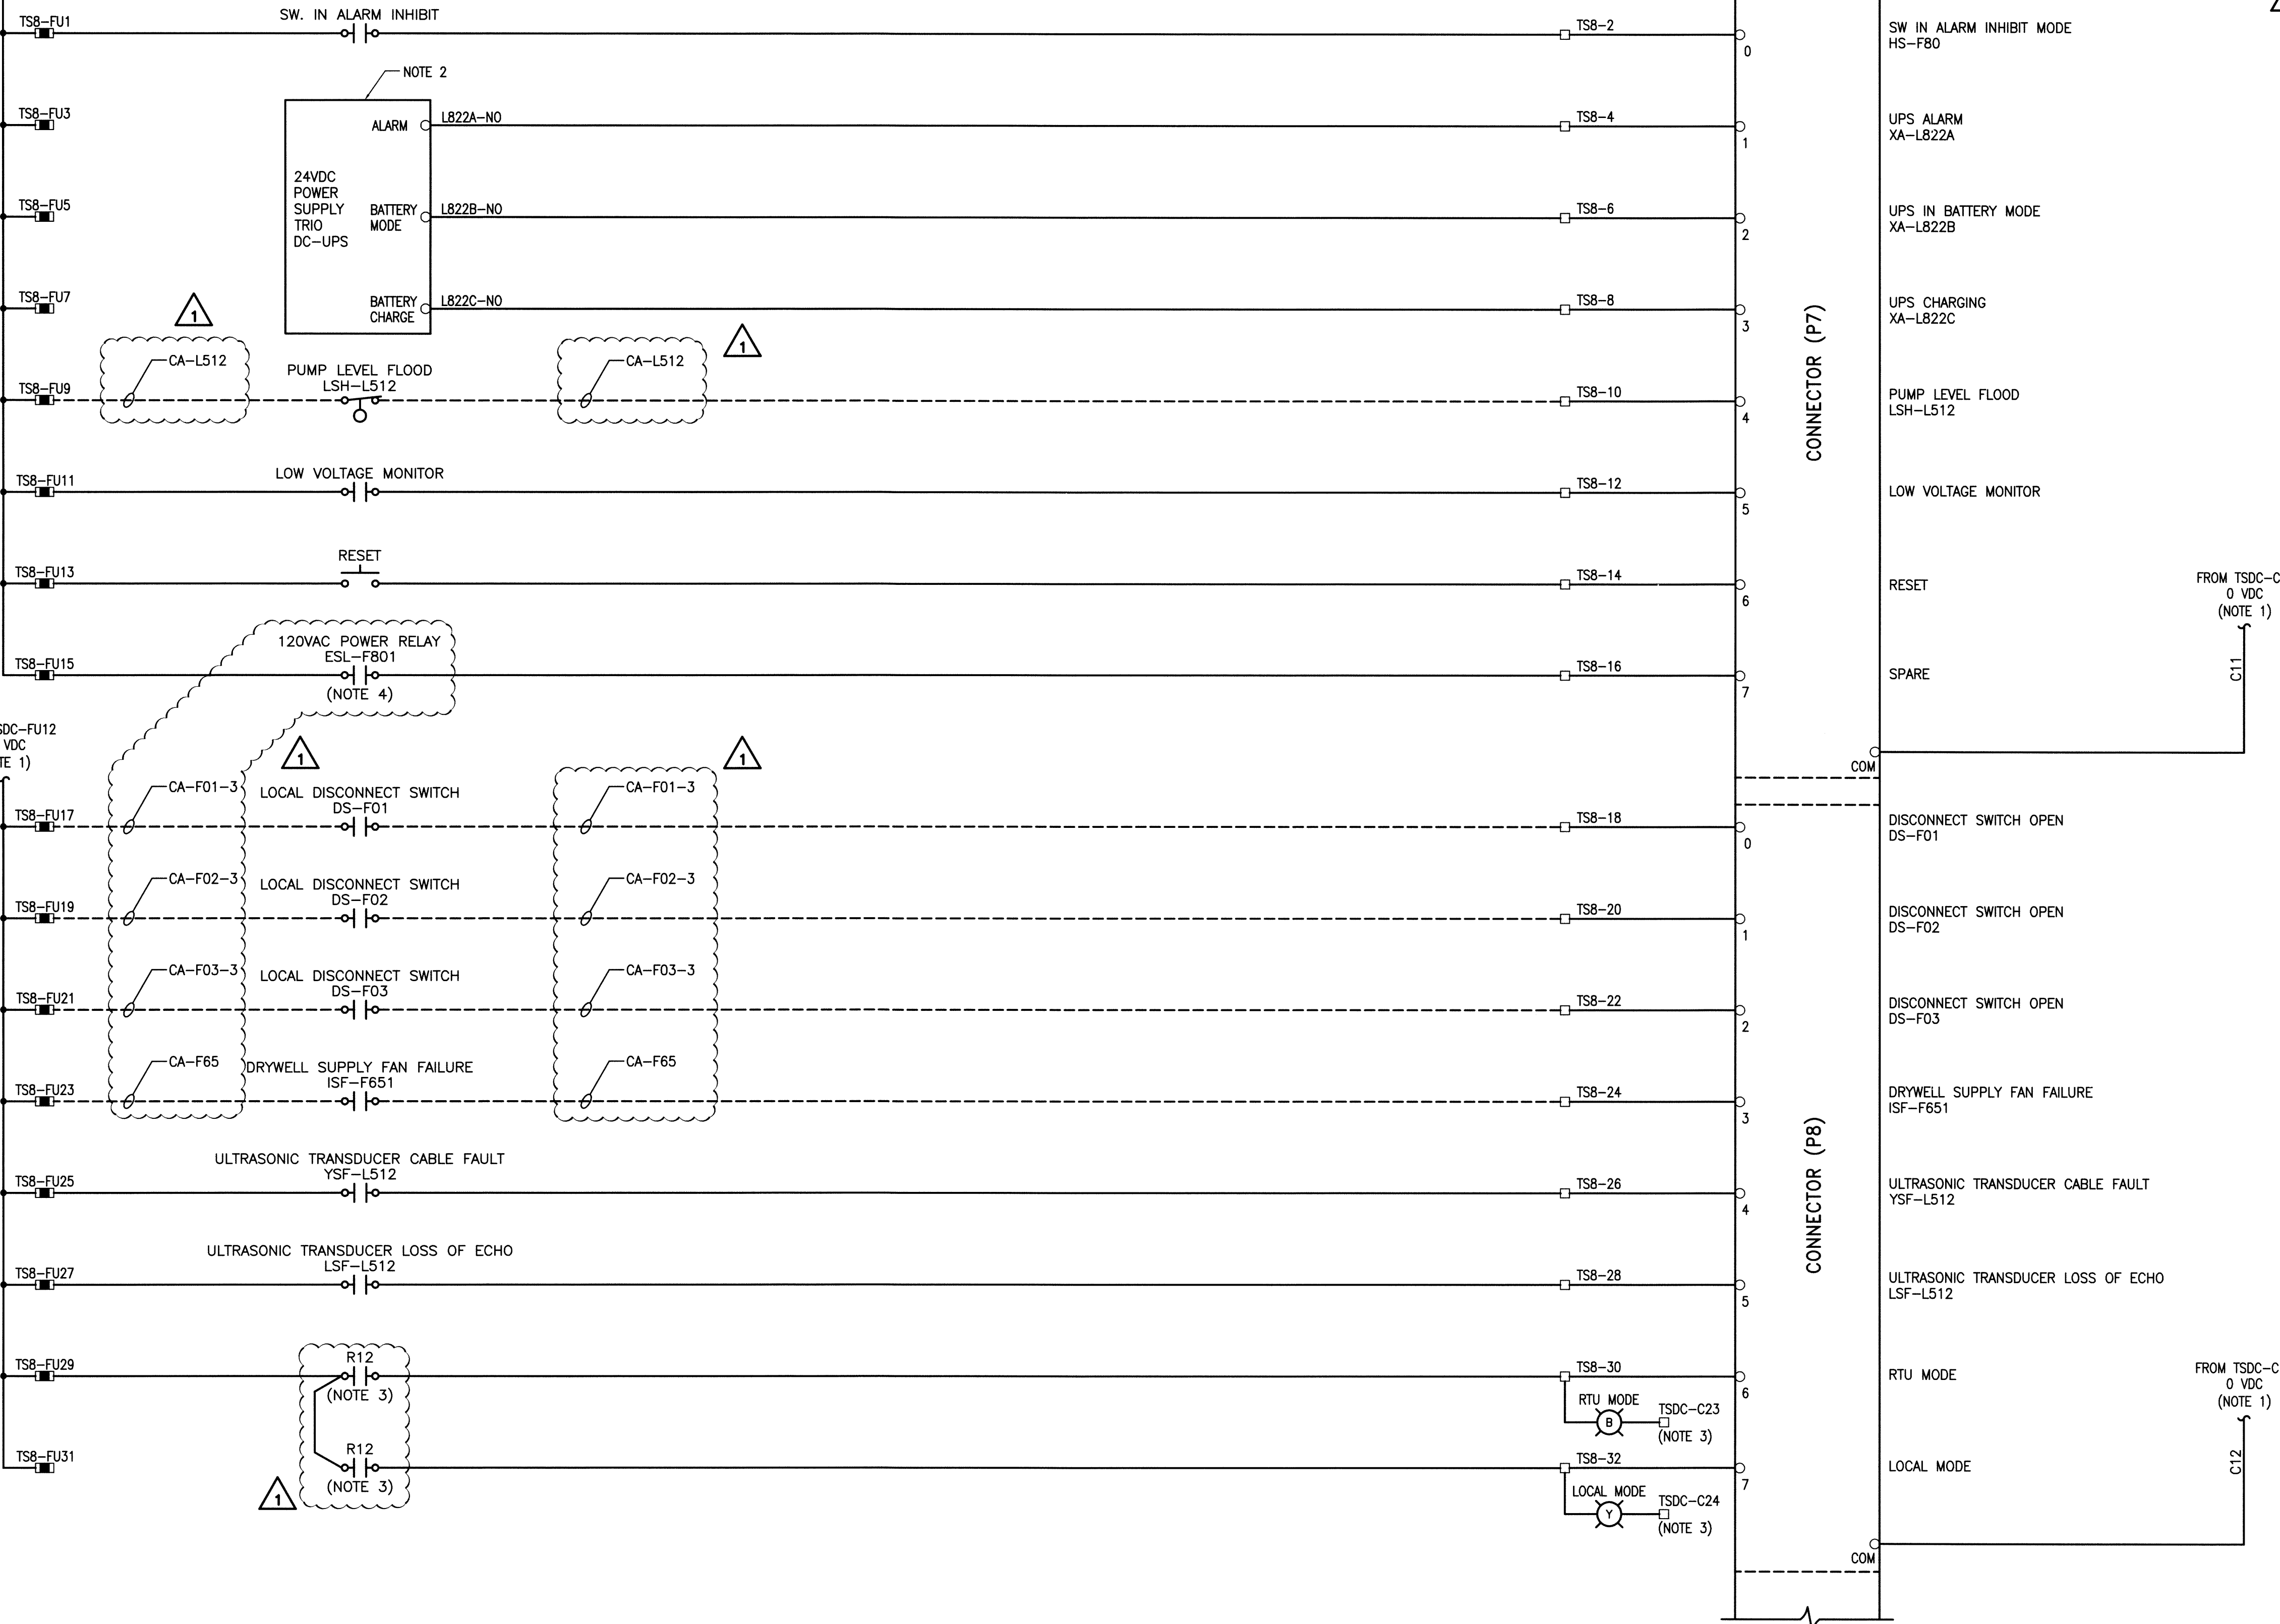

- NOTES:**
1. REFER TO DRAWING 1-0159F-E0011-001 (M-E21.1) FOR ADDITIONAL DETAILS.
  2. REFER TO DRAWING 1-0159F-E0012-001 (M-E22) FOR ADDITIONAL DETAILS.
  3. REFER TO DRAWING 1-0159F-E0011-002 (M-E21.2) FOR ADDITIONAL DETAILS.
  4. REFER TO DRAWING 1-0159F-E0010-001 (M-E20) FOR ADDITIONAL DETAILS.

- LEGEND:**
- PANEL WIRING
  - FIELD WIRING
  - RTU TERMINAL
  - FUSED TERMINAL

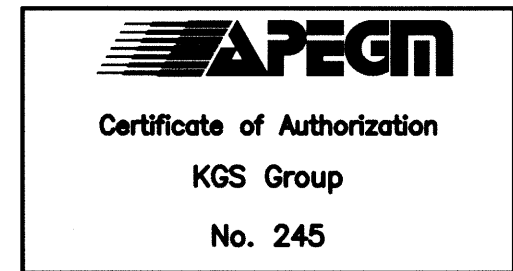

NO.	REVISIONS	DATE	BY
1	RE-ISSUED FOR CONSTRUCTION	14/09/11	AP
0	ISSUED FOR CONSTRUCTION	14/08/18	AP

**KGS GROUP**  
CONSULTING ENGINEERS

DESIGNED BY: DDW/MAM  
DRAWN BY: GCN  
HQR SCALE: N.T.S.  
VERTICAL

CHECKED BY: [Signature]  
APPROVED BY: [Signature]  
RELEASED FOR CONSTRUCTION

2014 01 17

ENGINEER'S SEAL

M-E34.1

**THE CITY OF WINNIPEG**  
WATER AND WASTE DEPARTMENT

FLOOD PUMPING STATION UPGRADES  
MARION STATION  
**ELECTRICAL**  
RTU PANEL - 5606 I/O BOARD NO.2  
DISCRETE INPUTS

SHEET 1 OF 2  
CITY DRAWING NUMBER  
1-0159F-E0021-001