



FILE NAME: 14-0107-021_B18.dwg DATE: 2014.10.27 PROJECT No: 2013-173 SHEET TITLE: SECTIONS - RENOVATED ADDRESS: 381 SHERBROOK STREET

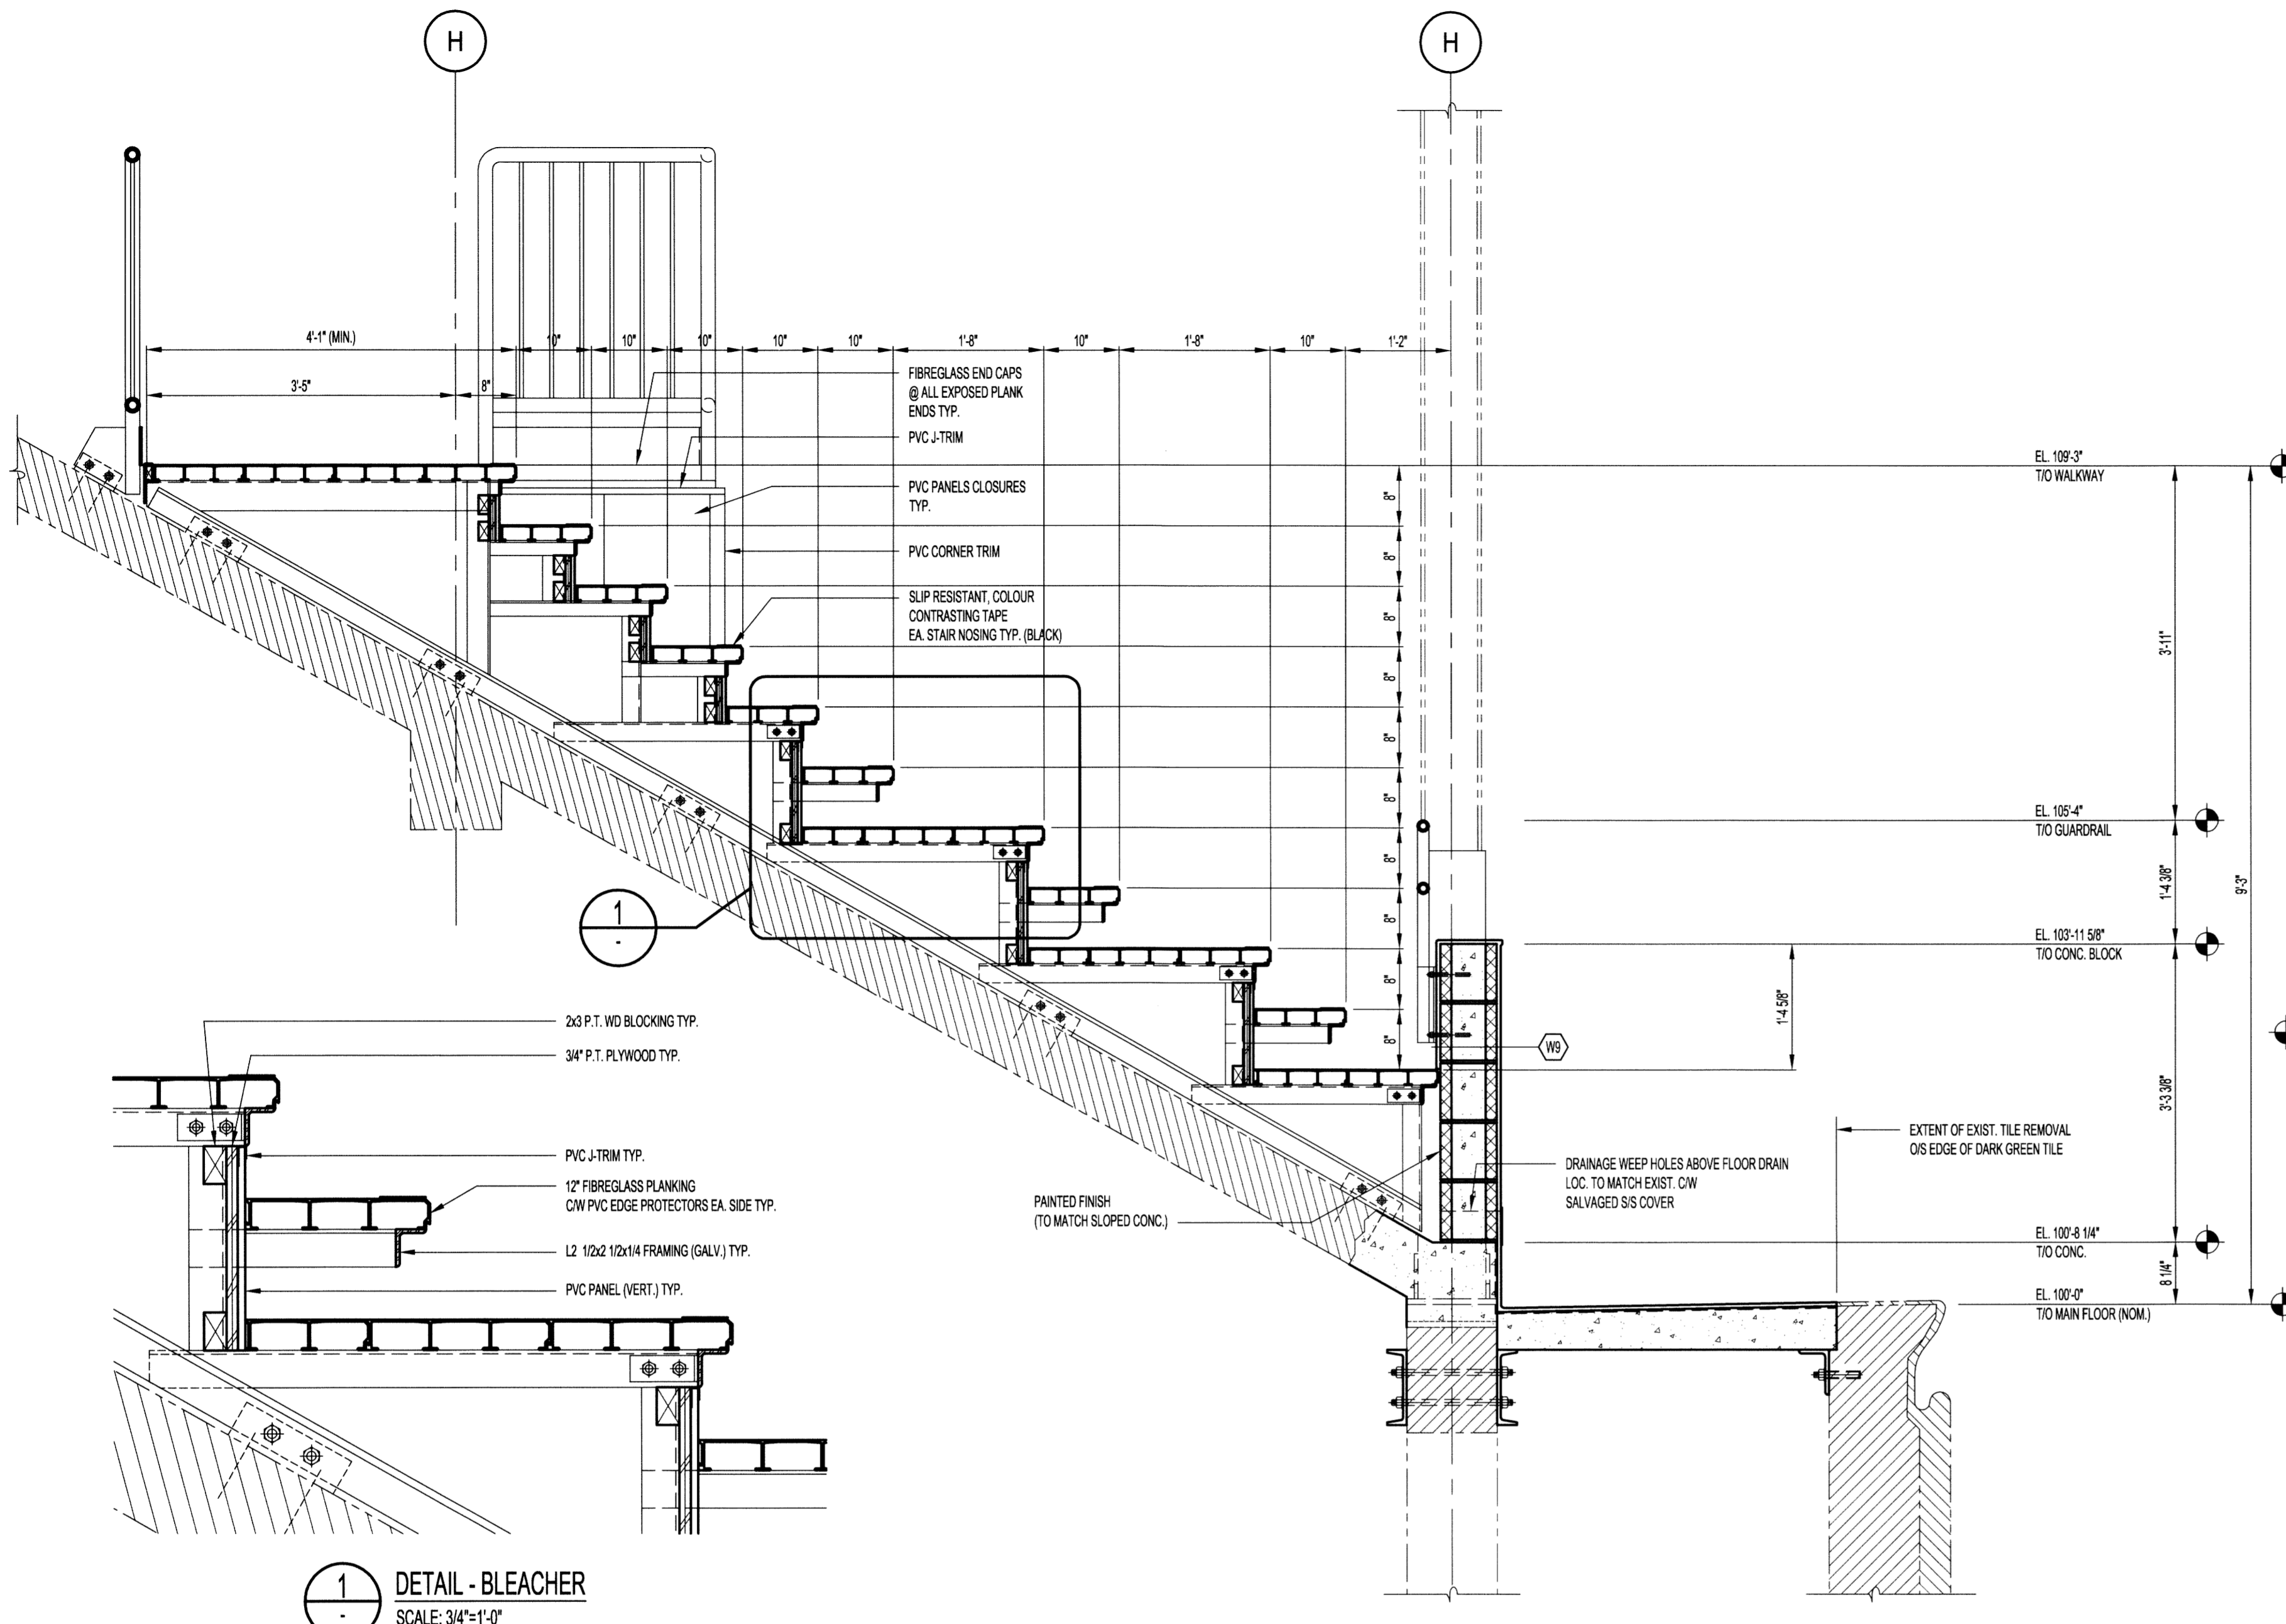


1 DETAIL - BLEACHER
SCALE: 3/4"=1'-0"

A SECTION - BLEACHER STAIRS - RENOVATED
SCALE: 3/4"=1'-0"

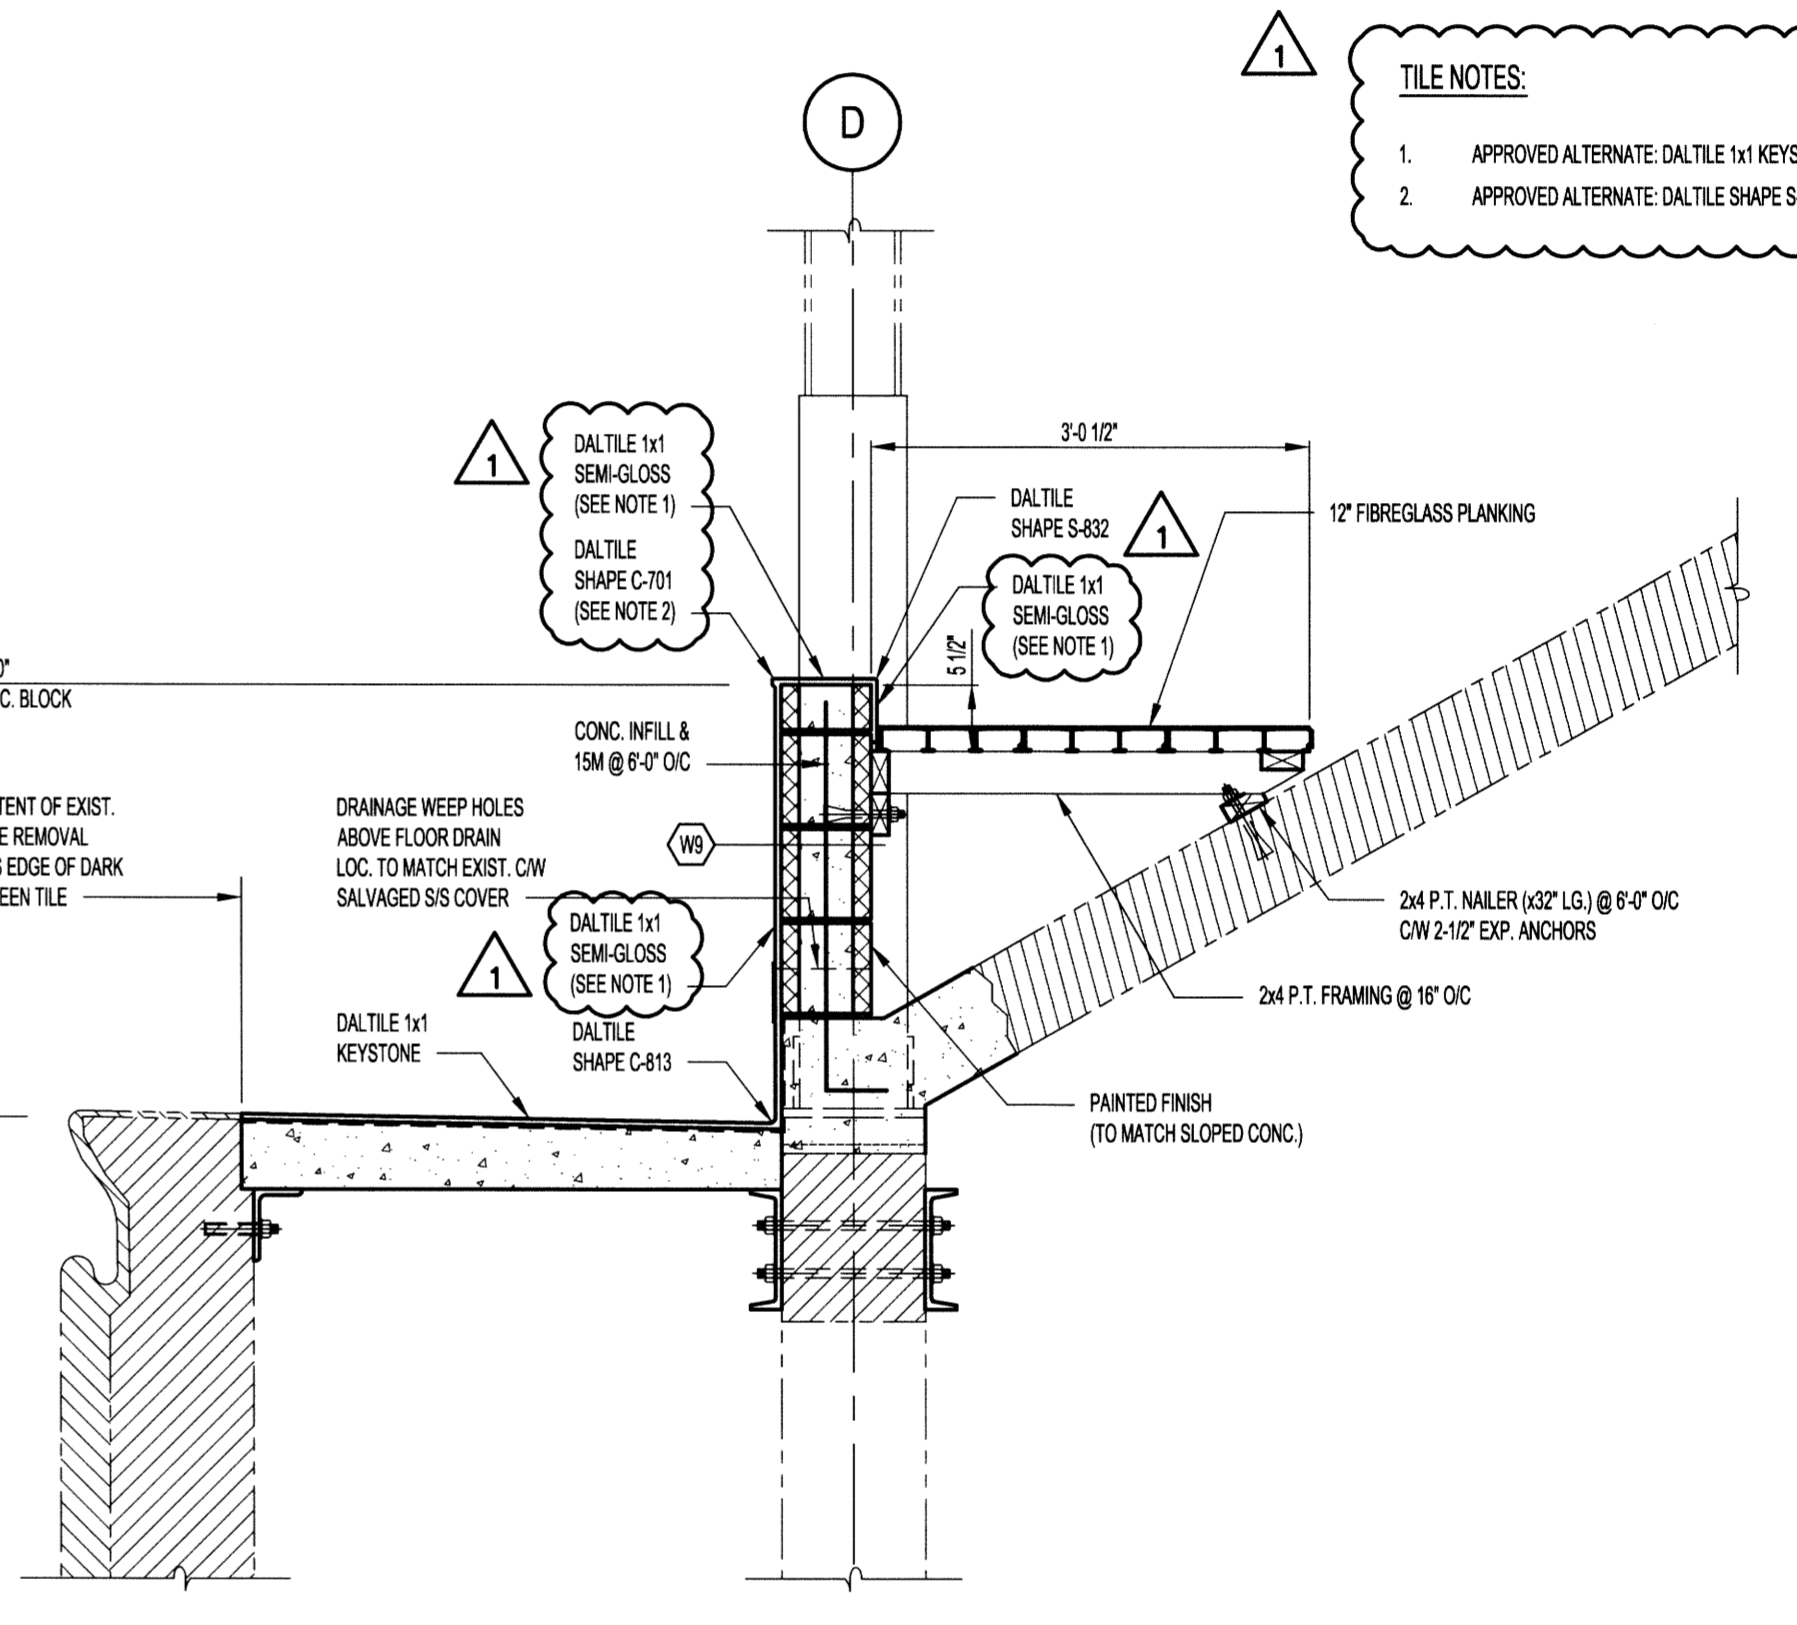


B SECTION - POOL STORAGE PLATFORM - RENOVATED
SCALE: 3/4"=1'-0"

TILE NOTES:
1. APPROVED ALTERNATE: DAL TILE 1x1 KEYSTONE
2. APPROVED ALTERNATE: DAL TILE SHAPE S-832

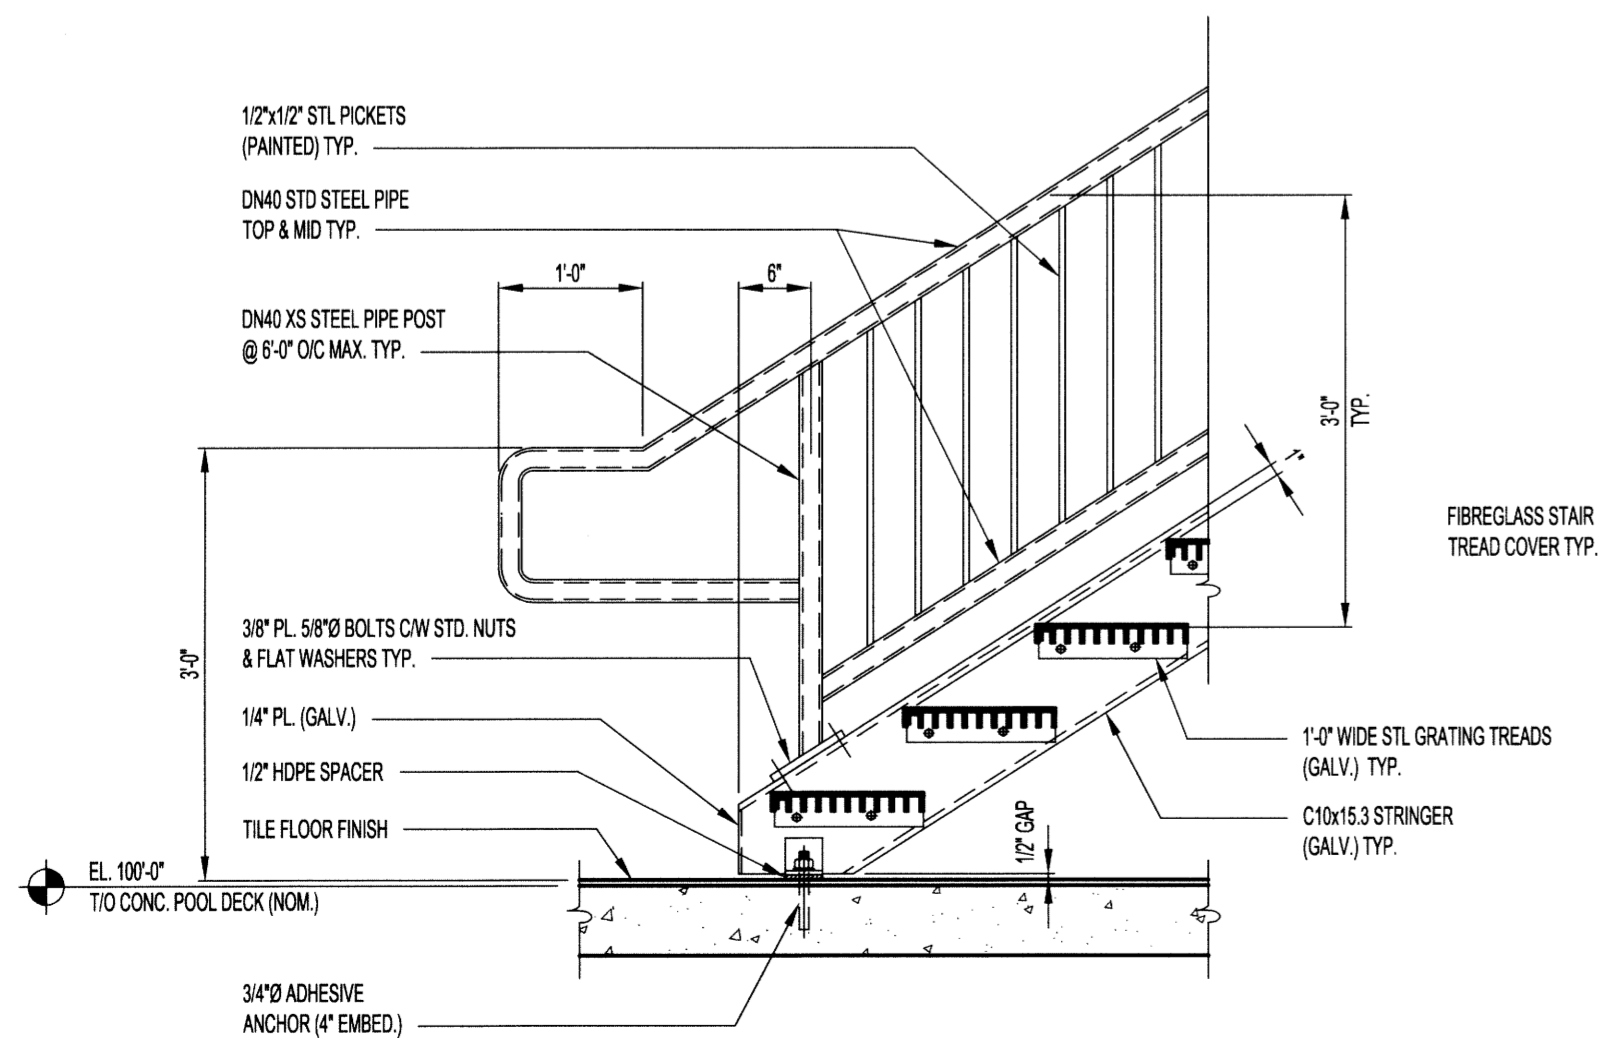

C SECTION - STAIRS - RENOVATED
SCALE: 3/4"=1'-0"

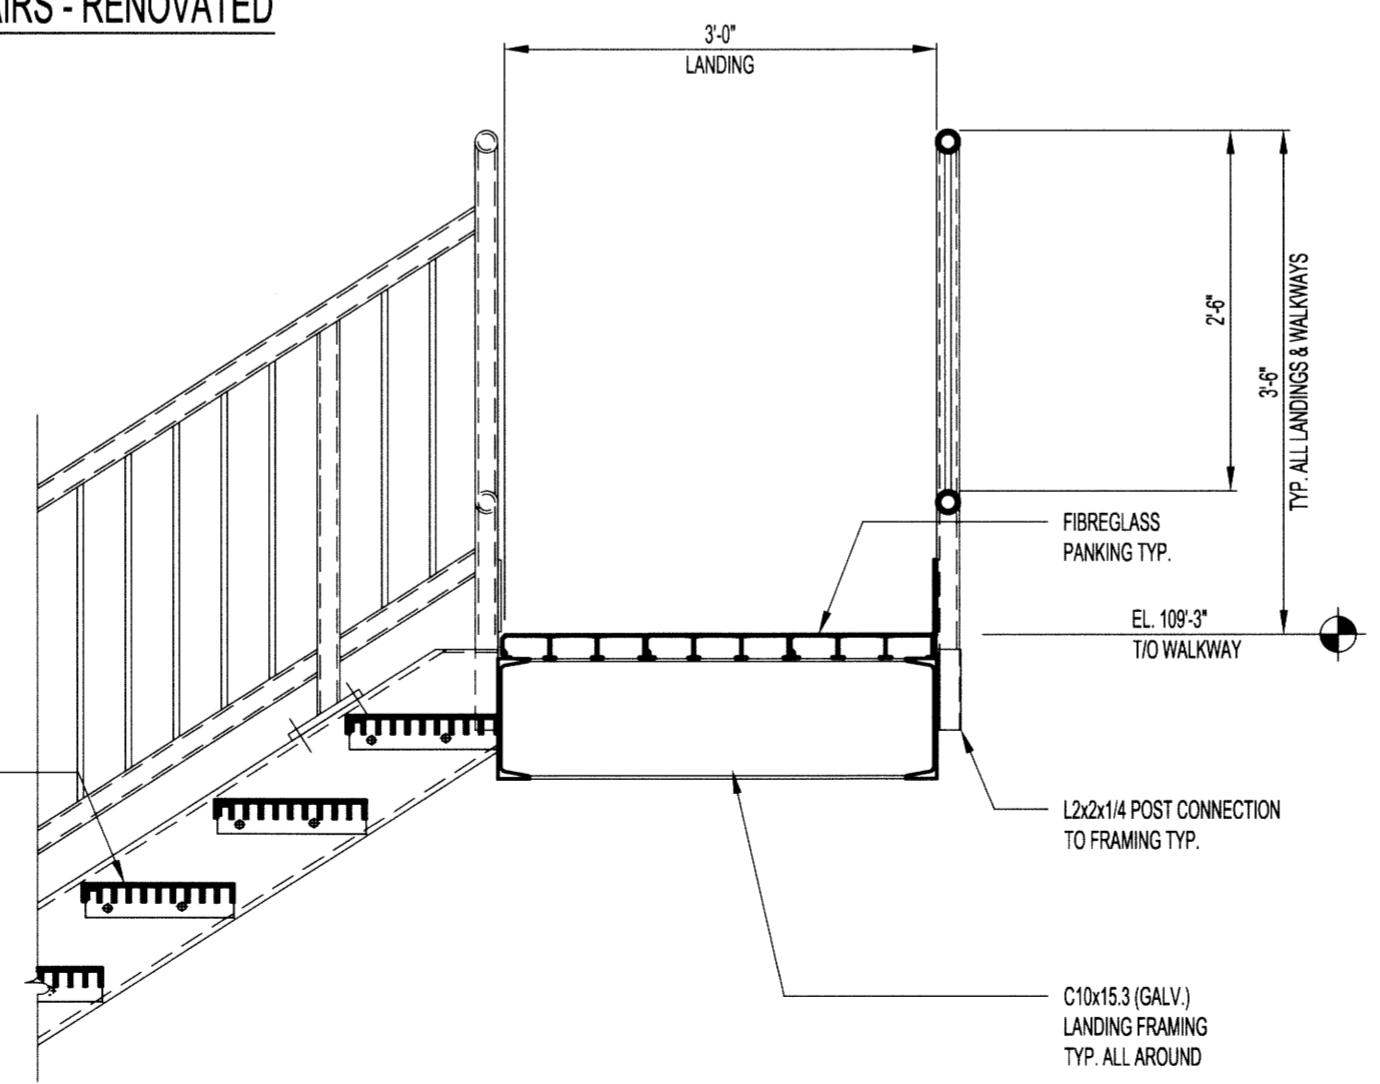

D SECTION - STAIRS - RENOVATED
SCALE: 3/4"=1'-0"

NOTES:
THESE DRAWINGS SHALL NOT BE SCALED.
THE CONTRACTOR SHALL VISIT THE SITE AND SATISFY ONESELF ALL DIMENSIONS, DATUM, AND DETAILED INFORMATION SHOWN ARE CORRECT.
THE CONTRACTOR IS TO REVIEW AND COORDINATE ALL ARCHITECTURAL, MECHANICAL, ELECTRICAL AND STRUCTURAL DRAWINGS FOR ADDITIONAL OPENINGS THROUGH FLOORS, WALLS, AND CEILINGS FOR DUCT, PIPE & ELECTRICAL RISERS AND ALL OPENINGS NOT SHOWN ON DRAWINGS.
ALL OPENINGS THROUGH FIRE ASSEMBLIES ARE TO BE FIRE STOPPED AND SEALED WITH U.L.C. APPROVED FIRE STOPPING TO MAINTAIN THE INTEGRITY OF THE FIRE SEPARATION, AND PROVIDE A SMOKE-TIGHT BARRIER.
ALL PRODUCTS AND MATERIALS TO BE USED AND INSTALLED SHALL CONFORM WITH MANUFACTURER'S SPECIFICATIONS & APPLICABLE CODES.
THE CONTRACTOR SHALL BE RESPONSIBLE TO PATCH AND MAKE GOOD ALL EXISTING CONSTRUCTION AFFECTED BY THE REMOVAL OF ALL ITEMS FORMING THE PART OF THE RENOVATION WORK.
WHERE NEW FLOORING AND BASE IS TO BE INSTALLED IN EXISTING AREAS (REFER TO FLOOR PLAN AND ROOM SCHEDULE) THE EXISTING FLOORING SURFACE AND BASE MUST BE REMOVED, UNLESS OTHERWISE NOTED. ALL FLOOR SURFACES SHALL BE PREPARED IN ACCORDANCE TO MANUFACTURER'S RECOMMENDATIONS FOR INSTALLATION OF NEW FLOOR.
WHERE PAINTING OF EXISTING WALLS IS INDICATED ON THE ROOM SCHEDULE, THESE WALLS MUST BE CLEANED OF ANY EXISTING WALL COVERING, PATCHED & PREPARED TO ACCEPT NEW MATERIAL, UNLESS OTHERWISE NOTED.

No.	REVISION/DESCRIPTION	BY	DATE
1	RE-ISSUED FOR CONSTRUCTION	RJL	15.03.13
0	ISSUED FOR CONSTRUCTION	RJL	15.02.17



DATE	USER	APPROVAL
2014.10.27		

THE CITY OF WINNIPEG
PLANNING, PROPERTY AND
DEVELOPMENT DEPARTMENT
MUNICIPAL ACCOMMODATIONS DIVISION
3-65 GARRY STREET, R3C 4K4

PROJECT
**SHERBROOK POOL
REFURBISHMENT OF SHERBROOK POOL**

381 SHERBROOK STREET
SHEET TITLE

**BUILDING
SECTIONS
RENOVATED**

SCALE AS SHOWN PROJECT No: 2013-173 SHEET No: **B18**

