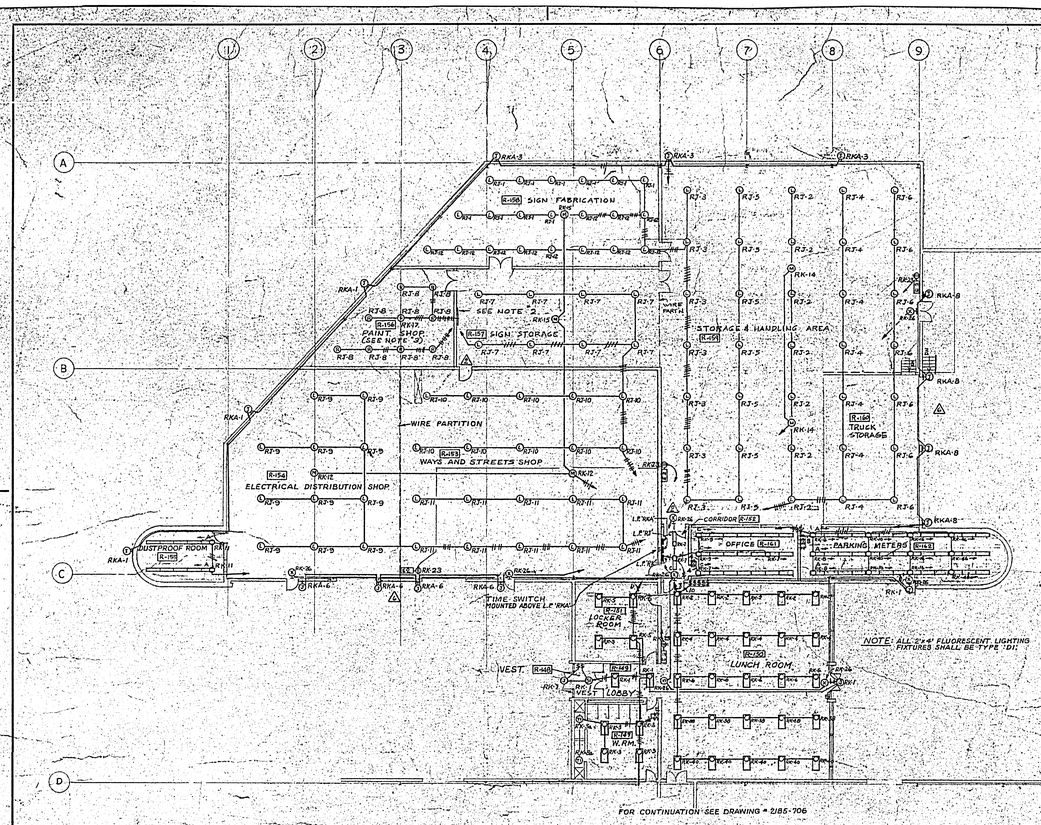

LIGHTING SCALE 1/16=1'-0"

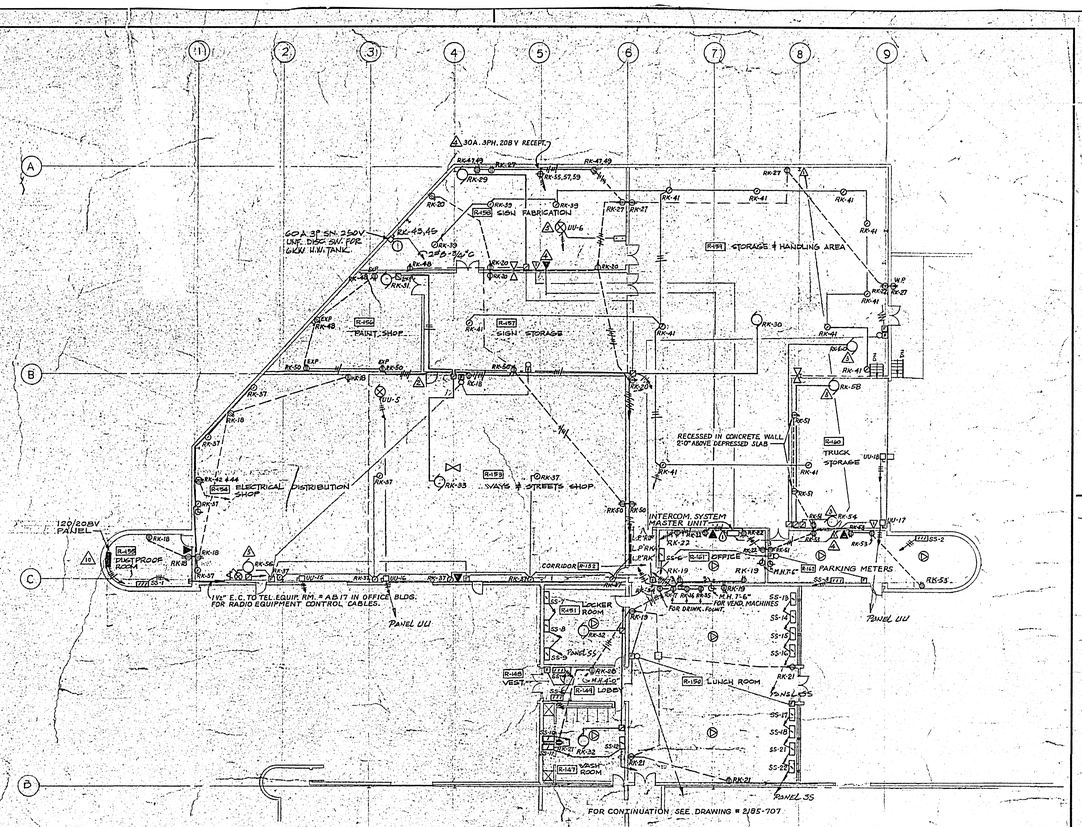

POWER SCALE 1/16=1'-0"

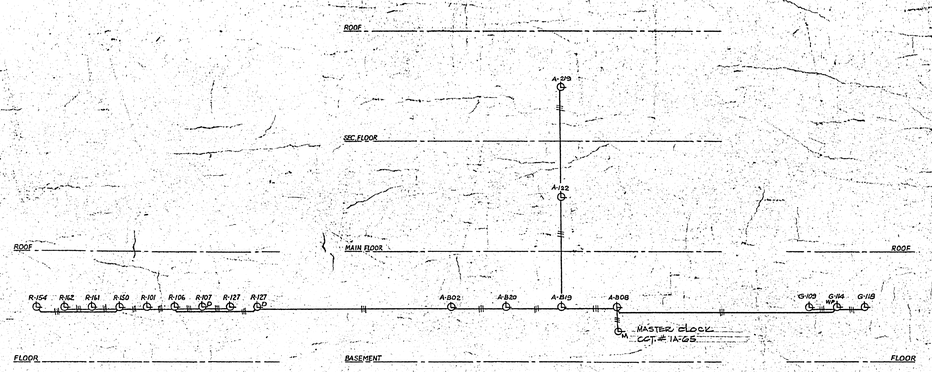

OVERHAUL & REPAIR BUILDING — OFFICE BUILDING — GARAGE BUILDING

CLOCK SYSTEM RISER DIAGRAM

(N.T.S.)

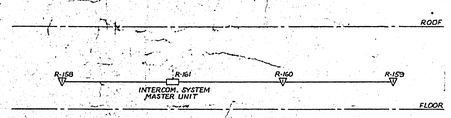

INTERCOM. SYST. RISER DIAGRAM IN WAYS & STREETS FACIL. BLDG.

(N.T.S.)

NOTES:

1. MOUNT BOTTOM OF LIGHTING FIXTURES TYPE 'L' AND 'M' FLUSH WITH THE BOTTOM FLANGE OF BEAM.
2. 1/8" THICK STEEL PLATE (SIZE TO SUIT) MOUNTED 8'-0" ABOVE FINISHED FLOOR FOR MOUNTING OF 4 400 W MERCURY VAPOUR 2-LAMP BALLASTS (1 SINGLE LAMP BALLAST
3. MOUNT TYPE 'R' LIGHTING FIXTURES IN PAINT SHOP ON OUTLET BOXES ON SUSPENDED CEILING.

2185-708

DATE	ISSUE NO.	REV. NO.	DESCRIPTION	DRAWN BY
NOV.6.69			AS BUILT	
JUL.10.68		1	ADDED PANEL AS PER FIELD INSTRUCTION No. 159.	
APR.7.68	9	1	CIRCUIT NUMBERS CHANGED *RK-13 TO *RKA-6 AND *RK-24 TO *RKA-8, ENTRIES DELETED.	
FEB.26.68	8	1	ADDED DIESEL PRESS. PUMP IN RM.*R-154 AND EXH. FAN IN RM.*R-158 WITH CONTROL EQUIPMENT.	
OCT.2.'68	7	1	30A RECEPT. ADDED, TEL. OUTL. RELOC. TO RM.* R-158, TALK-BACK STATION ADDED IN RM.* R-162.	
SEPT.18.68	6	1	MAKE-UP AIR UNITS ON CCTS. *OU-6,7 & 8 DELETED. UNIT HEATERS ADDED ON CCTS. *RK-52, 54 & 56.	
JUNE.11.68	5	1	IN ROOF PLUS TYPE 'F' FIXTURE ADDED IN CORRIDOR *R-152 TYPE 'L' FIXTURE DELETED - 2 TYPE 'C' FIXTURES ADDED. CIRCUITS *RK-1 AND *RK-3 REVISED.	
NOV.1.67	3		DOOR ADDED AS PER ARCHITECTURAL CHANGES.	
MAR.29.67	4		ISSUED FOR CONSTRUCTION	
12/2/67	3	1	GENERAL REVISIONS	
JAN.19.67	2		FOR TENDER.	
12/18/67	1	0	FOR APPROVAL.	

ISSUE OR REVISION

METROPOLITAN CORPORATION OF GREATER WINNIPEG
STREETS AND TRANSIT DIVISION

TRANSIT STORAGE AND SHOP FACILITIES

WAYS & STREETS FACILITIES BUILDING — LIGHTING & POWER

REGISTERED PROFESSIONAL ENGINEER — ELECTRICAL — L.G. JONES — PROVINCE OF ONTARIO

LICENSED TO PRACTICE — PROVINCE OF MANITOBA

CONSULTING PROFESSIONAL ENGINEERS
A. D. MARGISON AND ASSOCIATES LIMITED
1155 LESLIE STREET, DON MILLS, ONTARIO.

ARCHITECTS
Waisman Ross + Blankstein Coop Gillmor Hanna
10 DONALD STREET, WINNIPEG, MANITOBA

APPROVED — DEPUTY DIRECTOR OF STREETS AND TRANSIT

DRAWN BY: R.M. | DATE: 21 JULY 1967
CHECKED: L.G.J. | SCALE: AS SHOWN
FILE No. | DRAWING No. 2185-708
SHEET No. | ELECTRICAL

421 Osborne St. — Transit Storage & Shop Facilities
Address
LANNED
project no. 2185-709 — sheet no.
Ways & Streets Facilities Bldg. — Lighting & Power
description