


421 Osborne St.
 TRANSIT STORAGE
 SHOP FACILITIES
 2185-709
 OFFICE BUILDING PLANS -
 LIGHTING

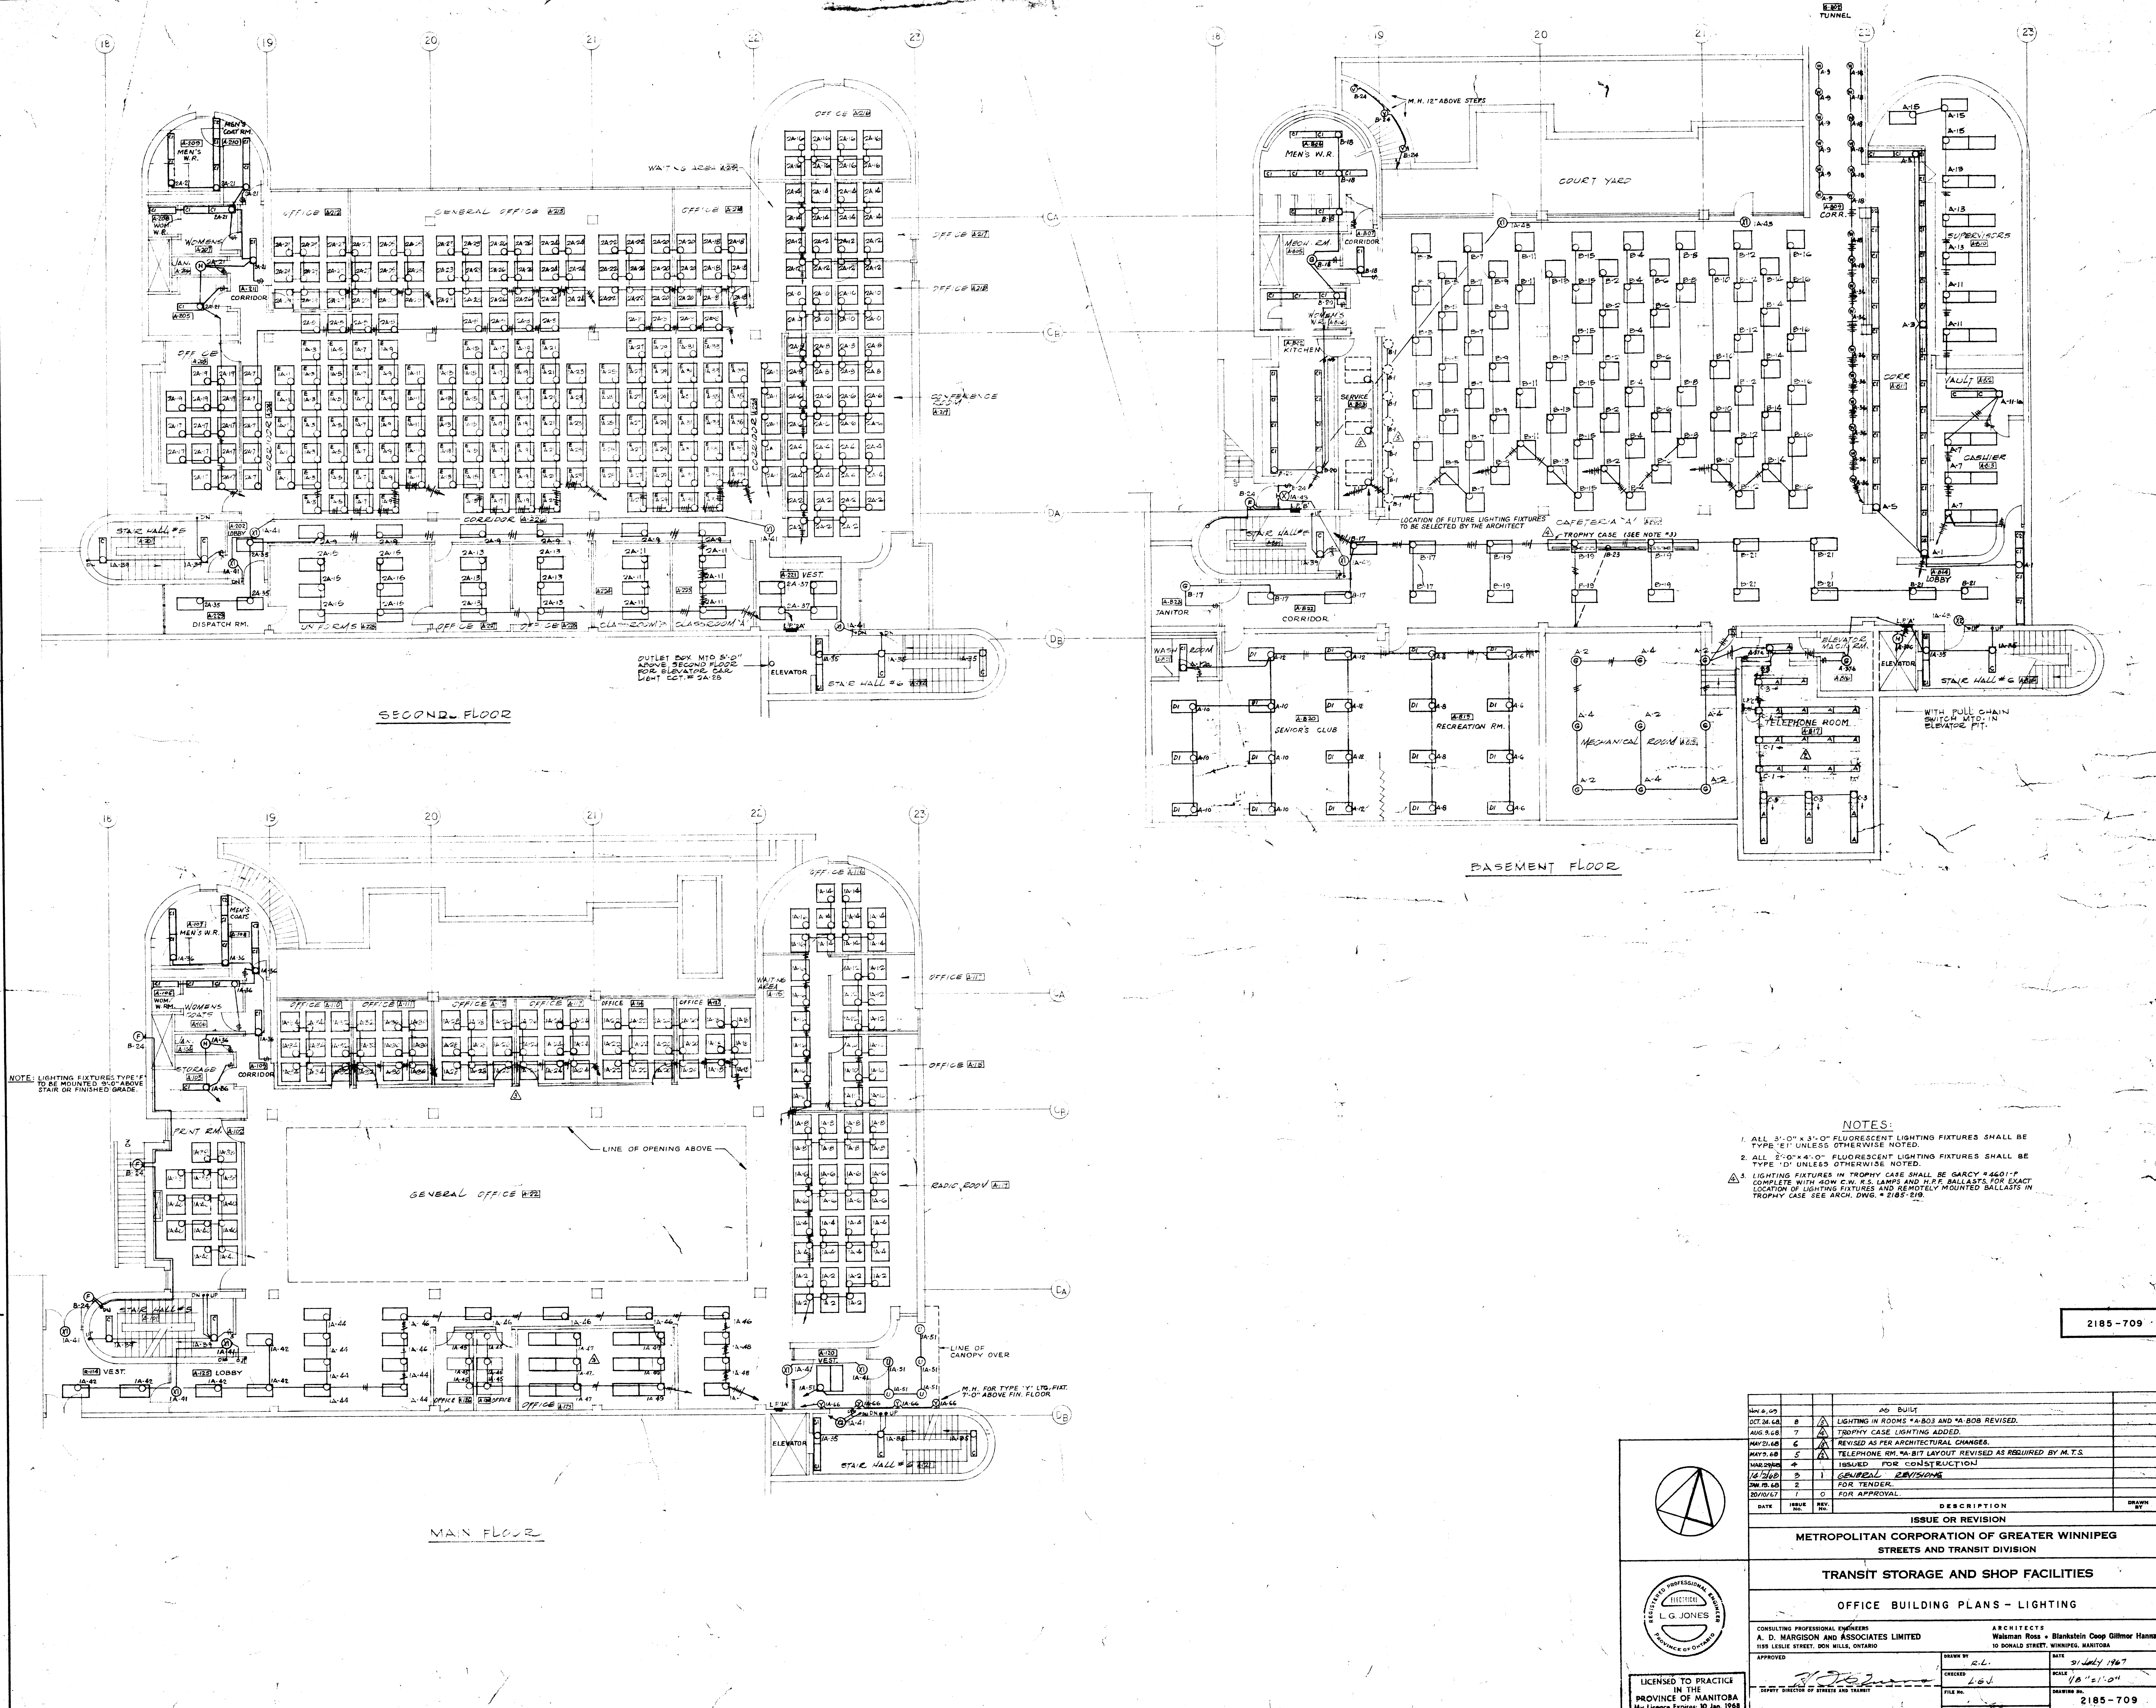

NOTE: LIGHTING FIXTURES TYPE 'F' TO BE MOUNTED 8'-0" ABOVE STAIR OR FINISHED GRADE.

- NOTES:
1. ALL 3'-0" x 3'-0" FLUORESCENT LIGHTING FIXTURES SHALL BE TYPE 'ET' UNLESS OTHERWISE NOTED.
 2. ALL 2'-0" x 4'-0" FLUORESCENT LIGHTING FIXTURES SHALL BE TYPE 'D' UNLESS OTHERWISE NOTED.

2185-709

DATE	ISSUE	REV.	DESCRIPTION	DRAWN BY
MAY 21 1968	6		REVISED AS PER ARCHITECTURAL CHANGES.	
MAY 19 1968	5		TELEPHONE ROOM LAYOUT REVISED AS REQUIRED BY M.T.S.	
MARCH 26 1968	4		ISSUED FOR CONSTRUCTION	
12/26/67	3		GENERAL REVISIONS	
NOV 16 1967	2		FOR TENDER.	
20/10/67	1		FOR APPROVAL.	

ISSUE OR REVISION

METROPOLITAN CORPORATION OF GREATER WINNIPEG
 STREETS AND TRANSIT DIVISION

TRANSIT STORAGE AND SHOP FACILITIES

OFFICE BUILDING PLANS - LIGHTING

CONSULTING PROFESSIONAL ENGINEERS
 A. D. MARGISON AND ASSOCIATES LIMITED
 1155 LESLIE STREET, DON MILLS, ONTARIO

ARCHITECTS
 10 DONALD STREET, WINNIPEG, MANITOBA

APPROVED: [Signature] DATE: 21 JULY 1967
 CHECKED: L.G.J. SCALE: 1/8" = 1'-0"
 FILE NO.: 2185-709
 SHEET NO.: ELECTRICAL

LICENSED TO PRACTICE
 IN THE
 PROVINCE OF MANITOBA
 My Licence Expires: 30 Jan. 1968