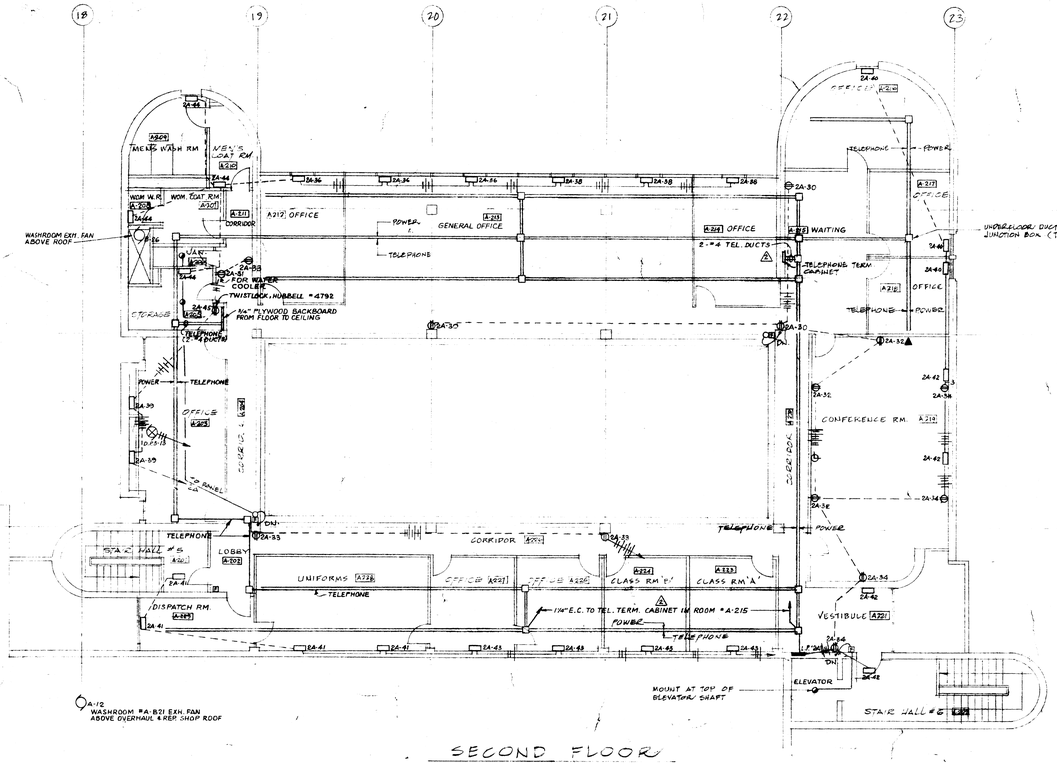

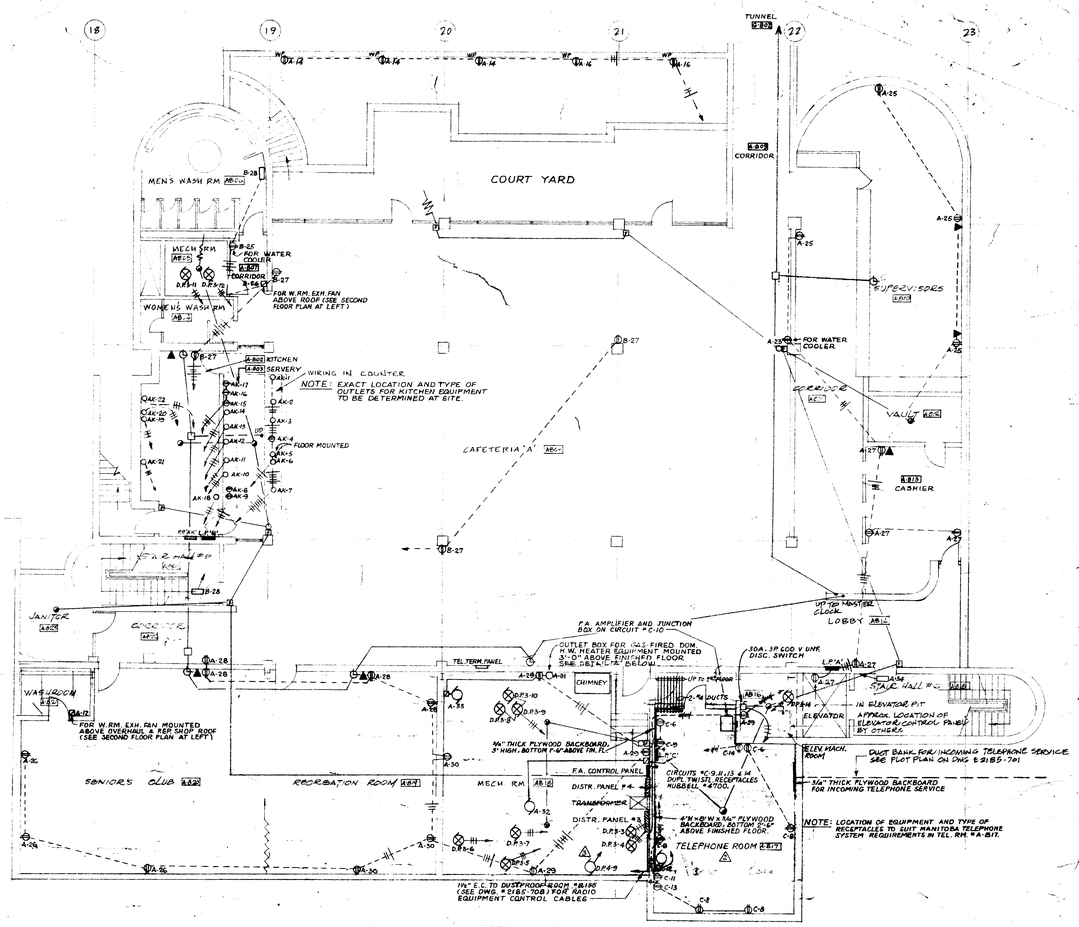

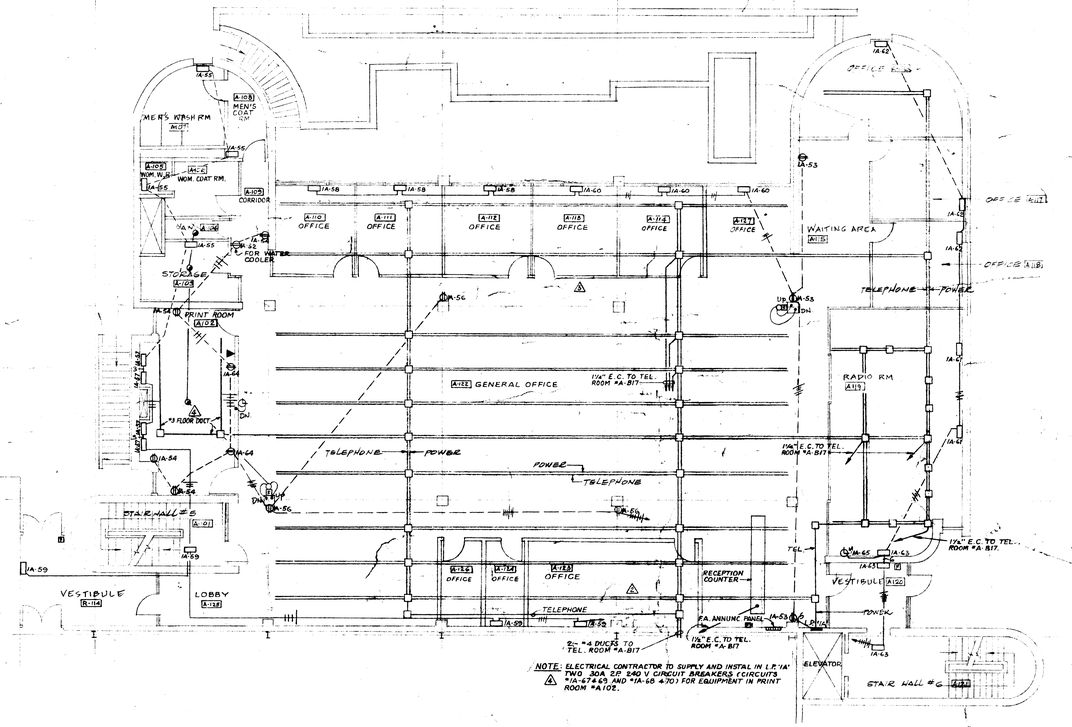

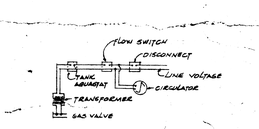

DETAIL 'A'
WIRING DIAGRAM FOR HOT WATER HEATERS

NOTES:
1. ALL UNDERFLOOR DUCTS SHALL BE #4 UNLESS OTHERWISE NOTED. UNDERFLOOR DUCT JUNCTION BOXES TO SUIT DUCT REQUIREMENTS.

2185-710

DATE	ISSUE NO.	REV. NO.	DESCRIPTION	DRAWN BY
NOV 6.69			AS BUILT	
APR 7.69	7	A	#5 UNDERFLOOR DUCTS AND JUNCTION BOXES ADDED IN RM. #A102.	
MAY 2.68	6	A	REVISED AS PER ARCHITECTURAL CHANGES, SUMP PUMP ADDED IN RM #A-B18.	
MAY 3.68	5	A	TELEPHONE SYSTEM RACEWAYS AND TEL RM. #A-B17 REVISED AS REQUIRED BY M.T.S.	
MAR 29/68	4		ISSUED FOR CONSTRUCTION	
14/2/68	3	1	GENERAL REVISIONS	
JAN 15.68	2		FOR TENDER	
20/10/67	1	0	FOR APPROVAL.	

ISSUE OR REVISION

METROPOLITAN CORPORATION OF GREATER WINNIPEG
STREETS AND TRANSIT DIVISION

REGISTERED PROFESSIONAL ENGINEER — ELECTRICAL — L.G. JONES — Province of Manitoba

LICENSED TO PRACTICE IN THE PROVINCE OF MANITOBA
My Licence Expires: 10 Jan. 1968

TRANSIT STORAGE AND SHOP FACILITIES

OFFICE BUILDING PLANS – POWER & SYSTEMS

CONSULTING PROFESSIONAL ENGINEERS
A. D. MARGISON AND ASSOCIATES LIMITED
1155 LENILE STREET, DON MILLS, ONTARIO

ARCHITECTS
Waisman Ross • Blankstein Coop Gillmor Hanna
10 DONALD STREET, WINNIPEG, MANITOBA

APPROVED
DEPUTY DIRECTOR OF STREETS AND TRANSIT

DRAWN BY R.M. | DATE 21 July 1967
CHECKED L.G.J. | SCALE 1/8" = 1'-0"
FILE No. | DRAWING No. 2185-710 ELECTRICAL
SHEET No.

TRANSIT STORAGE SHOP FACILITIES
421 OSBORNE ST. — ADDRESS
2185-710 — PROJECT NO. — SHEET NO.
OFFICE BUILDING PLANS — description
POWER & SYSTEMS