




1 SECTION
A2 1:75

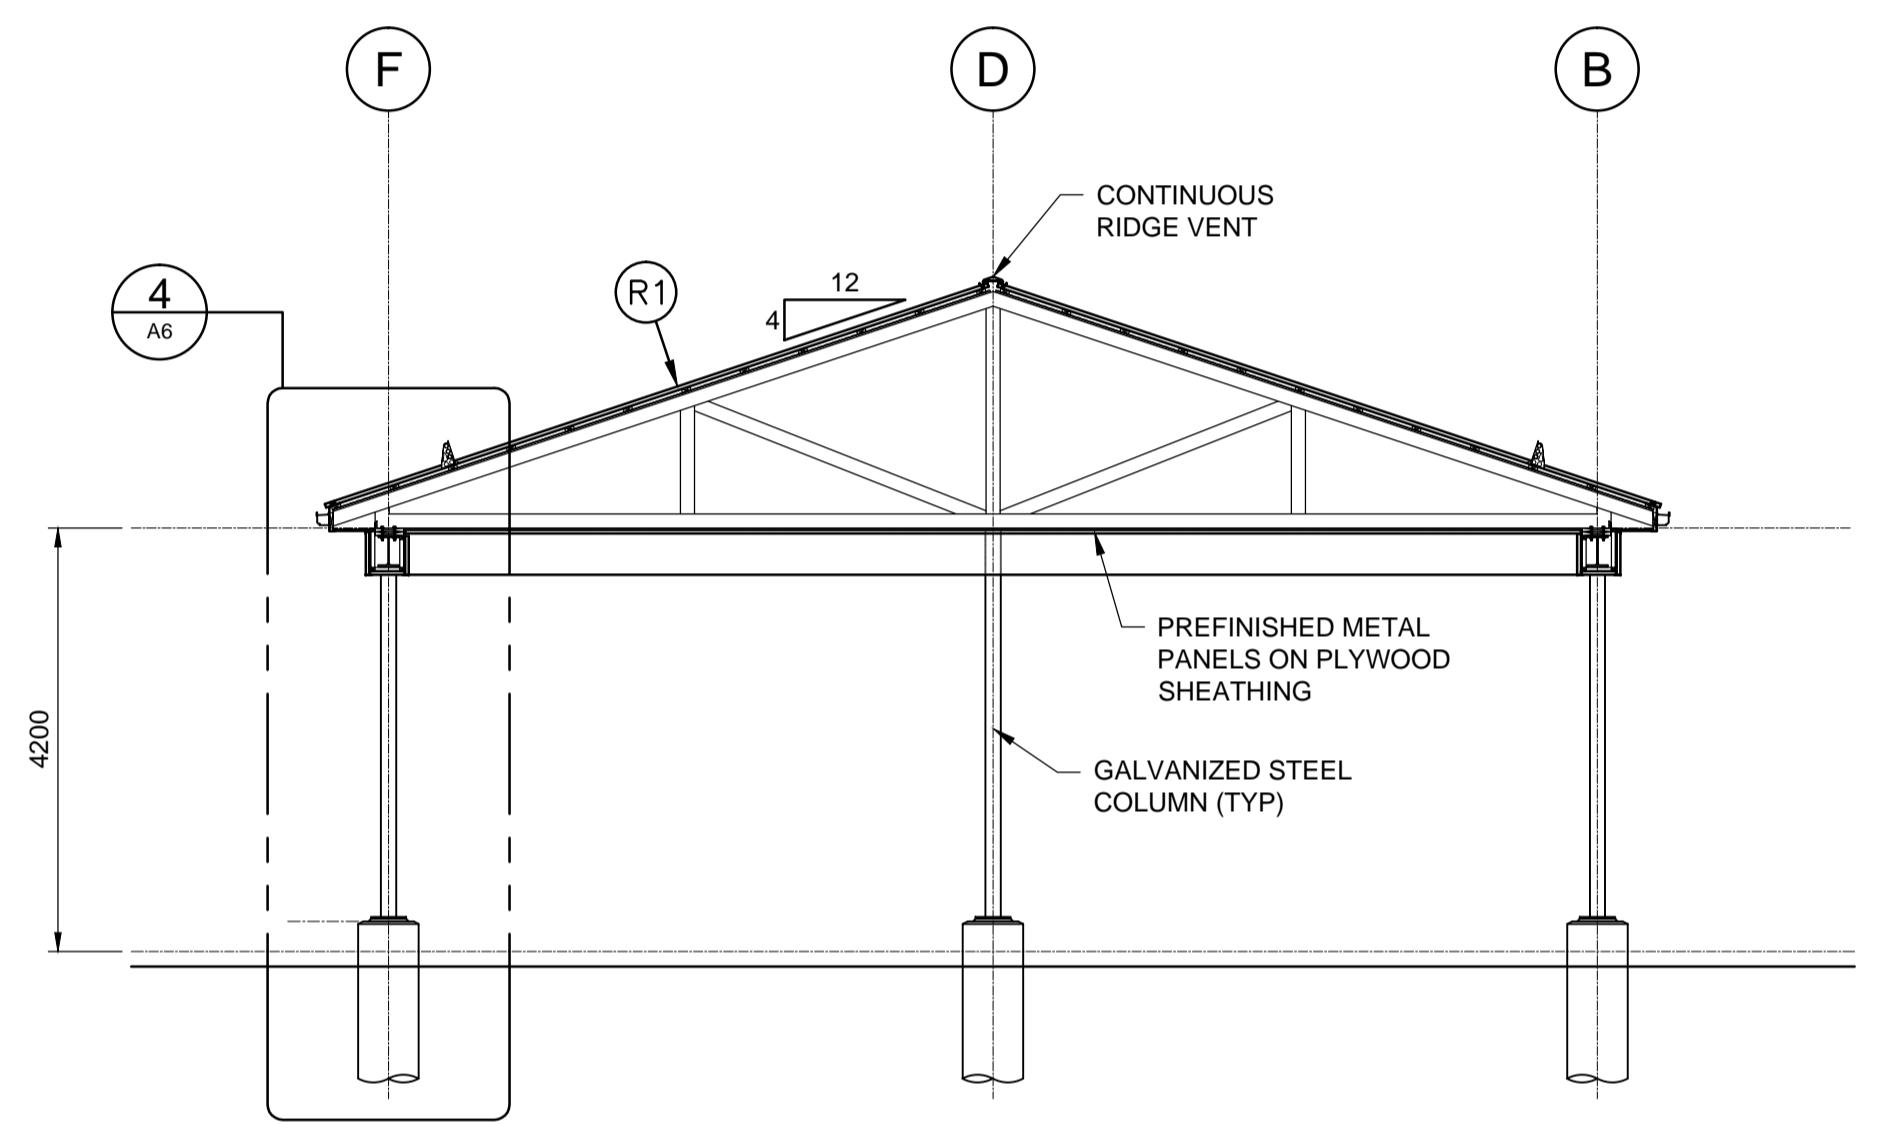

2 SECTION
A2 1:75

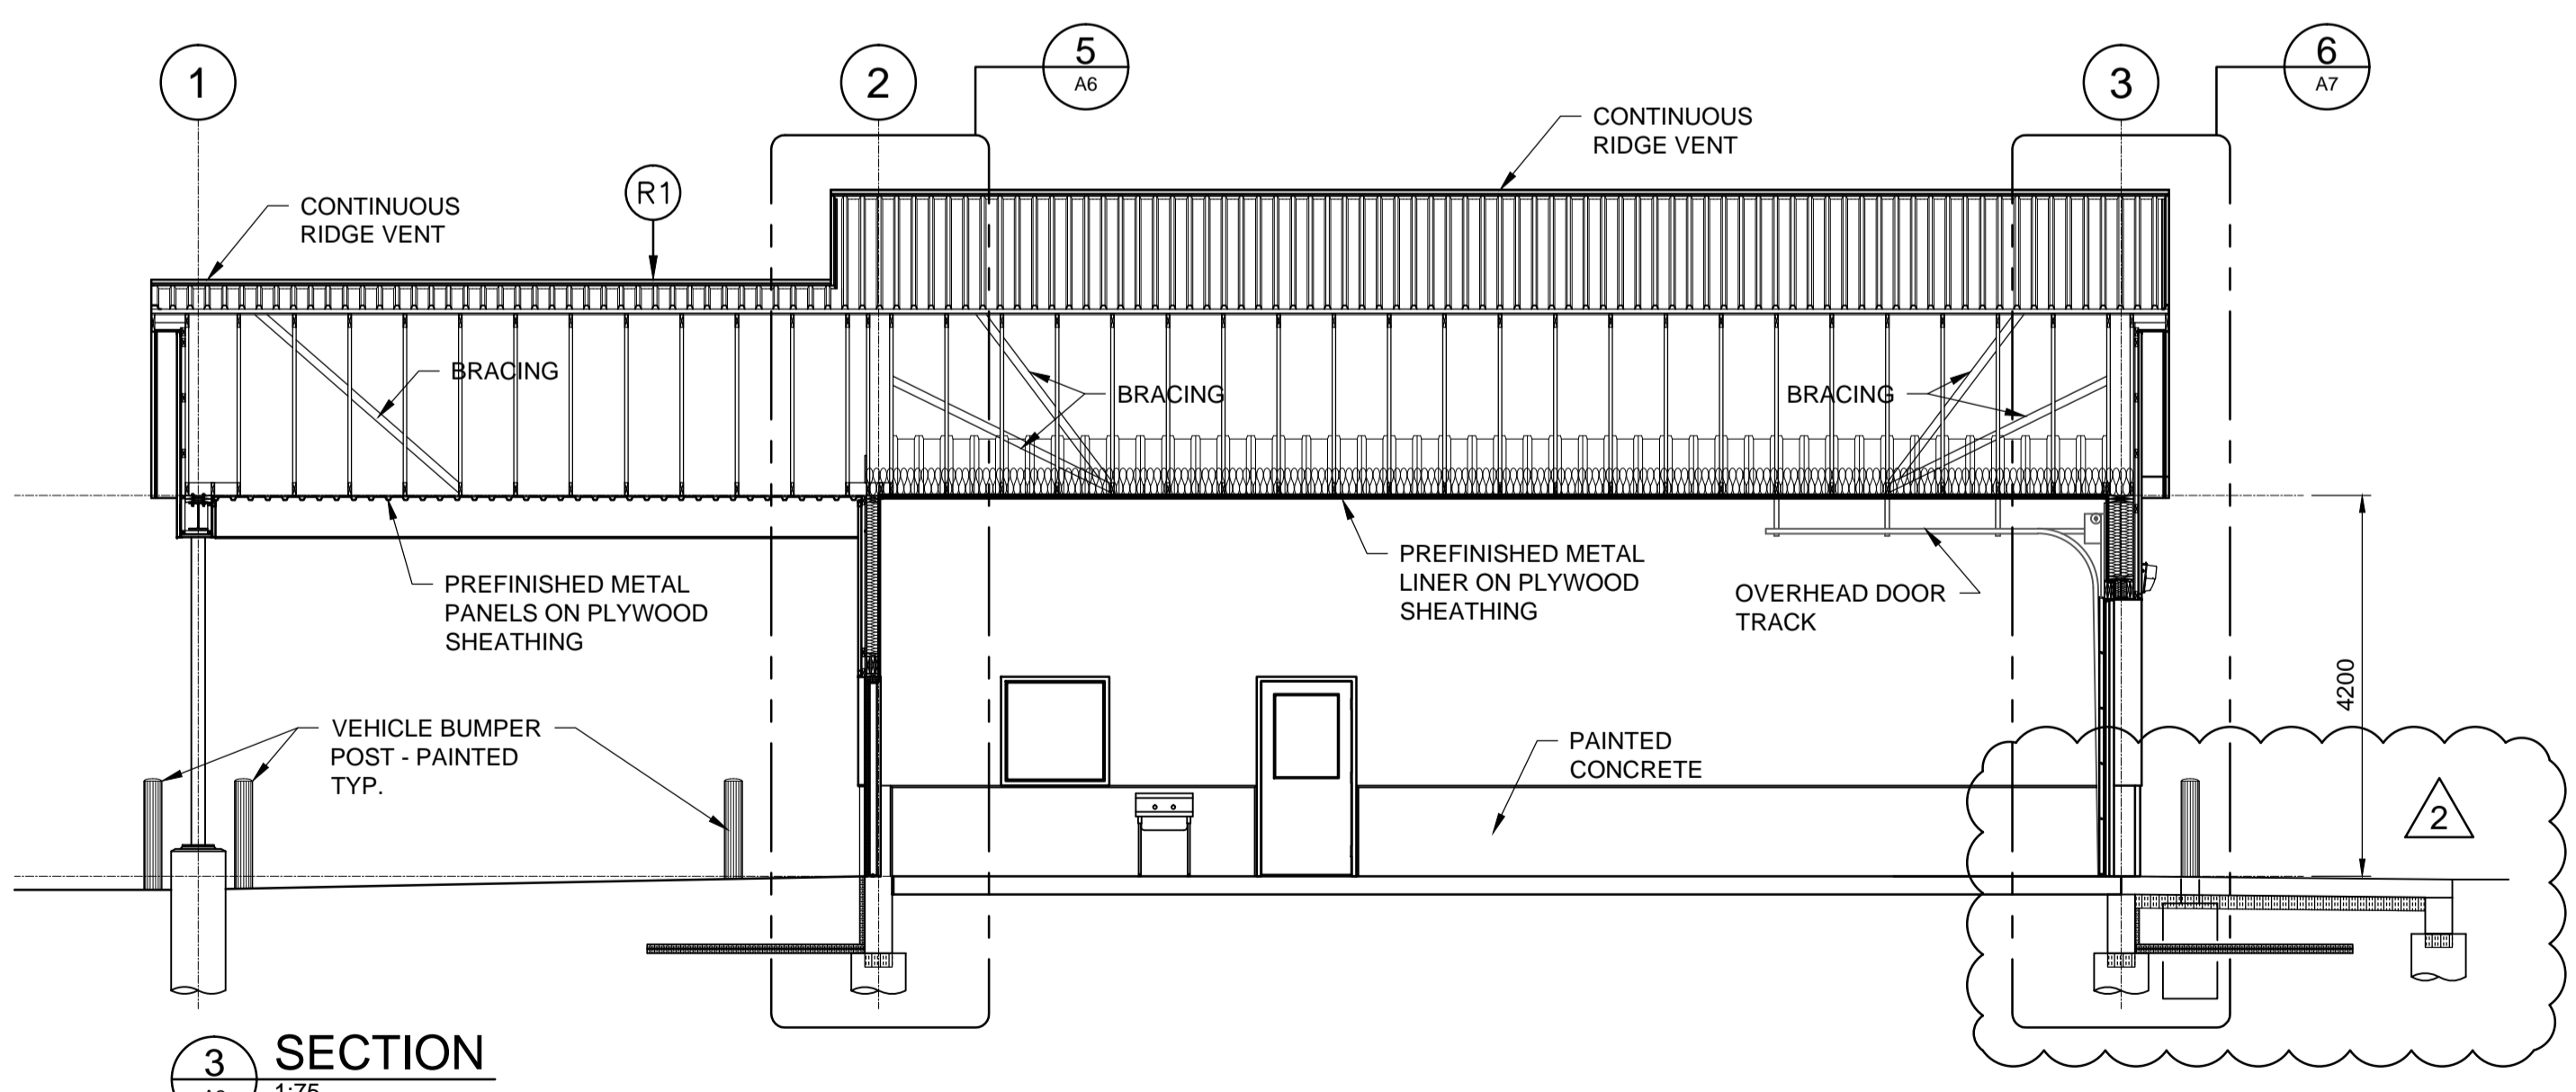

3 SECTION
A2 1:75

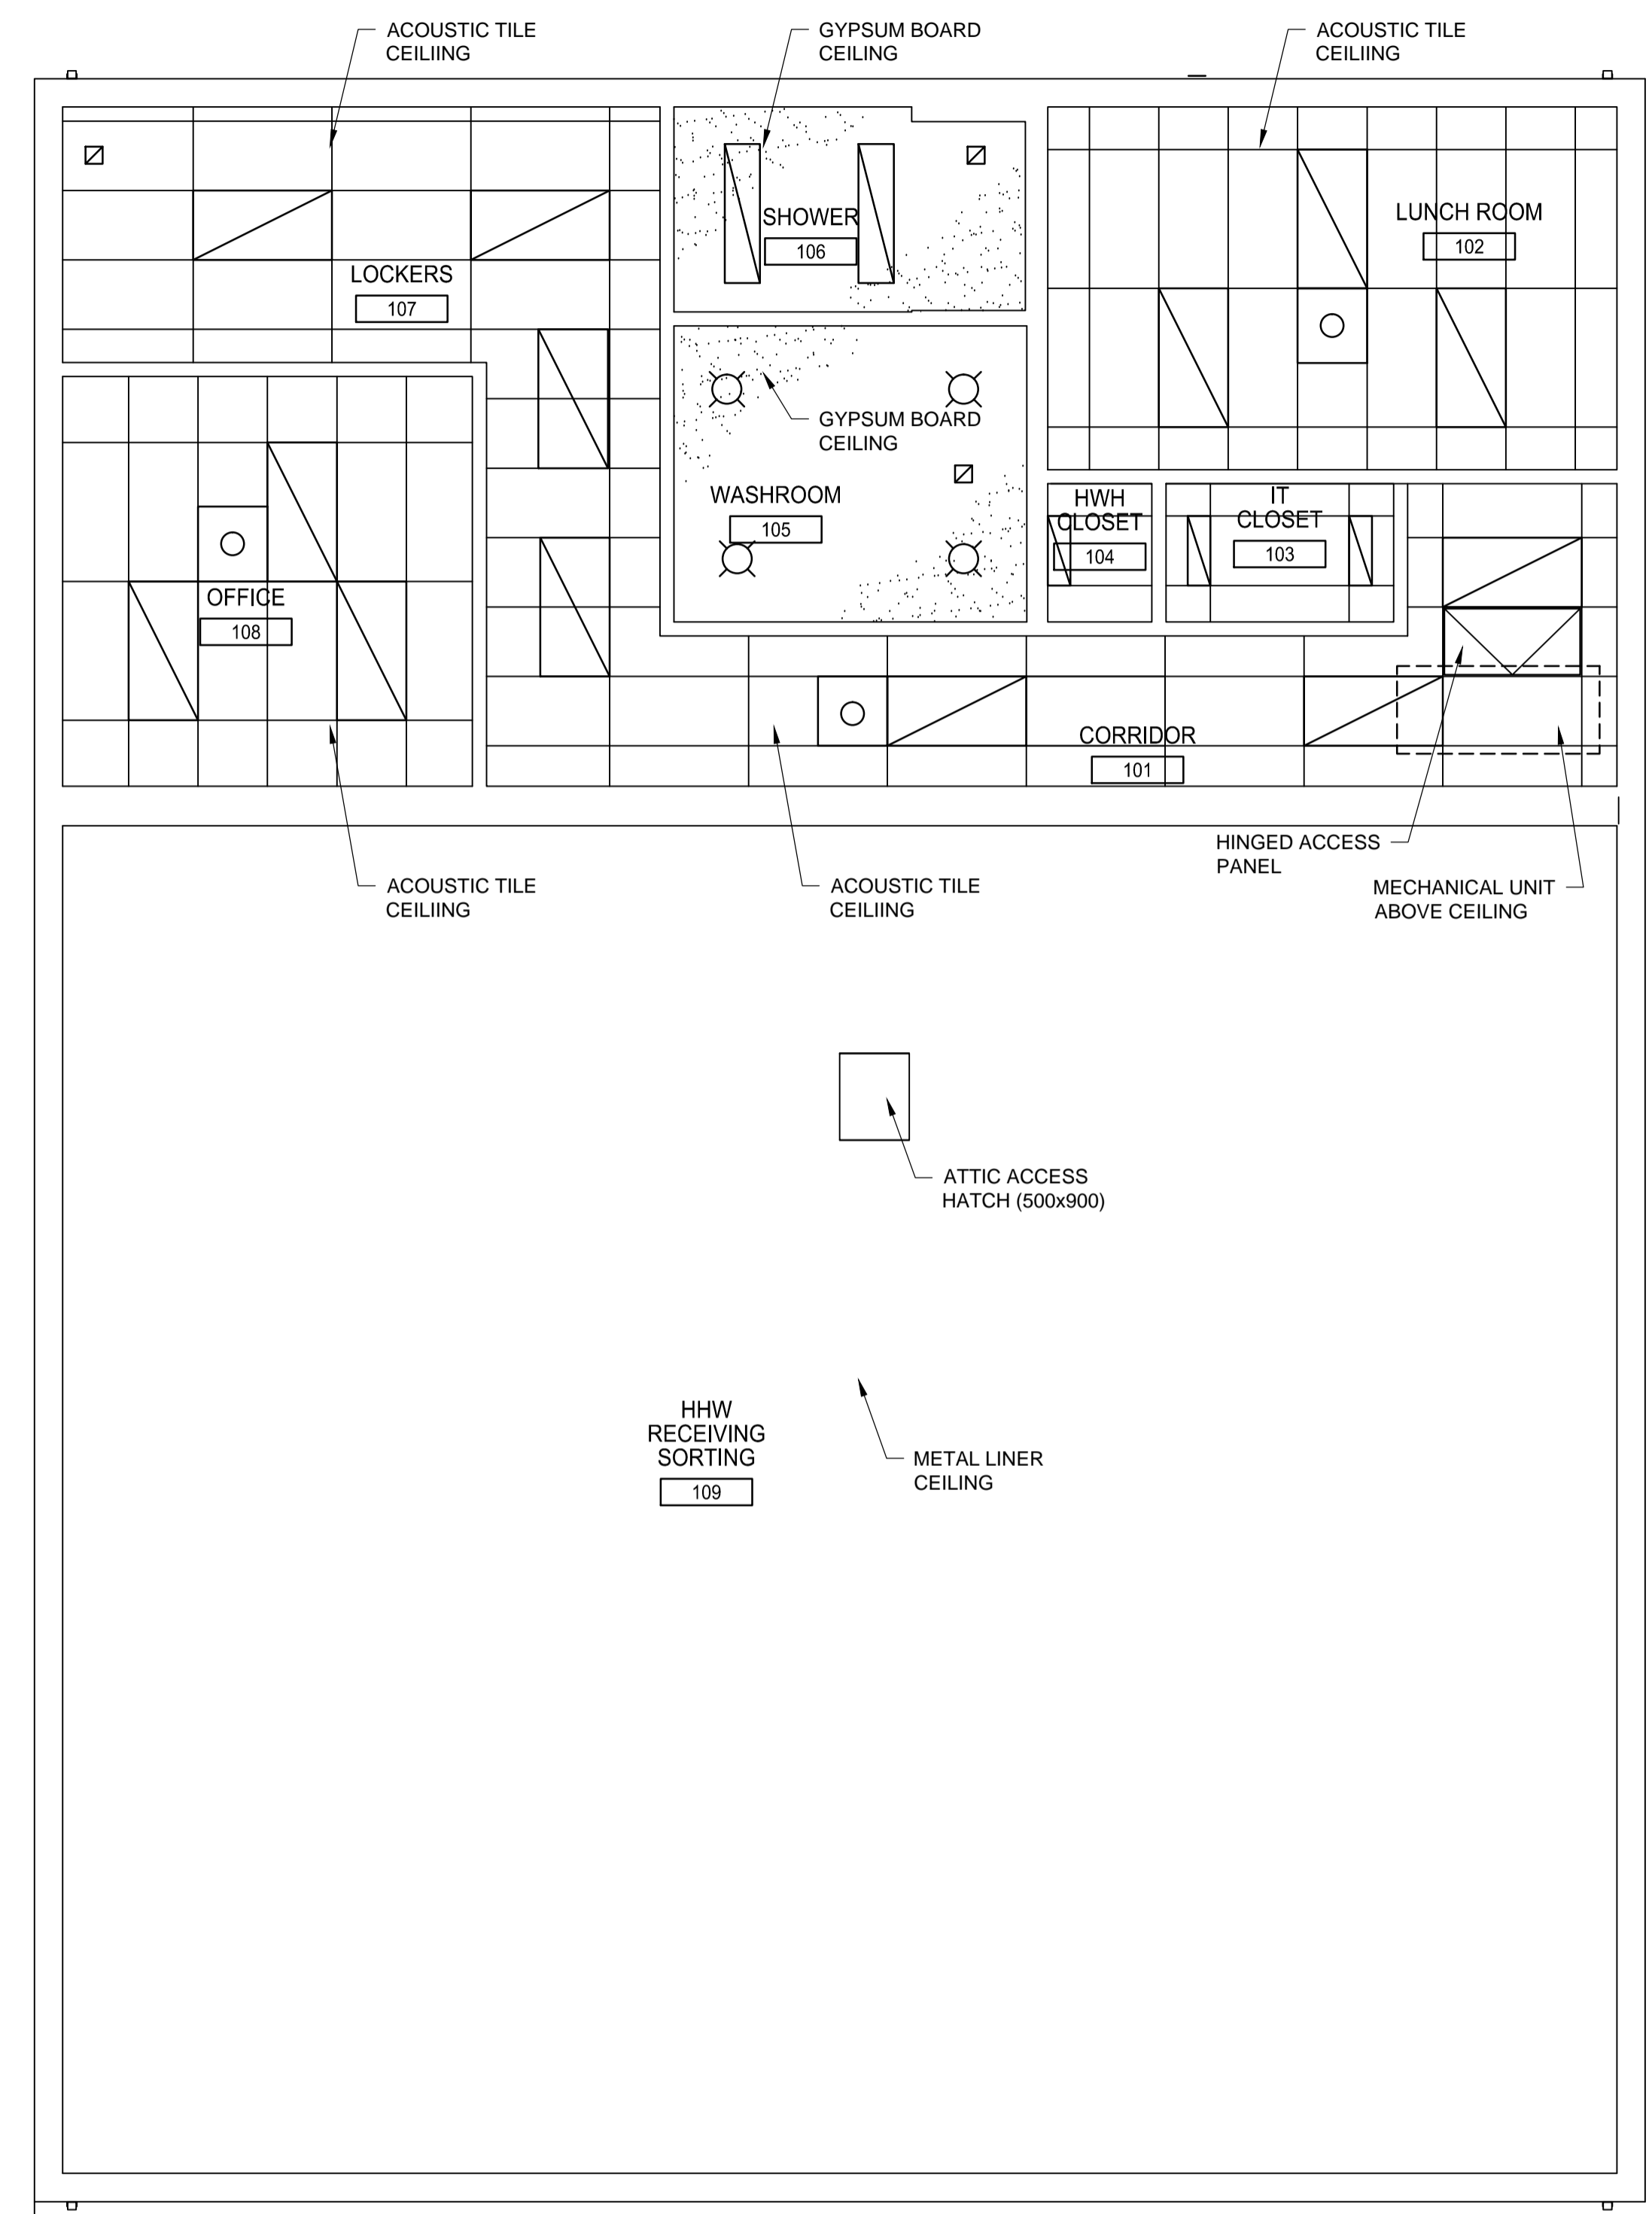

REFLECTED CEILING PLAN
1:50


METRIC
WHOLE NUMBERS INDICATE MILLIMETRES
DECIMALIZED NUMBERS INDICATE METRES

C:\projectwise_working_directory\active\408skb\0245764\138224-01-ARCH-PACIFIC.dwg



NO.	REVISIONS	DATE	BY
2	ISSUED FOR ADDENDUM # 1	16/03/14	ARR
1	ISSUED FOR TENDER	16/03/04	ARR

DESIGNED BY	LDP
DRAWN BY	PDR
CHECKED BY	LDP
APPROVED BY	ARR
HOR. SCALE	AS NOTED
VERTICAL	
DATE	

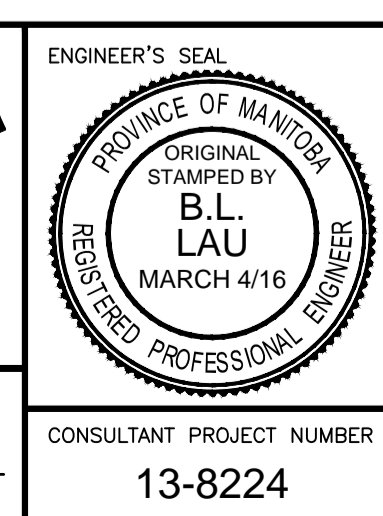

THE CITY OF WINNIPEG
PUBLIC WORKS DEPARTMENT

4R WINNIPEG DEPOT
PACIFIC AVENUE

HHW EWASTE BUILDING CROSS
SECTIONS, ROOF FRAMING PLAN

CITY DRAWING NUMBER
1-0851A-A0005-001

SHEET 27 OF 43

CONSULTANT PROJECT NUMBER
13-8224

CONSULTANT DRAWING NUMBER
A-5