



**A SECTION STATION 0+190**  
H 1:100 V 1:50

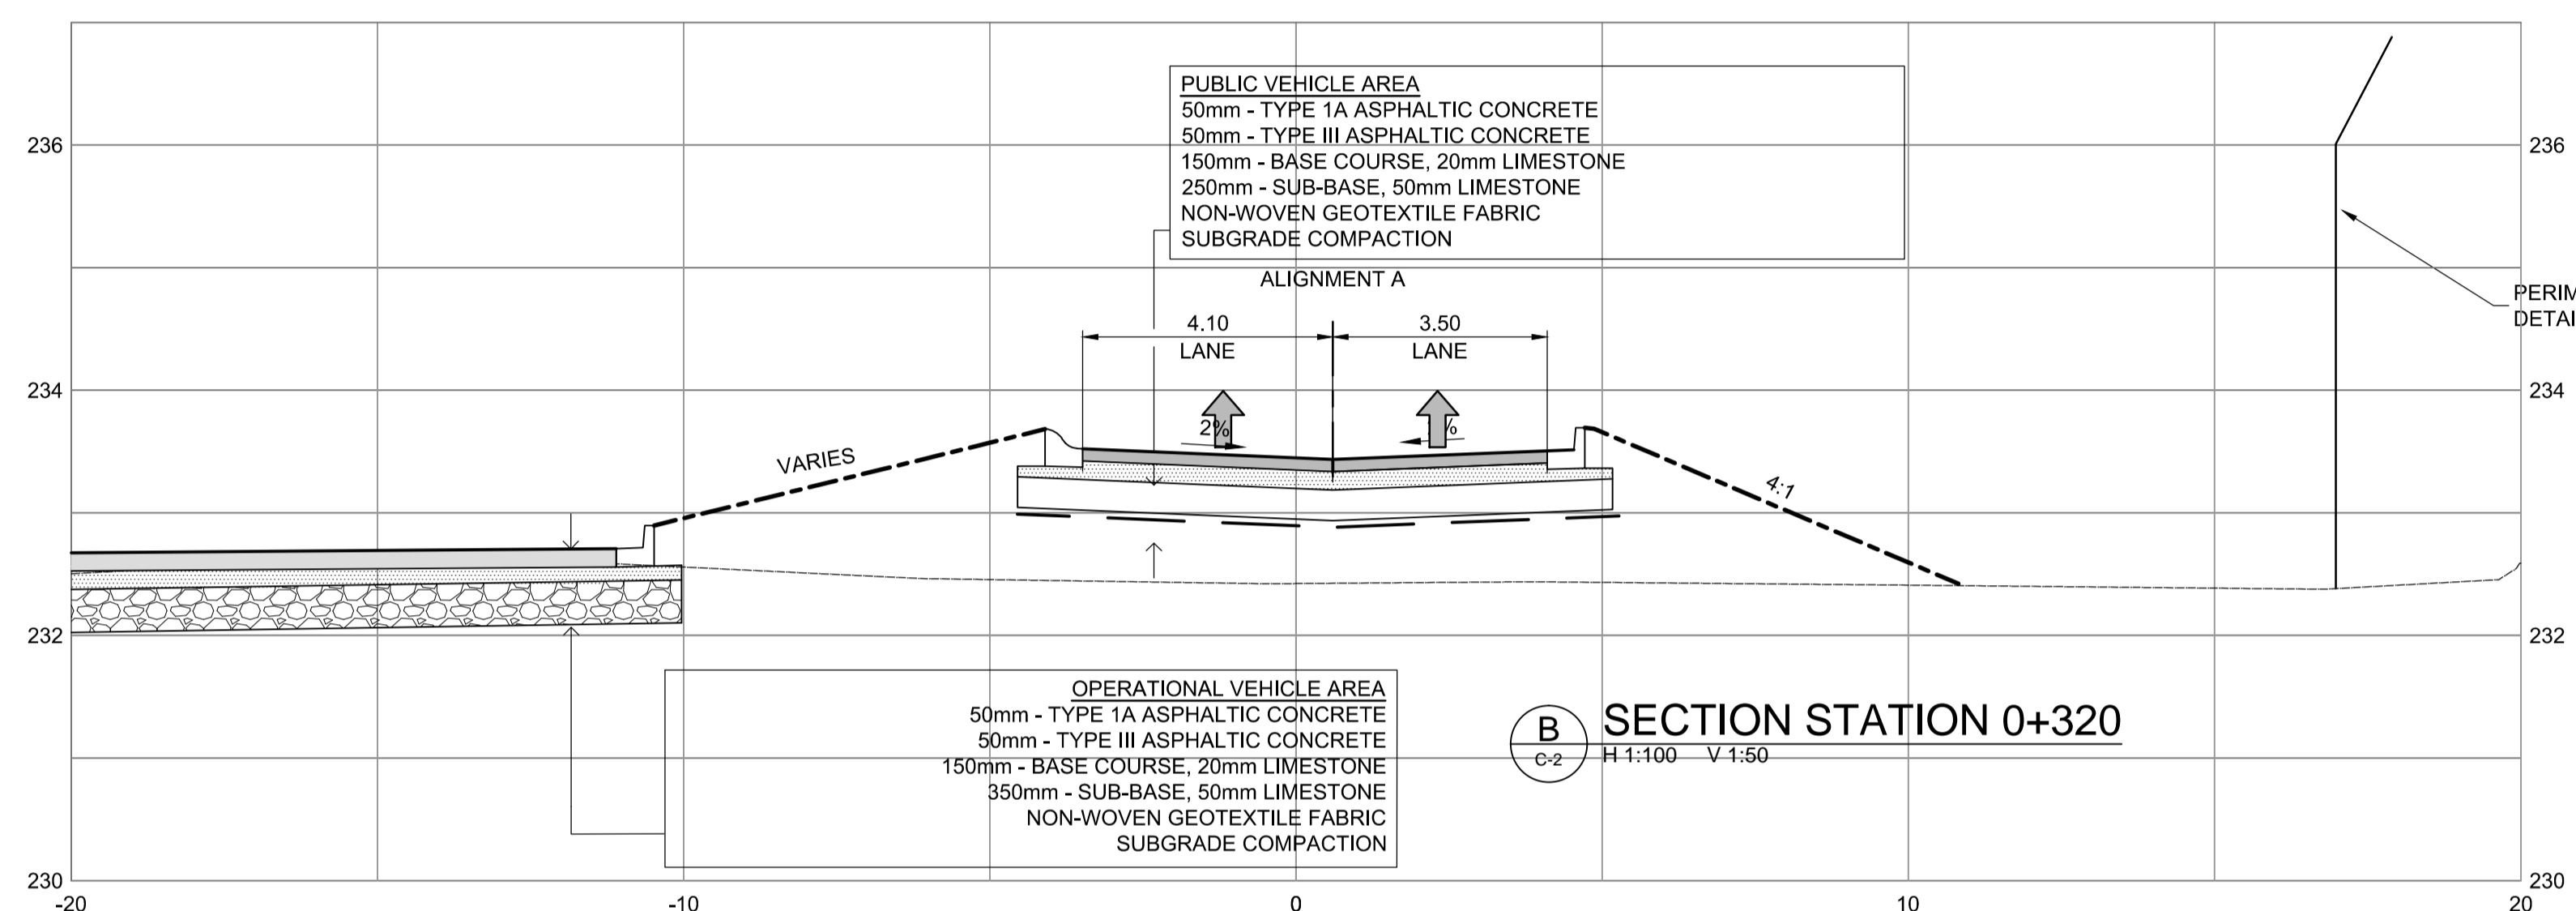

**B SECTION STATION 0+320**  
H 1:100 V 1:50

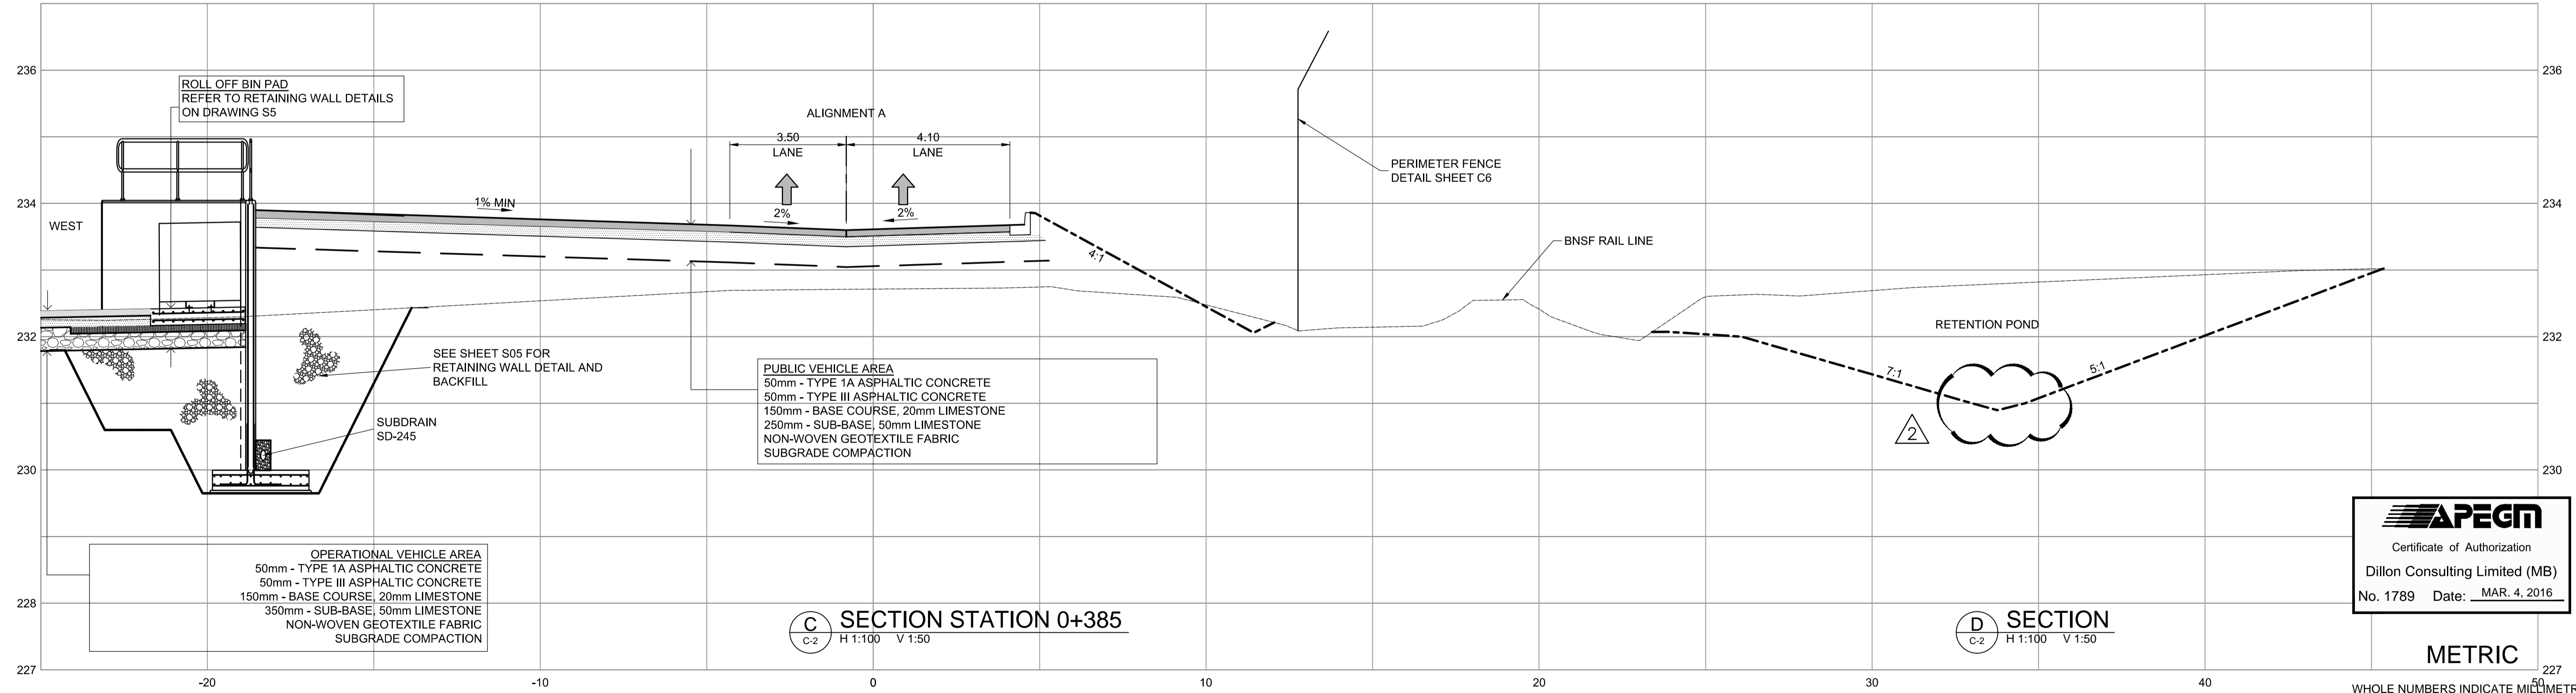

**C SECTION STATION 0+385**  
H 1:100 V 1:50

**D SECTION**  
H 1:100 V 1:50



**APEGM**  
Certificate of Authorization  
Dillon Consulting Limited (MB)  
No. 1789 Date: MAR. 4, 2016

METRIC  
DECIMALIZED NUMBERS INDICATE METRES

C:\projects\wastewater\working\_directory\active\4099\40245764\138224-02-DSEC-COIN.dwg


UNDERGROUND STRUCTURES			
SUPPLY, U/G STRUCTURES COMMITTEE	DATE		
NOTE: LOCATION OF UNDERGROUND STRUCTURES AS SHOWN ARE BASED ON THE BEST INFORMATION AVAILABLE, BUT NO GUARANTEE IS GIVEN THAT ALL EXISTING UTILITIES ARE SHOWN OR THAT THE GIVEN LOCATIONS ARE EXACT. CONFIRMATION OF EXISTENCE AND EXACT LOCATION OF ALL SERVICES MUST BE OBTAINED FROM THE INDIVIDUAL UTILITIES BEFORE PROCEEDING WITH CONSTRUCTION.			
B.M. ELEV.		DESIGNED BY	WPN
		DRAWN BY	GLG
		CHECKED BY	
		APPROVED BY	ARR
		HOR. SCALE	AS NOTED
		VERTICAL	AS NOTED
NO. REVISIONS	DATE	BY	DATE
2	16/03/14	ARR	
1	16/03/04	ARR	

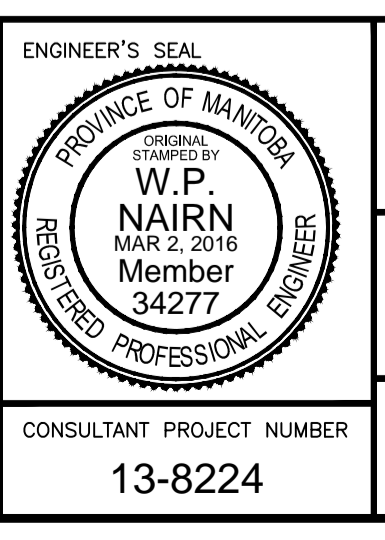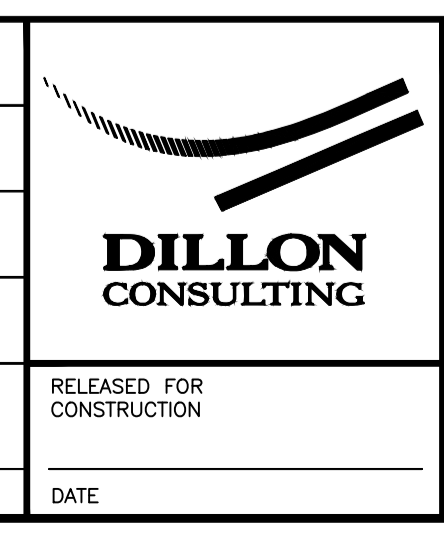

**THE CITY OF WINNIPEG**  
WATER AND WASTE DEPARTMENT

4R WINNIPEG DEPOT  
PACIFIC AVENUE

**TYPICAL SECTIONS**

CITY DRAWING NUMBER: 1-0851A-C0005-001  
SHEET 6 OF 43  
CONSULTANT DRAWING NUMBER: C-5

CONSULTANT PROJECT NUMBER: 13-8224