


\\c01169-800\Workgroups\1137\2013\11372013\drawing\04_working\sheet_files\mils_22_15\32050-3-103-800.dwg
 Date: 2013 May 20 11:57am User: Behrman, James

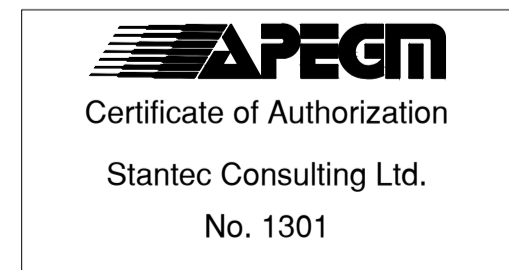

METRIC
WHOLE NUMBERS INDICATE MILLIMETRES
DECIMALIZED NUMBERS INDICATE METRES

LOCATION APPROVED UNDERGROUND STRUCTURES			
N/A			
SUPV. U/G STRUCTURES COMMITTEE	DATE		
NOTE: LOCATION OF UNDERGROUND STRUCTURES AS SHOWN ARE BASED ON THE BEST INFORMATION AVAILABLE BUT NO GUARANTEE IS GIVEN THAT ALL EXISTING UTILITIES ARE SHOWN OR THAT THE GIVEN LOCATIONS ARE EXACT. CONFIRMATION OF EXISTENCE AND EXACT LOCATION OF ALL SERVICES MUST BE OBTAINED FROM THE INDIVIDUAL UTILITIES BEFORE PROCEEDING WITH CONSTRUCTION.			

B.M. ELEV.			
1	REVISED LIMITS OF RIPRAP	15.05.20	J.M.B.
0	ISSUED FOR TENDER	15.04.24	J.M.B.
NO.	REVISIONS	DATE	BY

Stantec
100 - 1355 Taylor Avenue, Winnipeg MB Canada
www.stantec.com

DESIGNED BY: S.S.Y.	CHECKED BY: M.J.B.
DRAWN BY: J.A.S.	APPROVED BY: M.J.B.
HOR. SCALE: AS NOTED	RELEASED FOR CONSTRUCTION: DATE
VERTICAL: DATE 2014.03.24	DATE

ENGINEER'S SEAL
CONSULTANT DRAWING NO. S103

THE CITY OF WINNIPEG
WATER AND WASTE DEPARTMENT
ENGINEERING DIVISION

GREATER WINNIPEG WATER DISTRICT
RAILWAY BRIDGE REPLACEMENT AT MILE 22.15
GENERAL ARRANGEMENT

SHEET 5 OF 15
CAD FILE DRAWING NUMBER 32050-s-103-800.dwg
CITY DRAWING NUMBER D-13426