


NOTES:

DRAWING LIST	
SHEET No:	SHEET TITLE
S1	FOUNDATION PLAN
S2	MAIN FLOOR FRAMING PLAN, FOUNDATION DETAILS
S3	ROOF FRAMING PLAN
S4	STRUCTURAL DETAILS
S5	STRUCTURAL SPECIFICATIONS

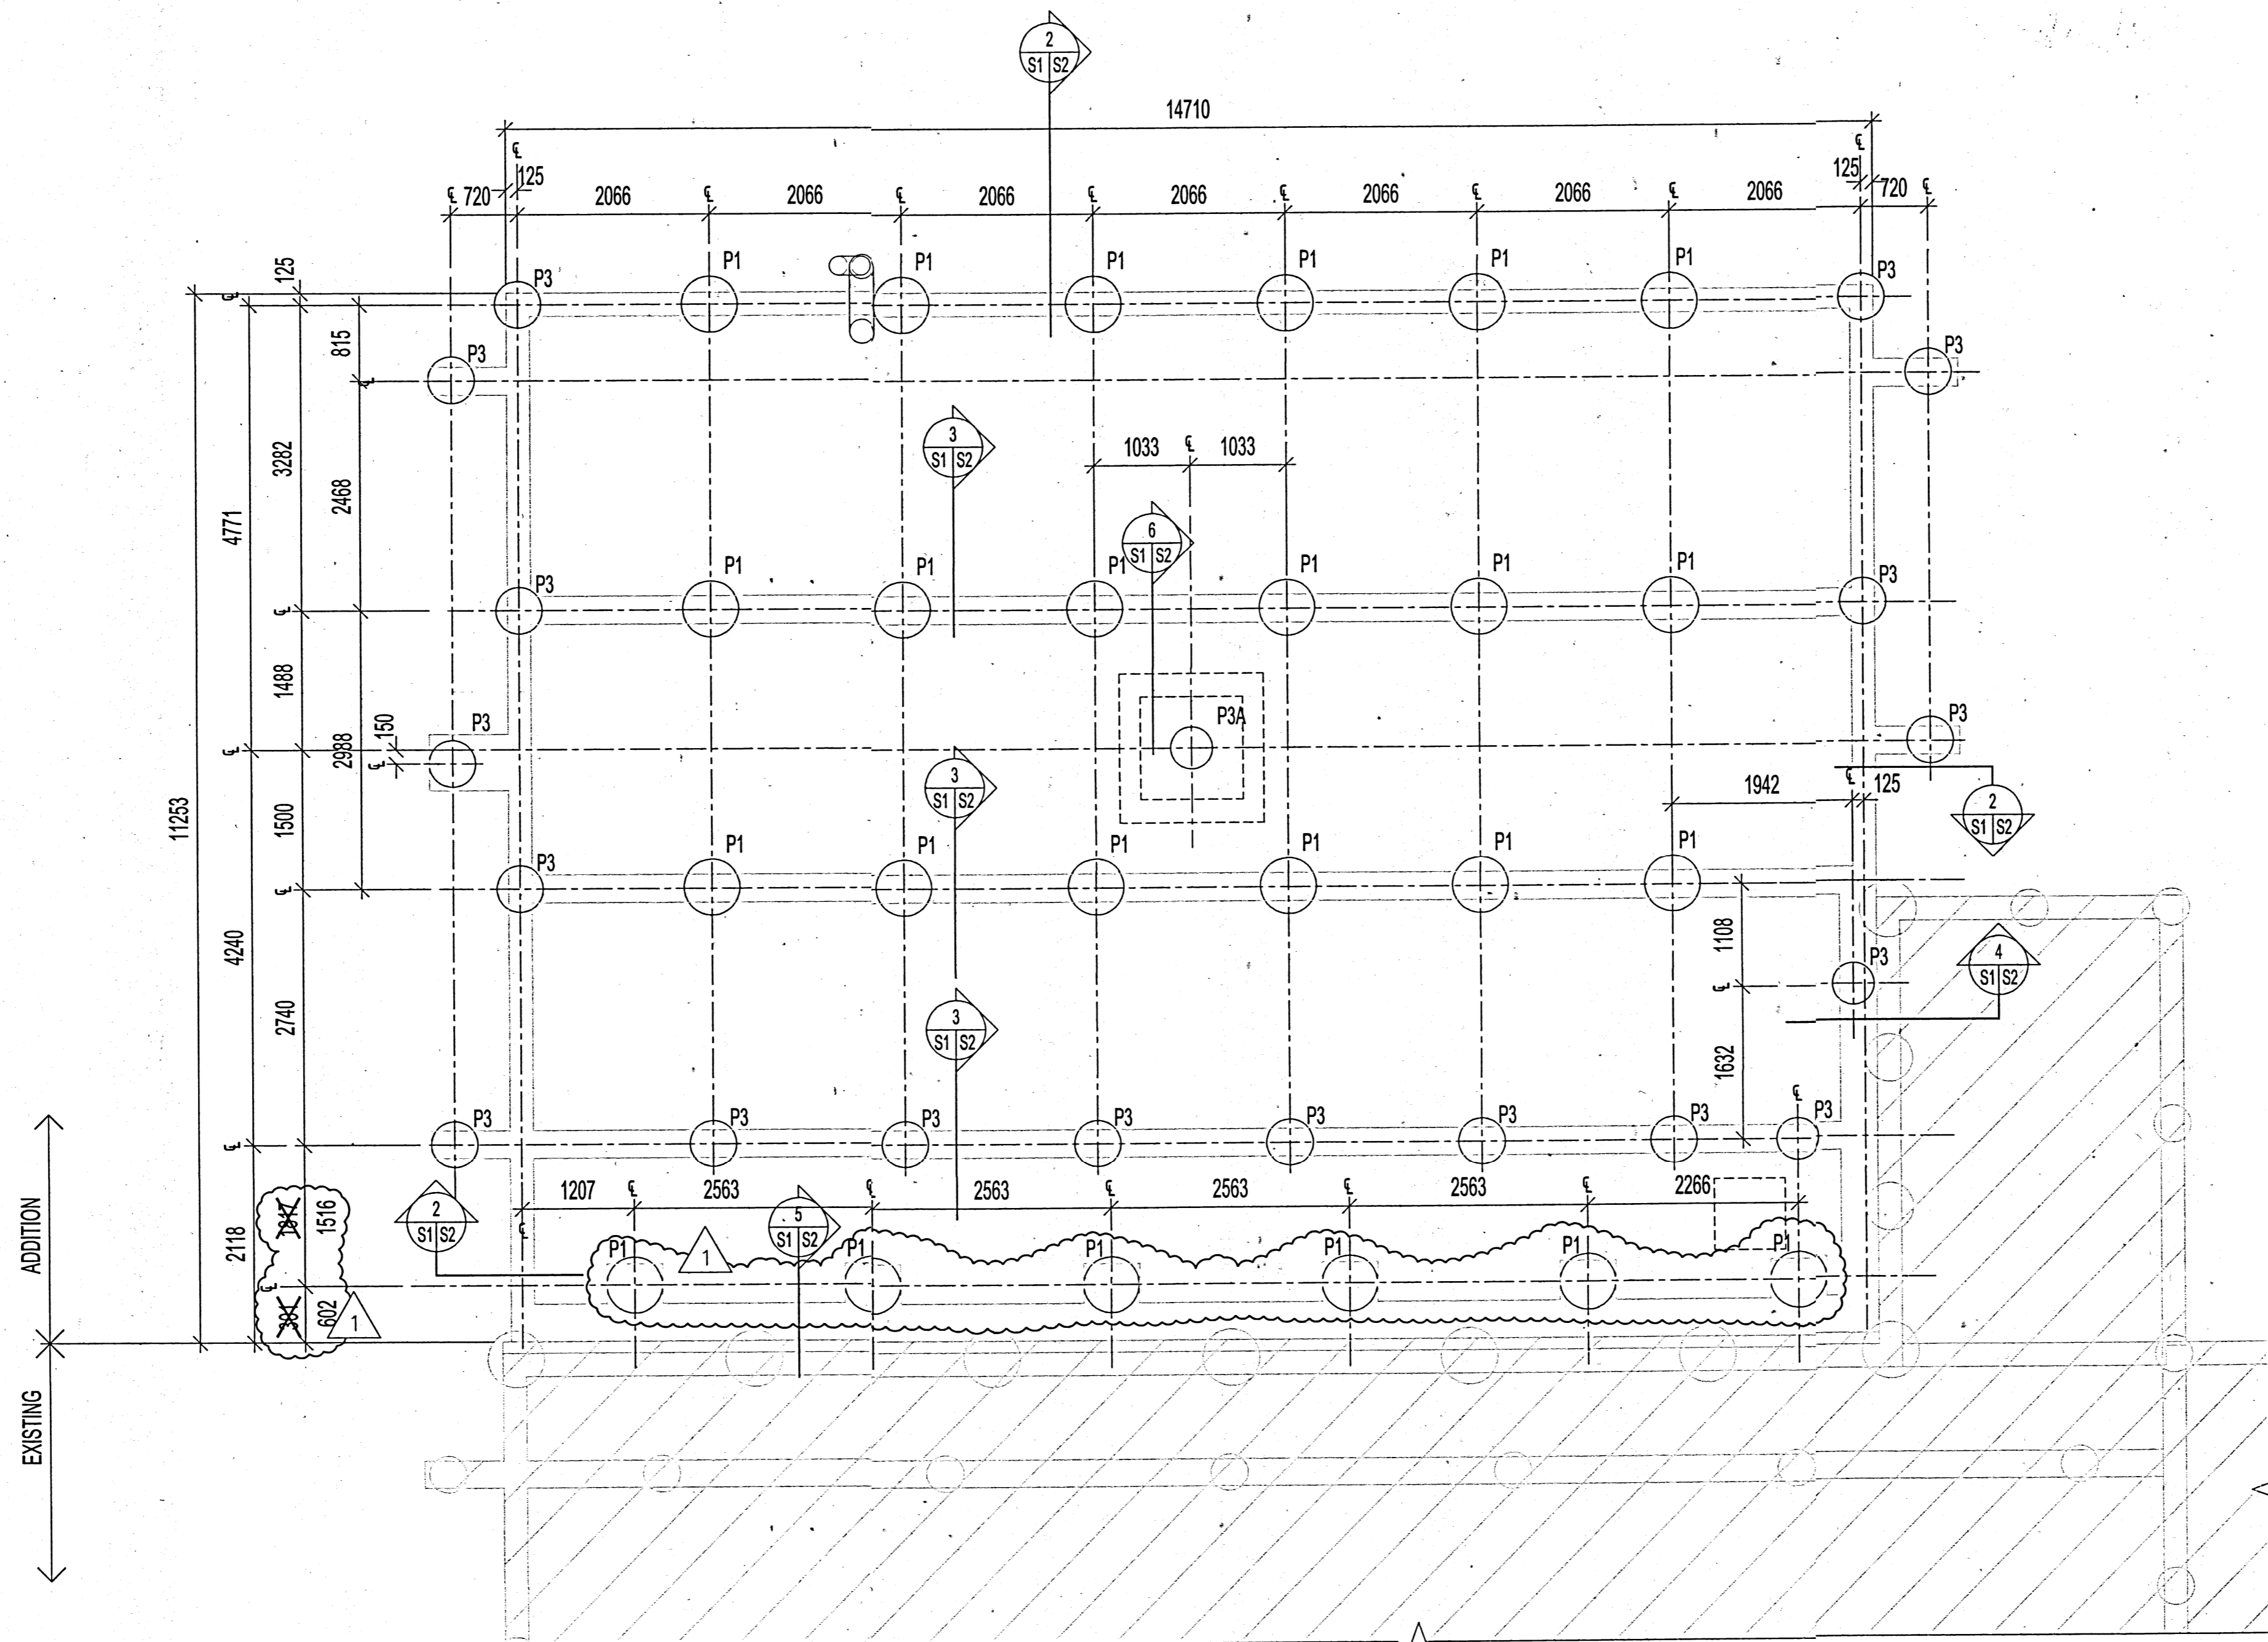

EXISTING
ADDITION

FOUNDATION PLAN
SCALE 1:50

SITE PAVING

SITE PAVING REQUIRED BETWEEN NEW OVERHEAD DOORS & STREET (PUBLIC LANE IS TO BE 200mm THICK CONCRETE SLAB, REINFORCED W/ 10M BARS @ 300 O.C. EACH WAY, TOP & BTM. GRANULAR SUB-BASE BELOW SLAB TO BE MIN. OF 2 LIFTS OF 150mm GRANULAR MATERIAL COMPACTED TO 98% SPMD. ALL GRANULAR MATERIAL TO MEET CITY OF WINNIPEG STANDARD SPECIFICATIONS FOR CRUSHED GRANULAR MATERIAL CW3110. SEE CIVIL DRAWING FOR EXTENT OF SITE PAVING.


PILE SCHEDULE				
MARK	PILE Ø	LENGTH	REINFORCING	TOP OF PILE ELEVATION
P1	600 Ø	11,500	8-20M VERTICAL BARS x 7600 LONG 10M RINGS @ 900 O.C. TRIPLE RING @ TOP	99.100
P2	500 Ø	11,500	8-15M VERTICAL BARS x 7600 LONG 10M RINGS @ 900 O.C. TRIPLE RING @ TOP	99.100
P3	400 Ø	11,500	5-15M VERTICAL BARS x 7600 LONG 10M RINGS @ 900 O.C. TRIPLE RING @ TOP	98.100
P3A	400 Ø	11,500	5-15M VERTICAL BARS x 7600 LONG 10M RINGS @ 900 O.C. TRIPLE RING @ TOP	98.225

* LENGTH OF PILE IS TO BE MEASURED FROM EXISTING GRADE

1 ISSUED FOR ADDENDUM #2 MMK 2015.06.05

ISSUED FOR CONSTRUCTION MMK 2015.03.26

No.	REVISION/DESCRIPTION	BY	DATE

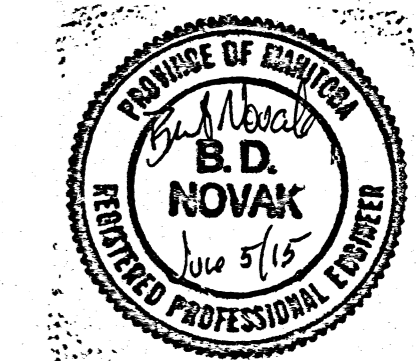

DRAWN	CHECKED	DESIGNED	APPROVED
MMK			
DATE	USER	APPROVAL	
2015.02.06			

THE CITY OF WINNIPEG
PLANNING, PROPERTY AND
DEVELOPMENT DEPARTMENT
MUNICIPAL ACCOMMODATIONS DIVISION
3-65 GARRY STREET, R3C 4K4

PROJECT
**WINNIPEG FIRE PARAMEDIC SERVICES
ADDITIONAL APPARATUS ROOM BAYS**

603 REDWOOD AVENUE
SHEET TITLE
FOUNDATION PLAN

SCALE	PROJECT No:	SHEET No:
AS SHOWN	2013-171-02	S1R1