


11 BASKETBALL STANDARD BASE
L3.3 N.T.S.

12 TENNIS COURT NET POST
L3.3 N.T.S.

1	ADDENDUM #1	MAR 24 2016	AH
	ISSUED FOR TENDER	MAR 12 2016	AH
-	99% CITY REVIEW	APR 23 2015	AH
No.	Revisions	Date	By
Date	Scale		
10-12-14	NTS		
Designed By	Drawn By	Checked By	
AH	GML	AH	

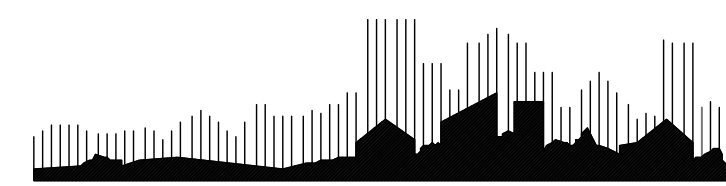

Client
CITY OF WINNIPEG

Project Title
**PARK CITY WEST
COMMUNITY
CENTRE**

Sheet Title
DETAILS

Project No. 14-030 Drawing No. L3.3