


**F SECTION**  
1:50  
SGAD-G001,  
SGAD-G002,  
SGAD-G003



**G SECTION**  
1:50  
SGAD-G001,  
SGAD-G002,  
SGAD-G003

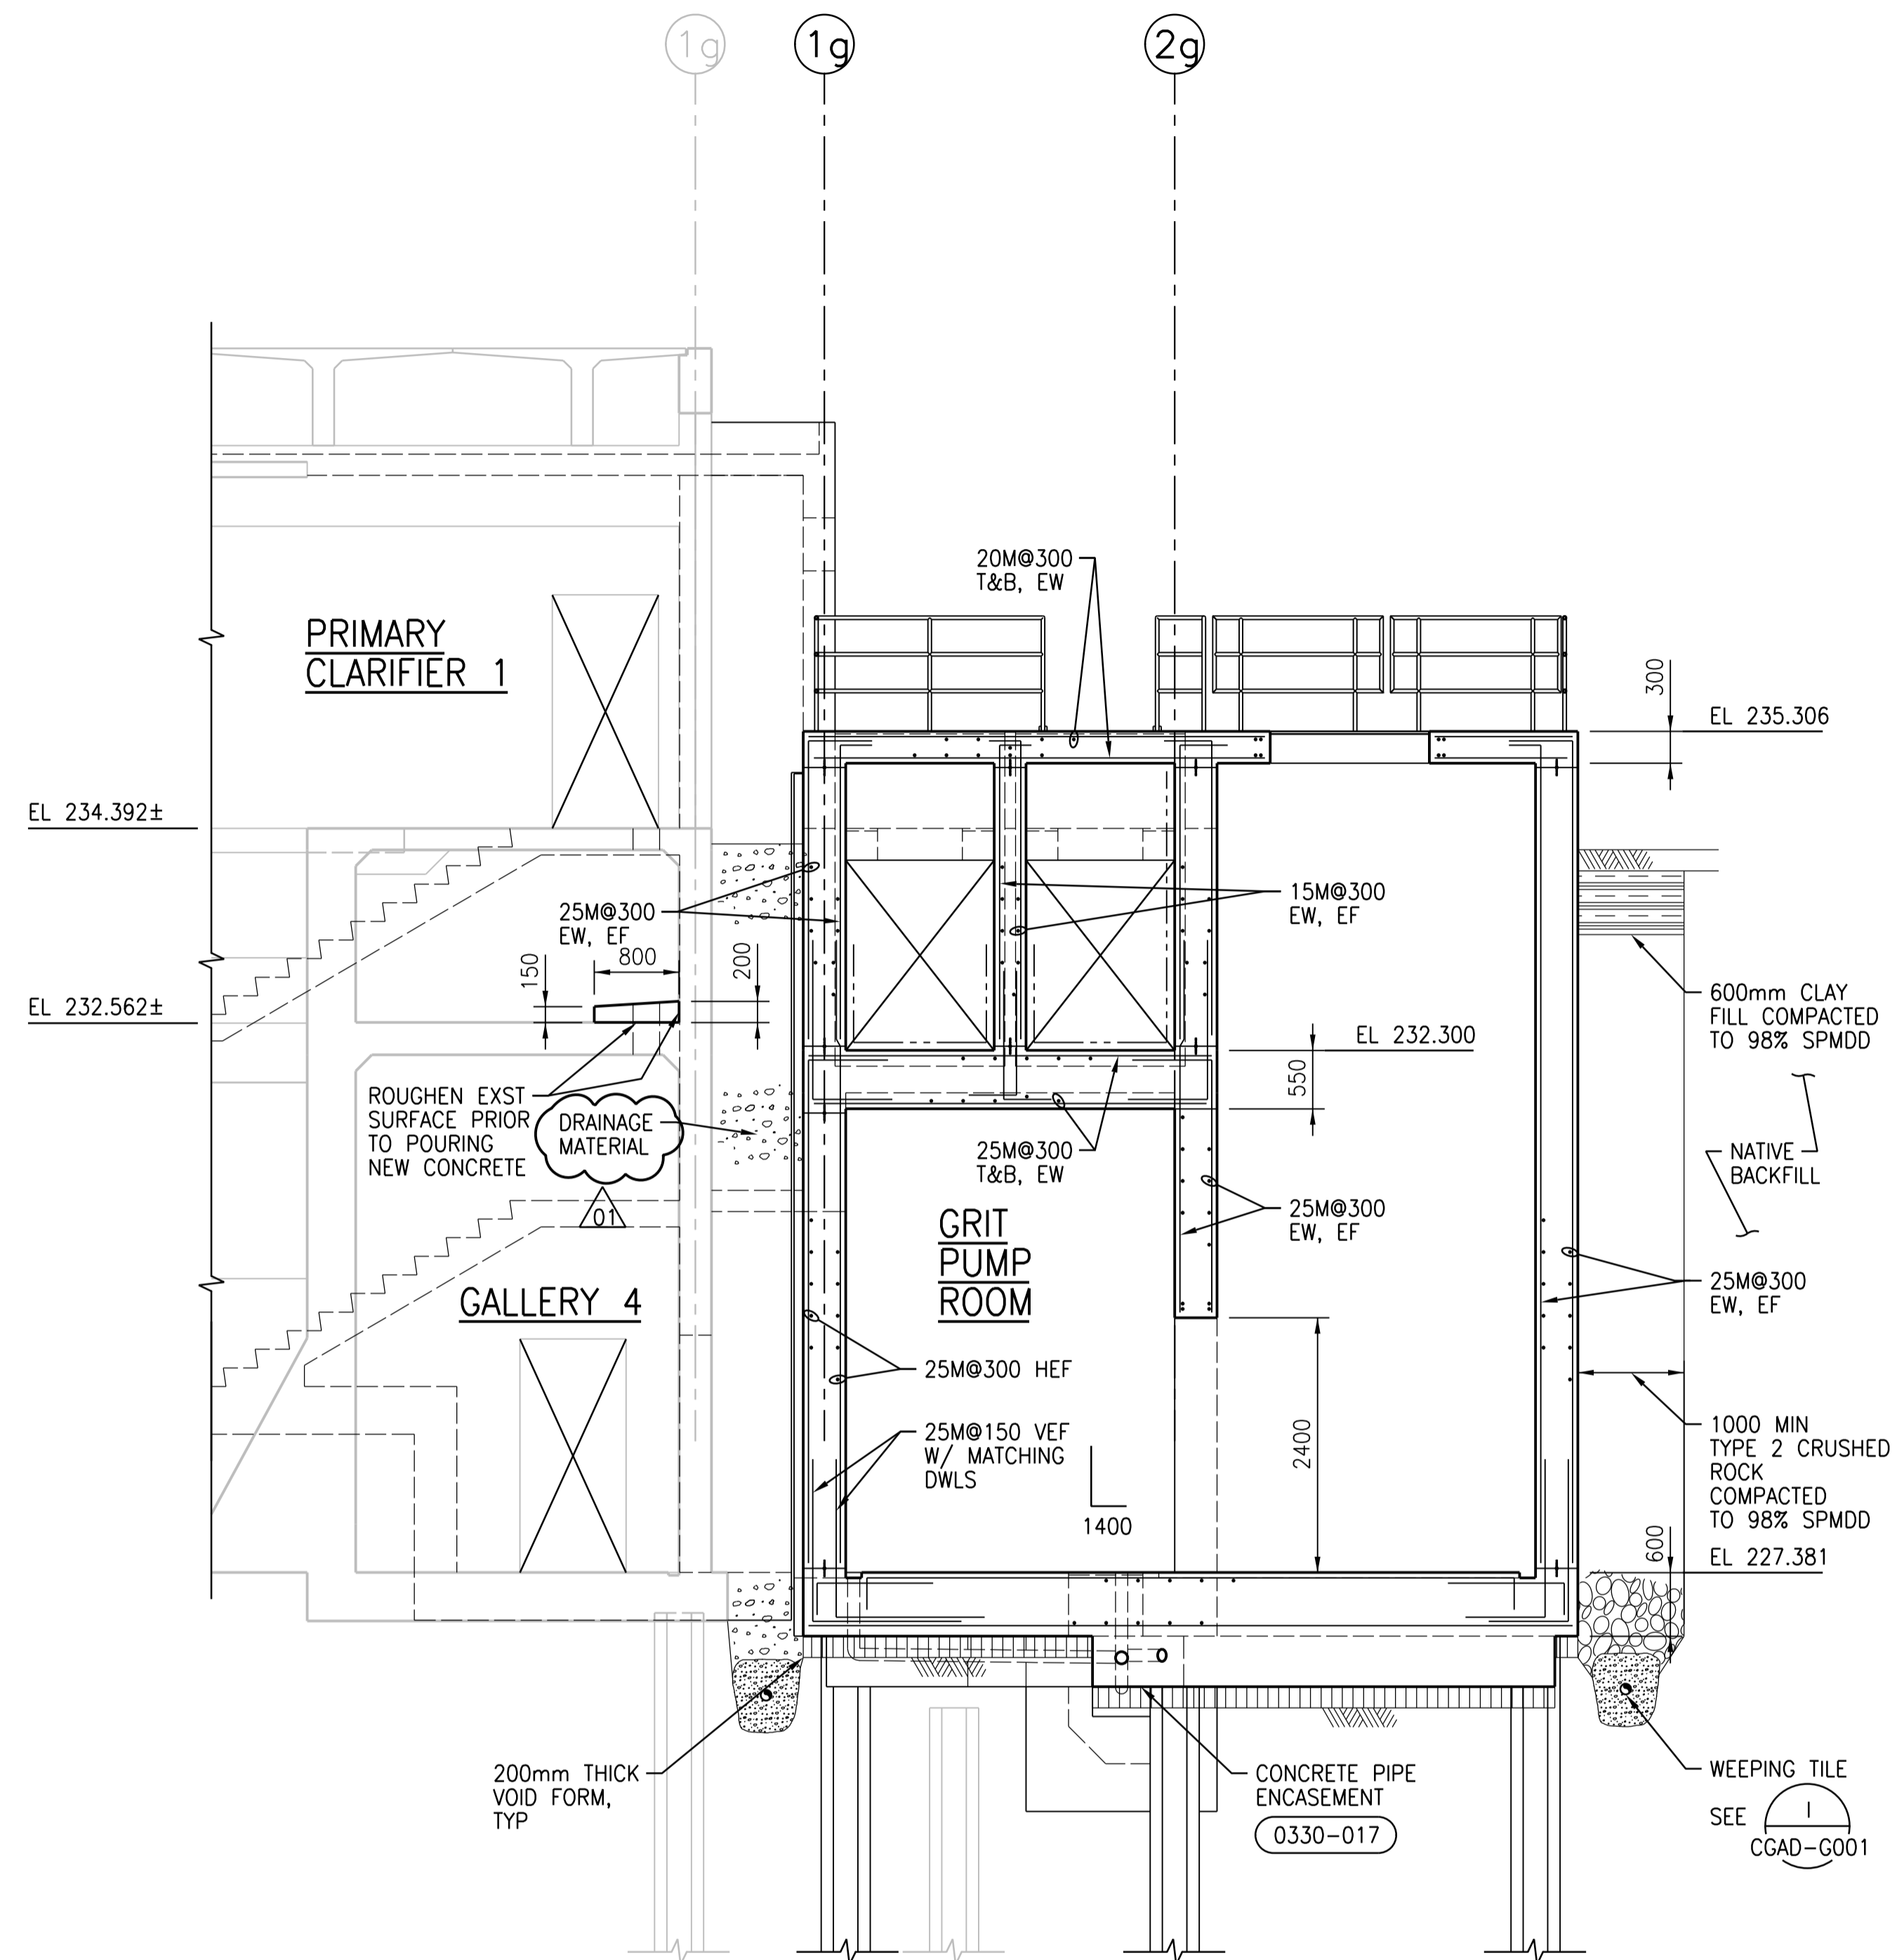

NO.	REVISIONS	DATE	DESIGN	CHECK
01	ISSUED FOR ADDENDUM NO. 2	09/2015	C.R.	J.C.
00	ISSUED FOR TENDER	08/2015	G.O.	J.C.

<b>CH2MHILL</b>		<b>KCS GROUP</b>	
SNC-LAVALIN		CONSULTING ENGINEERS	
DESIGNED BY: E. LUI	CHECKED BY: R. PARIKH	ISSUED FOR CONSTRUCTION BY: T. TURZAK	DATE: 2015/08/13
DRAWN BY: G. OMORI	APPROVED BY: E. LUI	DATE: 2015/08/13	CONSULTANT NO.: 474248
SCALE: 1:50			



**THE CITY OF WINNIPEG**  
Winnipeg WATER AND WASTE DEPARTMENT

SOUTH END WATER POLLUTION CONTROL CENTRE  
SEWPC UPGRADING/EXPANSION PROJECT  
STRUCTURAL  
GRIT TANKS 1 AND 2  
SECTIONS F AND G

CITY DRAWING NUMBER: 1-0102-SGAD-G007 SHEET: 01 SIZE: A1